




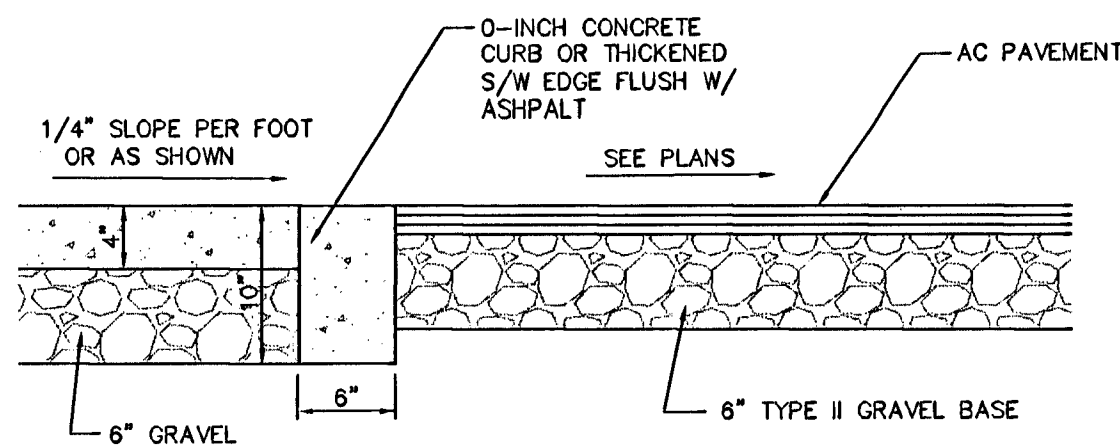


(N) 0' TYPE CONCRETE CURB DETAIL
N.T.S. GRADING CONSTRUCTION NOTE ⑩

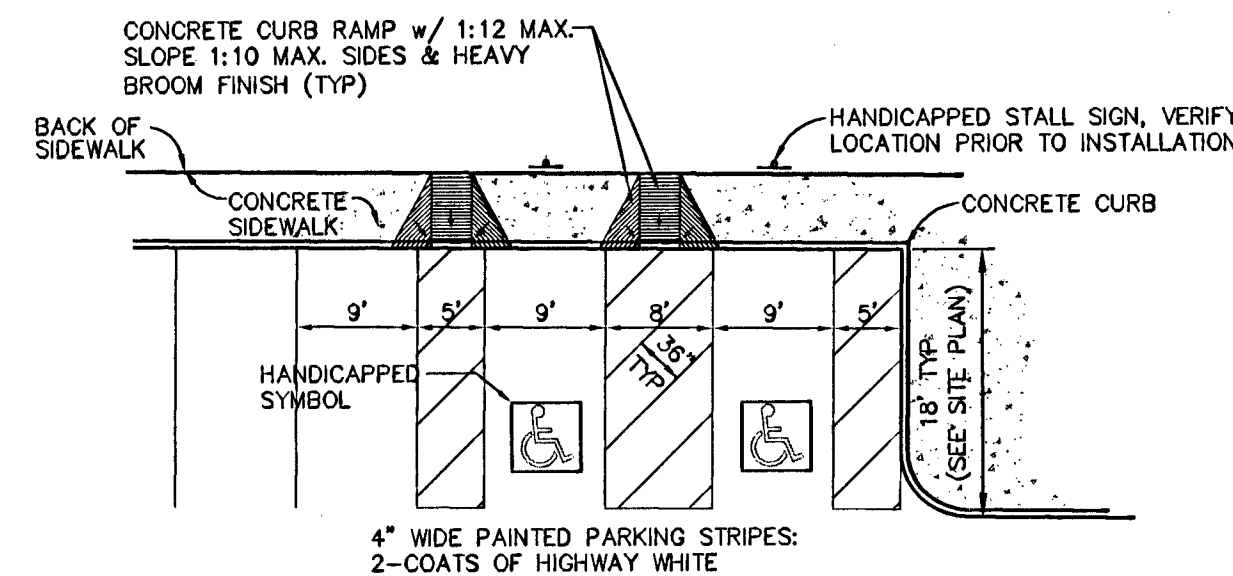


(P) HANDICAP PARKING SPACE DETAIL
N.T.S. GRADING CONSTRUCTION NOTE ⑩

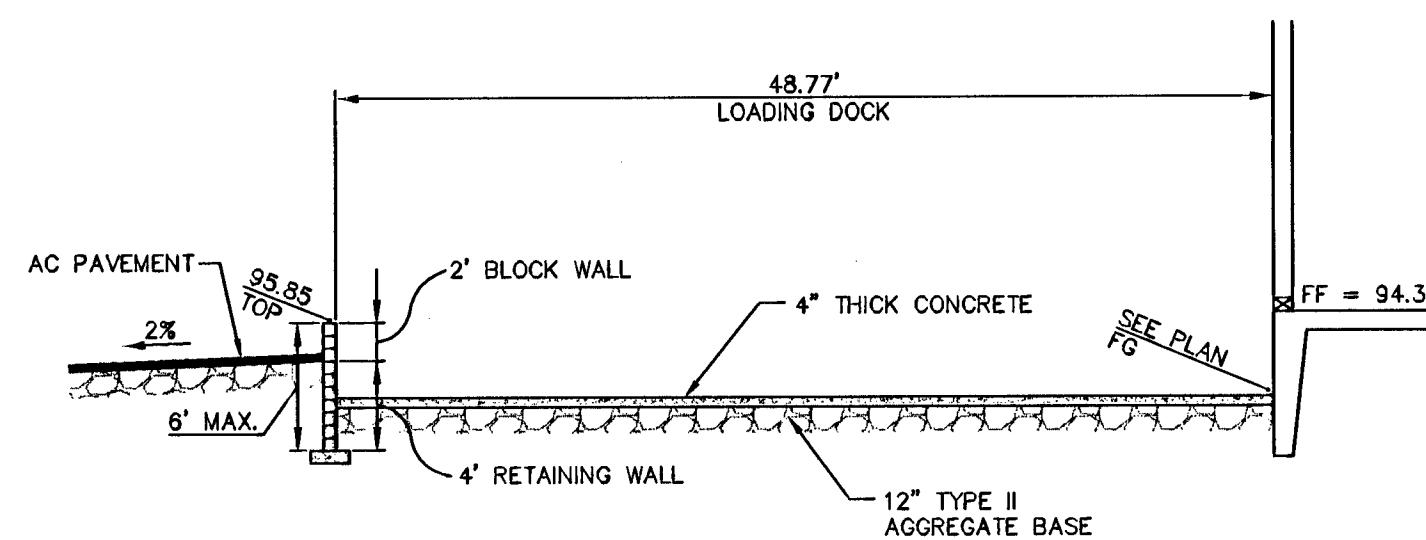


(Q) LOADING DOCK SECTION
N.T.S.

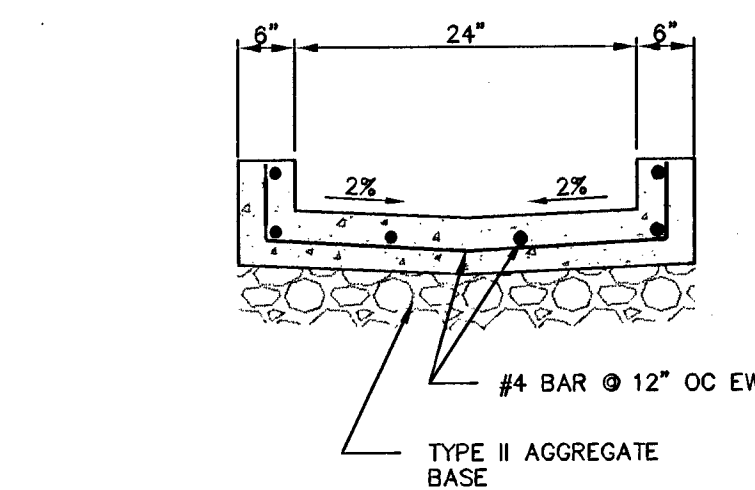


(R) 36' CONCRETE FLUME
N.T.S.

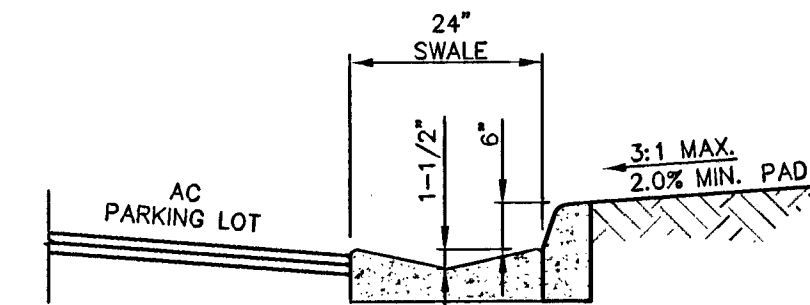


(AA) SECTION
N.T.S.

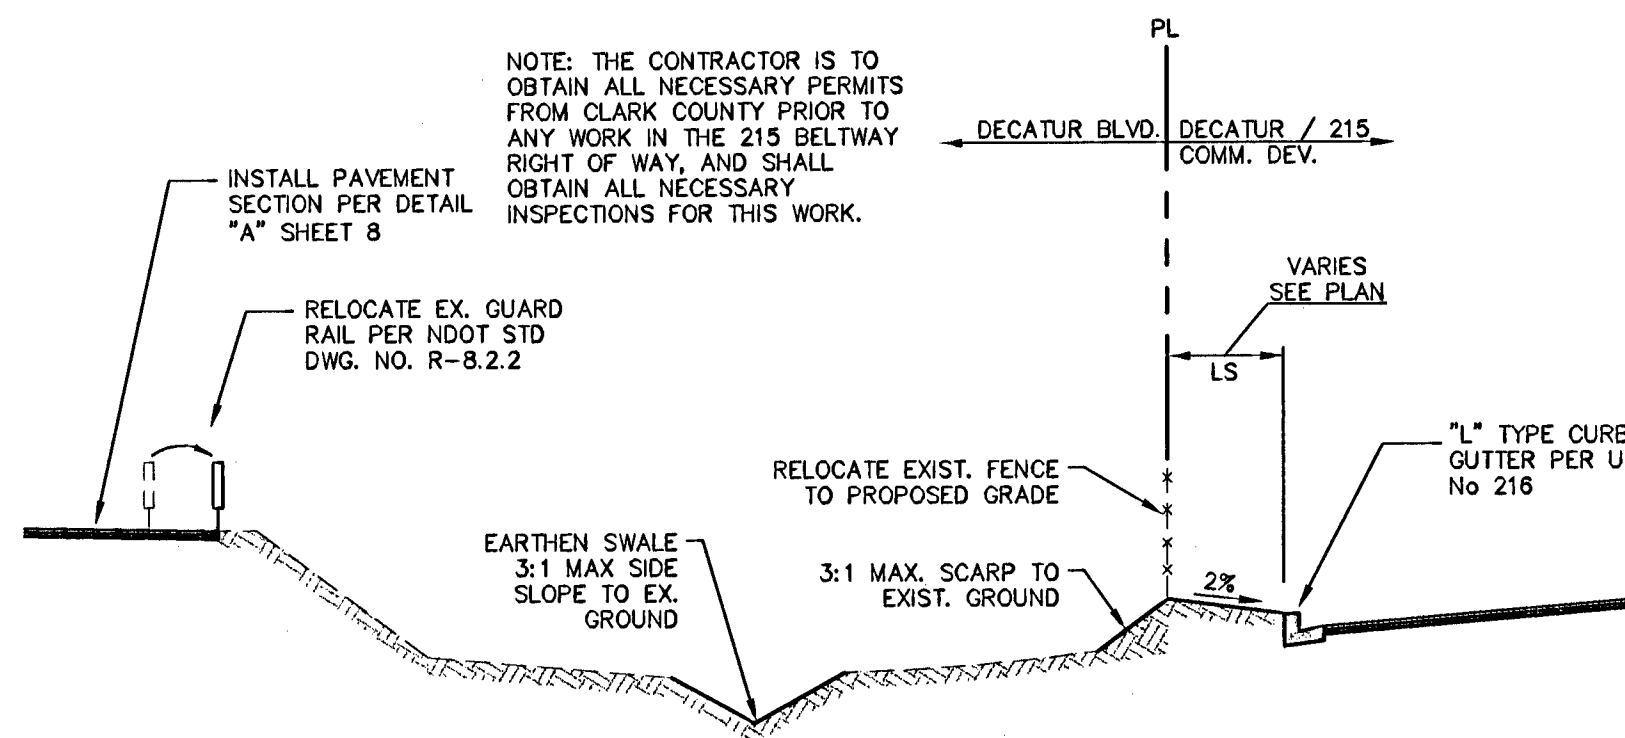


(S) SECTION AT NORTHEAST PROPERTY LINE
N.T.S.

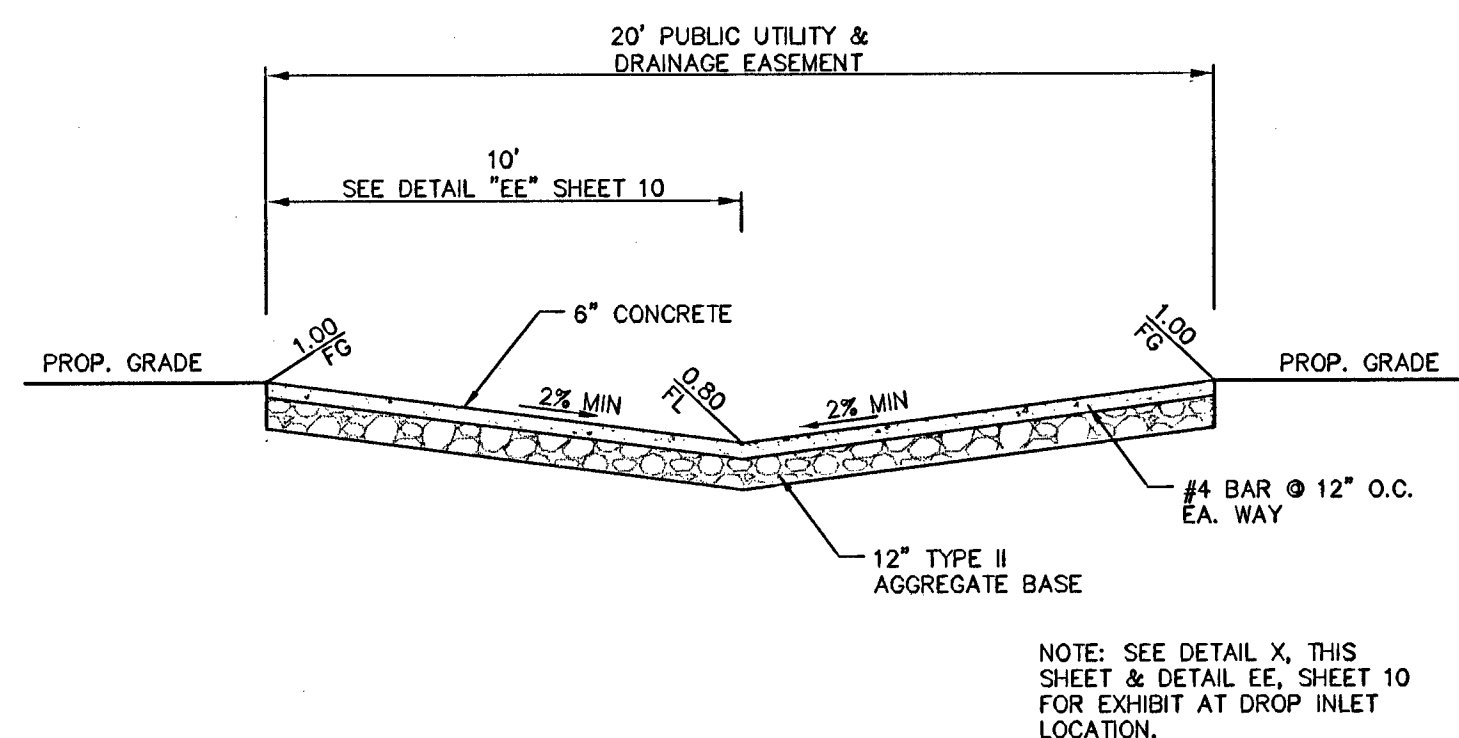


(T) UTILITY + DRAINAGE EASEMENT
N.T.S.

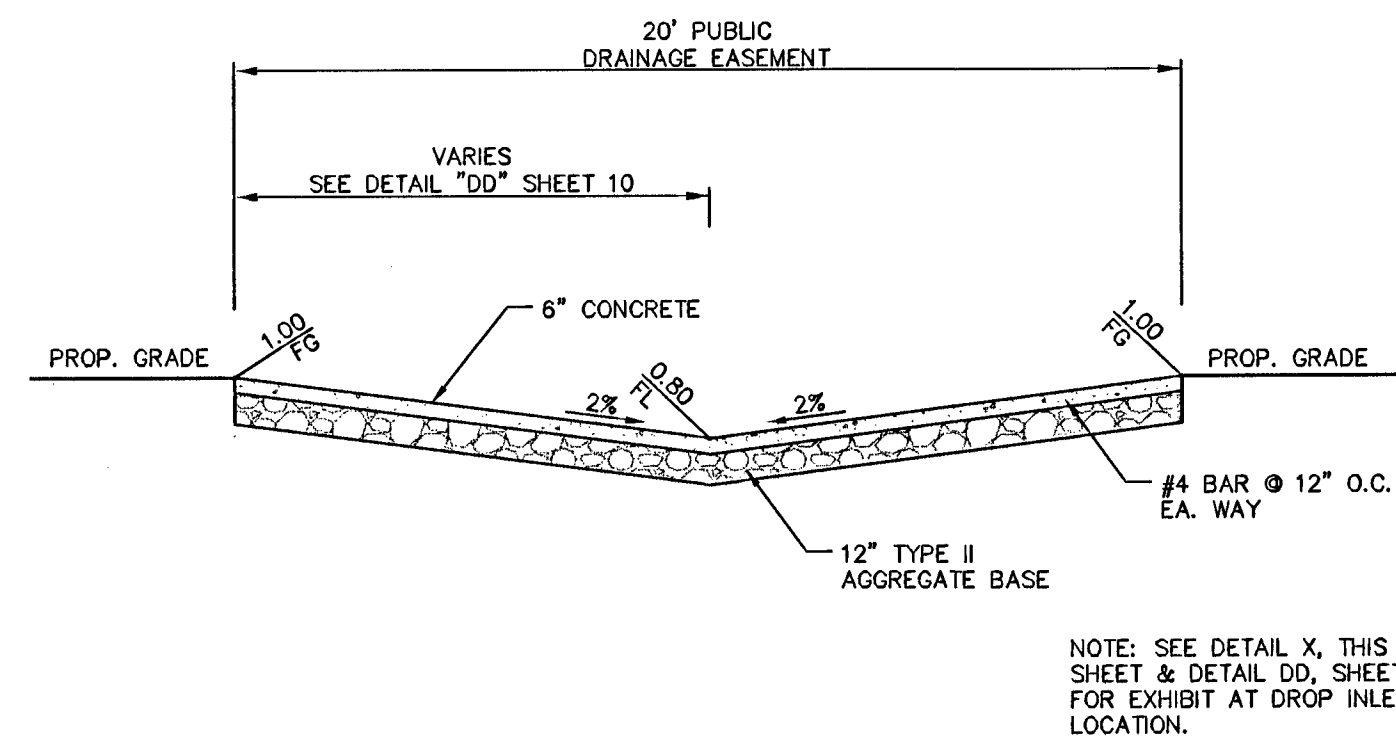

(U) DRAINAGE EASEMENT
N.T.S.

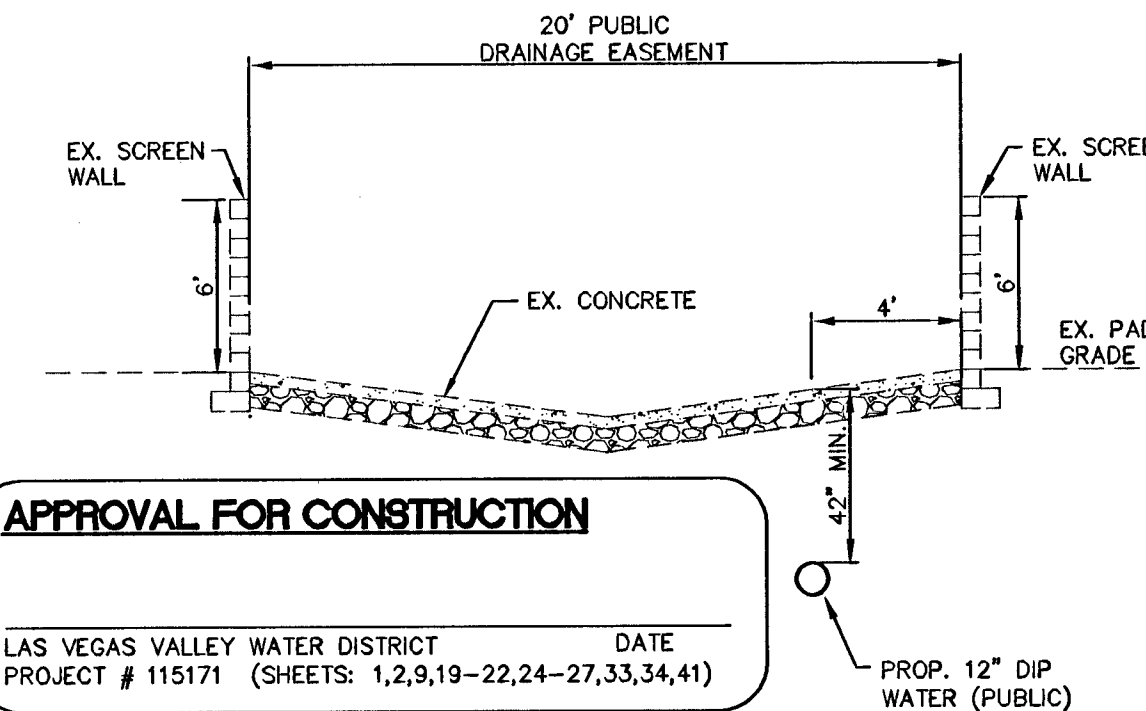

(Y) DRAINAGE EASEMENT
N.T.S.

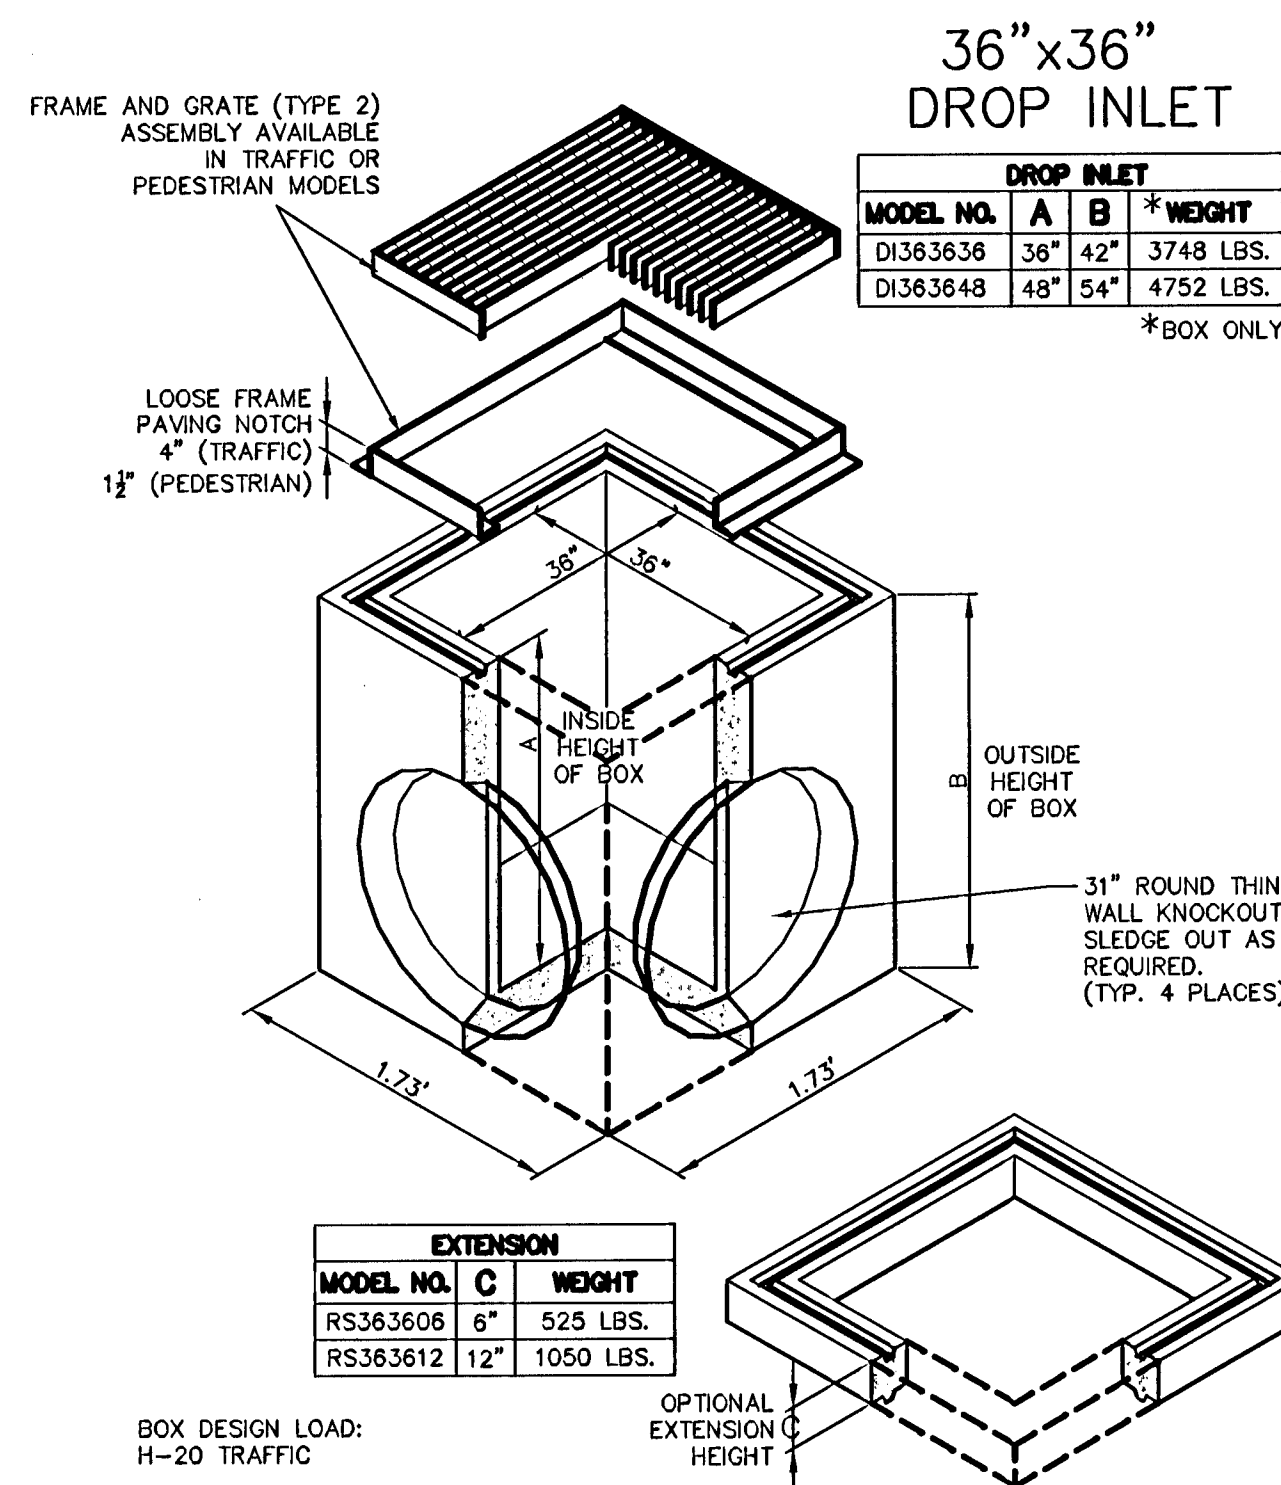


EXTENSION		
MODEL NO.	C	WEIGHT
RS363606	6"	525 LBS.
RS363612	12"	1050 LBS.

BOX DESIGN LOAD:
H-20 TRAFFIC


FOR COMPLETE DESIGN,
AND PRODUCT INFORMATION,
CONTACT JENSEN PRECAST.

6/27/03
Jensen Precast


(V) CATCH BASIN #1, #2 DETAIL
N.T.S. GRADING CONSTRUCTION NOTE ⑩

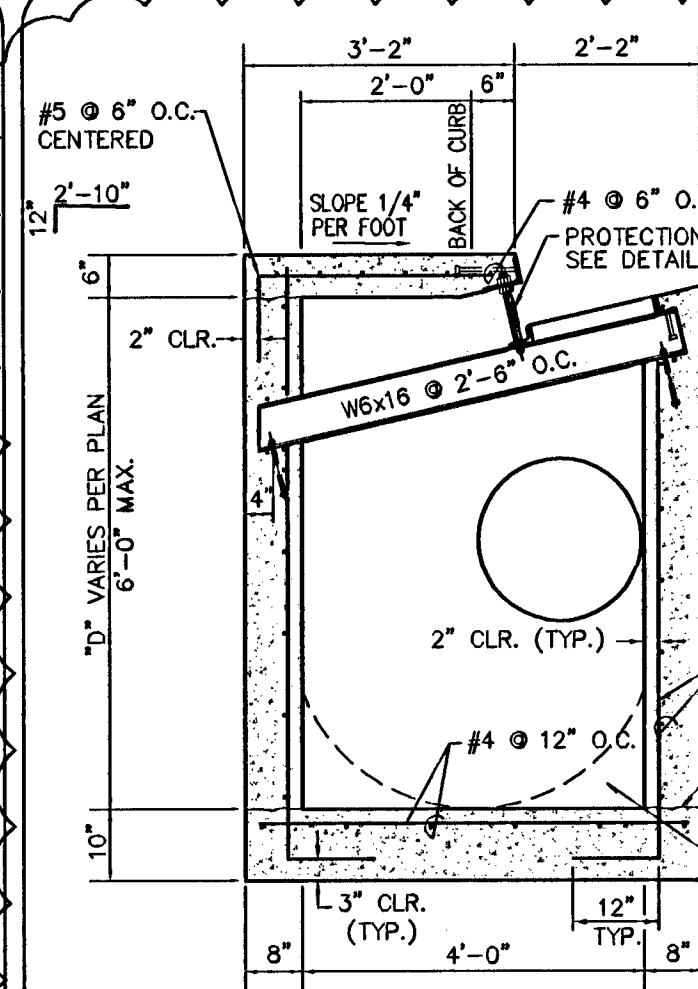

TYPE 'CM' DROP INLET SECTION
SCALE 3/4"=1"

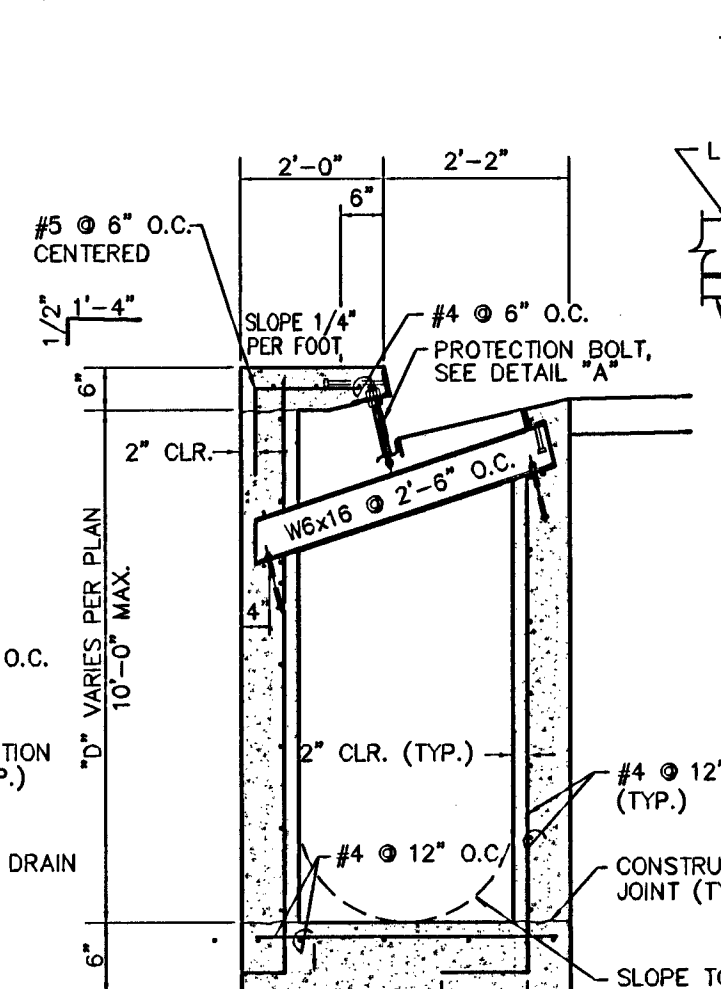

TYPE 'DM2' DROP INLET SECTION
SCALE 3/4"=1"

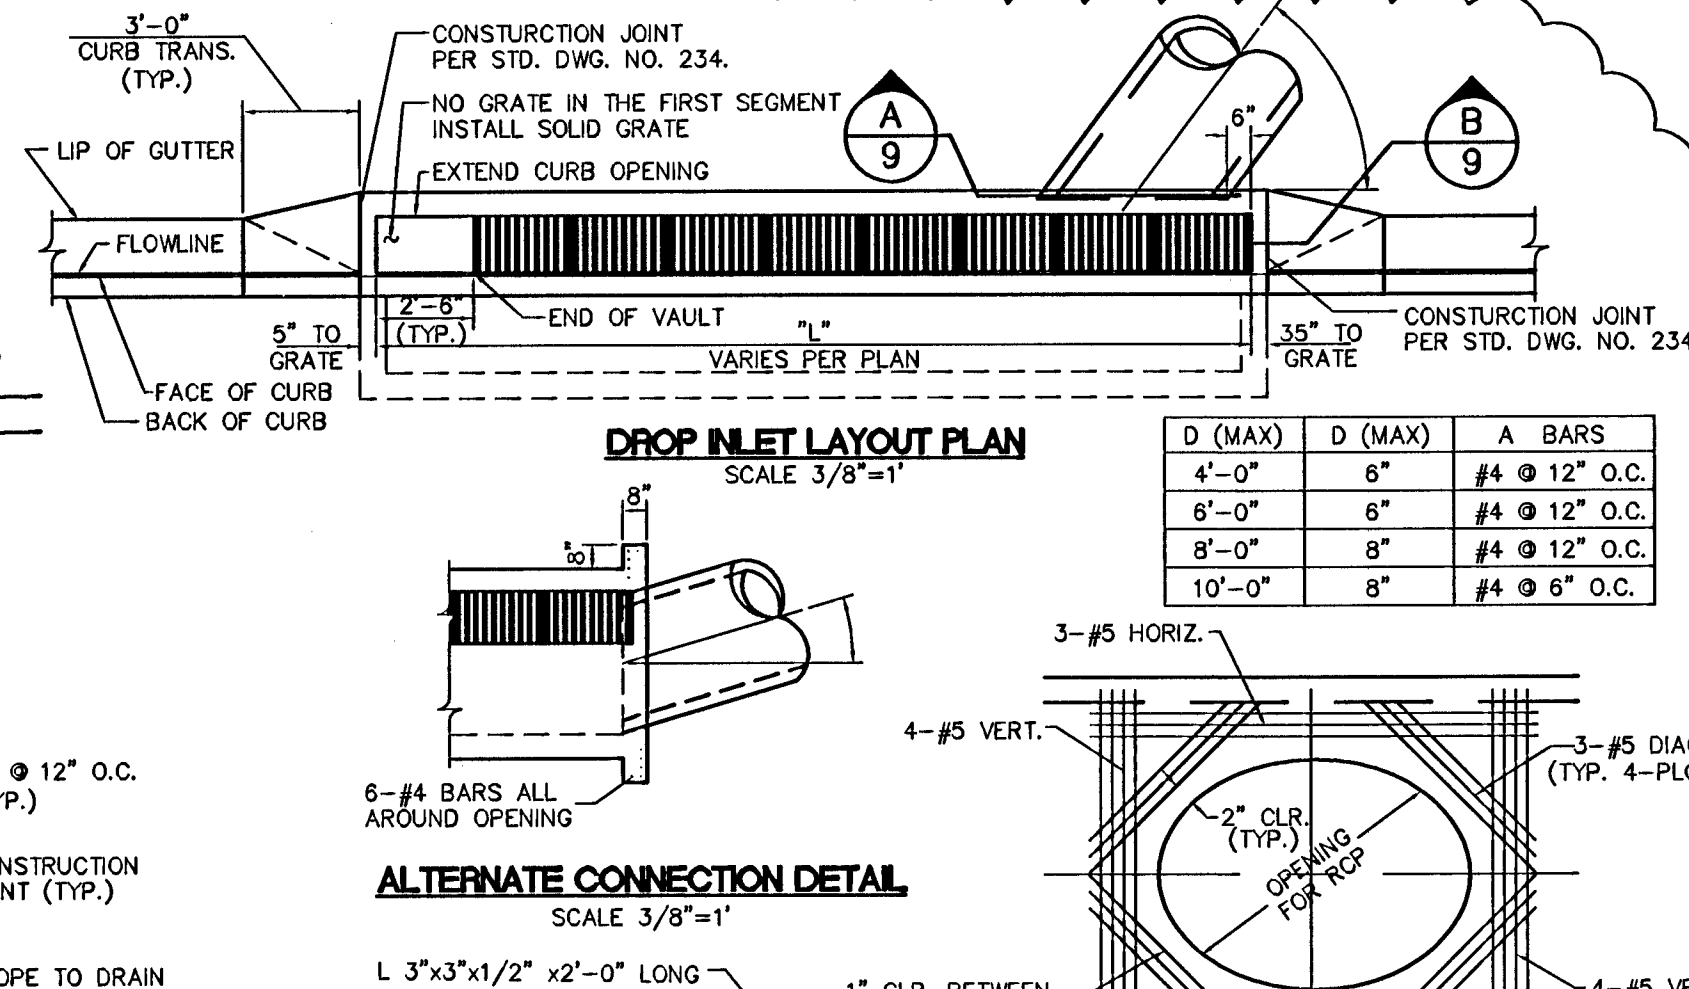


DROP INLET LAYOUT PLAN
SCALE 3/8"=1"

ALTERNATE CONNECTION DETAIL
SCALE 3/8"=1"

SECTION 'A'
SCALE 3/4"=1"

SECTION 'B'
SCALE 1-1/2"=1"

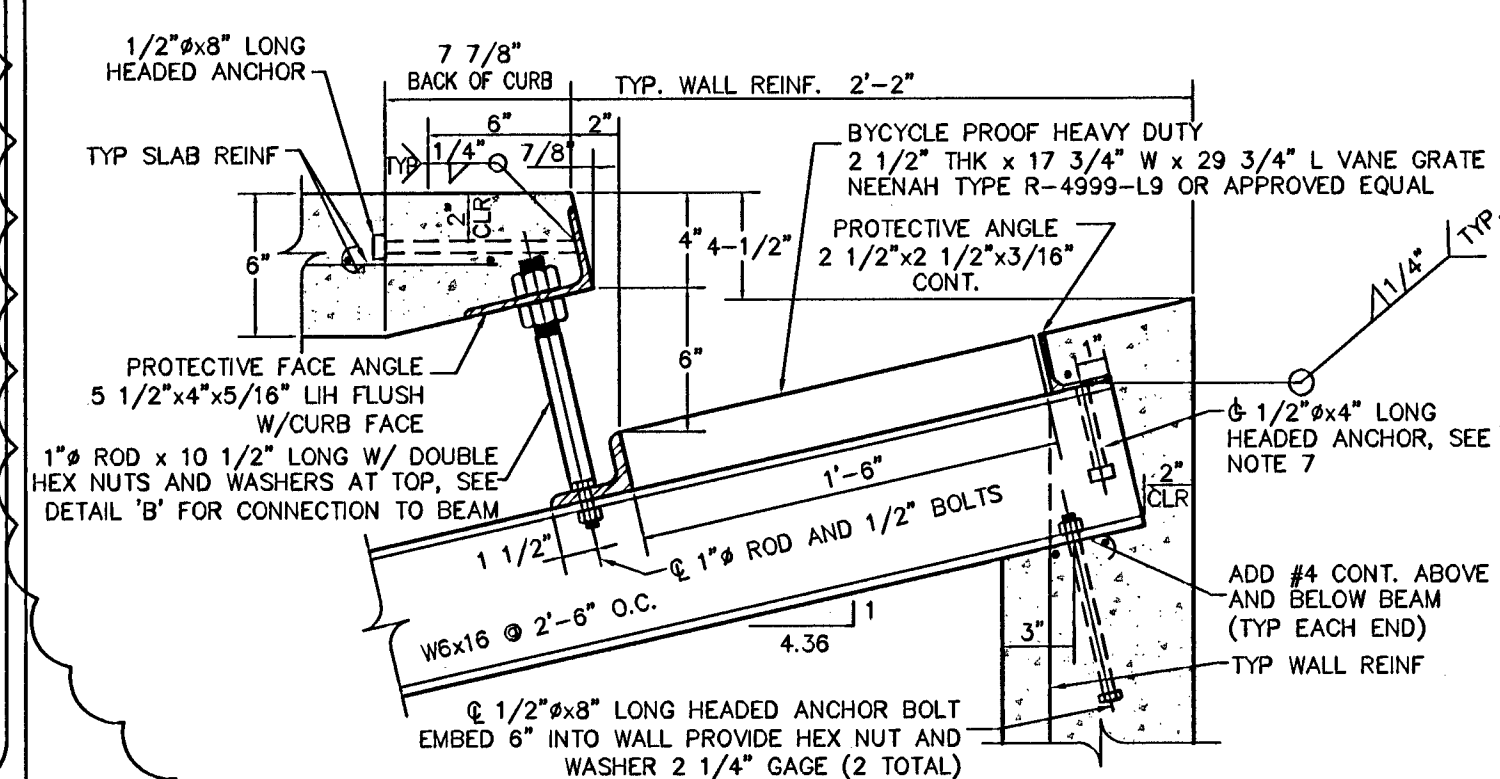


PROTECTIVE FACE + ROD - DETAIL 'A'
SCALE 3"=1"


(W) TYPE 'CM' DROP INLET
N.T.S. GRADING CONSTRUCTION NOTES ⑩ ⑪

NOTES

1. ALL EXPOSED METALS SHALL BE HOT DIP GALVANIZED AFTER FABRICATION.
2. PROVIDE 1/2" (MIN.) CLEARANCE ALL AROUND THE STEEL BEAM, DRY PACK AFTER INSTALLATION.
3. WHEN REQUIRED BY LENGTH OF OPENING, PLATE ANGLE MAY BE DELIVERED IN SECTIONS AND BUTT WELDED IN PLACE.
4. ALL GALVANIZING DAMAGED BY WELDING SHALL RECEIVE TWO COATS OF GALVALLOY OR EQUAL.
5. CONCRETE SHALL BE MODIFIED CLASS DA 4000 PSI, SEE SPECIAL PROVISIONS SECTION 501.
6. ANGLE ANCHORS SHALL BE EMBEDDED MIDPOINT IN EACH ENDWALL AND EVENLY SPACED, (MAXIMUM SPACING OF 2')

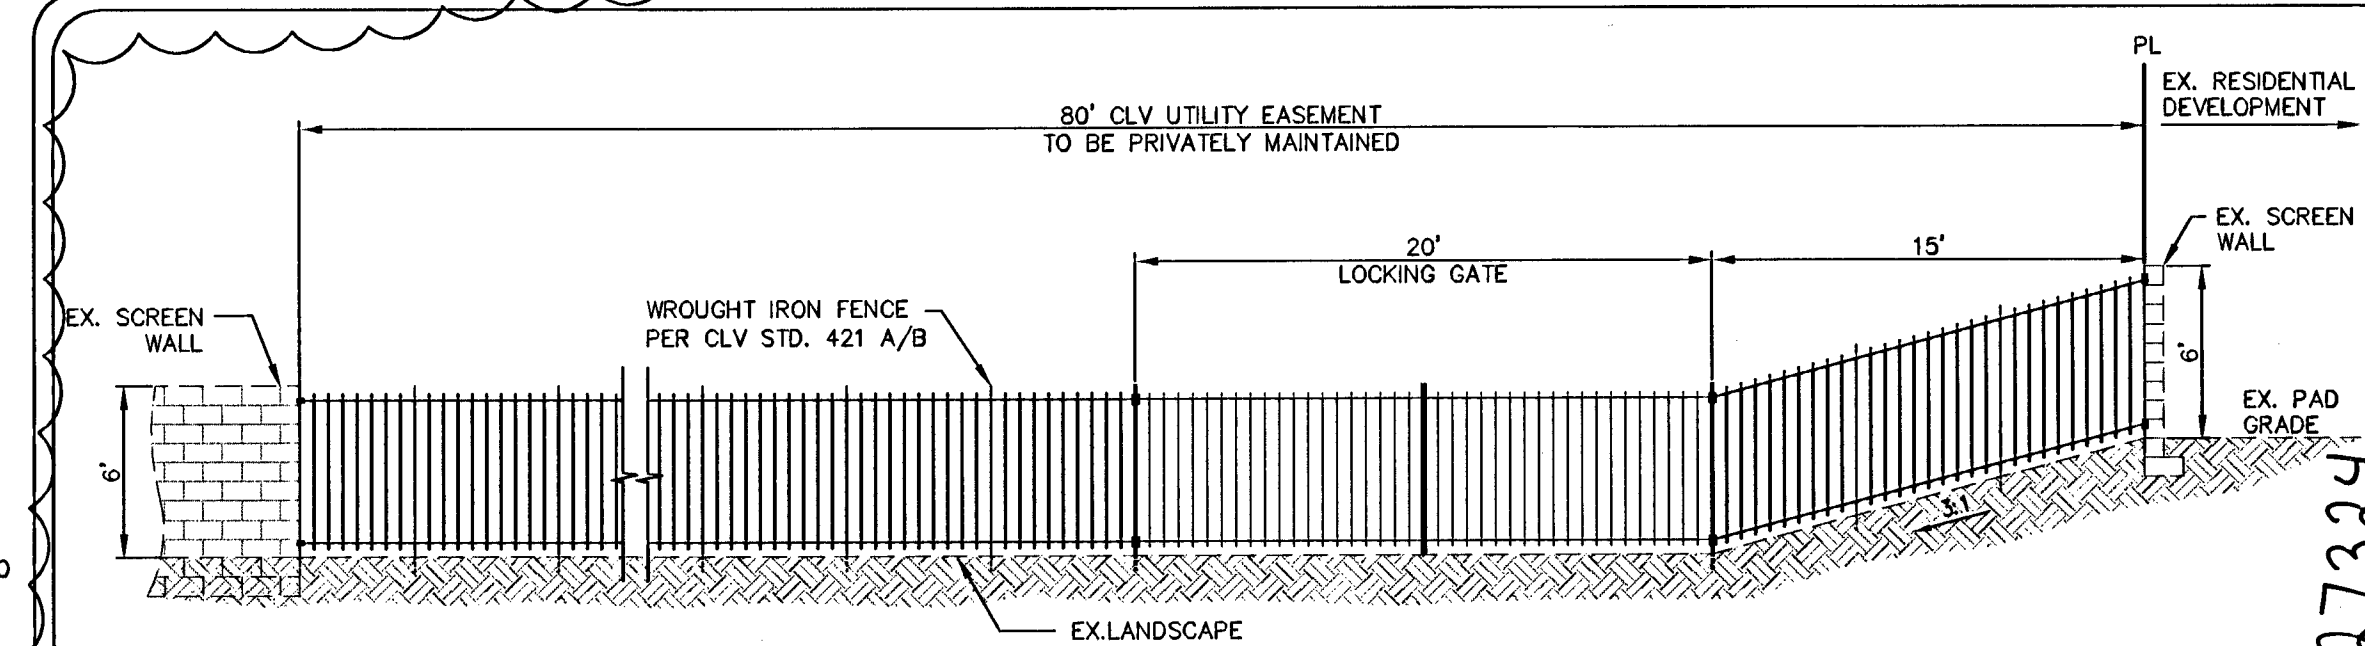


(Z) WROUGHT IRON FENCE W/ LOCKING ACCESS GATE DETAIL
N.T.S.

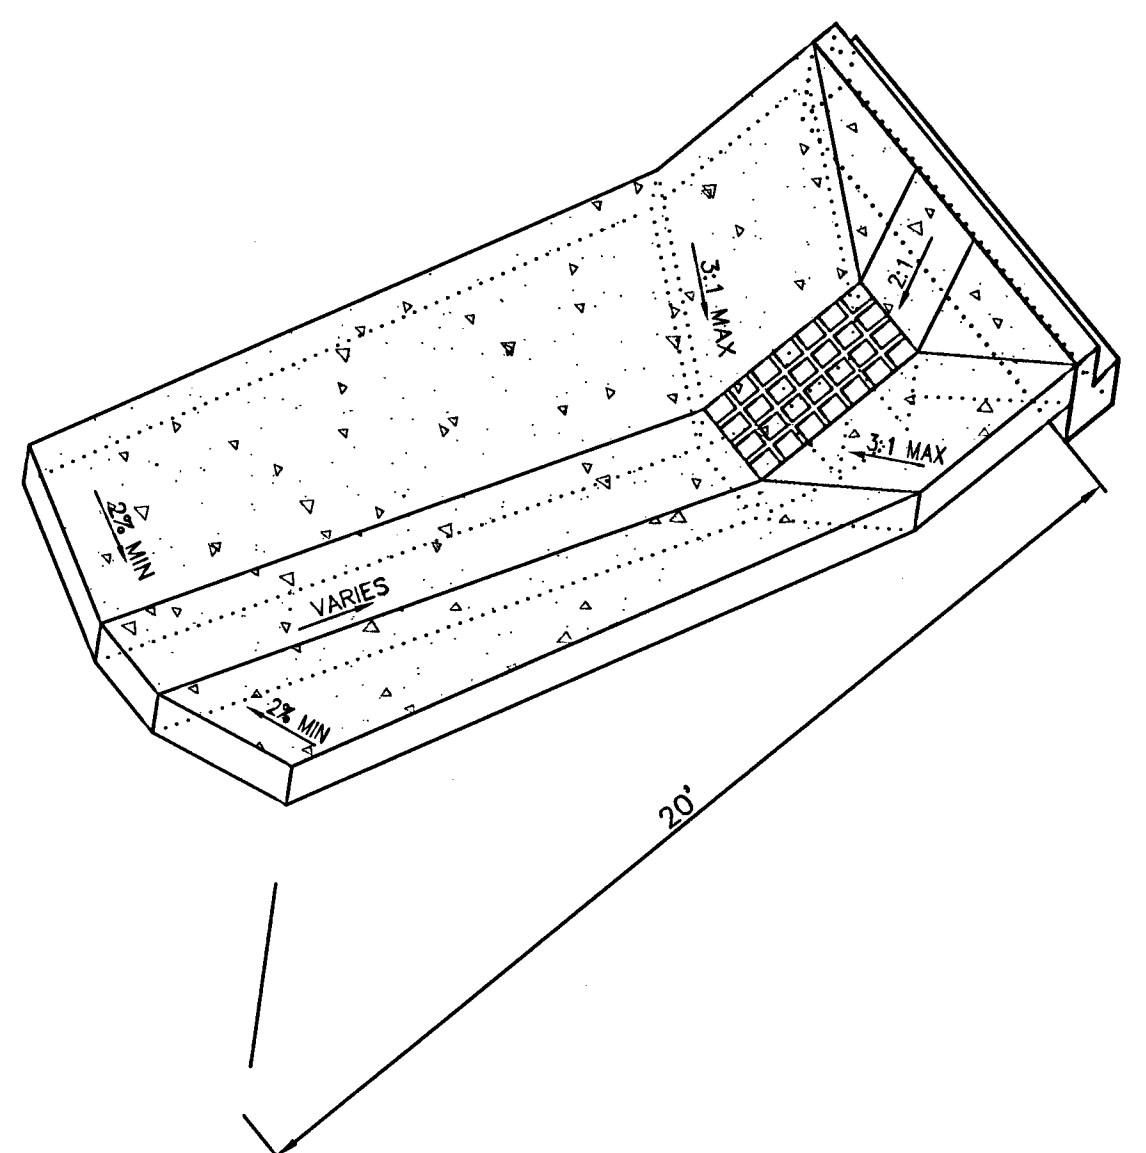

(X) DRAINAGE EASEMENT DETAIL
N.T.S.

NO.	DATE	BY	APPROVED	REVISION DESCRIPTION
1				

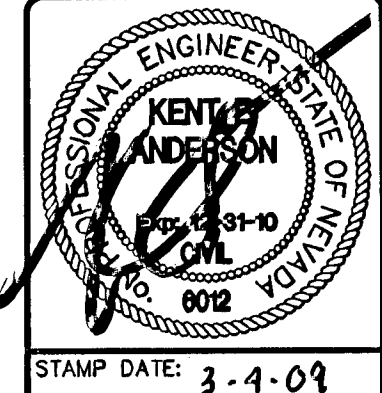

3610 North Rancho Drive
Las Vegas, Nevada 89130
Telephone: (702) 648-9700
Fax: (702) 648-4143

SOUTHWEST ENGINEERING
LAND PLANNING • SURVEYING • DEVELOPMENT

GRADING DETAILS AND SECTION II

DECATUR & TROPICAL
DECATUR 215, LLC

CITY OF LAS VEGAS
PROJECT: 070619
WORK ORDER NO.: 070619
DESIGN BY: KDS
DRAWN BY: KDS/WK
DATE: Mar 04, 2009
SCALE: AS SHOWN
SHEET: 9 OF 45 SHEETS
CLV DWG NO.: 107Y4968

116250