

Call
before you
Dig.


1 800 227 2600

LEGEND

- EXISTING POWER
- EXISTING GAS
- EXISTING TELEPHONE
- EXISTING WATER
- EXISTING SEWER
- 1/4" PVC CONDUIT & CONDUITOPS
- 100 W.H.P.S. ST. LIGHT, POLE & FOUNDATION
- 1250 W.H.P.S. ST. LIGHT, POLE & FOUNDATION
- SERVICE POINT & P.C.O.C.
- No. 3/4" PULL BOX
- ST. NAME SIGN
- STOP SIGN



Project
Location

Vicinity Map

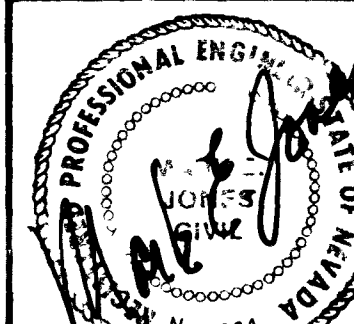

**SOUTHWEST
ENGINEERING**
LAND PLANNING • MAPPING • DEVELOPMENT
1725 S. RAINBOW BLVD., SUITE 200, LAS VEGAS, NEVADA 89102
(702) 861-1100

MASTER STREET LIGHT PLAN PHASE 1 EDGEWATER

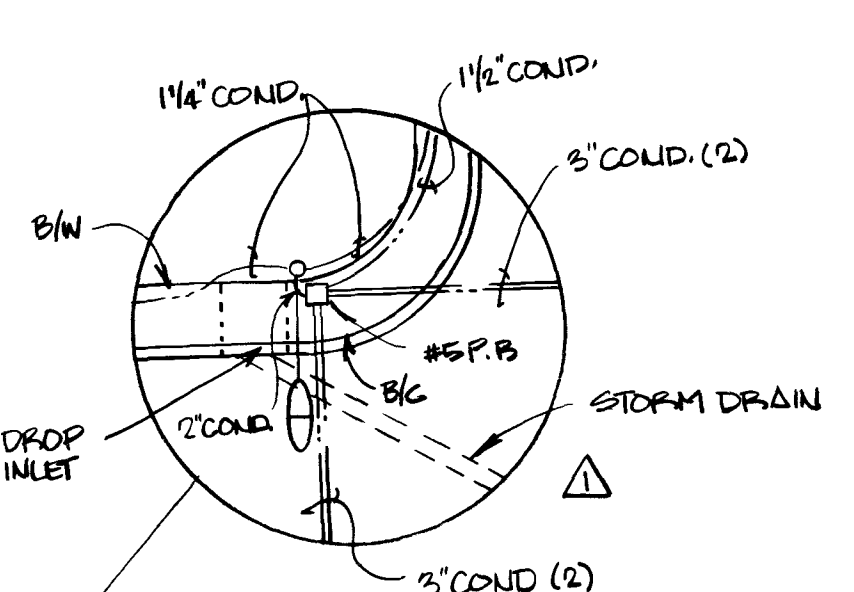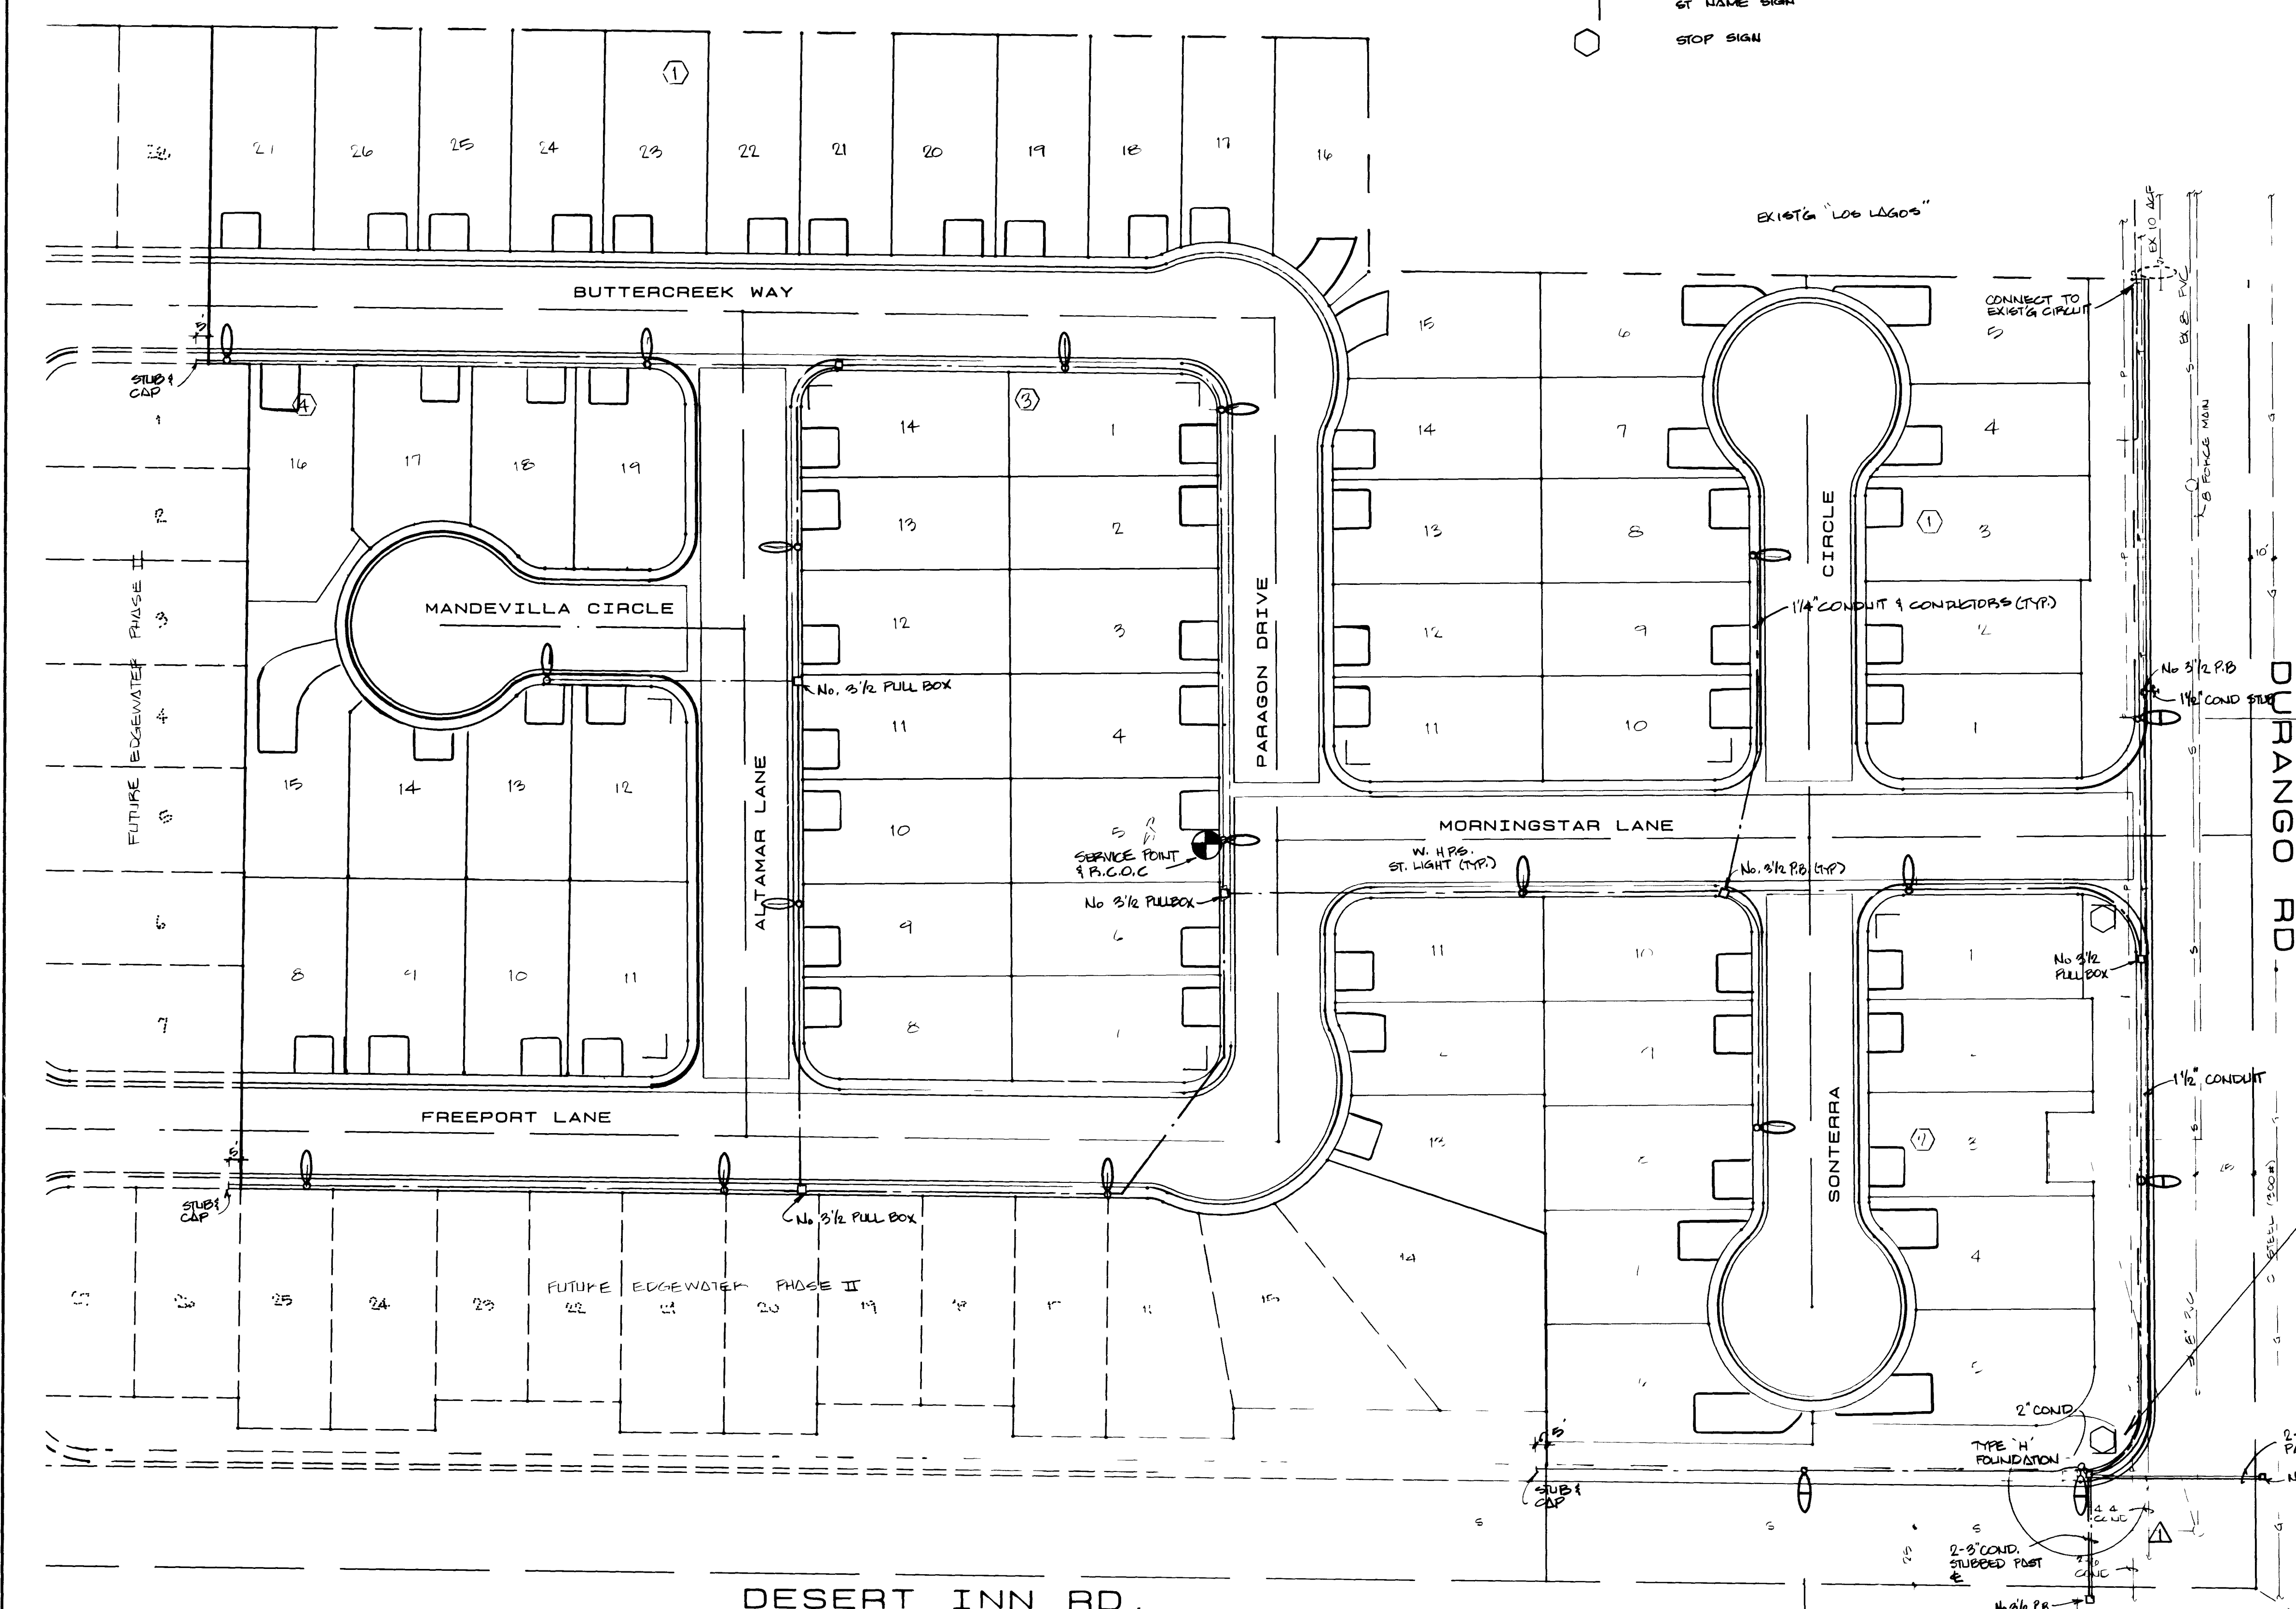

C L V STREETLIGHT NOTES

- ALL STREET LIGHT INSTALLATIONS SHALL CONFORM TO THE STANDARD DETAILS AND SPECIFICATIONS OF THE CITY OF LAS VEGAS, AND SHALL ALSO CONFORM TO THE INTERNATIONAL STANDARD SPECIFICATIONS FOR PUBLIC WORKS CONSTRUCTION OF OFF-SITE IMPROVEMENTS, CLARK COUNTY AREA, LATEST EDITION, UNLESS OTHERWISE NOTED.

ST. LIGHT ESTIMATE

250 W.H.P.S. POLE, FOUNDATION & LUMINAIRE	4 EA *
1250 W.H.P.S. POLE, FOUNDATION & LUMINAIRE	15 EA
No. 3/4" PULL BOX	2 EA
SERVICE PT. & P.C.O.C.	1 EA
1/4" PVC CONDUIT & CONDUITOPS	304 L.F.
No. 3 PULL BOX	1 EA
3" CONDUIT	280 L.F.
1/2" CONDUIT	350 L.F.
* POLES & FIXTURES TO BE THE TYPE APPROVED FOR "THE LAKES" PROJECT.	
* THE STREETLIGHT LOCATED @ D.I. & DURANGO SHALL BE CONSTRUCTED W/ A TYPE H FOUNDATION	

EXISTING UTILITIES ARE LOCATED ON PLANS FOR THE CONVENIENCE OF THE CONTRACTOR ONLY. THE ENGINEER BEARS NO RESPONSIBILITY FOR THE LOCATION OF UTILITIES SHOWN OR NOT SHOWN ON THE PLANS. THE CONTRACTOR SHALL NOTIFY ALL UTILITY COMPANIES BEFORE STARTING CONSTRUCTION AND IT SHALL BE THE RESPONSIBILITY OF THE CONTRACTOR TO VERIFY THE LOCATION OF ALL UTILITIES WITH THE UTILITY COMPANIES.

5802

4-178 2074-4000-1

