
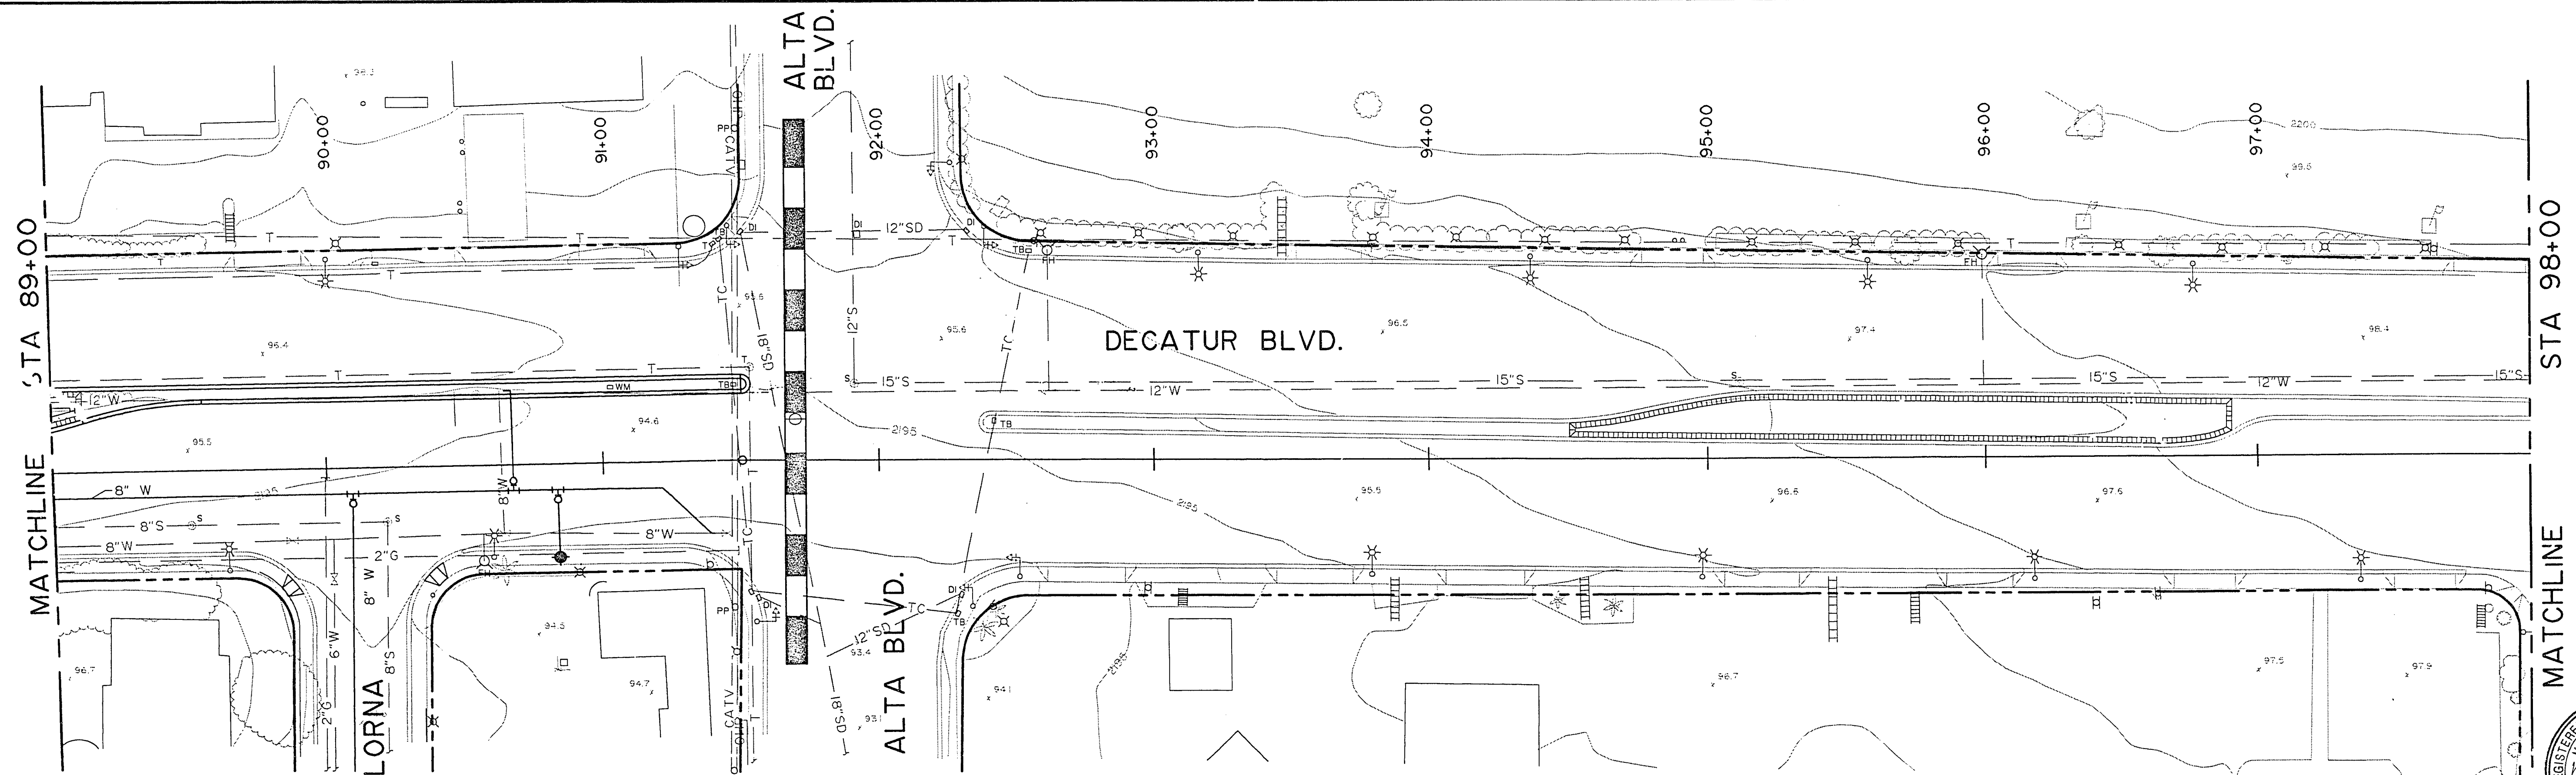


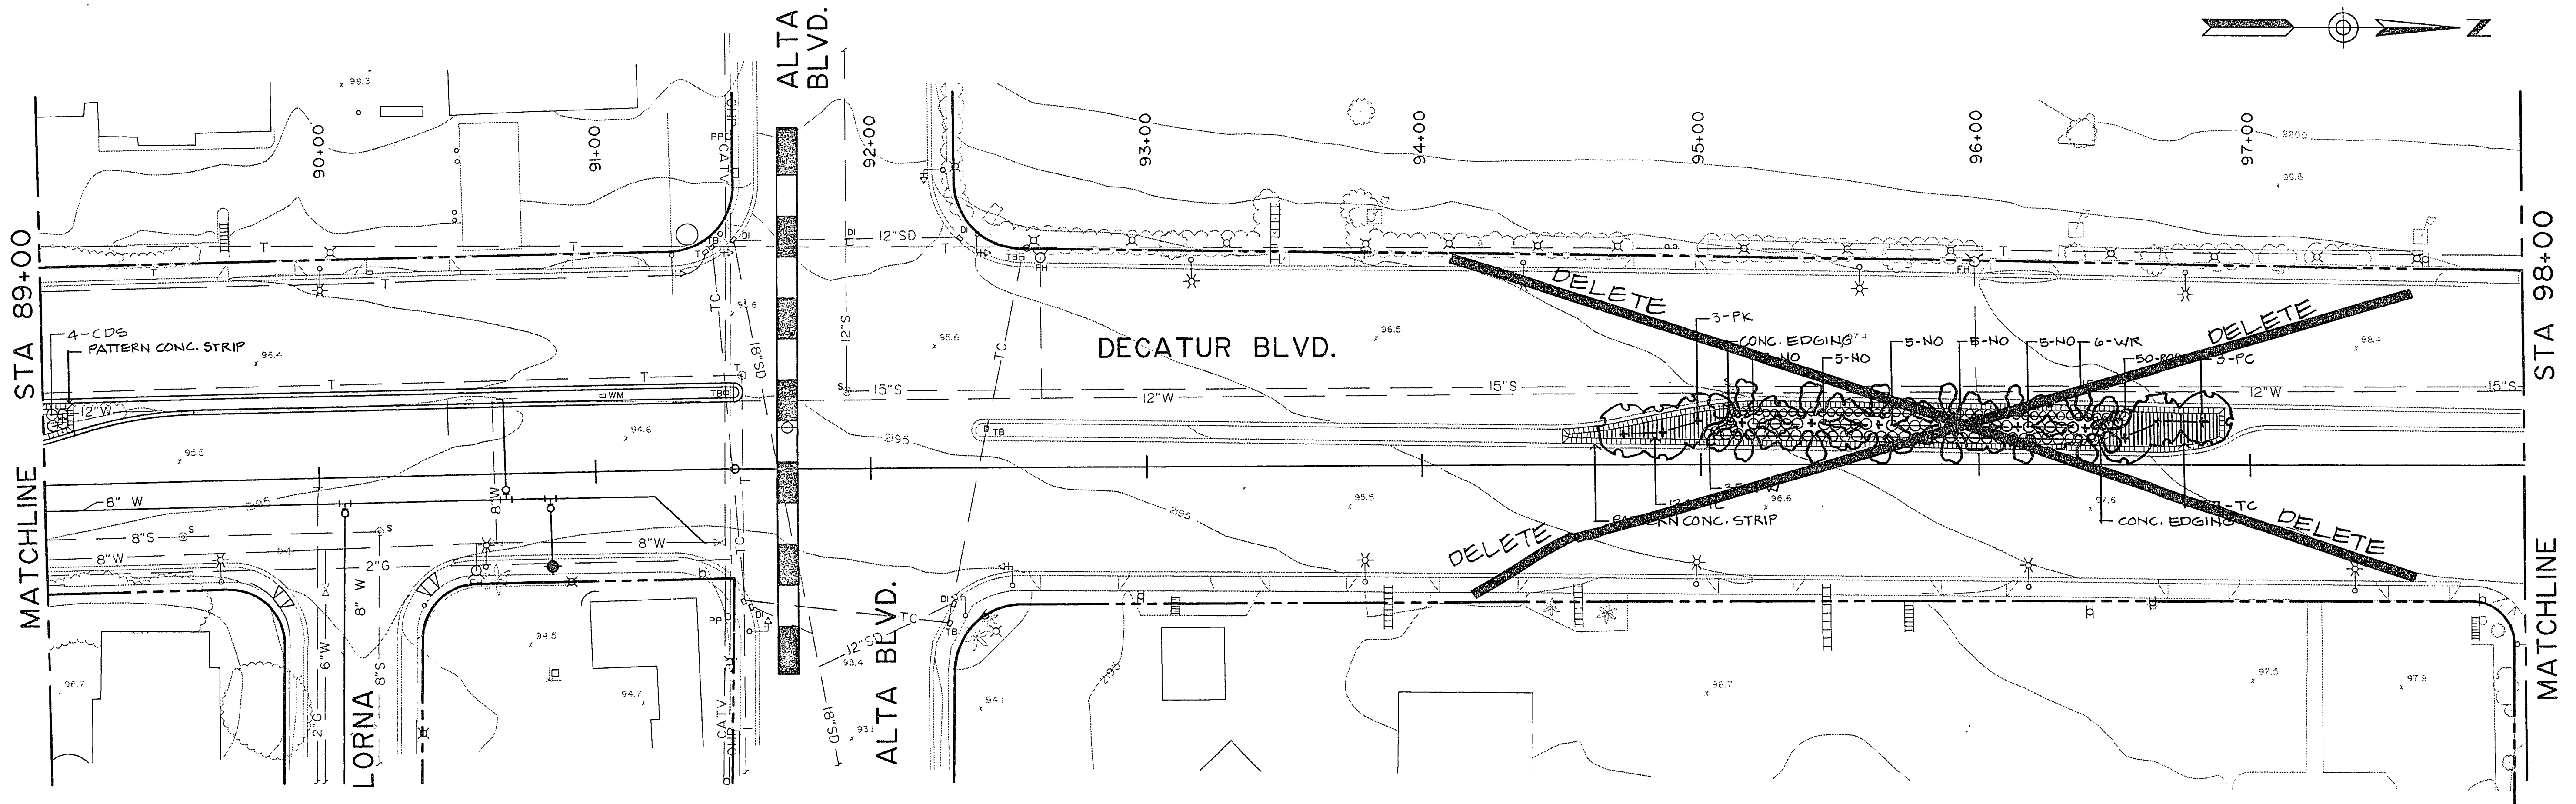

				Job No. 40930	Designed by MKH	Proj. Eng. S.N.T.	URS CONSULTANTS, INC. Engineering and Environmental Consultants Las Vegas, Nevada	CITY OF LAS VEGAS Decatur Boulevard Rehabilitation Project	LANDSCAPE AND IRRIGATION PLAN STA 89+00 TO STA 98+00	Sheet L 5
				Scale: 1" = 30'	Drawn by MKH	Approved by J.E.R.				
No. DATE BY REVISION					Checked by S.N.T.	Date				