


CONSTRUCTION NOTES

- 1 REMOVE EXISTING CURB & GUTTER. INSTALL NEW 24" "L" TYPE CURB & GUTTER PER USD NO. 216.
- 2 INSTALL TYPE "A" CURB PER USD NO. 218 & 219. FOR MEDIAN DETAILS, SEE SHT-G-3, R-13 THRU R-15 AND L-1 THRU L-12.
- 3 REMOVE EXISTING DRIVEWAY. INSTALL NEW DRIVEWAY PER USD NO. 223.
- 4 REMOVE EXISTING CROSS GUTTER. INSTALL NEW CROSS GUTTER PER USD NO. 228.
- 5 REMOVE EXISTING PARTIAL CROSS GUTTER. CONSTRUCT NEW AC PAVEMENT IN ACCORDANCE WITH SHT G-3.
- 6 REMOVE EXISTING SIDEWALK. INSTALL NEW SIDEWALK PER USD NO. 234.
- 7 REMOVE EXISTING SIDEWALK. HORIZONTALLY SAWCUT CURB FACE AND INSTALL WHEELCHAIR RAMP PER USD NO. 235.
- 8 INSTALL NEW TYPE 1 MANHOLE PER USD NO. 403.
- 9 CONSTRUCT PRECAST MANHOLE TEE PER USD NO. 407.
- 10 ADJUST MANHOLE RIM AND INSTALL CIRCULAR CONCRETE MANHOLE COLLAR PER USD NO. 408.
- 11 REMOVE EXISTING SQUARE CONCRETE COLLAR, ADJUST MANHOLE RIM AND INSTALL CIRCULAR CONCRETE MANHOLE COLLAR PER USD NO. 408.
- 12 REMOVE EXISTING CIRCULAR MANHOLE COLLAR, ADJUST MANHOLE RIM AND INSTALL NEW CIRCULAR CONCRETE MANHOLE COLLAR PER USD NO. 408.
- 13 ADJUST CONCRETE VALVE BOX RIMS AND INSTALL NEW CIRCULAR CONCRETE VALVE BOX COLLARS PER USD NO. 517.
- 14 REMOVE EXISTING LOOP DETECTOR. SEE TRAFFIC PLANS FOR REINSTALLATION OF LOOPS.
- 15 INSTALL TYPE "C" DROP INLET PER USD NO. 413.
- 16 SAWCUT EXISTING ASPHALT/CONCRETE AS SHOWN.
- 17 MATCH EXISTING ASPHALT/CONCRETE.
- 18 MATCH EXISTING PAVEMENT AT CURB RETURNS.
- 19 INSTALL 48" RCP.
- 20 INSTALL 18" RCP.
- 21 PROPOSED LVVWD WATER LINE. TO BE CONSTRUCTED BY OTHERS.
- 22 REMOVE EXISTING DRIVEWAY, CURB & GUTTER AND SIDEWALK. INSTALL NEW CROSS GUTTER AND DRIVEWAY PER USD NO. 228 AND SHT R-15 MEDIAN DETAIL 3.
- 23 INSTALL 36" RCP.
- 24 MATCH EXISTING ISLAND AT STRIGHT GRADE.

REVISED TO CONFORM WITH CONSTRUCTION RECORDS
 By: G.P.R.
 Ck'd: J.P.J.
 Date: 5-25-92

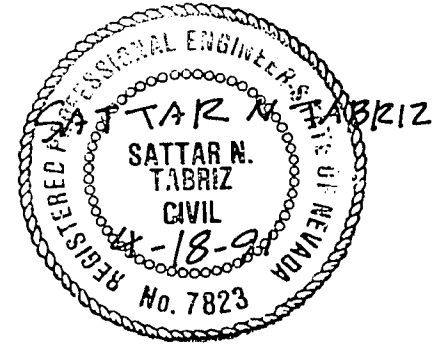

No.	DATE	BY	REVISION

Job No. 40930
 Scale: 1"=30' HOR, 1"=1' VERT
 Designed by R.T.J./J.P.J.
 Drawn by K.P.C./R.T.J.
 Checked by S.N.T.
 Date APRIL 1991

URS CONSULTANTS, INC.
 Engineering and Environmental Consultants
 Las Vegas, Nevada

CITY OF LAS VEGAS
 Decatur Boulevard Rehabilitation Project

ROADWAY IMPROVEMENTS
 PLAN AND PROFILE
 STA 53+00 TO STA 62+00

Sheet
R
6