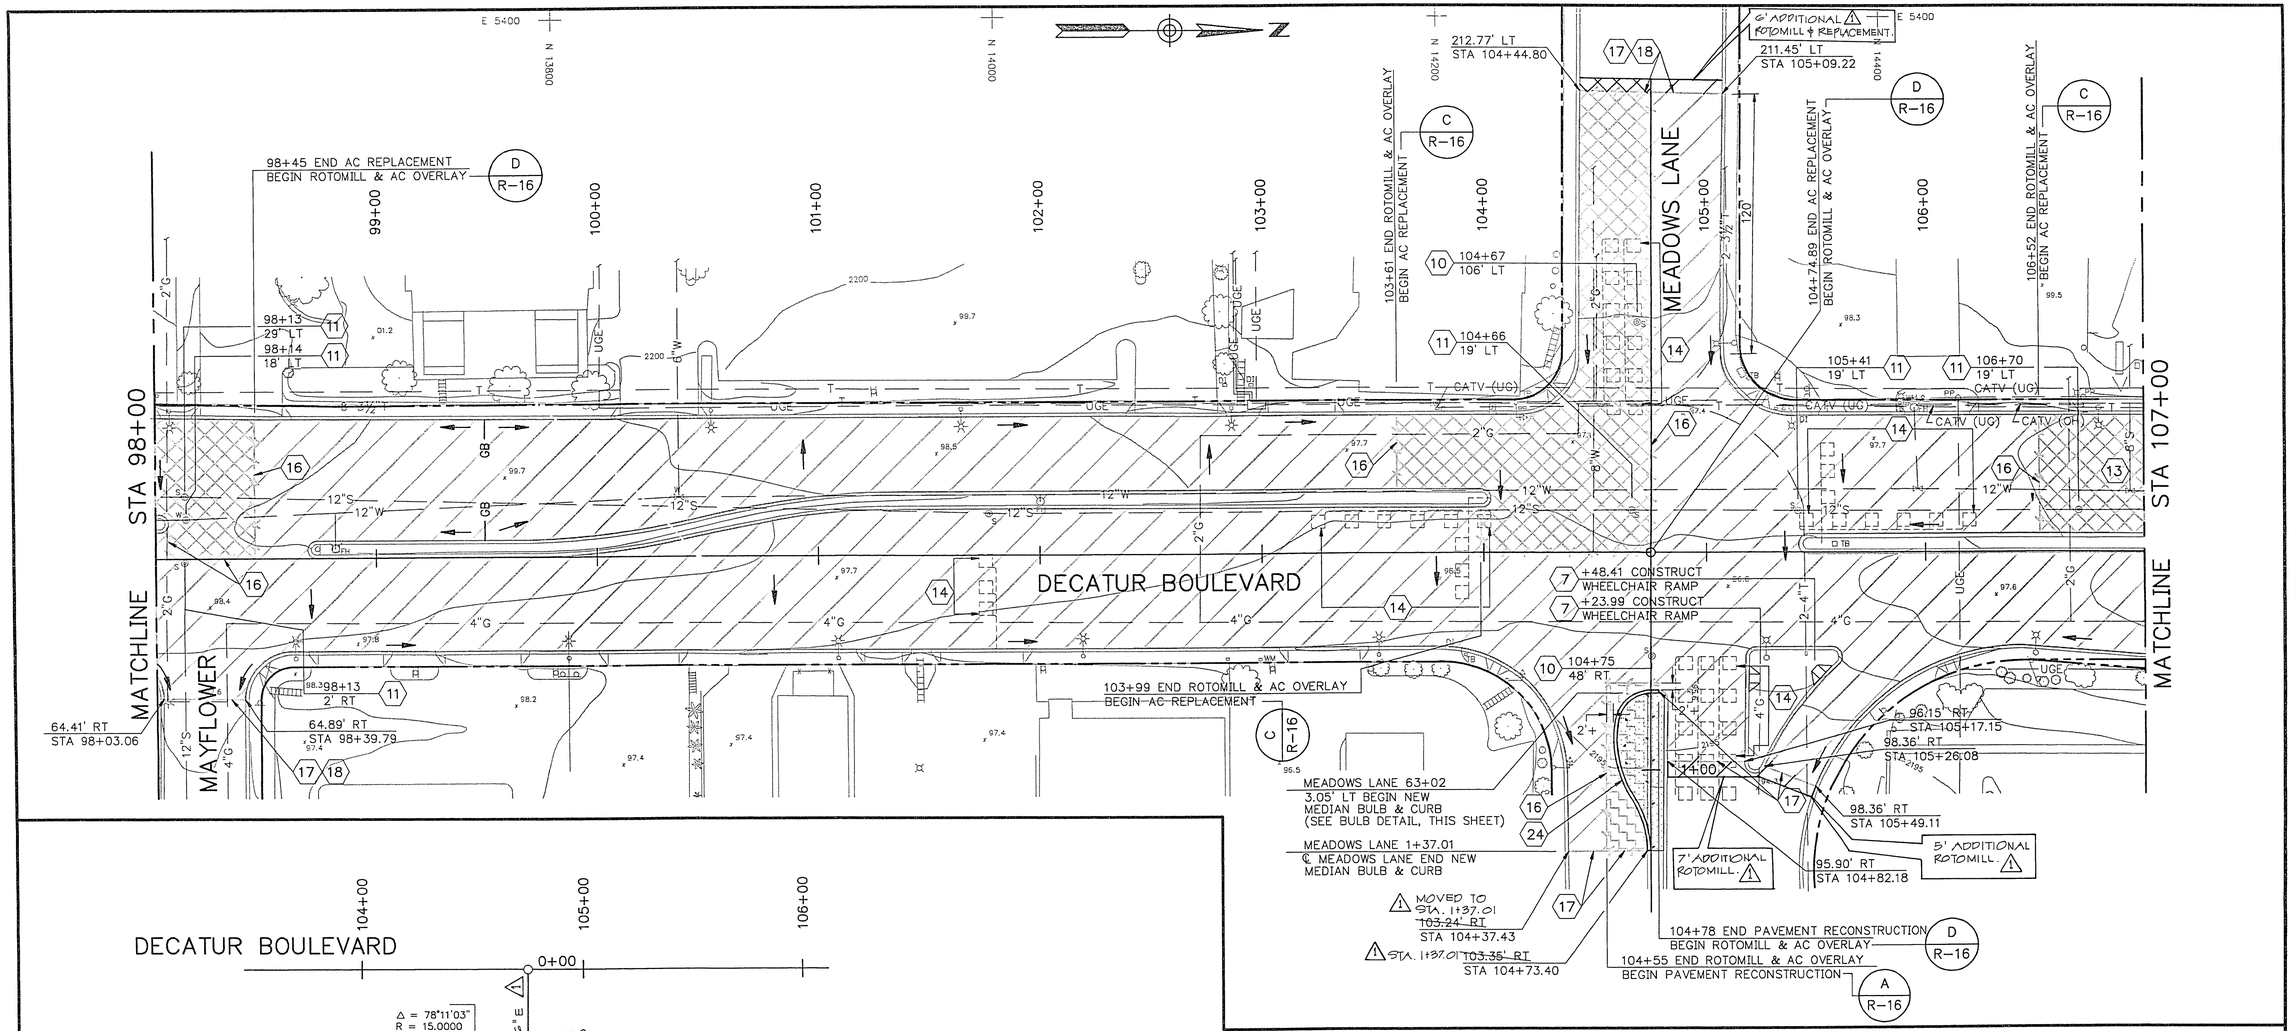

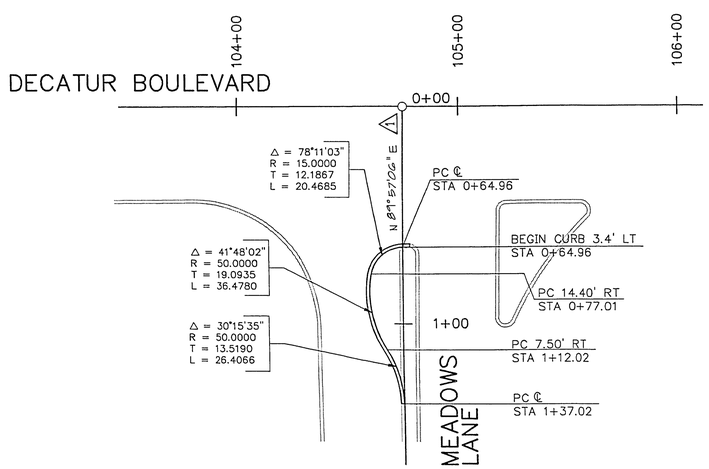

BULB DETAIL

REVISED TO CONFORM WITH CONSTRUCTION RECORDS
By: G.P.R.
Ck'd: J.P.J.
Date: 3-30-92

SATTAR N. TASRIZ
CIVIL
No. 7823
REGISTERED PROFESSIONAL ENGINEER
STATE OF NEVADA

No.	DATE	BY	REVISION
1	3-30-92	G.P.R.	REVISED TO CONFORM W/ CONSTRUCTION RECORDS.

Job No. 40930
Scale: 1"=30' HOR, 1"=1' VERT
Designed by R.T.J., J.P.J.
Drawn by K.P.C./R.T.J.
Checked by S.N.T.
Proj. Eng. S.N.T.
Approved by J.E.R.
Date APRIL 1991

URS CONSULTANTS, INC.
Engineering and Environmental Consultants
Las Vegas, Nevada

CITY OF LAS VEGAS
Decatur Boulevard Rehabilitation Project

ROADWAY IMPROVEMENTS
PLAN AND PROFILE
STA 98+00 TO STA 107+00

Sheet R / 11

24-3-16 **107 - V1851** **16/51**