


**ROADWAY TRAFFIC DELINEATION LEGEND**

- |   |   |
|---|---|
| ① REPLACE EXISTING LANE DELINEATION AS PER USD NO.246.                      | ⑦ REPLACE EXISTING "ONLY" LEGEND PER MARKING SPECIFICATIONS.                            |
| ② REPLACE EXISTING LEFT TURN LANE DELINEATION AS PER USD NO.246.            | ⑧ REPLACE EXISTING LOOP DETECTORS PER STANDARD SPECIFICATION NO.623.                    |
| ③ REPLACE EXISTING LEFT TURN AND THROUGH SYMBOL PER MARKING SPECIFICATIONS. | ⑨ REPLACE 4" WHITE CONTINUOUS PAINT LINE PER MANUAL OF UNIFORM TRAFFIC CONTROL DEVICES. |
| ④ REPLACE EXISTING CROSSWALK PER MARKING SPECIFICATIONS.                    | ⑩ INSTALL MEDIAN NOSE MARKING PER USD NO.248.   |
| ⑤ REPLACE EXISTING STOP BAR PER MARKING SPECIFICATIONS.                     | ⑪ REPLACE EXISTING TYPE I CENTERLINE PER USD NO.244.                                    |
| ⑥ REPLACE EXISTING LEFT TURN SYMBOL PER MARKING SPECIFICATIONS.             | ⑫ MATCH EXISTING LANE MARKING AND DELINEATION.  |

REVISED TO CONFORM WITH CONSTRUCTION RECORDS  
 By: G.P.R.  
 Ck'd: J.P.J.  
 Date: 3-31-92

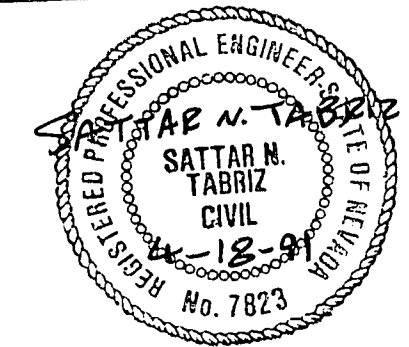

3-31-92	G.P.R.	REVISED TO CONFORM W/ CONSTRUCTION RECORDS.
No.	DATE	BY
		REVISION

Job No. 40930	Designed by S.N.T.	Proj. Eng. S.N.T.
Scale: 1" = 30'	Drawn by K.P.C.	Approved by J.E.R.
	Checked by S.N.T.	Date APRIL 1991

**URS CONSULTANTS, INC.**  
 Engineering and Environmental Consultants  
 Las Vegas, Nevada

**CITY OF LAS VEGAS**  
 Decatur Boulevard Rehabilitation Project

ROADWAY TRAFFIC PLAN  
 STA 26+00 TO STA 35+00

Sheet  
 T  
 3