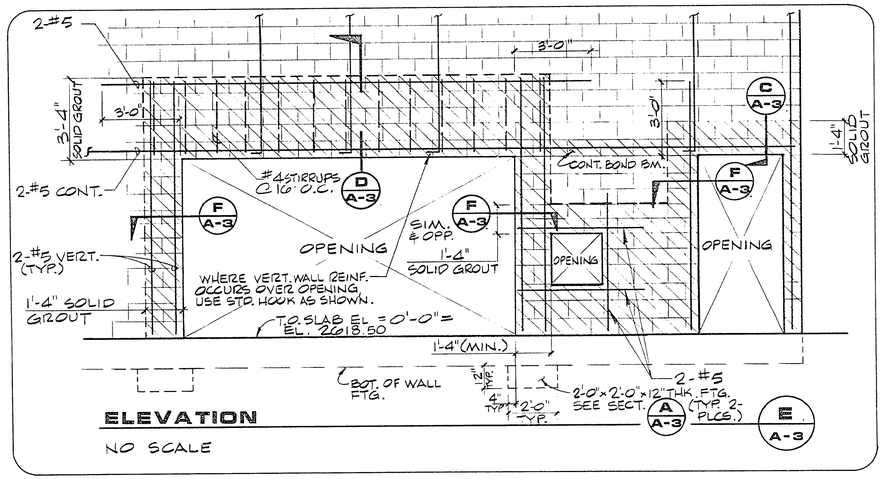

ELEVATION
NO SCALE

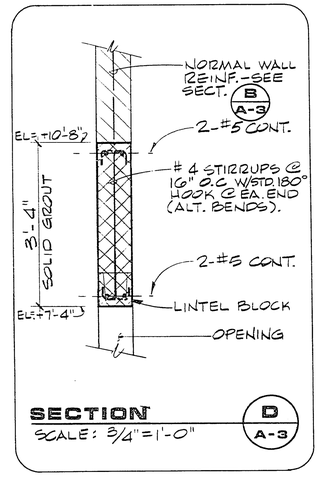

SECTION D A-3
SCALE: 3/4" = 1'-0"

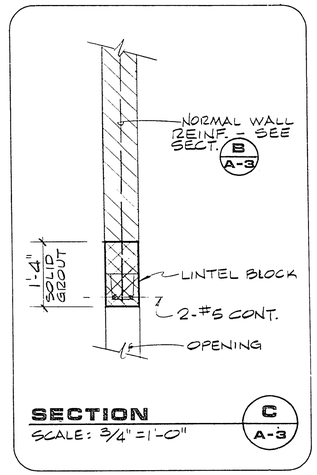

SECTION C A-3
SCALE: 3/4" = 1'-0"

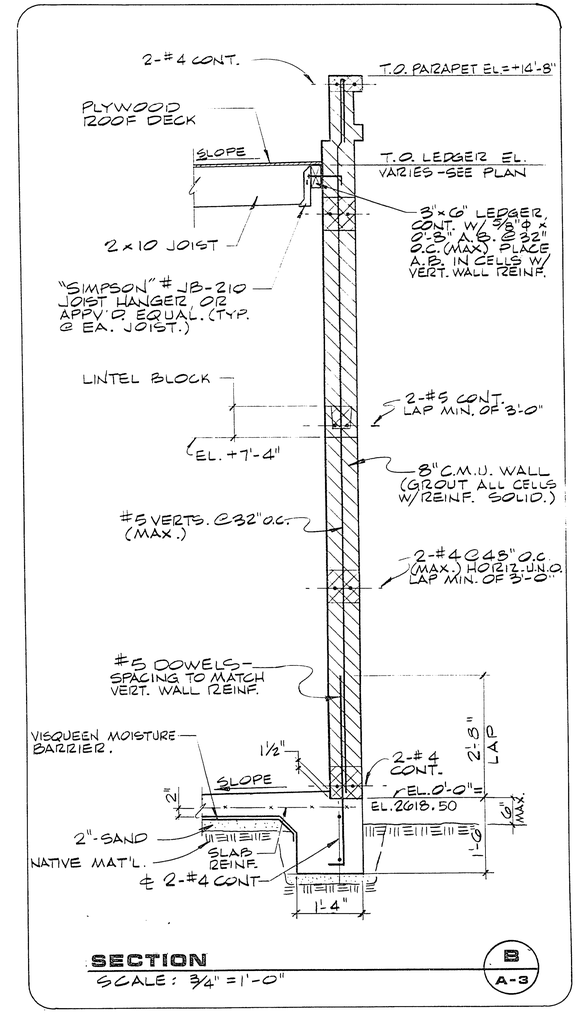

SECTION B A-3
SCALE: 3/4" = 1'-0"

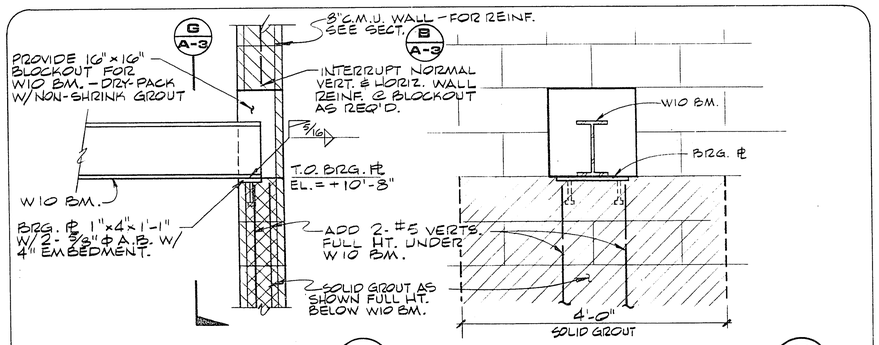

SECTION H A-3
SCALE: 1" = 1'-0"

SECTION G A-3
SCALE: 1" = 1'-0"

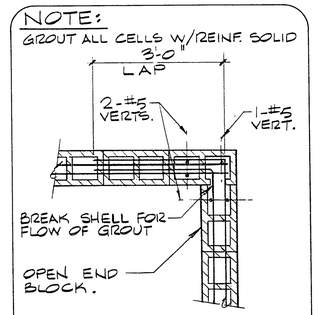

TYP. C.M.U. WALL CORNER DETAIL 1 A-3
NO SCALE

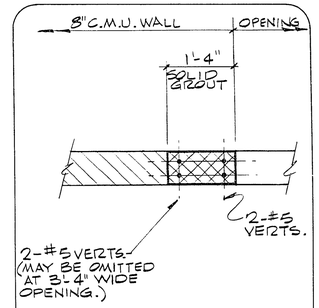

SECTION F A-3
SCALE: 3/4" = 1'-0"

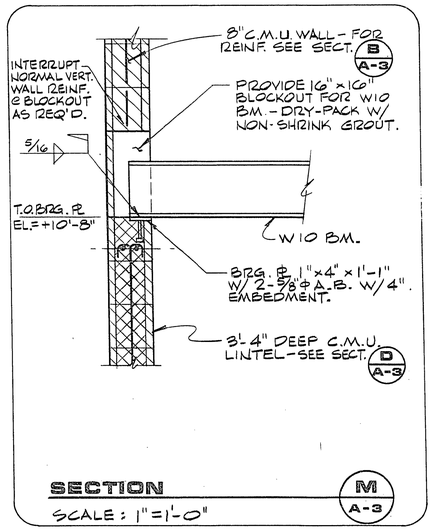

SECTION M A-3
SCALE: 1" = 1'-0"

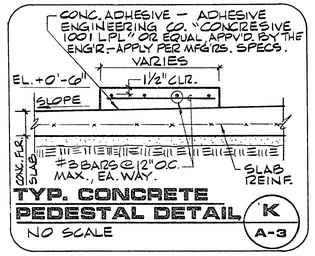

TYP. CONCRETE PEDESTAL DETAIL K A-3
NO SCALE

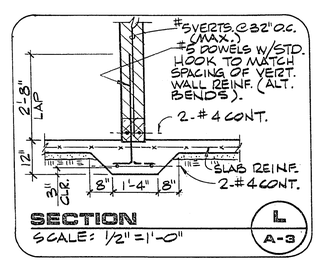

SECTION L A-3
SCALE: 1/2" = 1'-0"

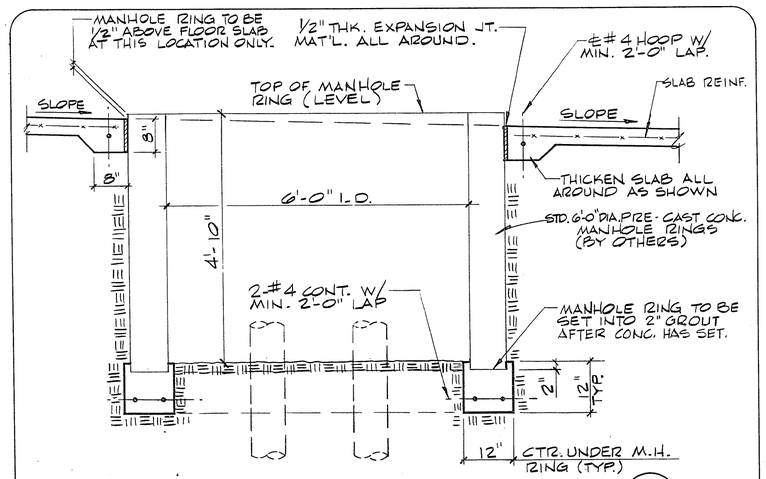

TYP. SECTION THRU PUMP PIT J A-3
SCALE: 3/4" = 1'-0" (ALTERNATE "B" ONLY)

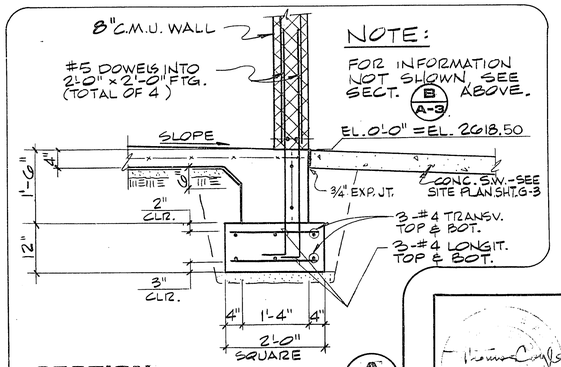

SECTION A A-3
SCALE: 3/4" = 1'-0"

AS BUILT DRAWING

REV	DATE	DESCRIPTION
1	11/1/85	AS BUILT NO REVISIONS

RECOMMENDED

R.E. NO DATE

G. C. WALLACE
Consulting Engineers, Inc.
1555 South Rainbow Blvd. • Las Vegas, Nevada 89102 • 363-1200

CITY OF LAS VEGAS
DURANGO DRIVE LIFT STATION
MISCELLANEOUS DETAILS

SHEET **A-3** OF 15 SHEETS

3-15-85

JOB NO. 412.150

8/84 DIETERICH POST 6532B

22-1-14 307-V578