


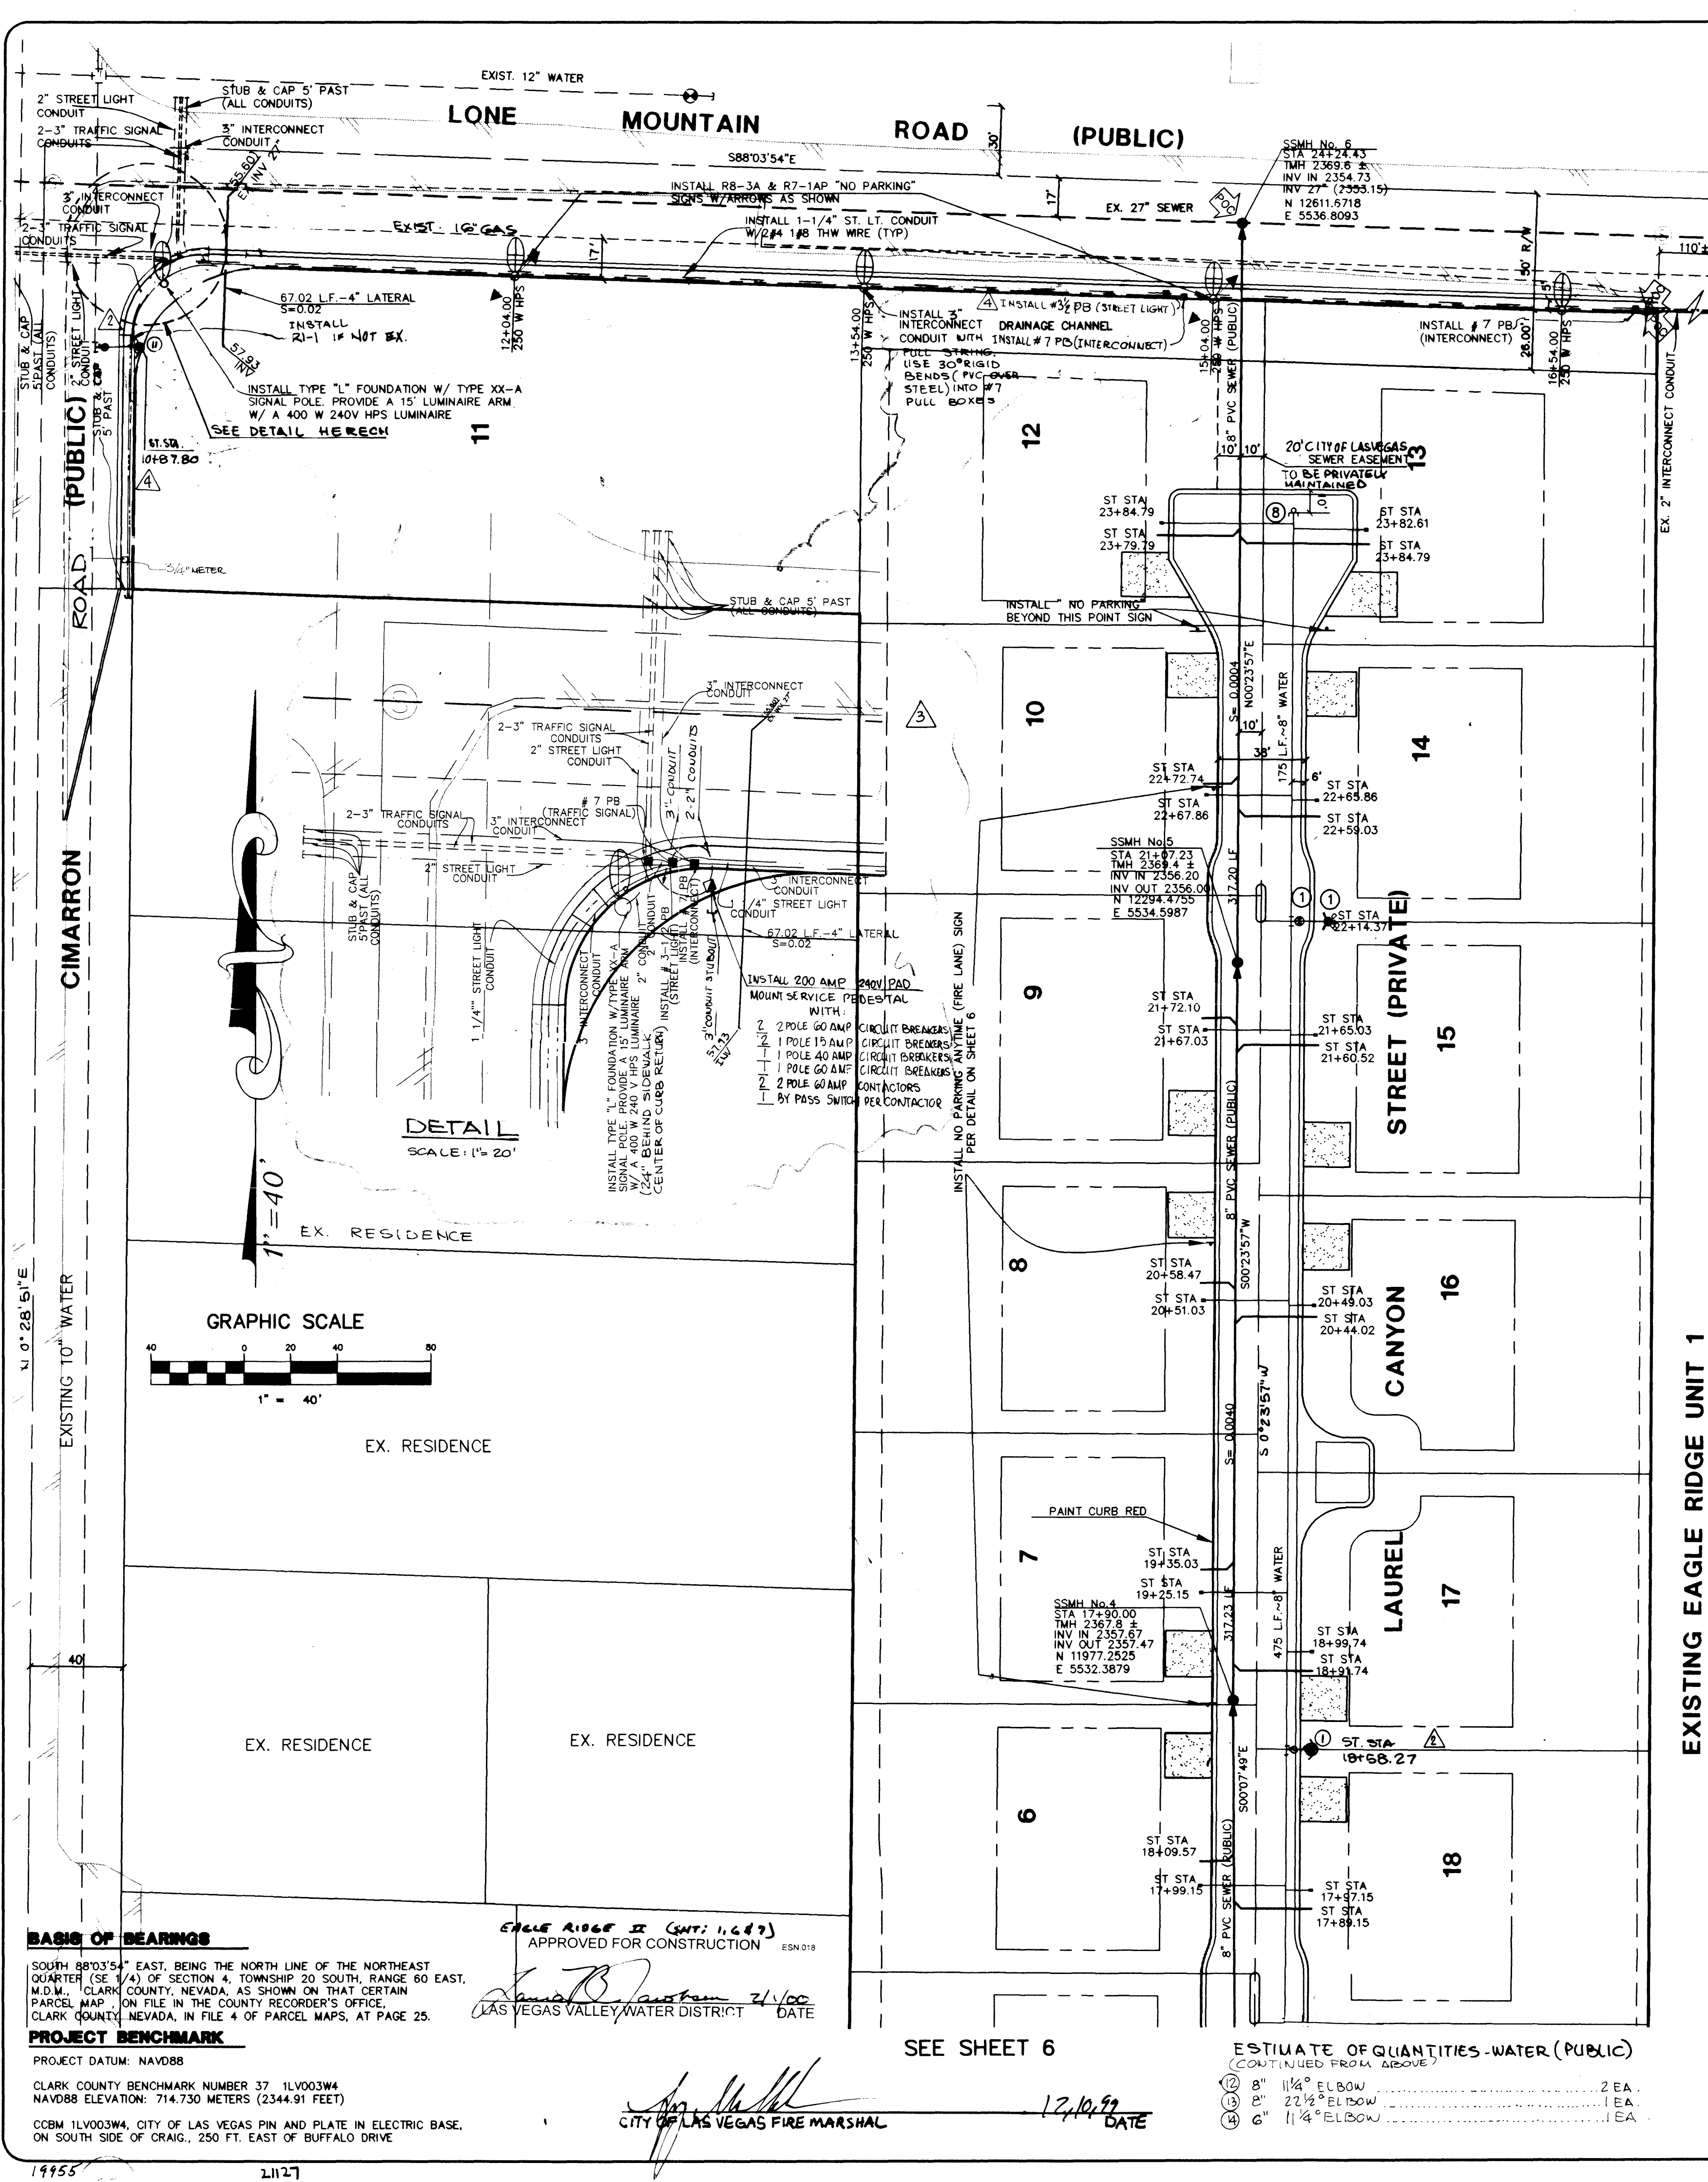

CLARK COUNTY SANITATION DISTRICT GENERAL NOTES

- ALL CONSTRUCTION AND MATERIALS SHALL BE IN ACCORDANCE WITH THE LATEST EDITION OF THE DESIGN & CONSTRUCTION STANDARDS OF THE CLARK COUNTY SANITATION DISTRICT AND THE UNIFORM STANDARD SPECIFICATIONS FOR PUBLIC WORKS CONSTRUCTION OFFSITE IMPROVEMENTS, CLARK COUNTY AREA, NEVADA. IN ALL CASES, THE DISTRICT'S CRITERIA SHALL SUPERSEDE THE UNIFORM STANDARD SPECIFICATIONS. IT WILL BE THE RESPONSIBILITY OF THE CONTRACTOR TO BE AWARE OF THE CONTENTS OF THE ABOVE SPECIFICATION BOOKS.
- CLARK COUNTY SANITATION DISTRICT'S STANDARD DRAWINGS SHALL APPLY TO ALL CONSTRUCTION.
- SEWER MAINS ONLY TO BE LAID IN SEWER TRENCHES.
- ALL 4" HOUSE LATERALS TO BE LAID AT NOT LESS THAN MINIMUM SLOPES AS SHOWN IN THE DISTRICT'S STANDARDS.
- IT SHALL BE THE CONTRACTOR'S RESPONSIBILITY TO PERFORM CONSTRUCTION AS PER PLANS, ANY ADDITIONS, DELETIONS, OR CHANGES SHALL FIRST MEET WITH THE APPROVAL OF THE CLARK COUNTY SANITATION DISTRICT.
- SOIL TESTING SHALL BE IN ACCORDANCE WITH SECTION 3.11 OF THE CONSTRUCTION STANDARDS OF THE DISTRICT'S DESIGN AND CONSTRUCTION STANDARDS.
- ALL EXFILTRATION, INFILTRATION, AND AIR TESTING OF LINES SHALL BE IN ACCORDANCE WITH THE DISTRICT'S DESIGN AND CONSTRUCTION STANDARDS.
- CUT SHEETS MUST BE SUBMITTED TO THE DISTRICT BEFORE CONSTRUCTION WILL BE PERMITTED TO START.
- ALL CONTRACTORS INSTALLING SEWER MAINS THAT WILL BE UNDER JURISDICTION OF THE DISTRICT MUST BE CLASS "A" CONTRACTORS.

FIRE FLOW CALCULATIONS

FIRE FLOW REQUIREMENT IS 1750 GALLONS PER MINUTE AT 20 PSI RESIDUAL PRESSURE.

BASED ON:

SQUARE FOOTAGE: 4800 MAX. SQ. FT.

LARGEST AREA BETWEEN 4-HOUR AREA SEPARATION WALLS: N/A. SQ. FT.

BUILDING HEIGHT: FEET

NUMBER OF STORIES: 1 & 2

TYPE OF CONSTRUCTION: V

OCCUPANCY:

FULL AUTOMATIC FIRE SPRINKLER SYSTEM: N/A

REVIEWED BY: *[Signature]*

DATE: 10-12-99

LAS VEGAS VALLEY WATER DISTRICT STANDARD NOTES

- NO WORK SHALL BEGIN UNTIL THE WATER PLANS HAVE BEEN RELEASED FOR CONSTRUCTION BY THE LVVWD. FOLLOWING WATER PLAN APPROVAL, HOUR NOTICE SHALL BE GIVEN TO THE LVVWD COMMUNICATIONS CENTER (258-7171) PRIOR TO THE START OF CONSTRUCTION. NOTICE MUST BE GIVEN BY 2:00 P.M. THE BUSINESS DAY PRIOR TO A LVVWD INSPECTION.
- ALL WORK SHALL CONFORM TO LVVWD STANDARD PLATES, DRAWINGS, AND SPECIFICATIONS, AND THE UNIFORM DESIGN AND CONSTRUCTION STANDARDS FOR WATER DISTRIBUTION SYSTEMS (UDACS), LATEST EDITION.
- ALL WORK, EXCEPT AS MODIFIED BY THESE PLANS OR BY NOTE 2, SHALL BE DONE IN ACCORDANCE WITH THE MOST CURRENT DRAFT OR EDITION OF THE UNIFORM STANDARD SPECIFICATIONS FOR PUBLIC WORKS CONSTRUCTION OFFSITE IMPROVEMENTS, CLARK COUNTY AREA.
- A SINGLE PIPE MATERIAL SHALL BE USED THROUGHOUT THE PROJECT UNLESS OTHERWISE APPROVED BY THE LVVWD.
- ALL SERVICE LATERALS TWO (2) INCHES IN DIAMETER AND SMALLER SHALL BE COPPER TUBING WITH LVVWD APPROVED SERVICE SADDLES.
- ALL WATER METER BOXES SHALL BE LOCATED OUTSIDE OF DRIVEWAY AREAS.
- ALL VALVES SHALL BE LOCATED OUTSIDE OF DRIVEWAYS, VALLEY AND CURB GUTTERS.
- THE FOLLOWING REQUIREMENTS MUST BE MET IN THE EVENT A WATER LINE AND A SANITARY OR STORM SEWER LINE CROSS:
 - A MINIMUM EIGHTEEN (18) INCH VERTICAL SEPARATION (OUTSIDE TO OUTSIDE) MUST BE MAINTAINED WHEN THE WATER LINE IS INSTALLED OVER THE SANITARY OR STORM SEWER LINE. IF THE VERTICAL SEPARATION CANNOT BE MAINTAINED OR THE WATER LINE MUST BE PLACED UNDER THE SANITARY OR STORM SEWER LINE, THE SANITARY OR STORM SEWER LINE MUST BE CONSTRUCTED WITH ONE OF THE FOLLOWING OR AS SHOWN ON THESE PLANS:
 - POTABLE WATER SUPPLY QUALITY MATERIAL.
 - ENCASEMENT, WITH FOUR (4) INCH CONCRETE (MINIMUM).
 - SLEEVING WITH POTABLE WATER SUPPLY QUALITY PIPE.
- EACH PROVISION MUST EXTEND ALONG THE SANITARY OR STORM SEWER, ON EITHER SIDE OF THE MAIN, A MINIMUM 10 FOOT DISTANCE PERPENDICULAR TO THE WATER MAIN EXTERIOR.
- WARNING TAPE SHALL BE REQUIRED OVER ALL MAINS, ALL SIX (6) INCH DIAMETER AND LARGER SERVICE LATERALS, AND ANY SERVICE LATERAL NOT INSTALLED PERPENDICULAR TO THE MAIN IN ACCORDANCE WITH STANDARD PLATE NO. 27.
- ALL WATER FACILITIES SHALL BE FILLED, DISINFECTED, PRESSURE TESTED, FLUSHED, FILLED AND AN ACCEPTABLE WATER SAMPLE OBTAINED PRIOR TO CONNECTION TO THE LVVWD'S DISTRIBUTION SYSTEM.
- THE CONTRACTOR MUST OBTAIN ALL METERS TWO (2) INCHES AND SMALLER FROM LVVWD CENTRAL STORES. TELEPHONE 258-3152 FORTY-FOUR (44) HOURS PRIOR TO PICKUP.
- CONSTRUCTION MAY INTERRUPT SERVICE, WITH LVVWD APPROVAL AND PROPER NOTIFICATION, BETWEEN THE HOURS OF 10 PM AND 6 AM, SUNDAY THROUGH THURSDAY. CIRCUMSTANCES MAY REQUIRE TEMPORARY SERVICE FEEDS BE INSTALLED, WITHOUT LVVWD REIMBURSEMENT. ANY TEMPORARY SERVICE FEED MUST HAVE PRIOR LVVWD APPROVAL.
- ALL WATER FACILITY CONSTRUCTION MATERIALS USED MUST BE AS LISTED ON THE LVVWD'S PRE APPROVED MATERIALS AND MANUFACTURERS LISTING FOR NEW FACILITIES, LATEST REVISION, OR SPECIFICALLY APPROVED ON THESE PLANS.

ESTIMATE OF QUANTITIES

WATER (PUBLIC)	
1 FIRE HYDRANT ASSEMBLY.....	3 EA.
2 PER UDS PLATE NO. 7.....	
3 8" x 8" MECHANICAL JOINT TAPPING TEE WITH.....	1 EA.
4 8" 45° ELBOW.....	2 EA.
5 8" GATE VALVE.....	1 EA.
6 8" GATE VALVE.....	1 EA.
7 8" GATE VALVE.....	1 EA.
8 8"x8"x6" TEE.....	1 EA.
9 2" MANUAL BLOW-OFF ASSEMBLY.....	2 EA.
SEWER (PUBLIC)	
10 8" 22' 1/2".....	1 EA.
11 8" WATER MAIN.....	1,364 LF.
12 6" WATER MAIN.....	190 LF.
13 1" SERVICE W/ 3/4" METER.....	23 EA.
14 3/4" IRRIGATION METER.....	1 EA.
15 FIRE HYDRANT ASSEMBLY (INCLUDES 8" GATE VALVE, TAPPING TEE, 1/2" RIGID).....	2 EA.
SEWER (PUBLIC) (CONTINUES BELOW)	
16 STANDARD MANHOLE 4' DIA.....	9 EA.
17 8" SEWER MAIN.....	1,894 LF.
18 4" SEWER LATERALS.....	23 EA.
19 6" SEWER LATERALS.....	0 EA.
20 SEWER BACKWATER VALVE.....	1 EA.
21 PER CLARK CO. SANITATION DISTRICT DNG # SD-29.....	

SEWER CONTRIBUTION RATE

AVERAGE DAILY FLOW.....	0.0133 MGD
PEAK FLOW.....	0.0451 MGD

CLARK COUNTY SANITATION DISTRICT

SIGNATURE ON THESE PLANS SHALL NOT BE CONSIDERED TO BE A PERMIT FOR OR AN APPROVAL OF ANY VIOLATION OF CLARK COUNTY SANITATION DISTRICT RULES, REGULATIONS, OR DESIGN AND CONSTRUCTION STANDARDS. THE APPROVAL OF THESE PLANS DOES NOT GUARANTEE CAPACITY IN THE DISTRICT'S COLLECTION OR TREATMENT SYSTEM.

POC POINT OF CONNECTION TO EXISTING UTILITIES

DRIVEWAY LOCATION (SCHEMATIC ONLY)

CLARK COUNTY FIRE DEPARTMENT GENERAL NOTES

- ALL WORK SHALL BE DONE IN STRICT ACCORDANCE WITH THE CLARK COUNTY ORDINANCE #1167, NFPA #24, 1987 EDITION OF THE UNIFORM FIRE CODE.
- ON ANY BUILDING CONSTRUCTION SITE, ACCESSIBLE FIRE HYDRANTS SHALL BE INSTALLED BEFORE COMBUSTIBLE MATERIALS ARE DELIVERED TO THE SITE AND CONSTRUCTION COMMENCES. SAID FIRE HYDRANTS SHALL BE IN GOOD WORKING ORDER WITH REQUIRED WATER SUPPLY.
- IF DURING CONSTRUCTION IT BECOMES NECESSARY TO CLOSE ANY CONTROL VALVE OR PLACE A HYDRANT OUT OF SERVICE, THE CLARK COUNTY FIRE DEPARTMENT SHALL BE NOTIFIED.
- PAINTING OF CURBS AND/OR STRIPING OF ASPHALT AREAS AND PROTECTION OF HYDRANTS FROM PHYSICAL INJURY, PER FIRE INSTALLATION SPECIFICATIONS.
- NO FIRE HYDRANT SHALL BE LOCATED WITHIN 25 FEET OF ANY STRUCTURE, OR 6 FEET OF A DRIVEWAY, POWER POLE, LIGHT STANDARD, OR ANY OTHER OBSTRUCTION. FOR WALL, FENCE AND PLANTER LOCATIONS, A PERIMETER AROUND THE HYDRANT MEASURING A MINIMUM OF 3 FEET FROM ITS CENTER SHALL BE MAINTAINED CLEAR OF ALL OBSTRUCTIONS AT ALL TIMES.
- AT ALL TIMES DURING CONSTRUCTION SUITABLE EMERGENCY VEHICLE ACCESS ROADS MUST BE MAINTAINED. ROADWAYS MUST BE SMOOTH, COMPACTED LAND CAPABLE OF SUPPORTING THE IMPROVED LOADS OF ALL EMERGENCY VEHICLES. PRIOR TO ACCEPTANCE OF ANY PRIVATE FIRE SERVICE MAIN, A SATISFACTORY HYDROSTATIC TEST WITH PIPING JOINTS UNCOVERED MUST BE CONDUCTED. APPROVED PLANS AND A CONTRACTOR'S MATERIALS AND TEST CERTIFICATE MUST BE PROVIDED AT TIME OF INSPECTION.
- IF DURING CONSTRUCTION IT BECOMES NECESSARY TO CLOSE ANY CONTROL VALVE OR PLACE A HYDRANT OUT OF SERVICE, THE CLARK COUNTY FIRE DEPARTMENT SHALL BE NOTIFIED.

ESTIMATE OF QUANTITIES - WATER (PUBLIC)



FIRE HYDRANT DETAIL

CLARK COUNTY TRAFFIC MANAGEMENT DEPARTMENT

CLARK COUNTY TRAFFIC MANAGEMENT DEPARTMENT

TRAFFIC MANAGEMENT DIVISION
CLARK COUNTY PUBLIC WORKS
ACCEPTED
By: *[Signature]* DATE: 9-21-99
Traffic Management Date

W.O. NO. 5567
BY NDH
DATE 4/29/99
SCALE HORIZ. 1"=40'
VERT. N/A
SHEET 7 OF 15 SHEETS

CLARK COUNTY TRAFFIC MANAGEMENT DEPARTMENT

TRAFFIC MANAGEMENT DIVISION
CLARK COUNTY PUBLIC WORKS
ACCEPTED