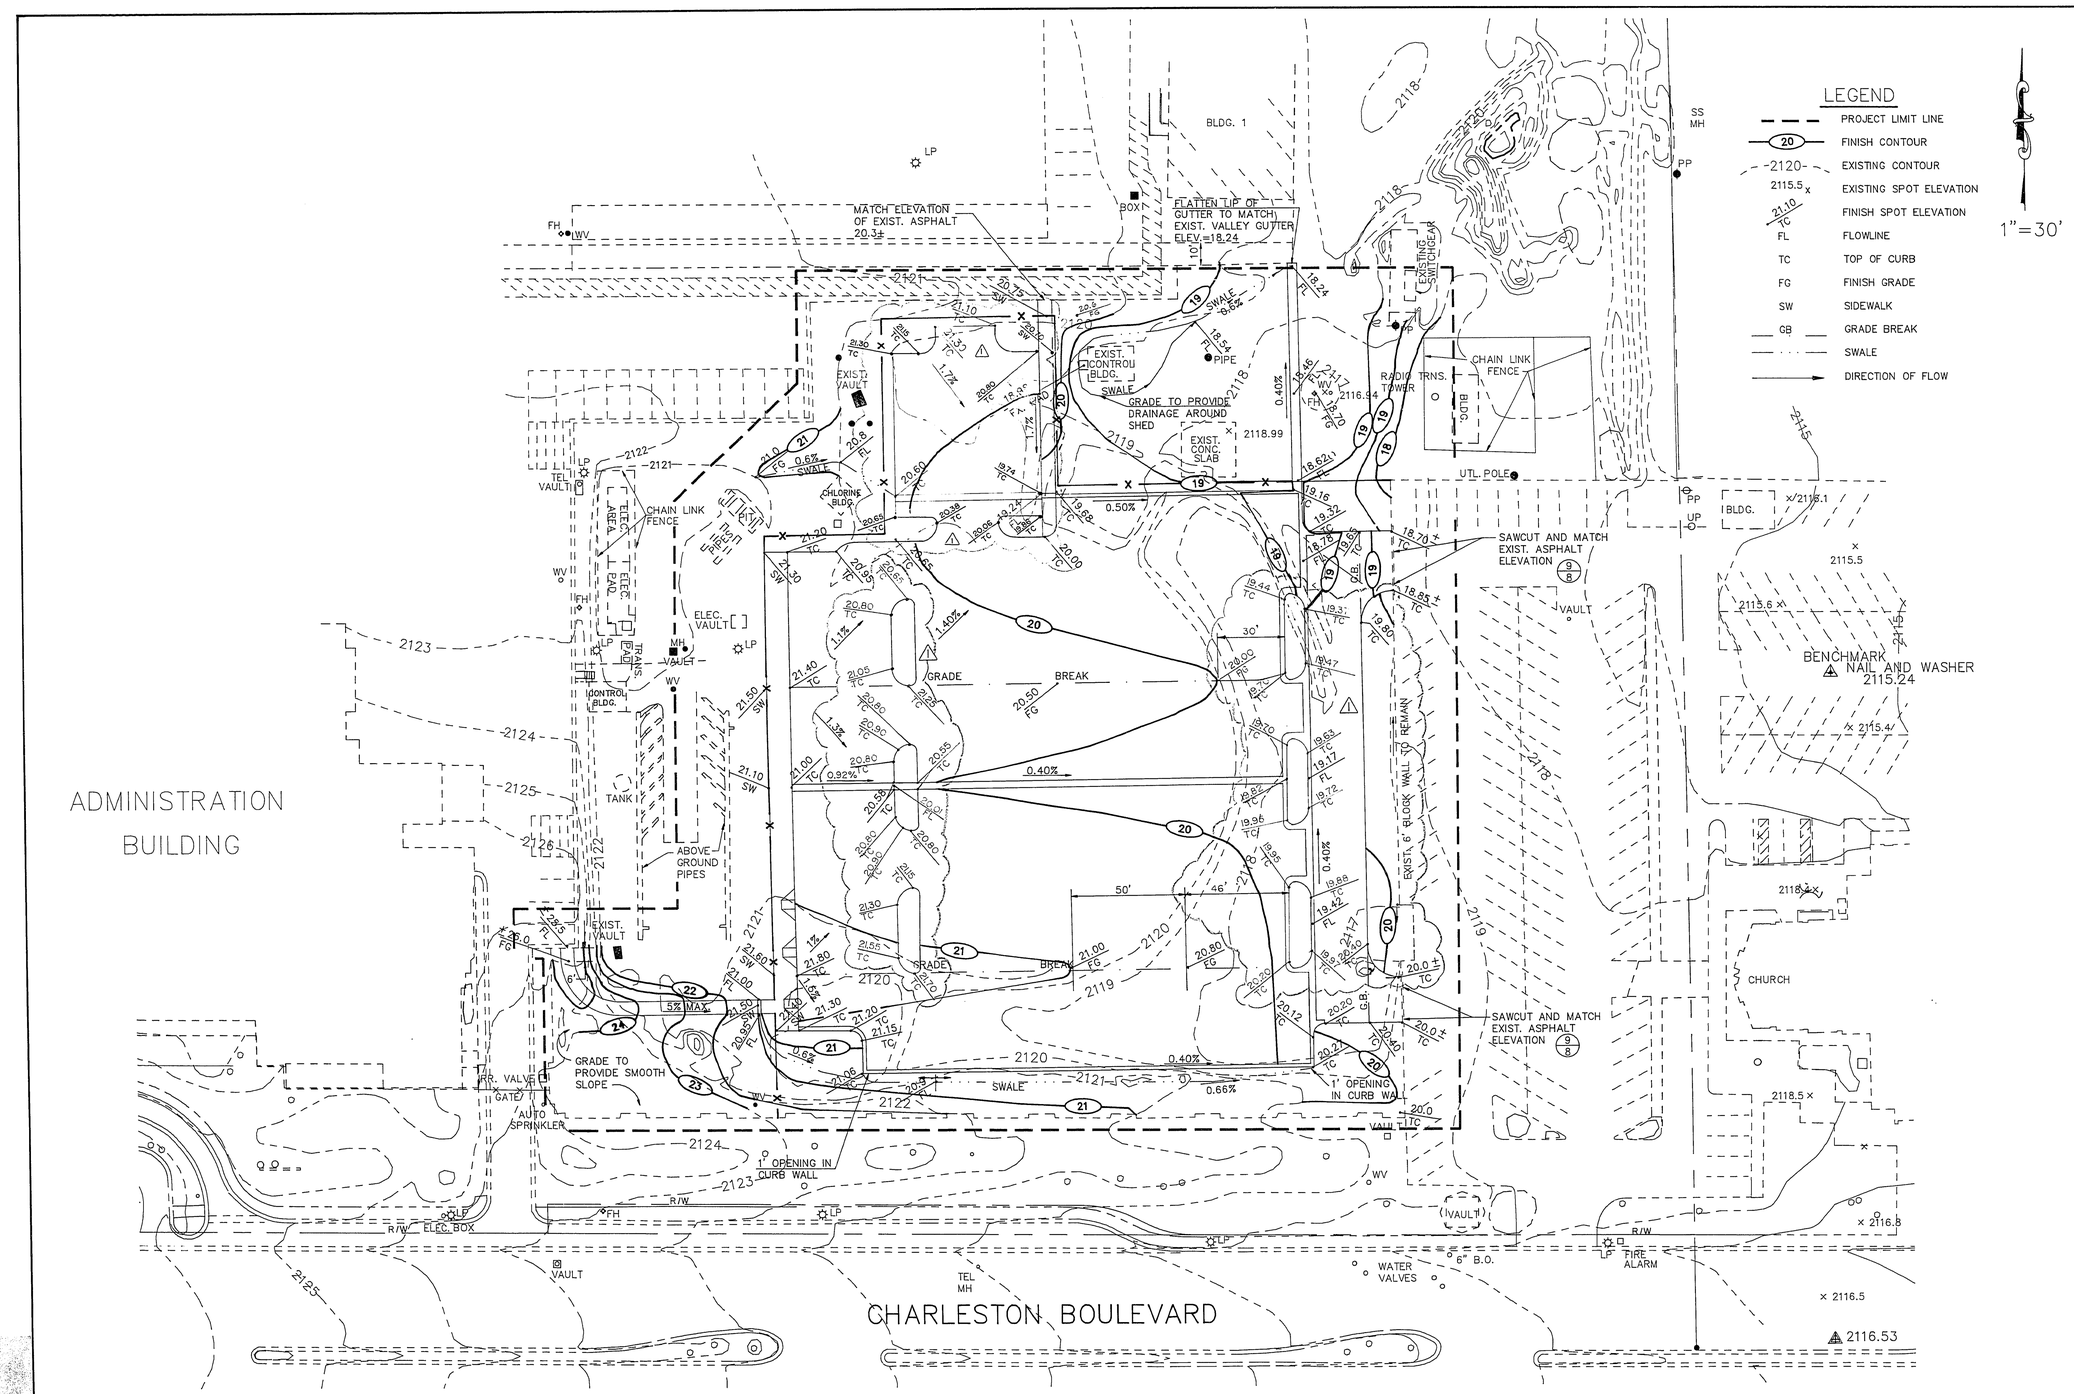

GRADING PLAN

EAST PARKING LOT IMPROVEMENT PLANS
LAS VEGAS VALLEY WATER DISTRICT
FOR WELLES PUGSLEY ARCHITECTS

REV.	BY	DATE	DESCRIPTION	APPROV'D
1	MRG	2/22/93	REVISED CURB ISLANDS AND ELEVATIONS	

SCALE 1"=30'
ACCT. NO. 30-22274
F.B. NO.
DESIGN SHW
DRAWN SHW
CHECKED
DATE 12-16-92

CONSULTING ENGINEERS OF NEVADA, INC.
2295-B RENAISSANCE DRIVE
LAS VEGAS, NEVADA 89119
PHONE (702)798-9045
FAX (702)798-1690

12/16/92
ENGINEER'S SEAL

SHEET	DRWG. NO.
4 OF 9	LV-116

107-V2092
9-2-66