23-5-59

EXISTING UTILITIES ARE LOCATED ON THE PLANS FOR THE CONVENIENCE OF THE CONTRACTOR. THE CONTRACTOR [illegible] CITY BEARS NO [illegible] FOR UTILITIES NOT SHOWN ON THE PLANS OR NOT IN THE LOCATION SHOWN ON THE PLANS.

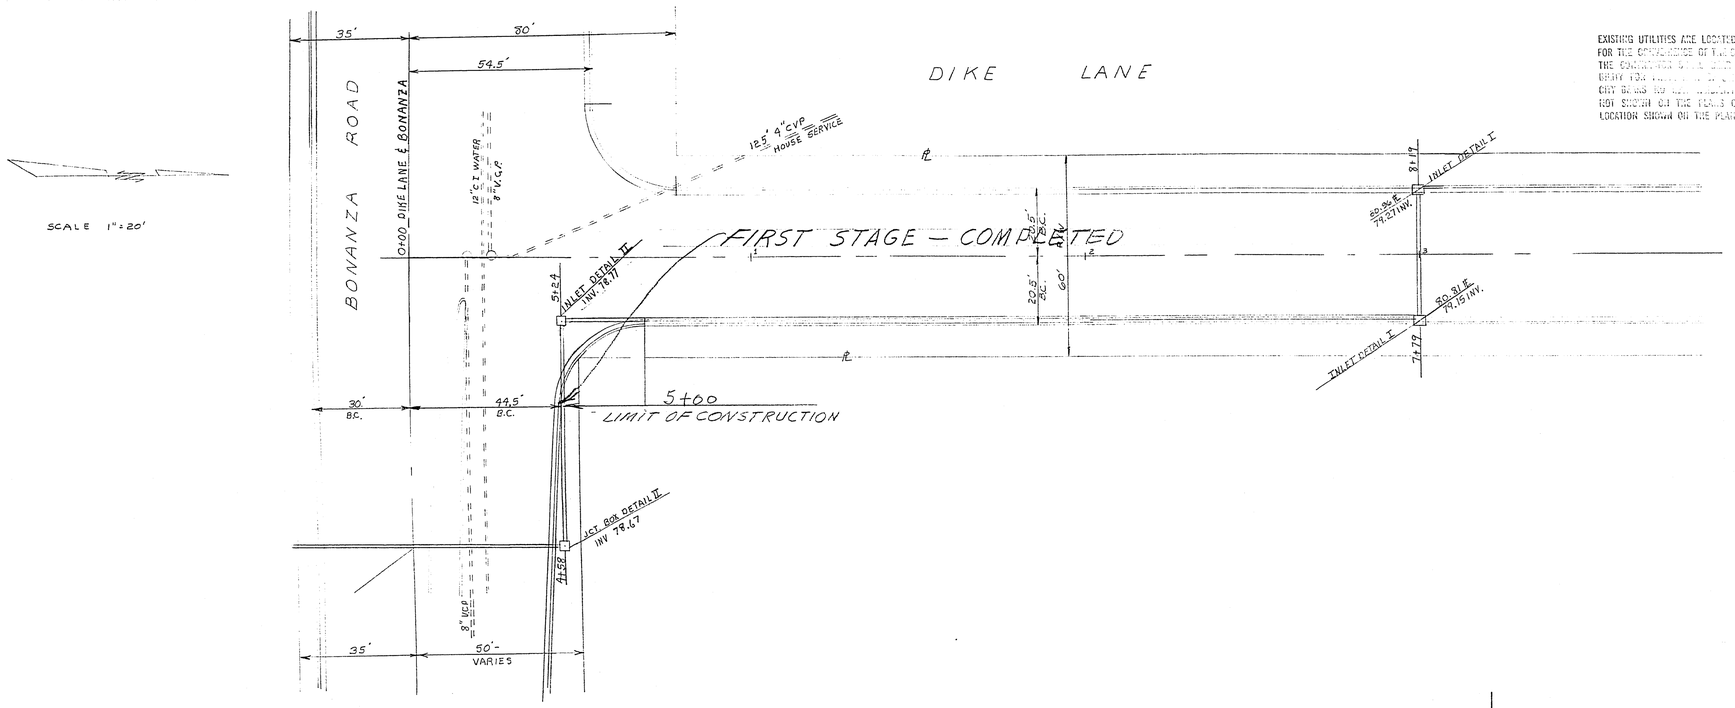

B.M. BONANZA ROAD & SUNNY PLACE
S.E. COR. 1.5' NORTH OF SHINER ON
POWER POLE.
C.L.V. B.M. NO 222 ELEV. 2057.489

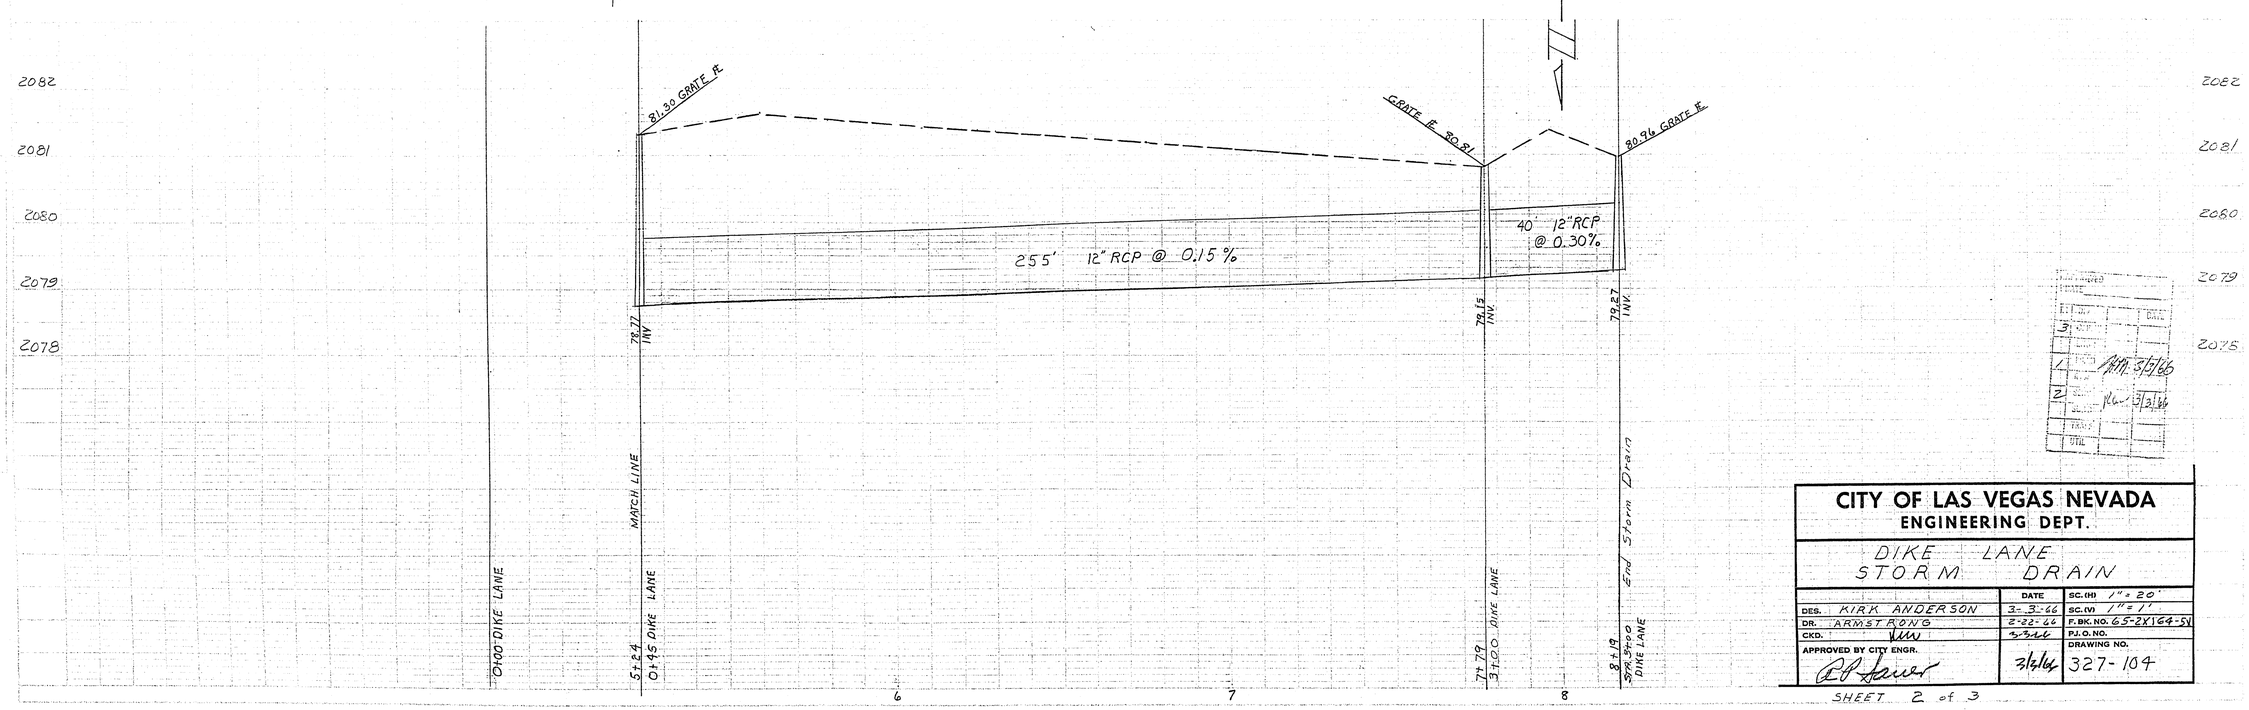

3		
1	RMM 3/7/66	
2	RMM 3/21/66	

CITY OF LAS VEGAS NEVADA
ENGINEERING DEPT.

DIKE LANE
STORM DRAIN

		DATE	SC. (H) 1" = 20'
DES.	KIRK ANDERSON	3-3-66	SC. (V) 1" = 1'
DR.	ARMSTRONG	2-22-66	F. BK. NO. 65-2X164-5X
CKD.	RMM	3/3/66	PJ. O. NO.
APPROVED BY CITY ENGR.		3/6/66	DRAWING NO. 327-104

SHEET 2 of 3