83-55

HORIZONTAL SCALE 1" = 50'-0"
VERTICAL " 1" = 5'-0"

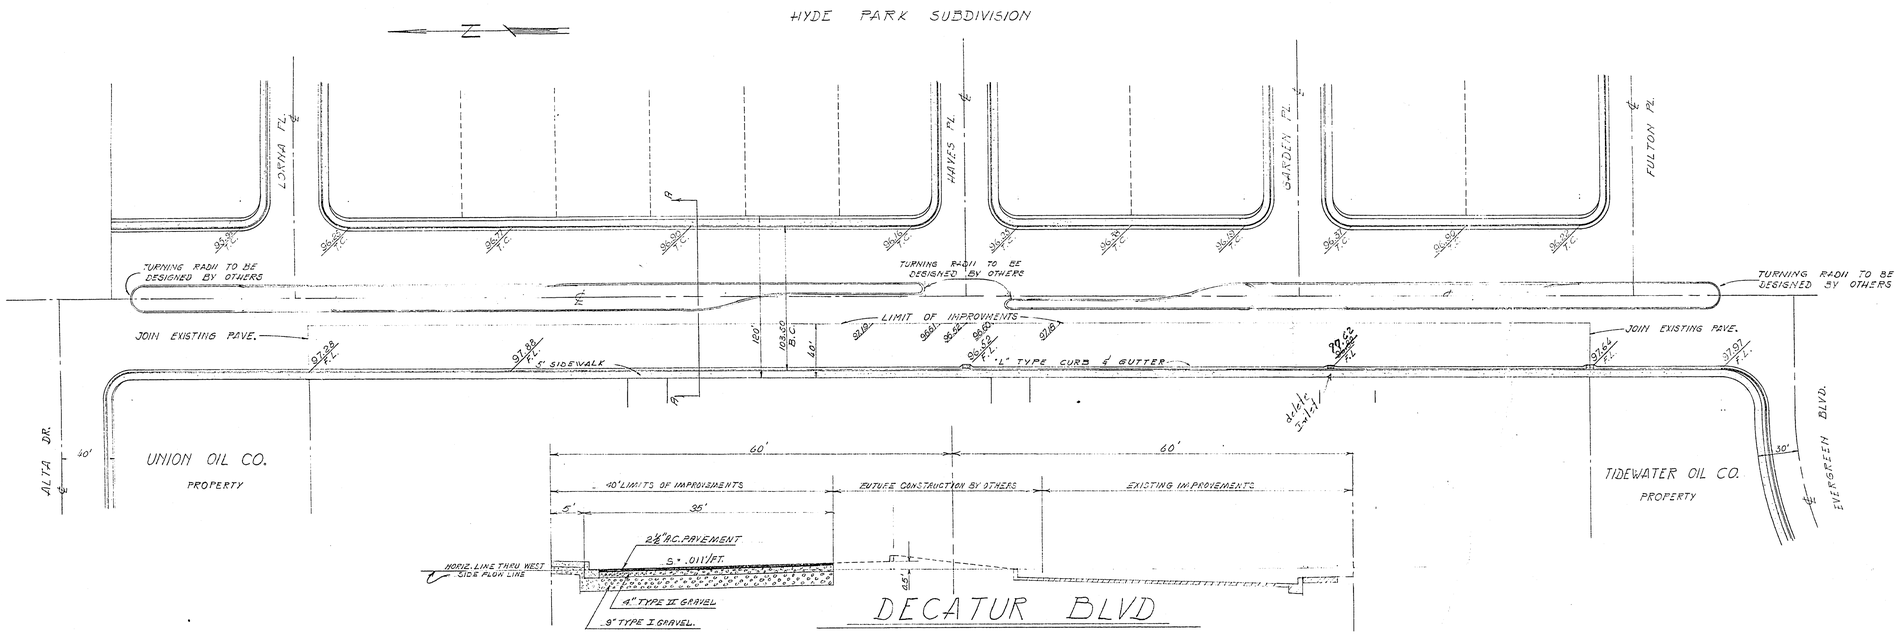

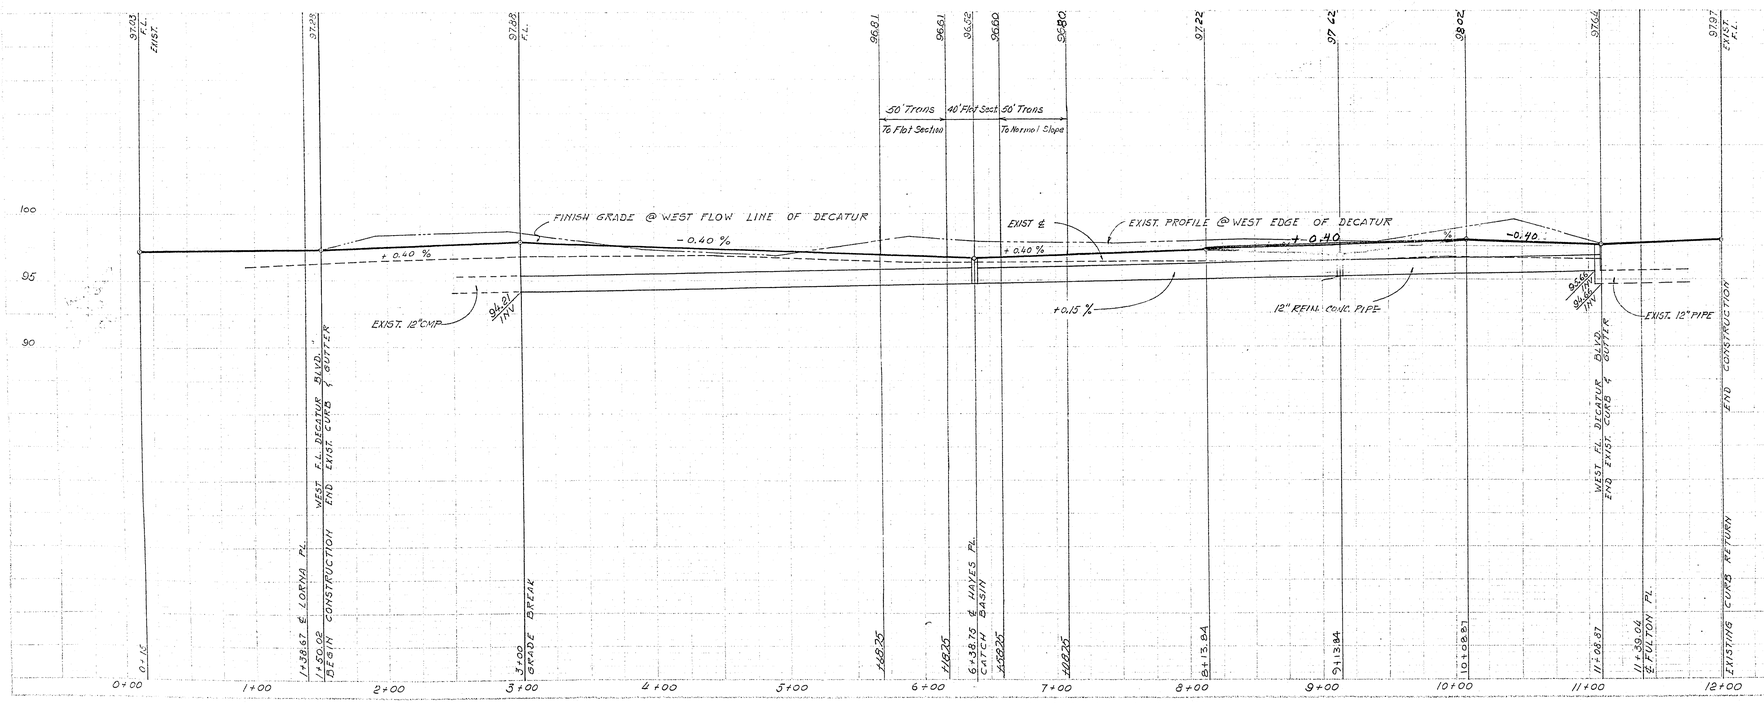

CITY ENGINEER: 8-8-63
Grade Rev. 7-16-63

WEST SIDE DECATUR BLVD.
BETWEEN ALTA DR. AND EVERGREEN BLVD.
STREET PLAN AND PROFILE

DESIGNED
DRAWN
CHECKED
WESTON ENGINEERS, INC.
LAS VEGAS NEVADA
APPROVED DATE
SHEET 1 OF 2
327-V72