

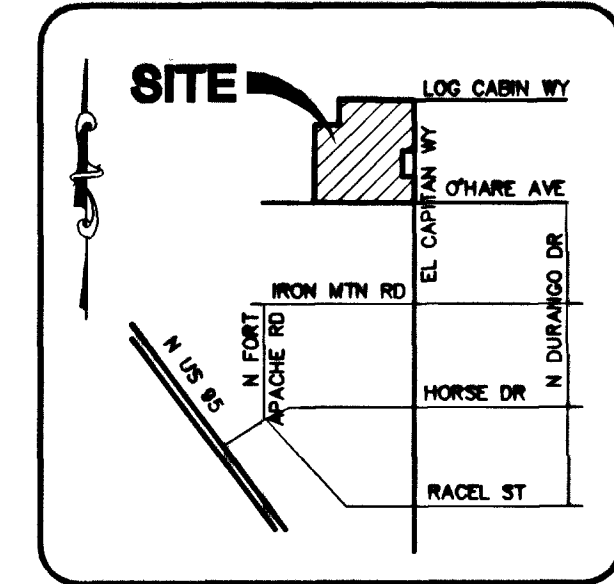


Call before you Dig
1-800-227-2600

Call before you Overhead
1-702-593-6111

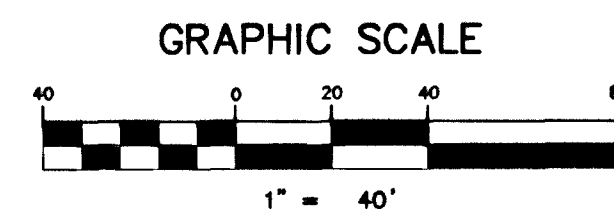

LOCATION MAP
N.T.S.

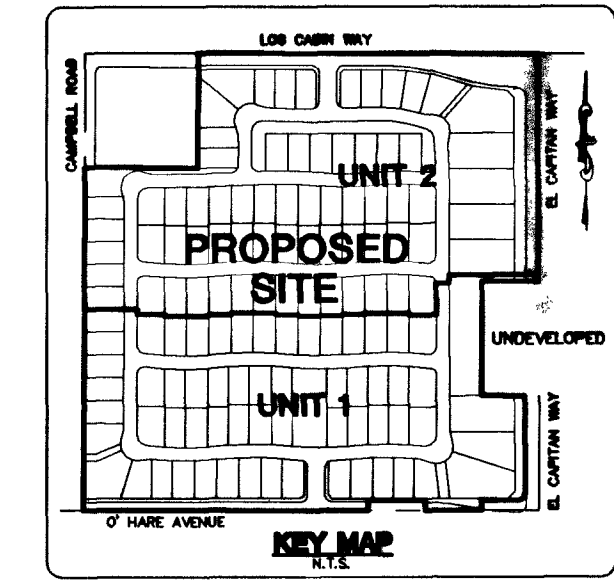

BASIS OF BEARING

NORTH 89°48'22" WEST BEING THE BEARING OF THE NORTH LINE OF THE SOUTHWEST QUARTER (SW 1/4) OF SECTION 5, TOWNSHIP 19 SOUTH, RANGE 60 EAST, W.D.M., CLARK COUNTY, NEVADA, AS SHOWN BY THAT PLAT ON FILE IN THE OFFICE OF THE COUNTY RECORDER, CLARK COUNTY, NEVADA, IN BOOK 92 OF PLATS, AT PAGE 17.

BENCHMARK

CITY OF LAS VEGAS BENCHMARK 1LV90-BNES
HAYDEN ELEV. 771.9689 METERS (2532.70 FEET)
BLM BRASS CAP LOCATED AT DURANGO DRIVE AND IRON MOUNTAIN ROAD.


FOR ALL GRADING & STREET SECTIONS SEE SHEET D1

CONTRACTOR NOTE




CONTRACTOR SHALL VERIFY HORIZONTAL AND VERTICAL LOCATION OF EXISTING UTILITIES AND NOTIFY THE DESIGN ENGINEER IMMEDIATELY OF ANY DISCREPANCIES PRIOR TO CONSTRUCTION.

CLARK COUNTY
DEPARTMENT OF PUBLIC WORKS
FOR CLARK COUNTY PART ONLY
Jack Gorman 10-30-02



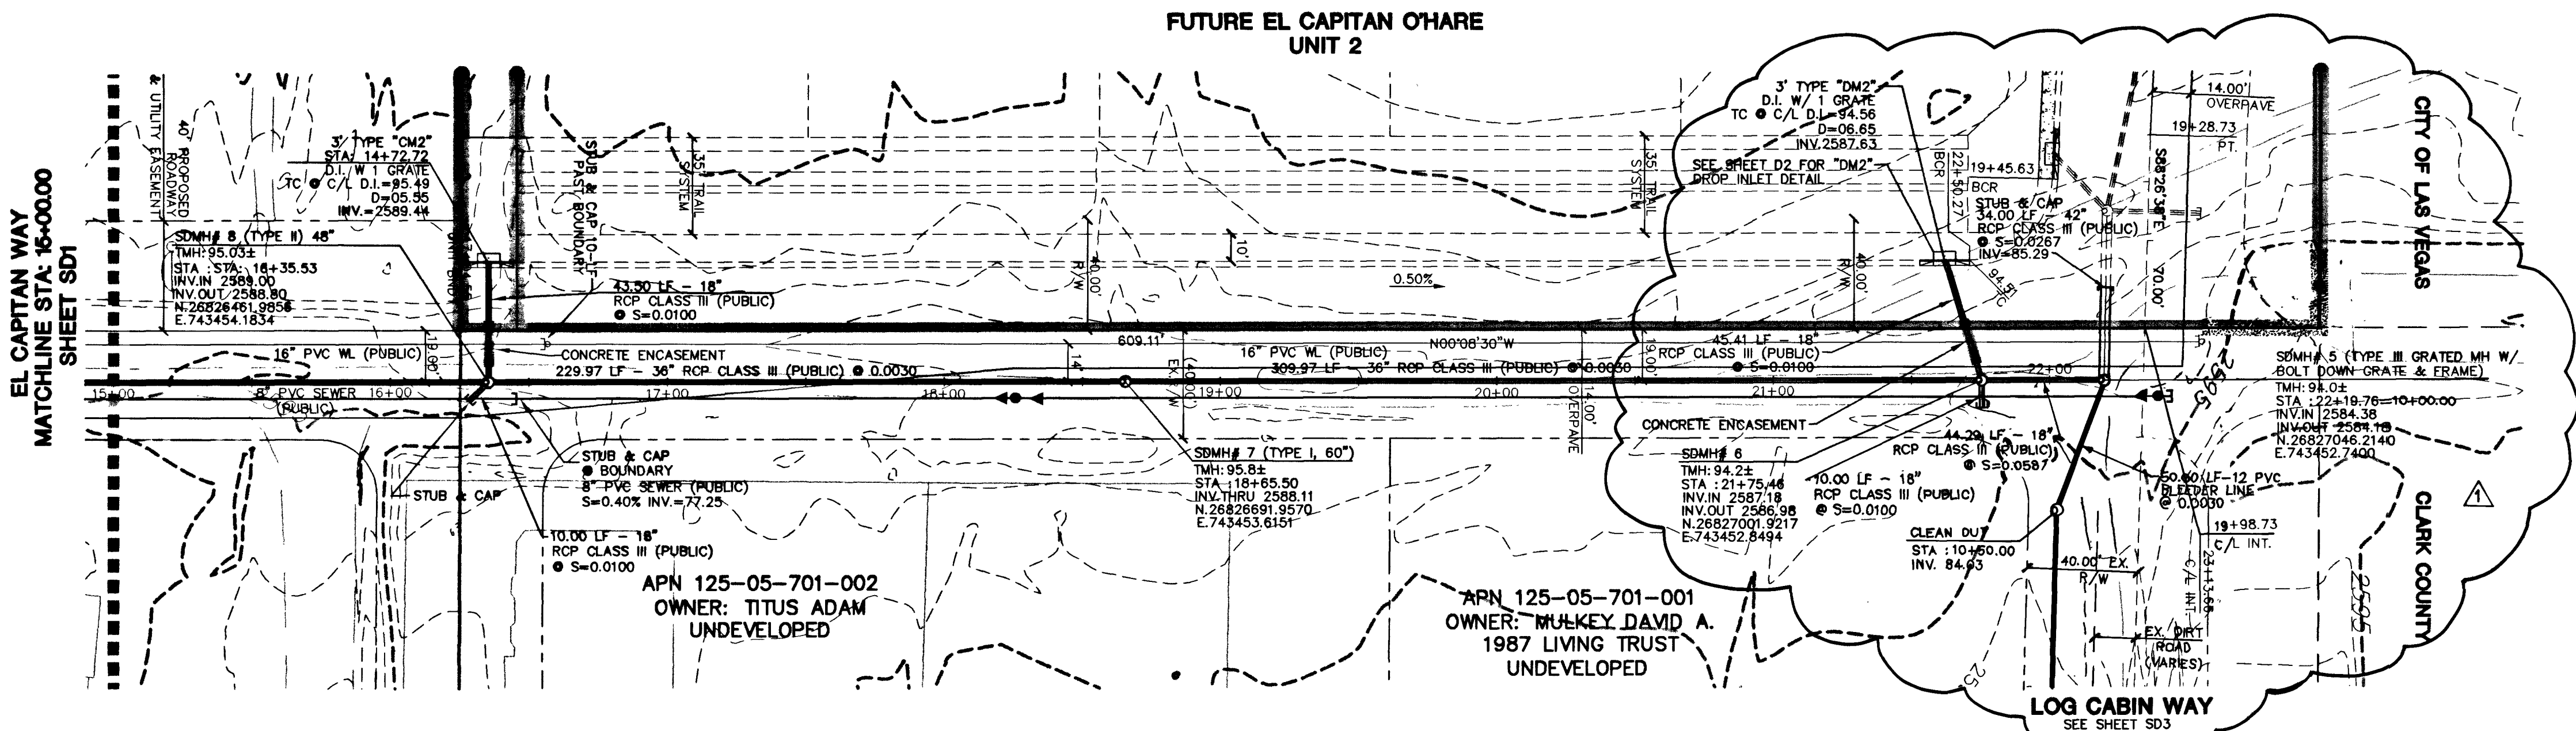

EL CAPITAN WAY (PUBLIC)

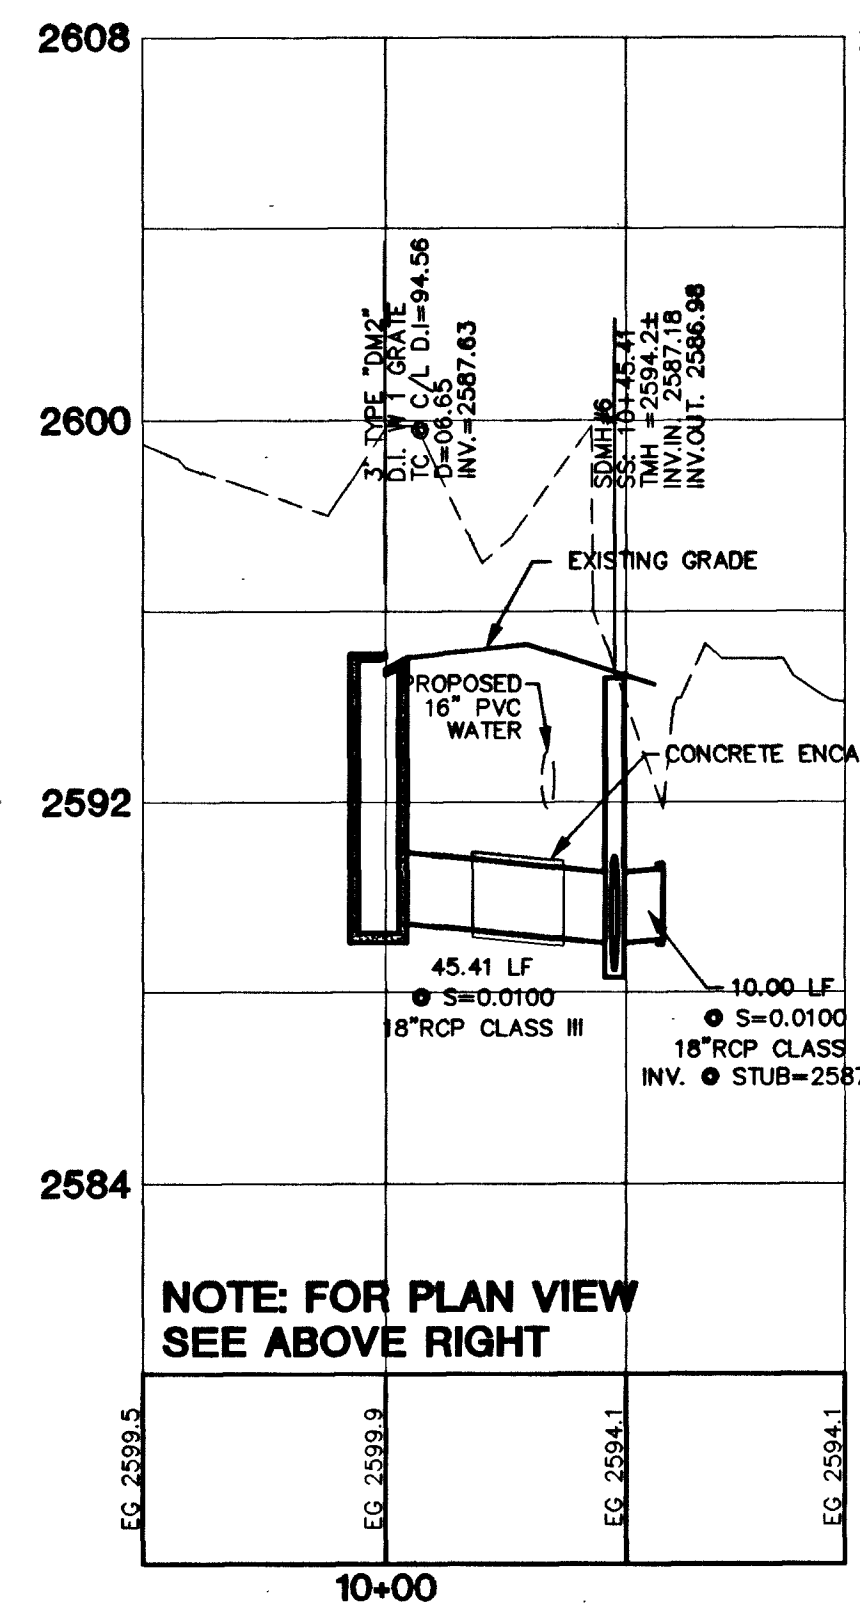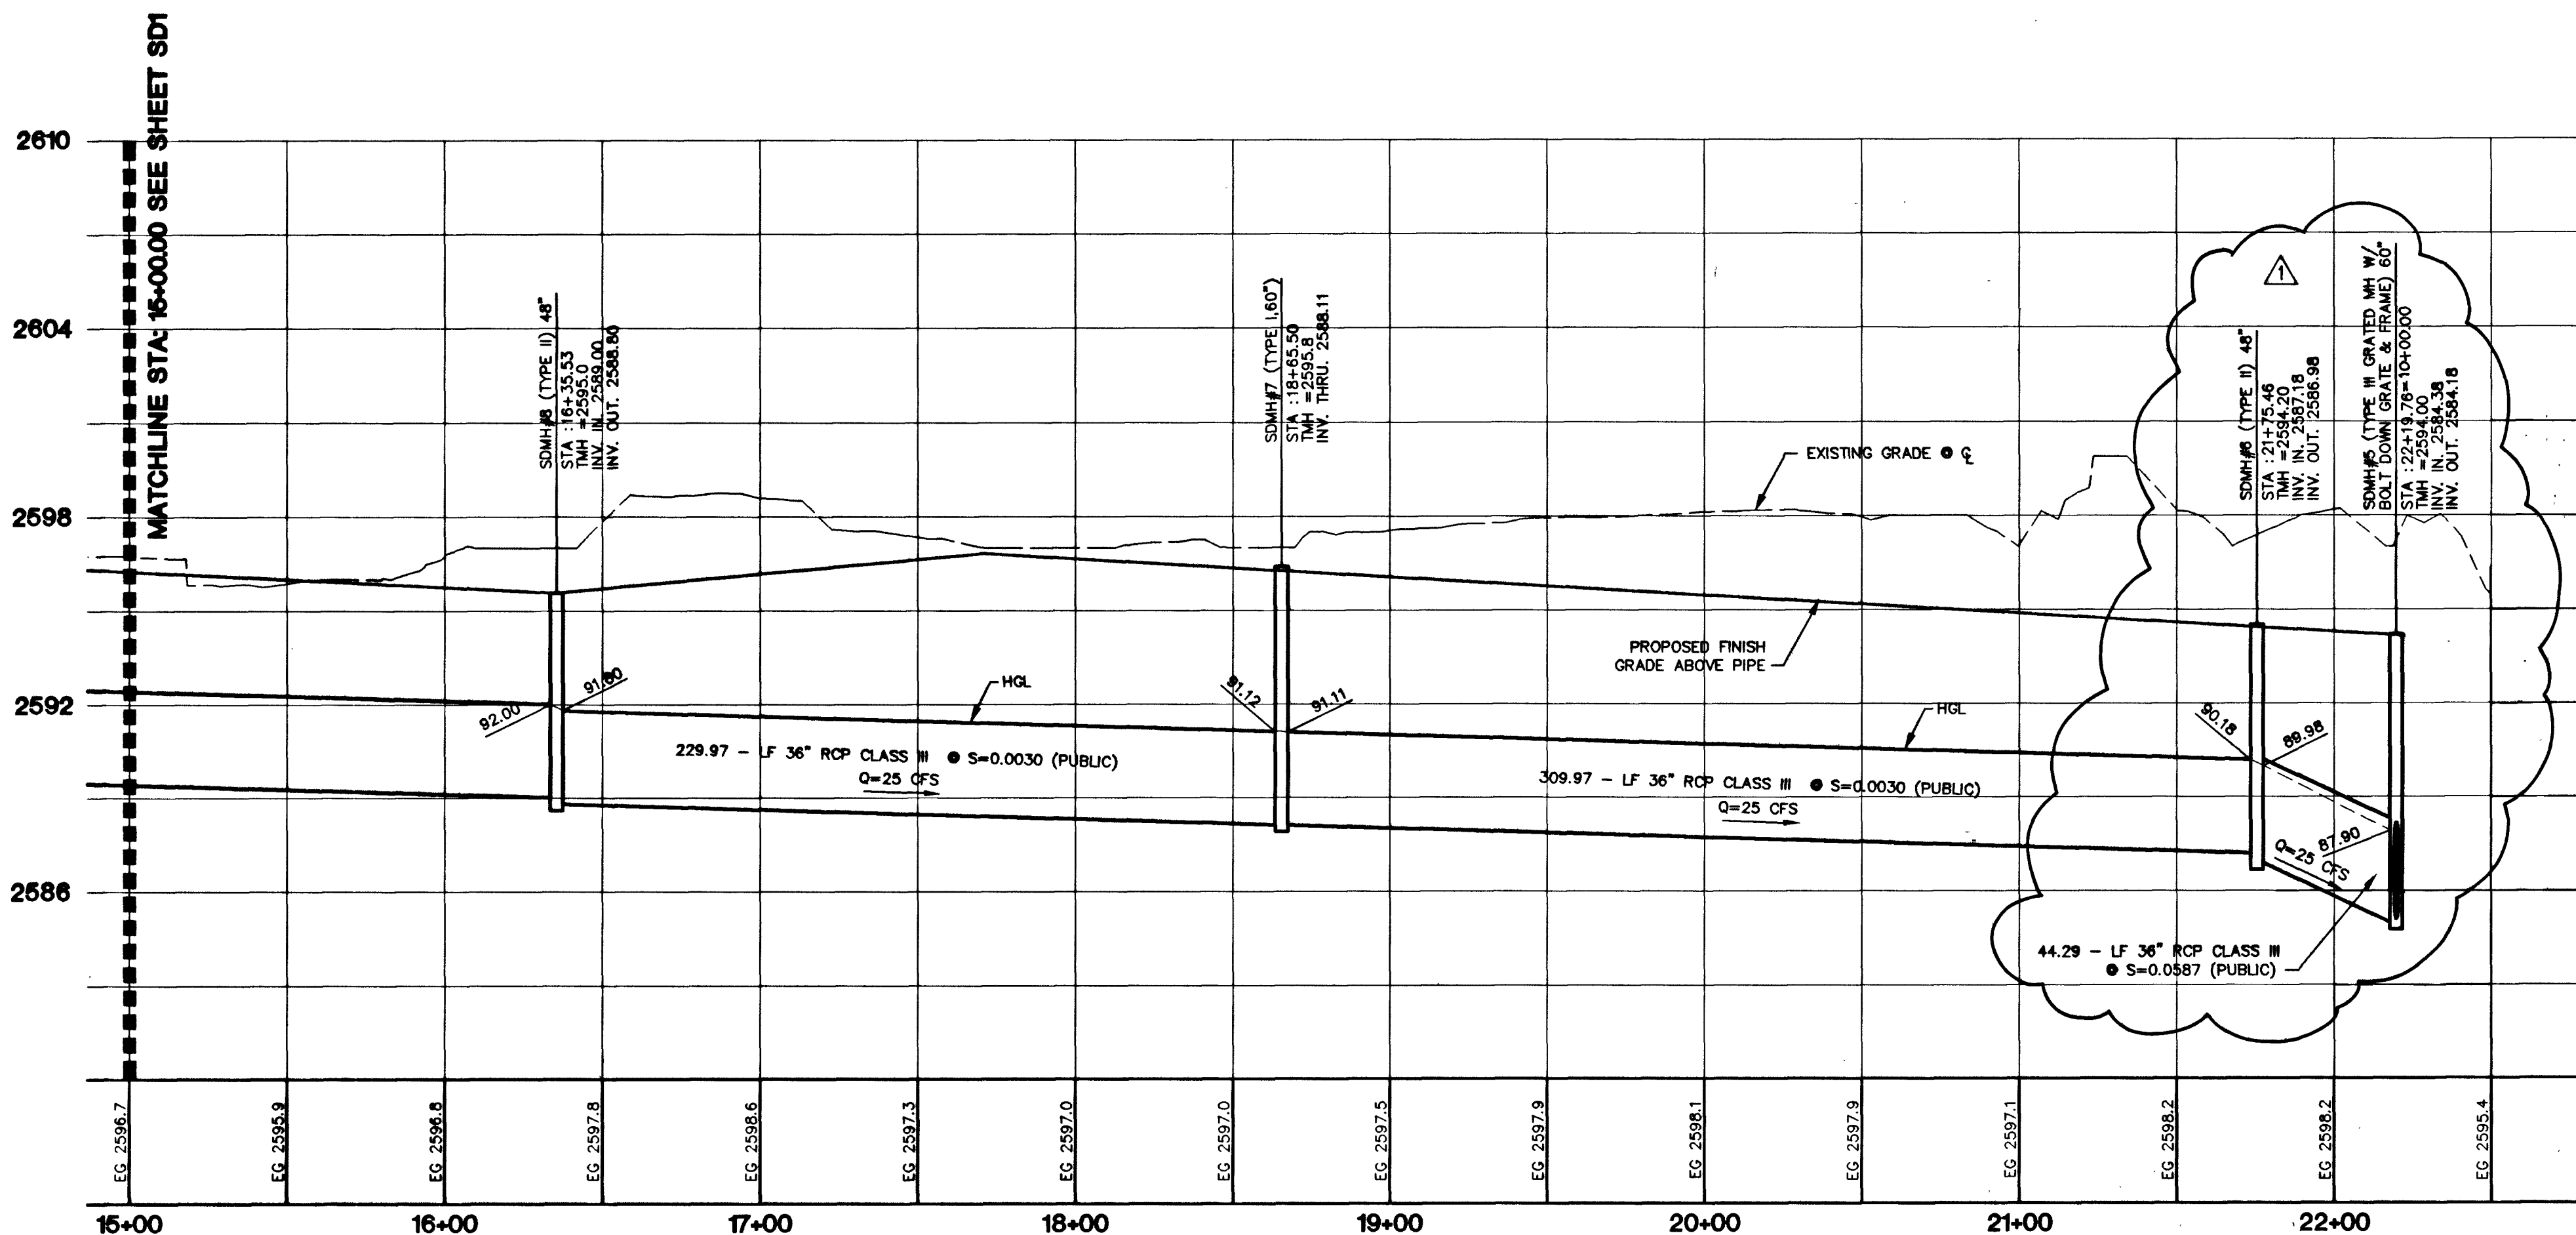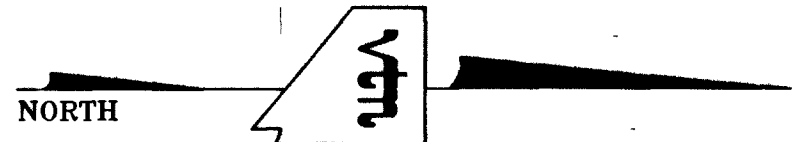

NOTE: FOR PLAN VIEW
SEE ABOVE RIGHT

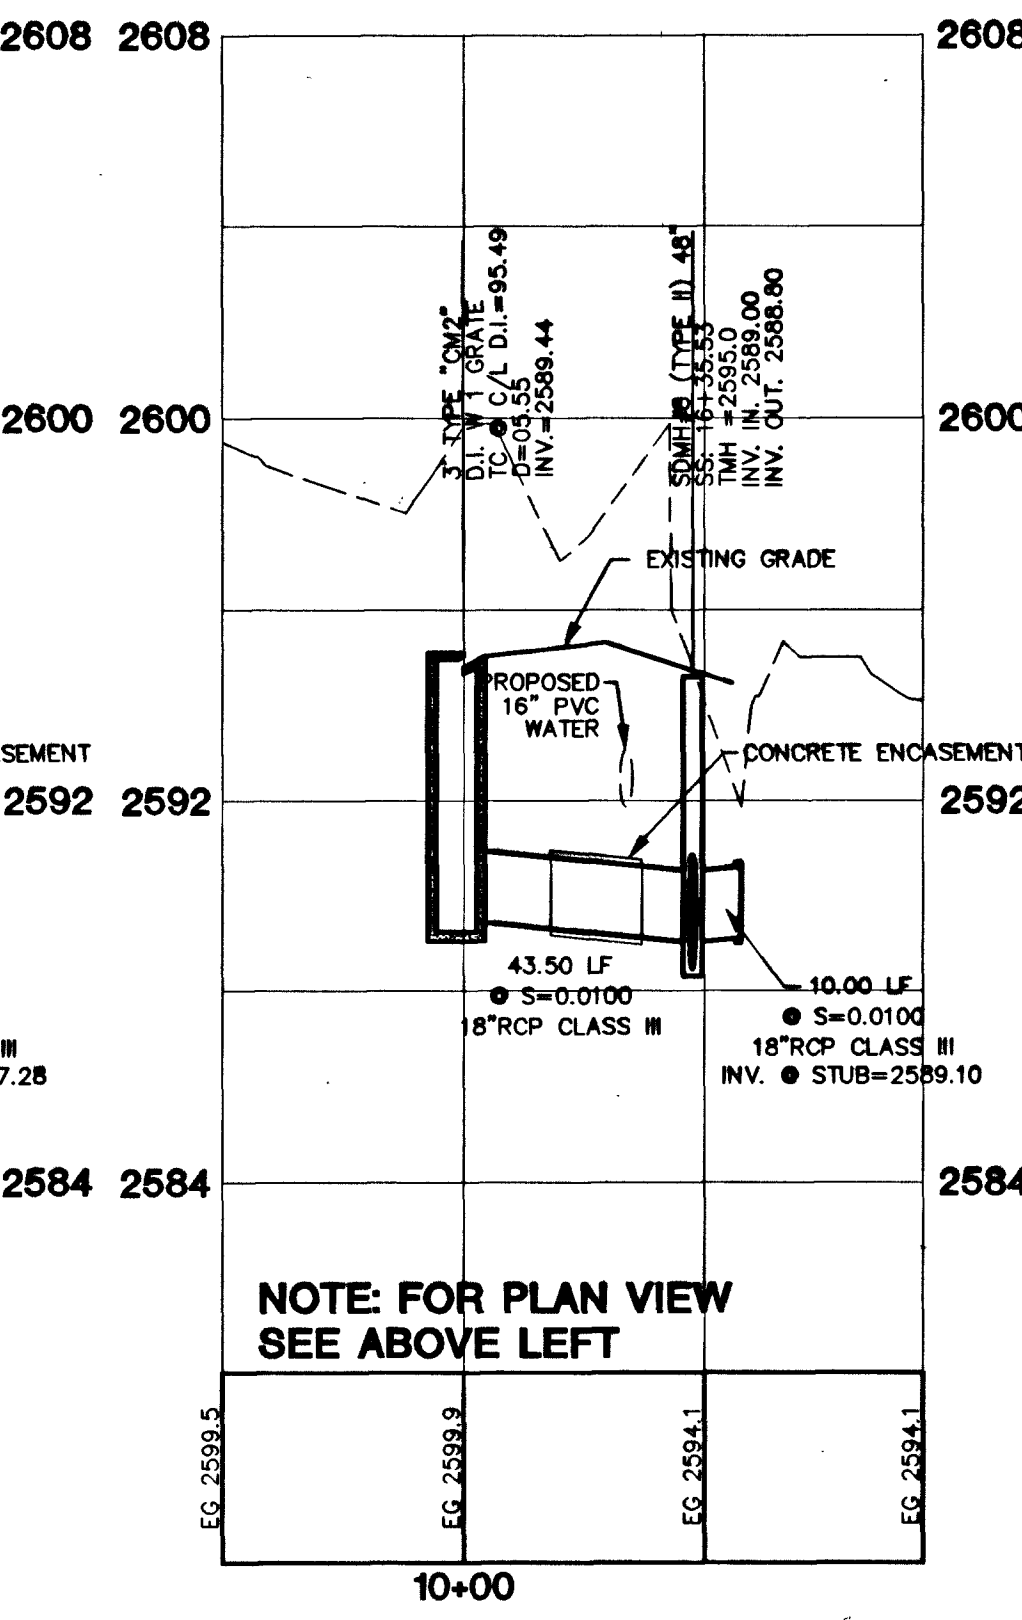

NOTE: FOR PLAN VIEW
SEE ABOVE LEFT

STERLING S. DEVELOPMENT


CITY OF LAS VEGAS, NEVADA

5365 S. CAMERON STE. # 200
LAS VEGAS, NEVADA 89119
(702) 871-0555

STORM DRAIN PLAN & PROFILE EL CAPITAN WAY STA. 15+00.00 - 22+19.76

EL CAPITAN / O'HARE UNIT 1

DRAWN BY: _____
DESIGNED BY: _____
CHECKED BY: _____
PROJECT NO: 8018
SCALE: 1" = 40' HORIZ
1" = 5' VERT.

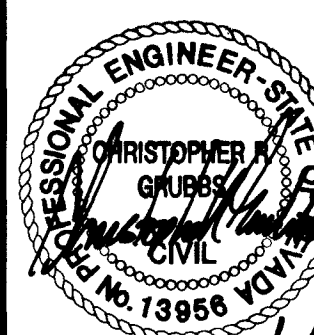

SHEET
SD2
30 OF 31 SHEETS
DRAWING NO.
327Y-4732-1

46442 55021