
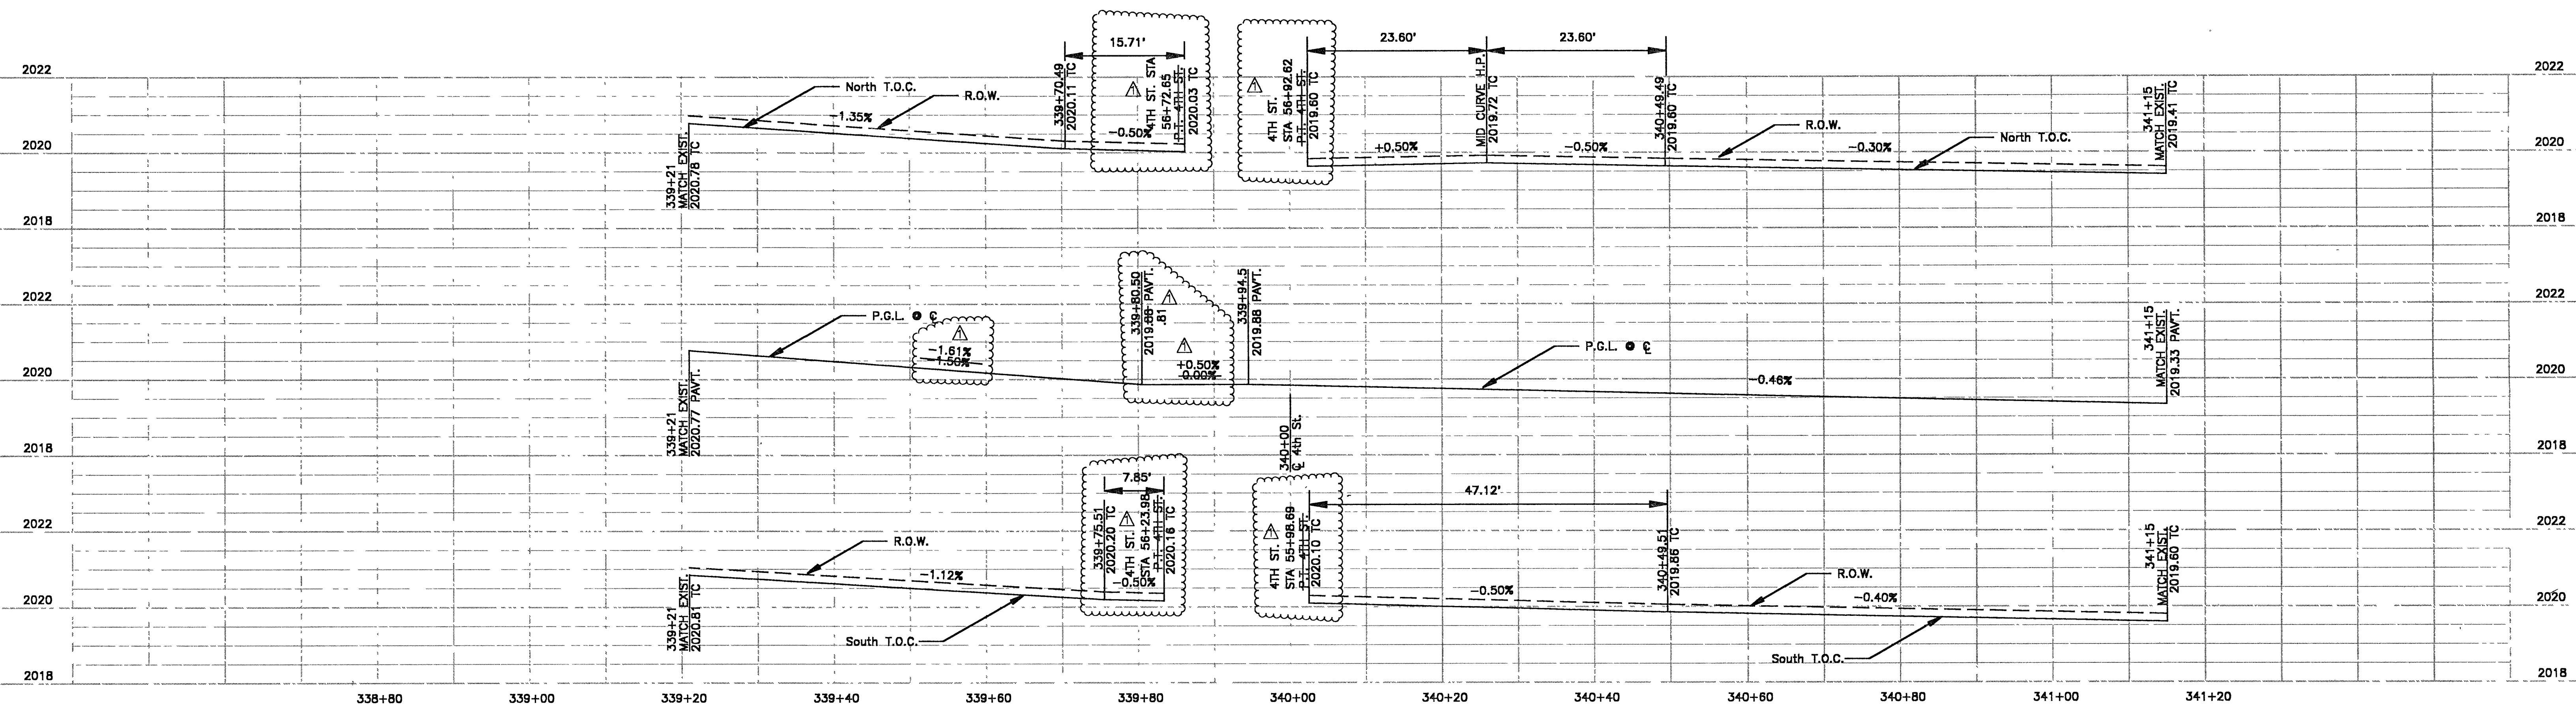


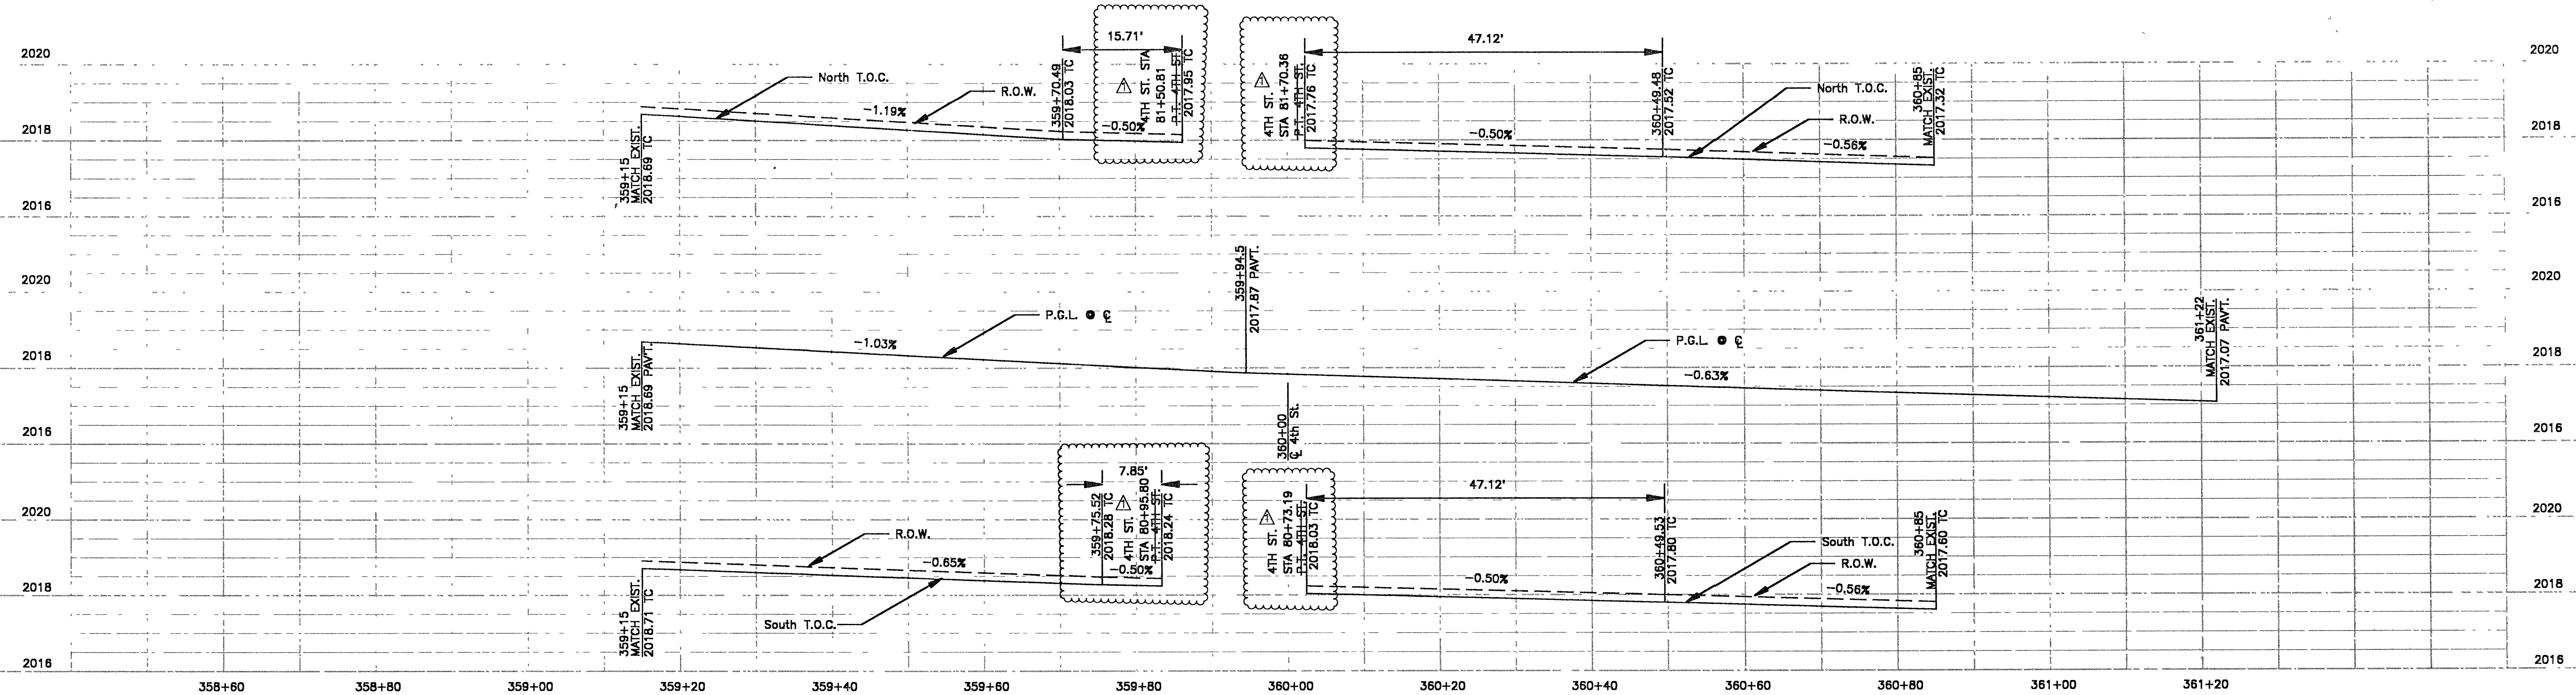

Time: 15:45:00.0
Date: 12/13/94
Drawing File: 990302\C-7

94974			
NO.	REVISIONS	DATE	BY
1	REVISIONS IN ACCORDANCE WITH ADDENDUM 1	12/13/94	LJP

Raymond Bransford
11-16-95

Kimley-Horn and Associates, Inc.
Las Vegas, Nevada
© 1994

DESIGNED BY JK
DRAWN BY CPT
CHECKED BY LJP
NOTE BOOK NO.



DOWNTOWN CORRIDOR IMPROVEMENTS
CITY OF LAS VEGAS DEPT. OF PUBLIC WORKS
LAS VEGAS, NEVADA

CALCULATED:
1-16-95
DATE 12/94
SCALE
1"=10' H
1"=2' V

**Cross Street Profiles—
Hoover Ave. & Gass Ave.**

DWG. NO. 107-V-2288
FILE NO. 9903.0
SHEET C-7