



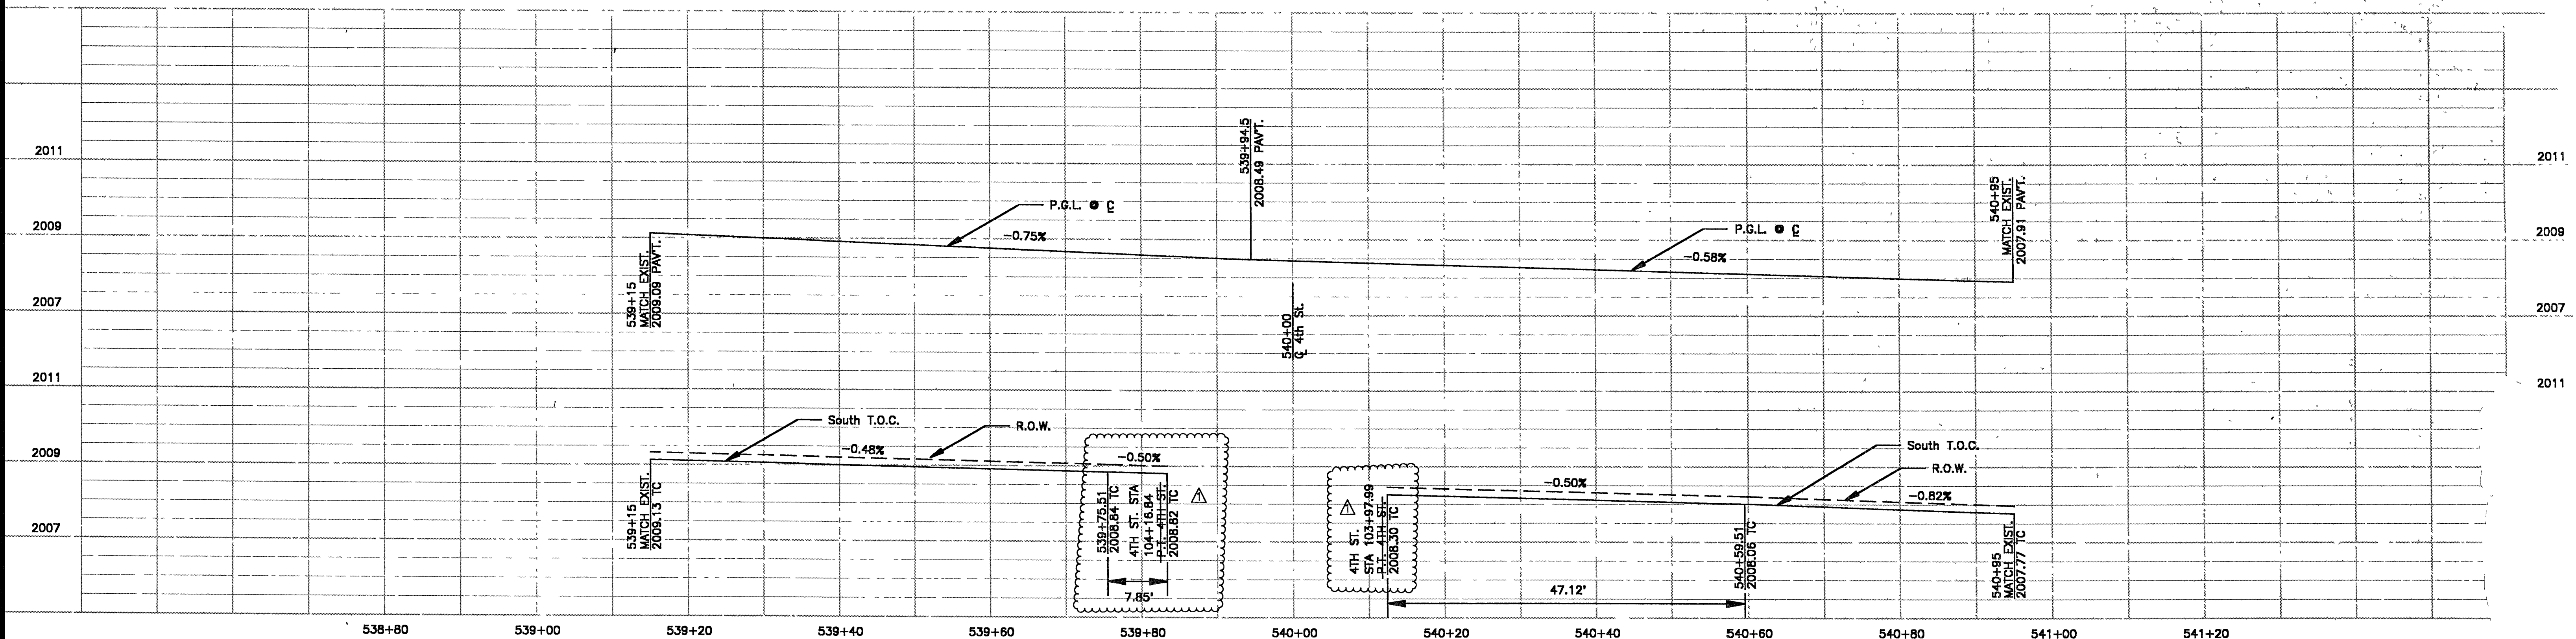

Stewart Ave.

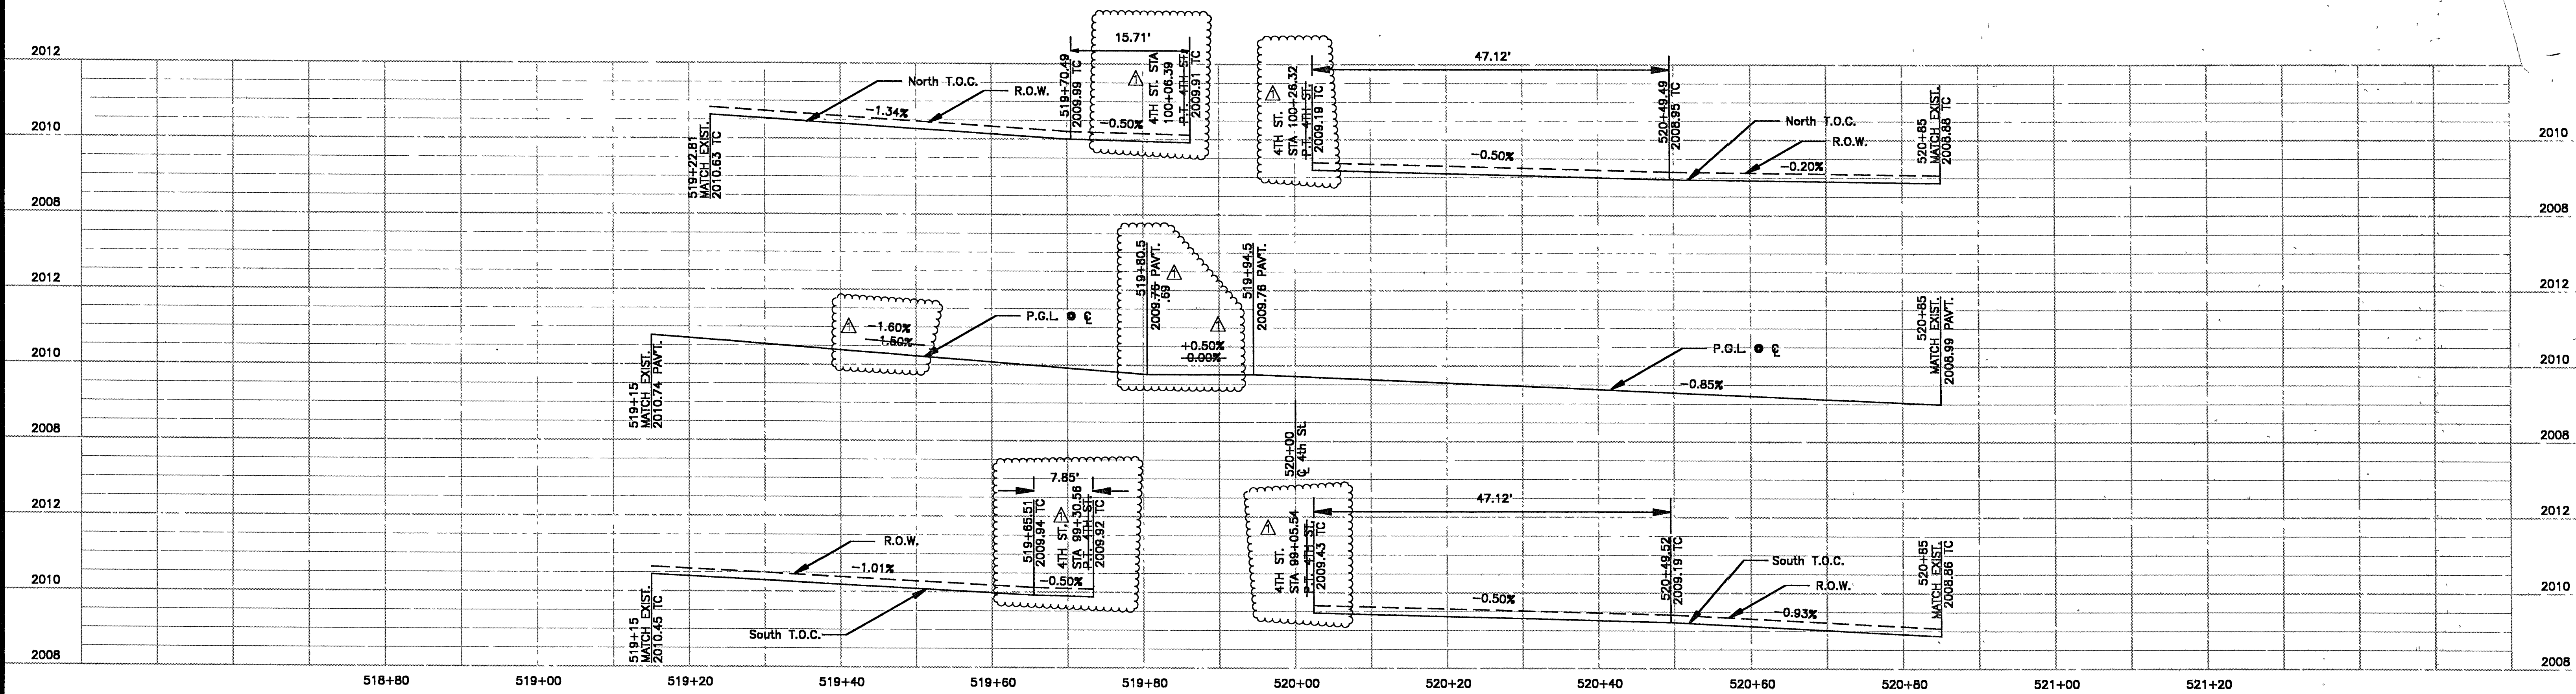

Ogden Ave.

Time: 15:45:00.0
Date: 12/13/1994
Drawing File: 990302\C-11

9997B REVISIONS IN ACCORDANCE WITH ADDENDUM 1 NO. REVISIONS DATE BY		 1-16-95 Las Vegas, Nevada	 Kimley-Horn and Associates, Inc. Las Vegas, Nevada © 1994	DESIGNED BY JK DRAWN BY CPT CHECKED BY <i>LSB</i> NOTE BOOK NO.	 DOWNTOWN CORRIDOR IMPROVEMENTS CITY OF LAS VEGAS DEPT. OF PUBLIC WORKS LAS VEGAS, NEVADA	CONFORMED: 1-16-95 DATE 12/94 SCALE 1"=10' H 1"=2' V	DWG. NO. 107-V-2288 FILE NO. 990302 Cross Street Profiles— Ogden Ave. & Stewart Ave.
---	--	----------------------------------	--	--	--	---	---