


- NOTES
- 1 REMOVE EXISTING 4' x 10" OVAL STORM DRAIN AND PLUG REMAINING PIPE OPENINGS WITH CONCRETE
 - 2 REMOVE EXISTING GRATE BASIN AND PLUG REMAINING CONNECTOR PIPE OPENINGS WITH CONCRETE
 - 3 REMOVE AND RECONNECT EXISTING BUBBLER CATCH BASINS AND PLUG CONNECTOR PIPE OPENINGS WITH CONCRETE, AS DIRECTED BY ENGINEER.
 - 4 CONSTRUCT STORM DRAIN MANHOLE TYPE I PER C.L.V. STD. DWG. No. 403 SIZE - 4'
 - 5 CONSTRUCT DROP INLET TYPE "A" PER C.L.V. STD. DWG. No. 411, SIZE-4' TRUNCATE LOCAL DEPRESSION AT HANDICAP RAMP, AS DIRECTED BY ENGINEER
 - 6 EXISTING UNDERSIDEWALK DRAIN. CLEAR OBSTRUCTIONS TO DRAIN, AS DIRECTED BY THE ENGINEER
 - 7 SEE SHEETS SD-6 AND SD-7 FOR CONNECTOR PIPE PROFILES
 - 8 CONSTRUCT NDOT TYPE 3 INLET PER NDOT STD. #R-4.3.1-(609), SIZE-4'
 - 9 WATER MAIN RELOCATION, SEE SHEET SD-1 FOR DETAIL
 - 10 CONCRETE ENCASUREMENT, SEE SHEET SD-1 FOR DETAIL
 - 11 REMOVE EXISTING CONCRETE OR BRICKWORK SEAL, CONNECT 18" STORM DRAIN TO EXISTING 18" STUB

CAUTION!

IT SHALL BE THE CONTRACTOR'S RESPONSIBILITY TO LOCATE ALL UTILITY INTERFERENCES, THIS SHEET. THE STORM DRAIN LOCATION IS SCHEMATIC ONLY AND MAY CHANGE WITH FURTHER UTILITY INVESTIGATION. QUANTITIES, INCLUDING BUT NOT LIMITED TO 18" CLASS II RCP, RCP MANHOLES AND CATCH BASINS (TYPE "A") MAY VARY.

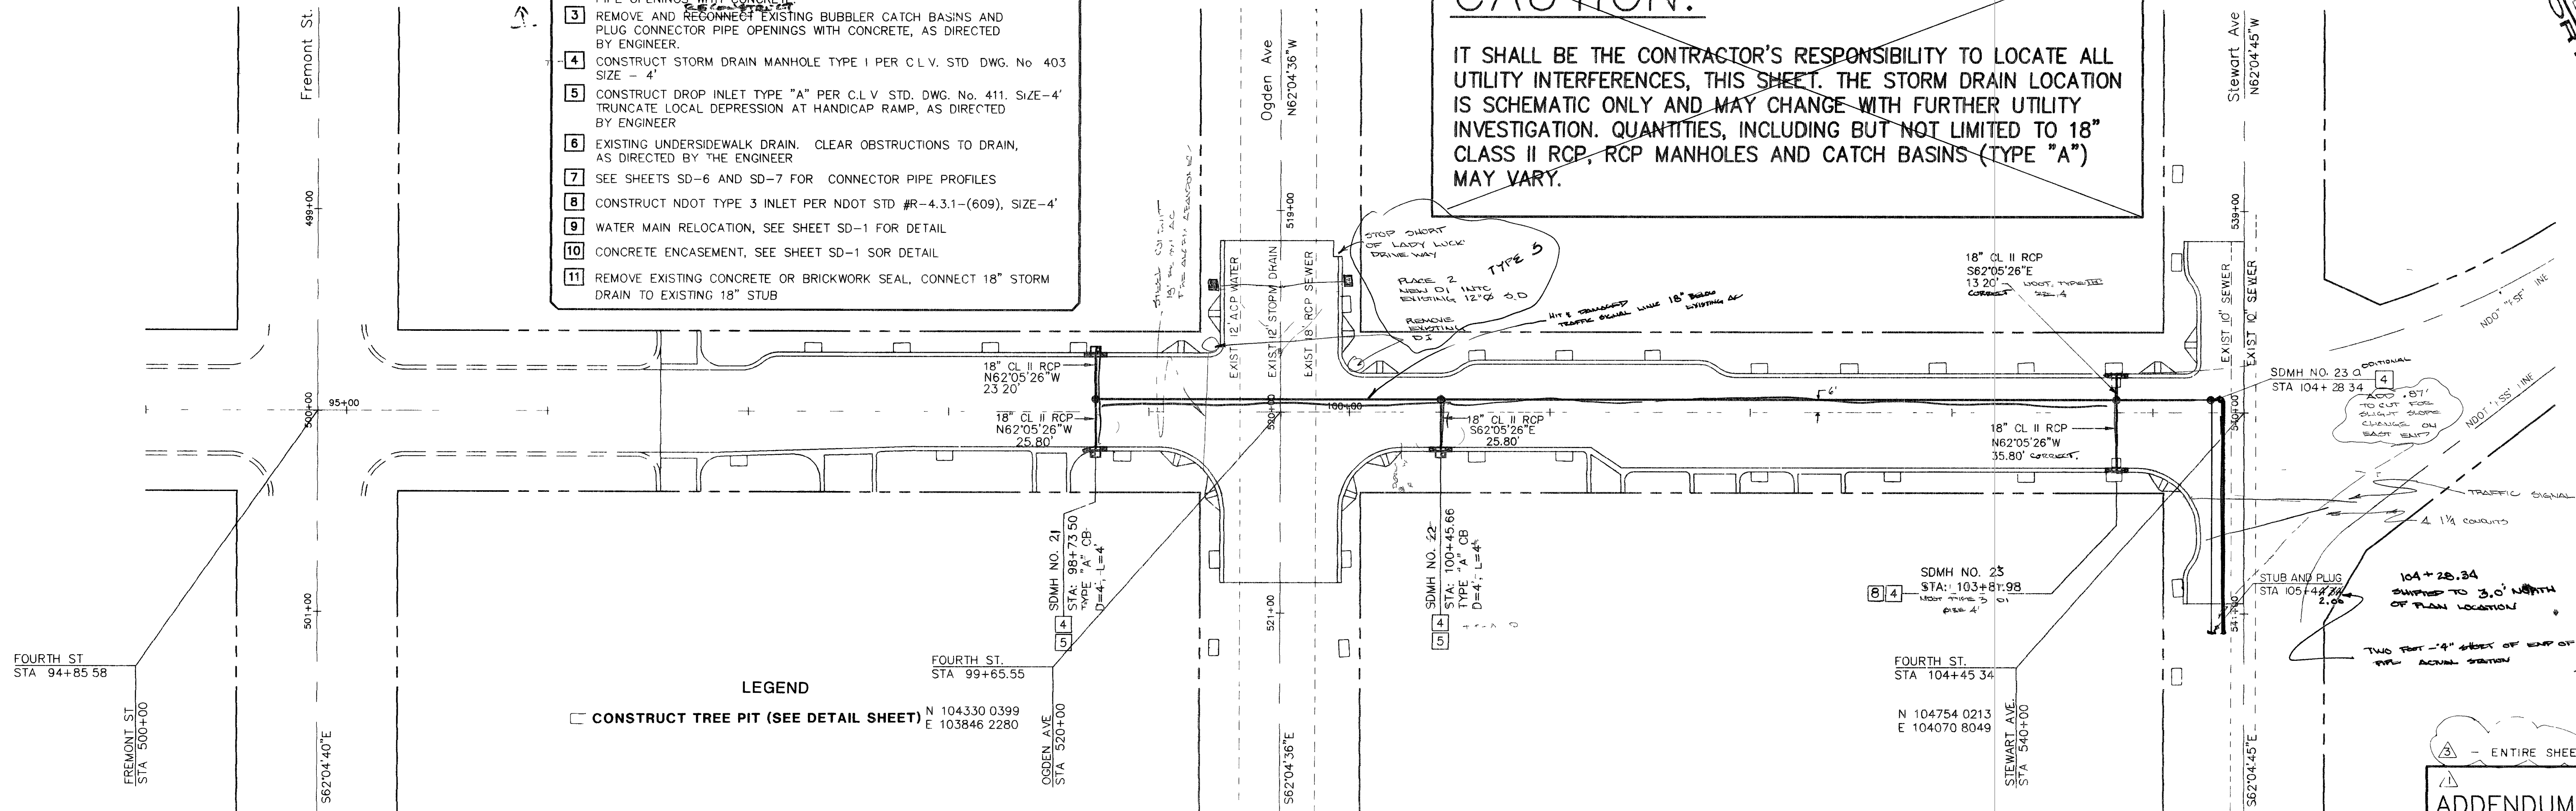


LEGEND

CONSTRUCT TREE PIT (SEE DETAIL SHEET)

N 104330 0399
E 103846 2280

ADDENDUM NO. 1
ENTIRE SHEET

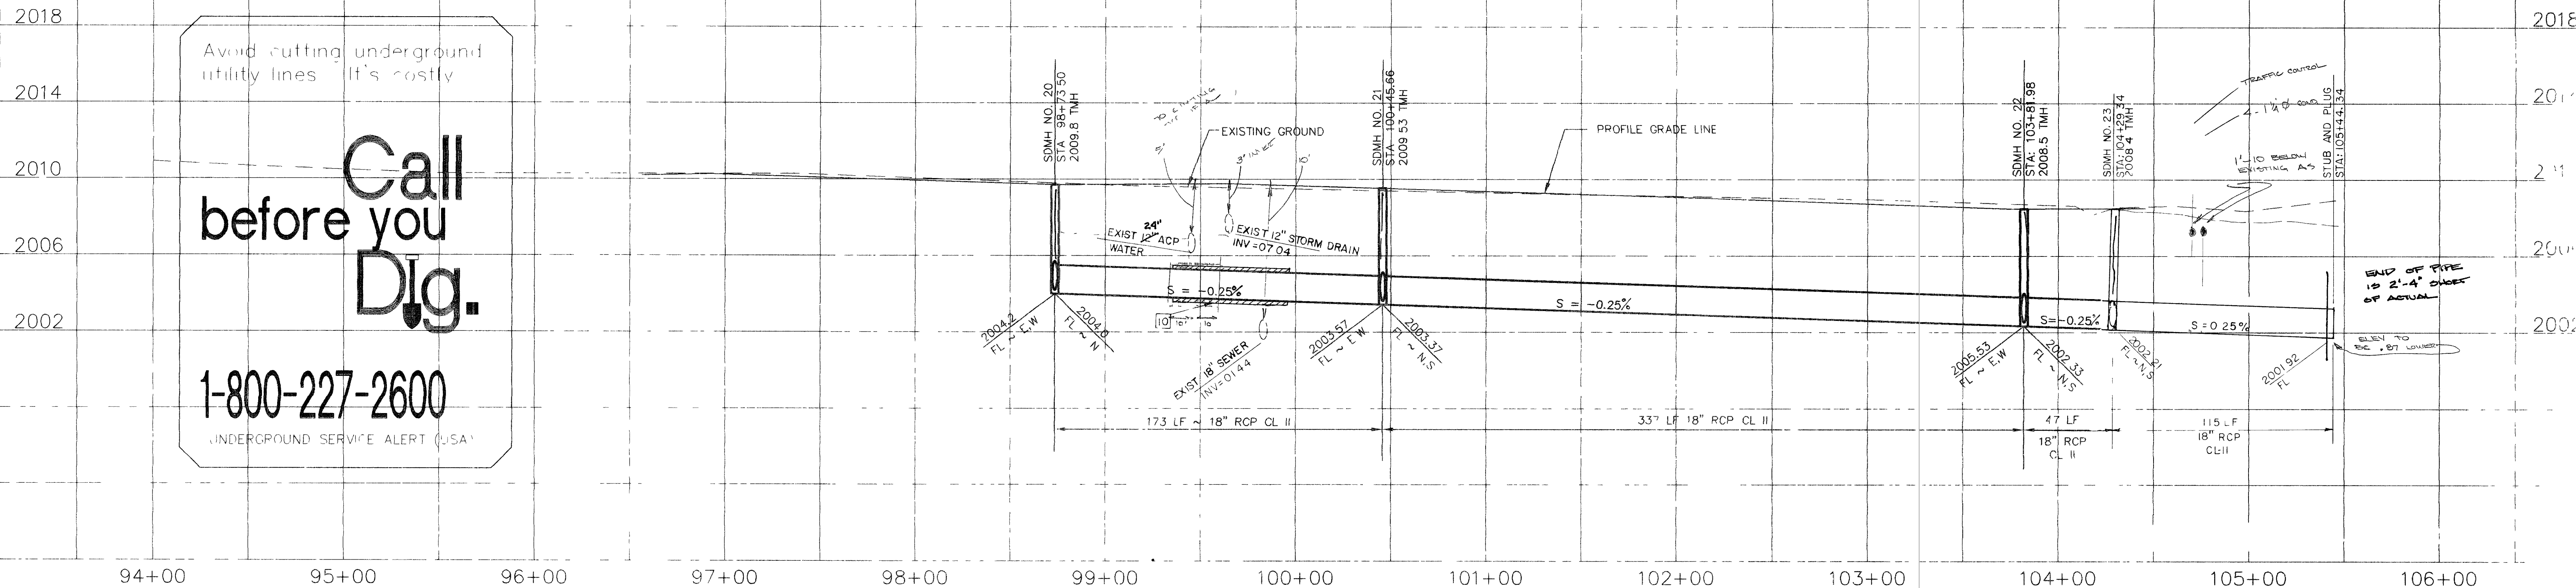


NO	REVISIONS	DATE	BY
1	REVISION 1, ISSUED AS ADDENDUM NO. 1, ENTIRE SHEET, ADD STORM DRAIN ON PLAN AND PROFILE	12/10/94	DBB
2	REVISION 3, ISSUED AS CCO ENTIRE SHEET, ADD UTILITIES IN PLAN AND PROFILE, CONC. ENCASUREMENT, MODIFY STUB OUT ON STEWART, MODIFY CB'S AT STA 103+81.98 TO NDOT TYPE 3	01/21/95	DBB

DESIGNED BY DBB
DRAWN BY KOZ
CHECKED BY
NOTE BOOK NO.

PENTACORE
Engineering, Inc.
6763 West Charleston Boulevard
Las Vegas, Nevada 89102
(702) 298-0115

DESIGNED BY DBB
DRAWN BY KOZ
CHECKED BY
NOTE BOOK NO.

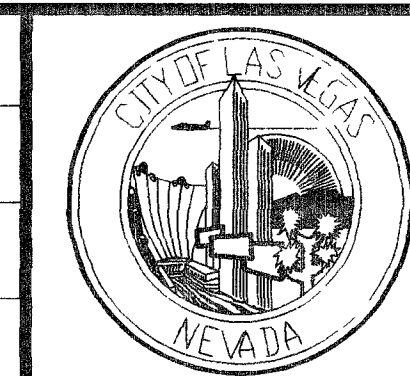

DOWNTOWN CORRIDOR IMPROVEMENTS
CITY OF LAS VEGAS DEPT. OF PUBLIC WORKS
LAS VEGAS, NEVADA

CONFORMED:
1-16-95
DATE 12/06/94
SCALE
VER 1" = 4'
HOR 1" = 40'

PLAN AND PROFILE
STA.94+00 TO STA.106+00

DWG NO
107 v-
FILE NO
SHEET
SD-1