
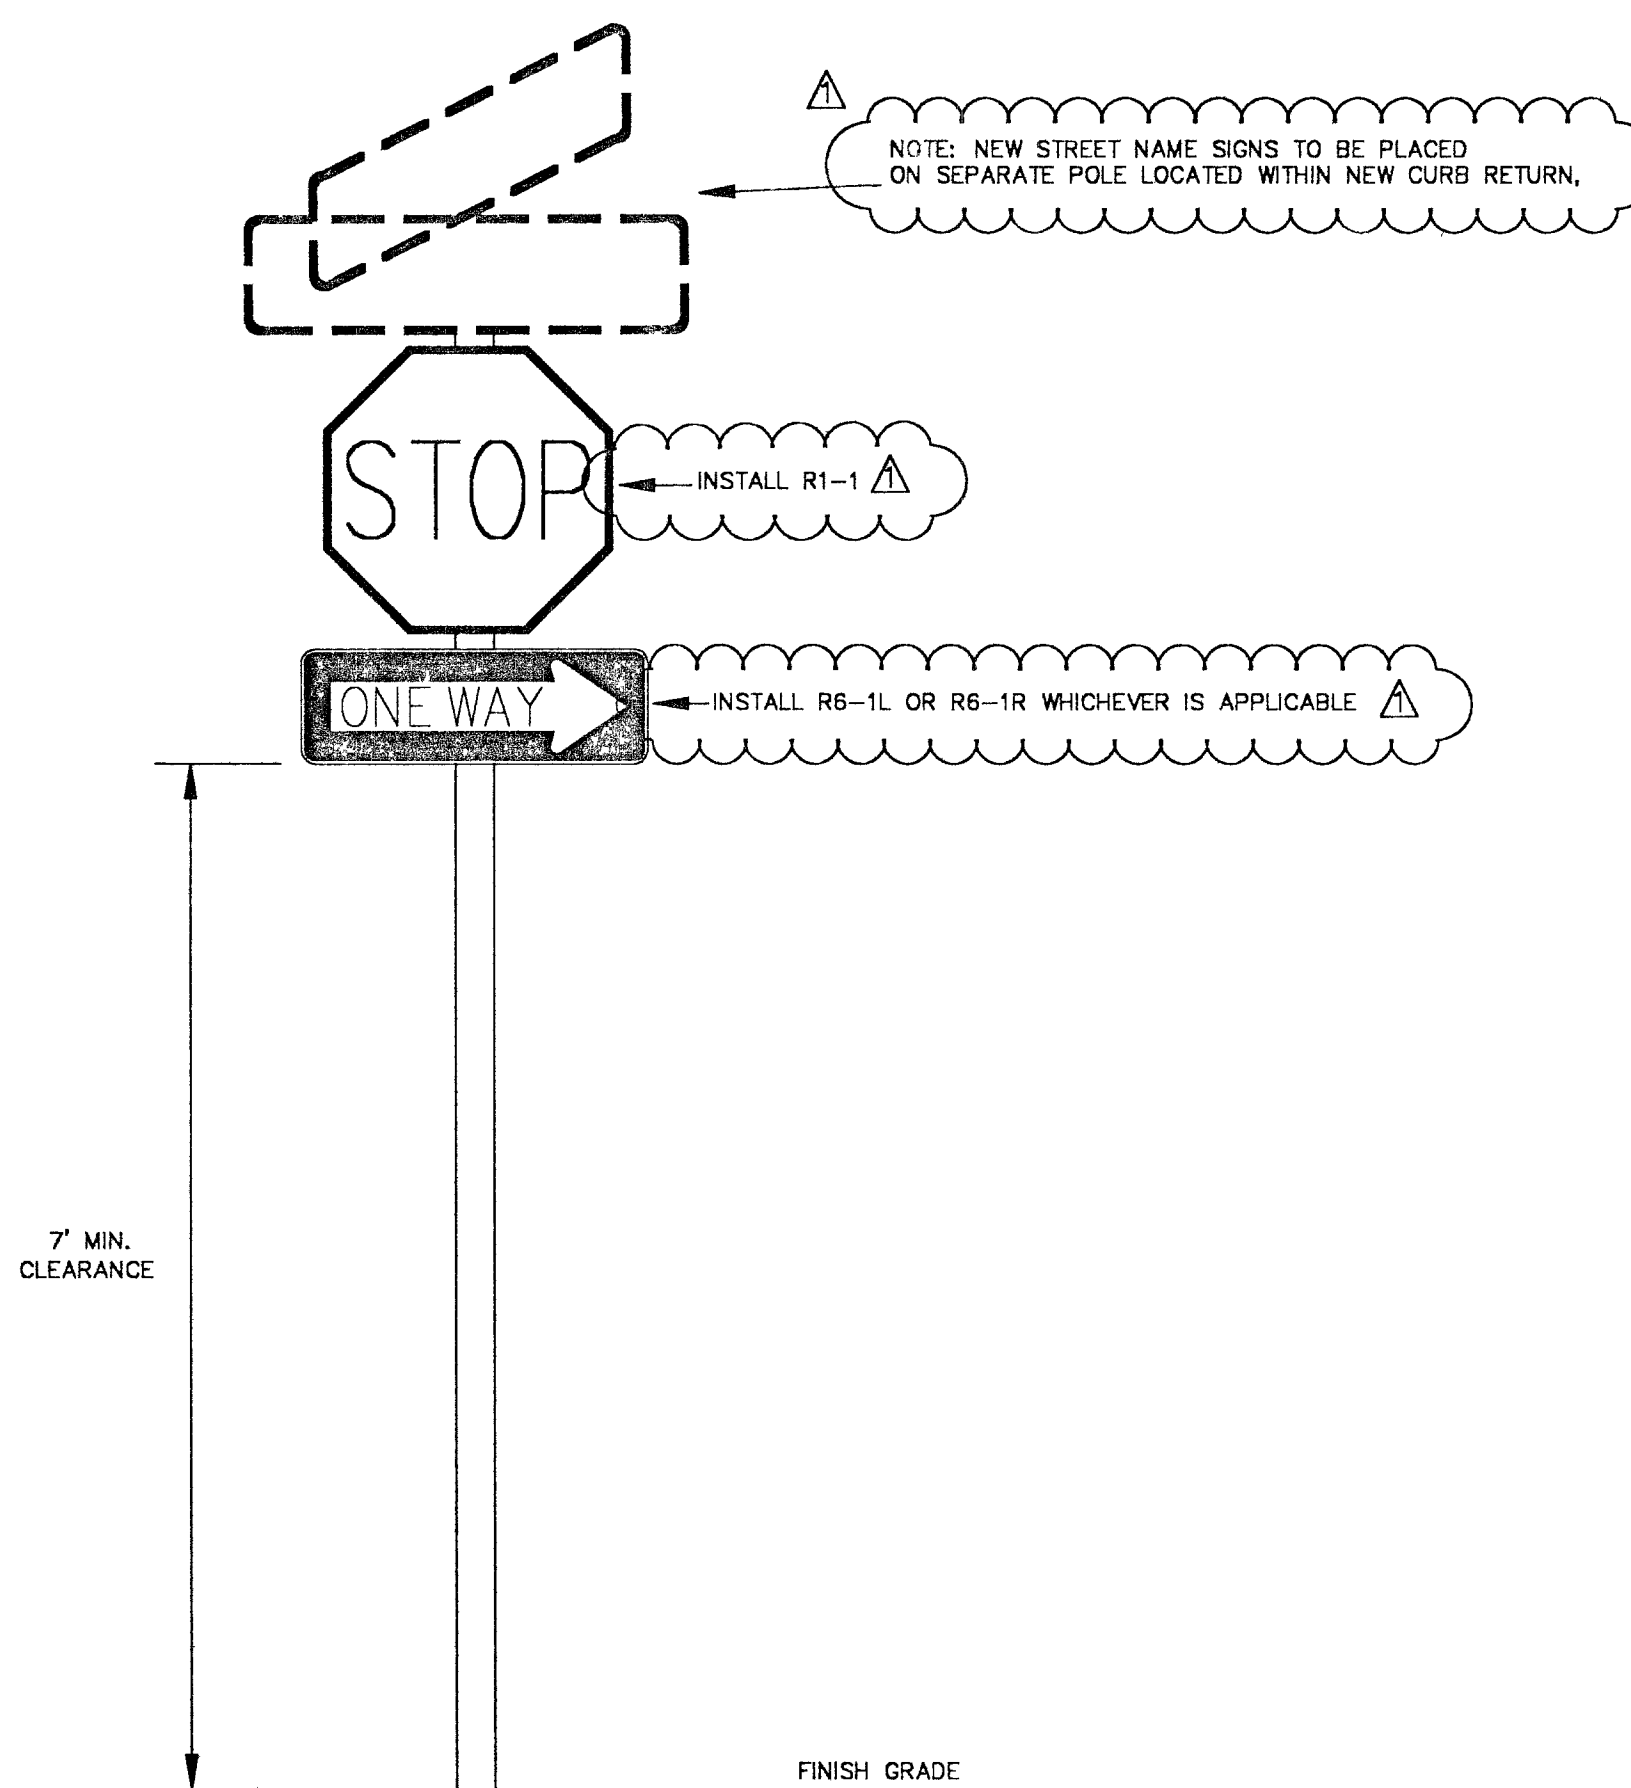


GENERAL NOTES TRAFFIC SIGNS

1. THE CONTRACTOR SHALL TAKE ALL PRECAUTIONARY MEASURES NECESSARY TO PROTECT EXISTING IMPROVEMENTS WHICH ARE TO REMAIN IN PLACE FROM DAMAGE, AND ALL SUCH IMPROVEMENTS OR STRUCTURES DAMAGED BY THE CONTRACTORS OPERATIONS SHALL BE REPAIRED OR RECONSTRUCTED SATISFACTORY TO THE ENGINEER AT THE EXPENSE OF THE CONTRACTOR.
2. RETURN ALL TRAFFIC SIGNAL AND SIGNAGE EQUIPMENT SALVAGED TO CITY OF LAS VEGAS BONANZA YARD.
3. ALL SIGN SHEETING TO BE 3M V.I.P. GRADE OR APPROVED EQUAL. SIGN PANELS NOT CONSTRUCTED WITH THIS MATERIAL SHALL BE REPLACED WITH NEW SIGN PANELS, AND THE EXISTING PANELS SALVAGED AND DELIVERED TO THE CITY OF LAS VEGAS BONANZA YARD.
4. CONTRACTOR TO COORDINATE WITH REGIONAL TRANSPORTATION COMMISSION (RTC) FOR CAT-BUS STOP SIGN DETAIL AND ROUTE NUMBER. SUPPLY AND INSTALLATION OF TRANSIT SYSTEM SIGNAGE IS NOT A PART OF THIS CONTRACT.
5. ALL SIGNS TO BE CENTERED 2'-6" FROM BACK OF CURB, UNLESS OTHERWISE INDICATED ON PLANS.
6. PRIOR TO PERFORMING ANY SIGNAGE WORK, THE CONTRACTOR SHALL INVENTORY ALL EXISTING SIGNS AS SHOWN ON THE PLANS AND PROVIDE WRITTEN SUMMARY AND COMMENTS TO THE ENGINEER CONFIRMING THE AMOUNT OF WORK TO BE PERFORMED.
7. EXACT LOCATION OF ALL SIGNS SHALL BE STAKED BY THE CONTRACTOR FOR REVIEW AND APPROVAL BY THE ENGINEER. NOTIFY TRAFFIC DIVISION 48 HOURS PRIOR TO PERFORMING ANY SIGN INSTALLATION WORK.

CONSTRUCTION NOTES TRAFFIC SIGNS

1. EXISTING SIGN TO REMAIN (IF EXISTING SIGN NOT VIP ON 4TH STREET, THEN REPLACE WITH VIP SHEETING) (EXCEPTION: NON-INTERNALLY ILLUMINATED STREET NAME SIGNS SHALL NOT REQUIRE UPGRADING UNDER THIS CONTRACT.)
2. REMOVE AND SALVAGE EXISTING SIGN INSTALLATION
3. INSTALL NEW SIGN(S) (VIP SHEETING)
4. RELOCATE SIGN TO NEW LOCATION SHOWN (REPLACE SIGN PANEL WITH NEW VIP SHEETING PANEL AND SALVAGE EXISTING SIGN PANEL)
5. INTERNALLY ILLUMINATED DIRECTION ARROW SIGNS TO REMAIN IN PLACE AND UNMODIFIED.

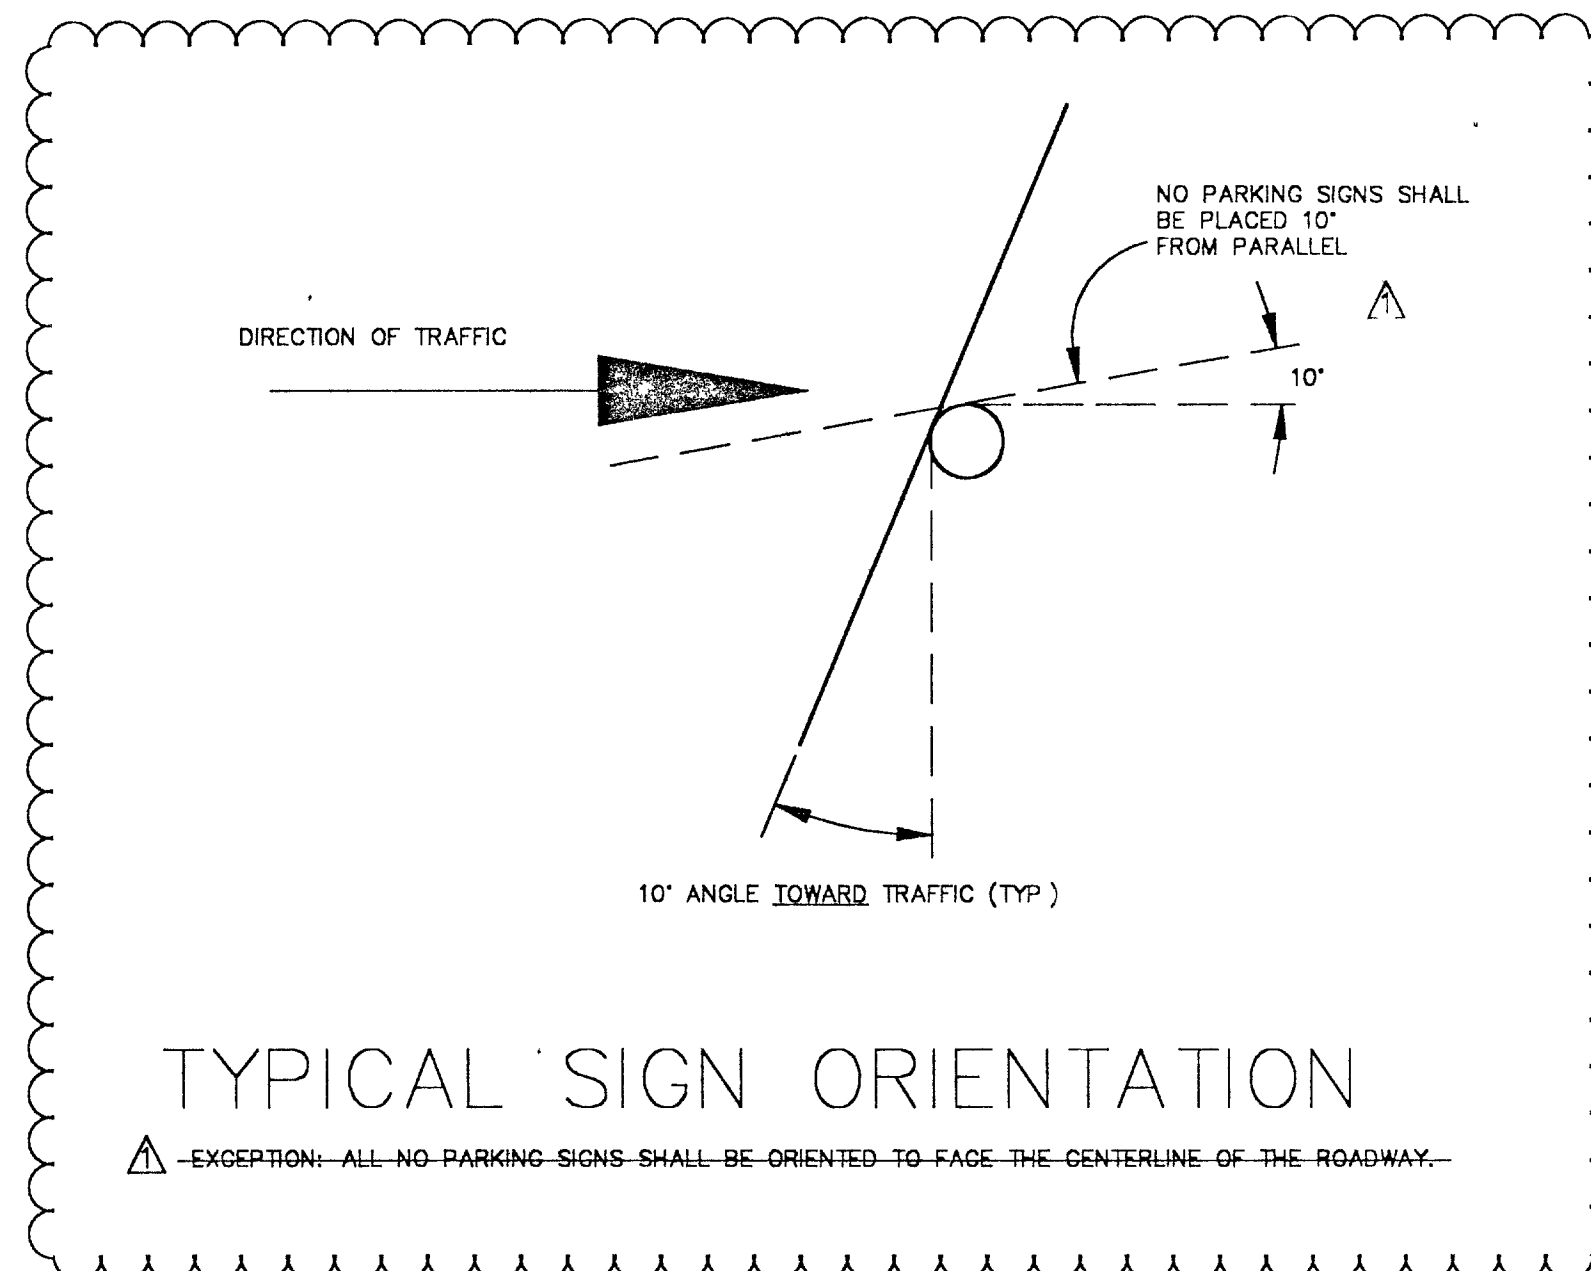

TYPICAL STOP SIGN INSTALLATION

SIGN SCHEDULE


(LOCATION PER PLANS)

DESCRIPTION	TYPE & SIZE	SHEET S-2	SHEET S-3	SHEET S-4	SHEET S-5	SHEET S-6	TOTAL
SIGN AND SUPPORT (NEW) OR NEW SIGN PANEL ON EXISTING SUPPORT	R5-1 30"x30"	4	4	6	4	2-6	20-24
	R3-1 24"x24"	6	4-6	4-5	5	2	21-24
	R3-2 24"x24"	2	4	4	2-5	4-3	13-18
	R6-1L 36"x12"	7	7	6	2	3	25
	R6-1R 36"x12"	3	4-6	4-4	2-3	3	10-19
	W11A-2 R7-2a(R) 12"x18" 30"x30"	2	2	4	-	4-	8
	R1-1 R7-2a(L) 12"x18" 30"x30"	3	2	3	-	4-	8
	R7-2a(B) 12"x18"	3	4	-	9-6	2	15
	W4-2 36"x36"	-	-	2	-	-	2
	R7-10B 12"x18"	2	7	4	-	2	15
	R2-1 24"x30"	3	3	4	1	-	11
	R3-7L 30"x30"	-	1	1	4	2	8
	R3-7R 30"x30"	-	-	-	2	4-2	4
	D3 VARIES	7	3	6	-	4	20
	R1-2 30"x30"	-	-	-	-	1	1
	"BUSES ONLY"	-	-	-	-	2	2
	M4-5 24"x12"	-	-	-	-	2	2
	M6-3 21"x15"	-	-	-	-	2	2
	M1-1 24"x24"	-	-	-	-	1	1
	M1-4 24"x24"	-	-	-	-	1	1
	"NO PARKING TROLLEY STOP"	-	-	-	-	1	1
TOTAL		22-42	40-49	39-49	29-32	20-39	150-211
RELOCATE EXISTING SIGN SUPPORT AND INSTALL NEW SIGN PANEL	R1-1 30"x30"	3	2	2	-	-	7
	R6-1L 36"x12"	7	7	5	2	-	21
	R6-1R 36"x12"	3	1	2	-	-	6
	D3 VARIES	7	3	4	-	2	16
	W11A-2 30"x30"	-	-	2	-	-	2
	R7-10B 12"x18"	1	-	-	-	-	1
	R2-1 24"x30"	2	-	1	1	-	4
	R3-1 24"x24"	-	1	1	1	-	3
	R3-5 INTERNALLY ILLUMINATED	-	-	-	-	3	3
	R1-2 30"x30"	-	-	-	-	4	4
	M4-5 24"x12"	-	-	-	-	2	2
	M6-3 21"x15"	-	-	-	-	2	2
	M1-1 24"x24"	-	-	-	-	1	1
	M1-4 24"x24"	-	-	-	-	1	1
TOTAL		23	14	17	4	15	73
REMOVE AND SALVAGE EXISTING SIGN AND SUPPORT INSTALLATION	R7-10B 12"x18"	4	8	5	6	1	24
	R6-1R 36"x12"	4	6	5	4-2	5	22
	D3 VARIES	7	7	10	6	7	37
	R2-1 24"x30"	3	4	4	1	-	12
	R6-1L 36"x12"	7	9	9	-	3	28
	R7-8 12"x18"	-	-	1	-	-	1
	"RIGHT TURN ONLY"	-	-	-	-	1	1
	"TOW AWAY ZONE"	-	-	-	-	1	1
	R1-1 30"x30"	3	2	3	-	-	8
	R3-1 24"x24"	2	3	4	4	-	13
	R3-2 24"x24"	1	2	1	1	-	5
	W11A-2 30"x30"	-	-	2	-	-	2
	M4-5 24"x12"	-	-	-	-	2	2
	M6-3 21"x15"	-	-	-	-	2	2
	M1-1 24"x24"	-	-	-	-	1	1
	M1-4 24"x24"	-	-	-	-	1	1
	R5-1 30"x30"	-	-	-	-	2	2
	"BUSES ONLY"	-	-	-	-	2	2
	R3-7L 30"x30"	-	-	-	-	2	2
	R3-7R 30"x30"	-	-	-	-	2	2
	R1-2 30"x30"	-	-	-	-	1	1
TOTAL		2-31	9-41	11-44	13-20	10-33	45-168

Time: 8:49:36
Date: 12/12/1994
Drawing File: 990302/S-1

NO.	REVISIONS AND DELETIONS/ADDITIONS AS PER ADDENDUM 1	DATE	BY
1	REVISIONS	12/13/94	AB

Large Brackets
12-13-94

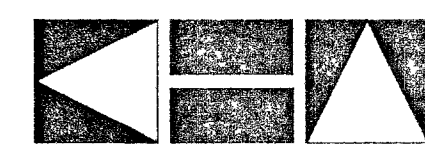

Kimley-Horn
and Associates, Inc.

Las Vegas, Nevada


© 1994

DESIGNED BY RKS

DRAWN BY RKS

CHECKED BY *AB*

NOTE BOOK NO.

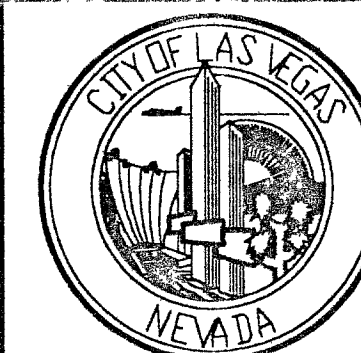

DOWNTOWN CORRIDOR IMPROVEMENTS
CITY OF LAS VEGAS DEPT. OF PUBLIC WORKS
LAS VEGAS, NEVADA

Califormed:
1-16-95

DATE 12/94

SCALE

NA

SIGNING
GENERAL NOTES

DWG. NO.
107-V-2288
FILE NO.
9903.02

SHEET
S-1