



- 1 EXISTING SIGN TO REMAIN (IF EXISTING SIGN NOT VP ON 4TH STREET, THEN REPLACE WITH VP SHEETING)
- 2 REMOVE AND SALVAGE EXISTING SIGN INSTALLATION
- 3 INSTALL NEW SIGN(S) (VP SHEETING)
- 4 RELOCATE SIGN TO NEW LOCATION SHOWN (REPLACE SIGN PANEL WITH NEW VP SHEETING PANEL AND SALVAGE EXISTING SIGN PANEL)

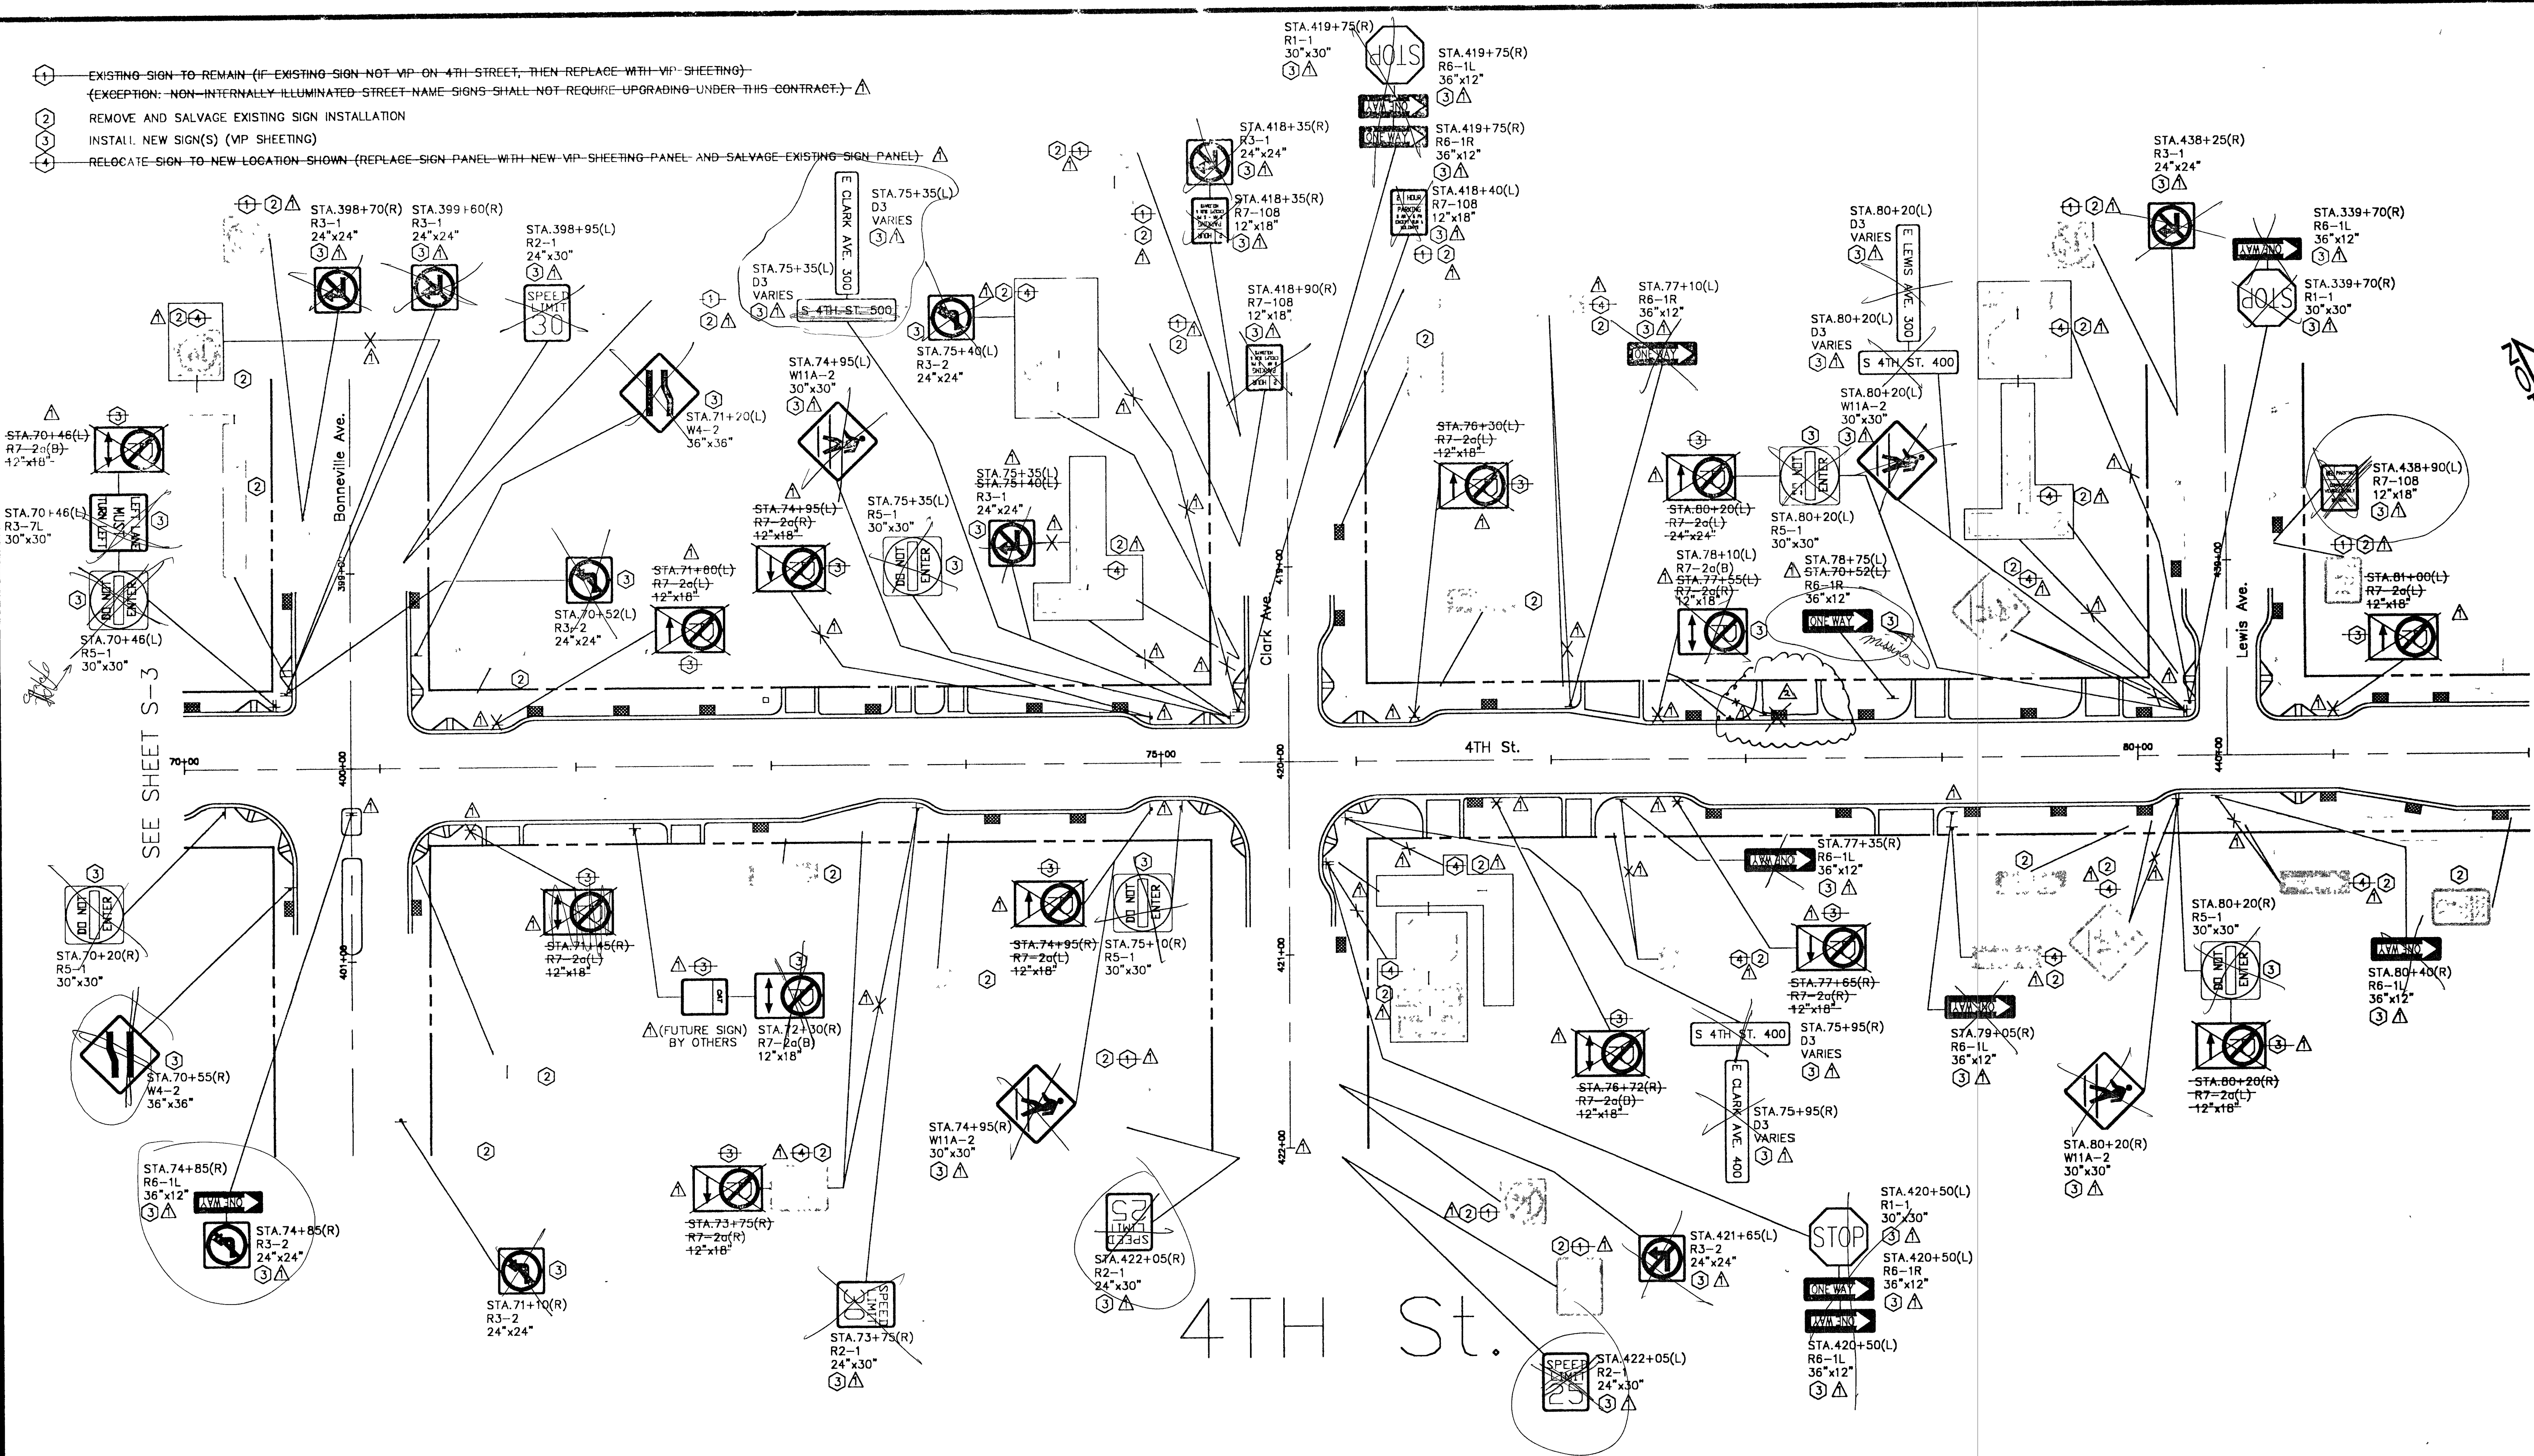

ENTIRE SHEET

Time: 15:00:00
Date: 11/17/1994
Drawing File: 990302\S-4

94994		
DRIVEWAY ADDITION PER 1/12/95 MEETING	1/13/95	
REVISIONS AND SIGNAGE CHANGES PER ADDENDUM 1: ENTIRE SHEET	12/13/94	
NO.	REVISIONS	DATE

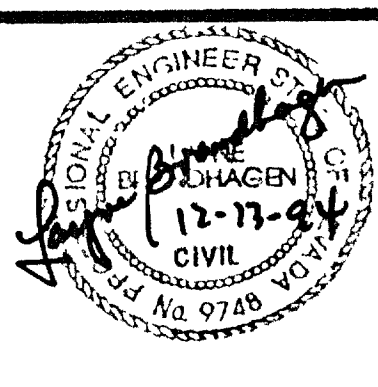

Kimley-Horn and Associates, Inc.
Las Vegas, Nevada © 1994

DESIGNED BY JHK
DRAWN BY RKS
CHECKED BY *SB*
NOTE BOOK NO.



DOWNTOWN CORRIDOR IMPROVEMENTS
CITY OF LAS VEGAS DEPT. OF PUBLIC WORKS
LAS VEGAS, NEVADA

Call Form 1-16-95
DATE 12/94
SCALE 1" = 40'

SIGNING PLAN
STA. 70+00 TO STA. 82+00

DWG. NO. 107-V-2288
FILE NO. 9903.02
SHEET S-4

Call before you Dig.
1-800-227-2800