



- 1- EXISTING SIGN TO REMAIN (IF EXISTING SIGN NOT V.P. ON 4TH STREET, THEN REPLACE WITH V.P. SHEETING)
 (EXCEPTION: NON-INTERNALLY ILLUMINATED STREET NAME SIGNS SHALL NOT REQUIRE UPGRADING UNDER THIS CONTRACT.)
 2- REMOVE AND SALVAGE EXISTING SIGN INSTALLATION
 3- INSTALL NEW SIGN(S) (V.P. SHEETING)
 4- RELOCATE SIGN TO NEW LOCATION SHOWN (REPLACE SIGN PANEL WITH NEW V.P. SHEETING PANEL AND SALVAGE EXISTING SIGN PANEL)

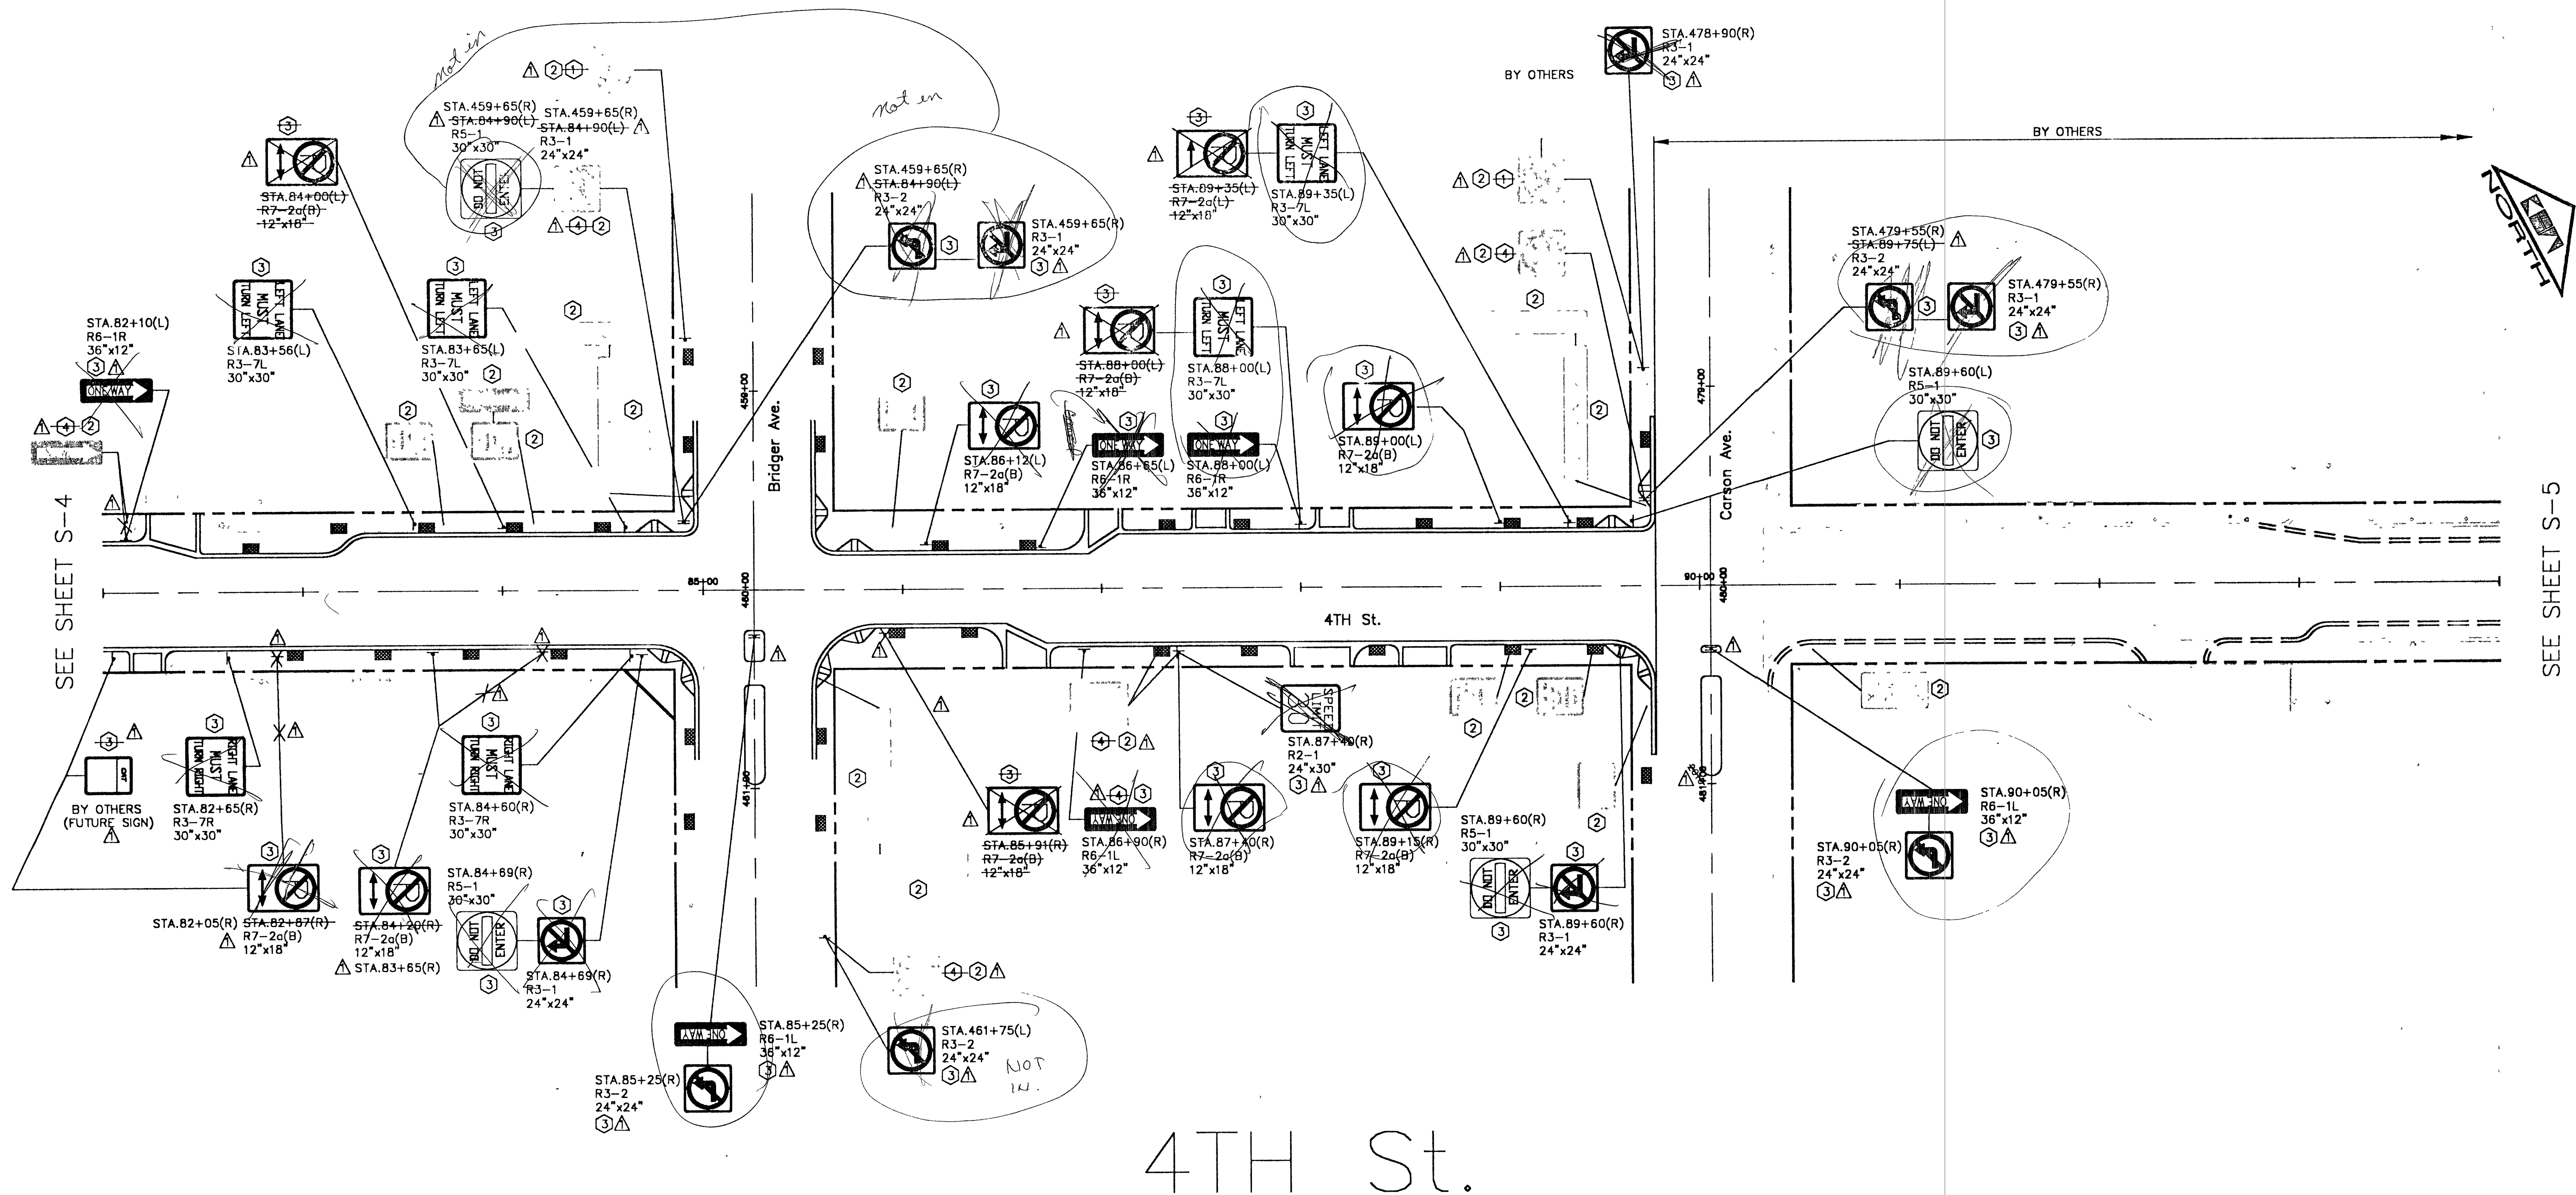

ENTIRE SHEET

Time: 15:15:00.0
 Date: 11/17/1994
 Drawing File: 990302\S-5

94992			
NO.	REVISIONS	DATE	BY
1	REVISIONS AND SIGNAGE CHANGES PER ADDENDUM 1: ENTIRE SHEET	12/13/94	JP

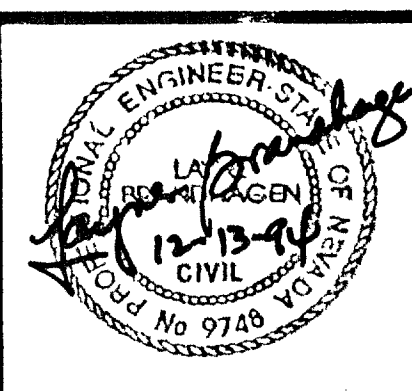

Kimley-Horn and Associates, Inc.
 Las Vegas, Nevada
 © 1994

DESIGNED BY JHK
 DRAWN BY RKS
 CHECKED BY *JP*
 NOTE BOOK NO.



DOWNTOWN CORRIDOR IMPROVEMENTS
 CITY OF LAS VEGAS DEPT. OF PUBLIC WORKS
 LAS VEGAS, NEVADA

Cal Form 1-16-95
 DATE 12/94
 SCALE 1" = 40'

SIGNING PLAN
STA.82+00 TO STA.94+00

DWG. NO. 107-V-2288
 FILE NO. 9903.02
 SHEET S-5

Call before you Dig.
 1-800-227-2600