



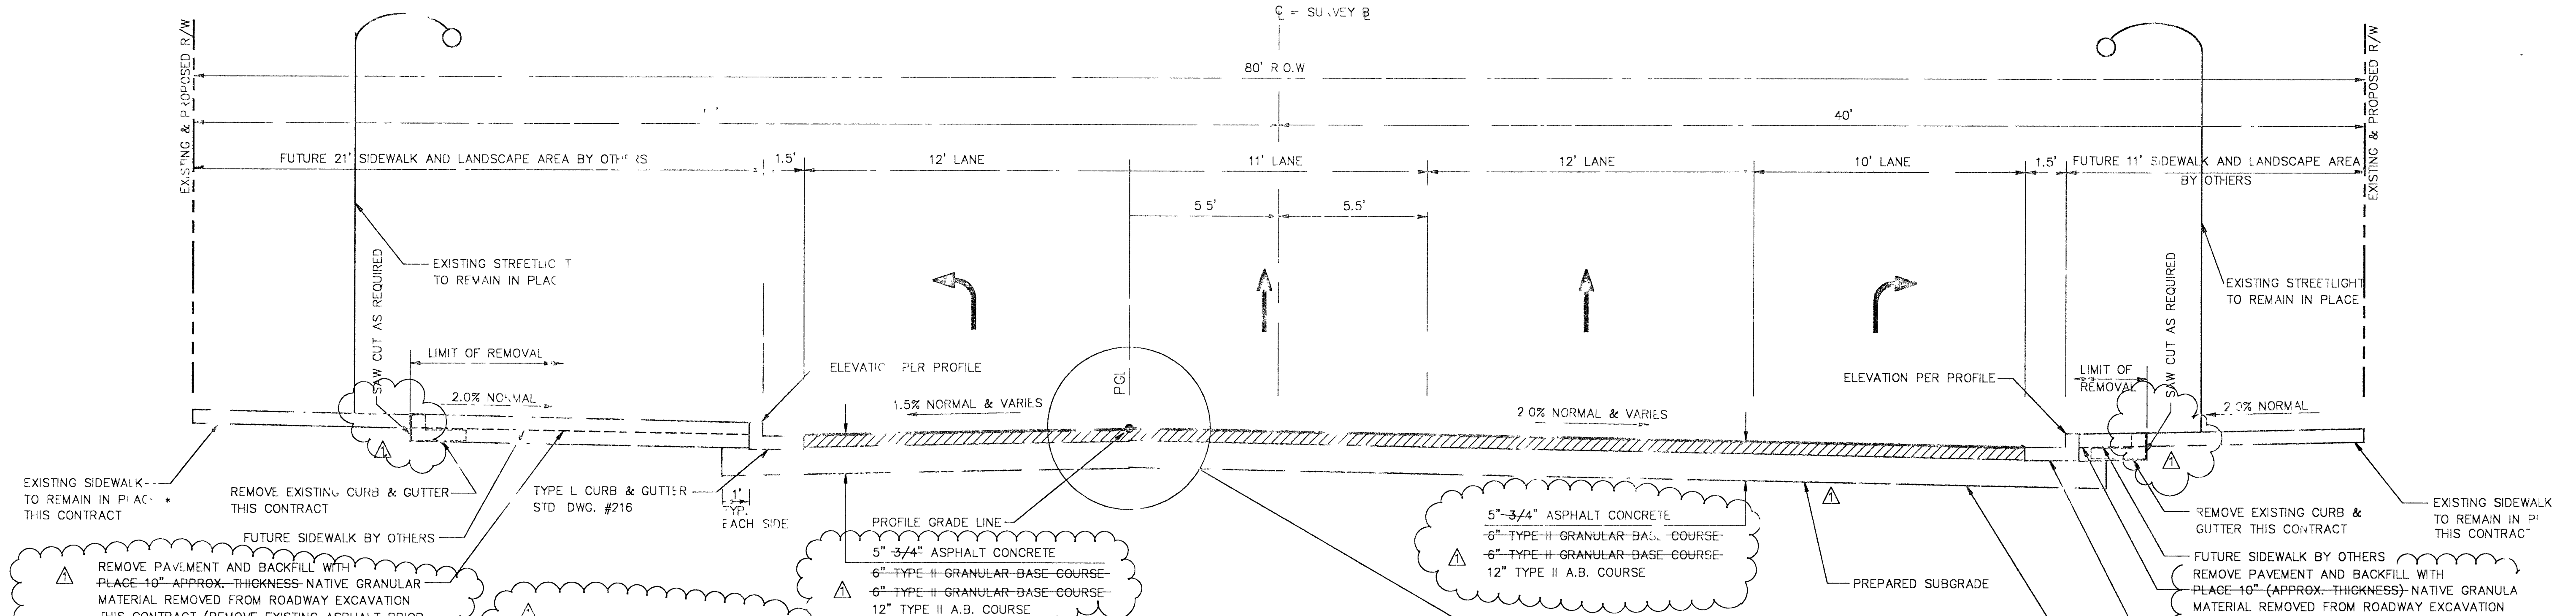


4TH STREET (LOOKING NORTH)
TYPICAL-2 LANES NB-TURN LANES LT AND RT @ STEWART

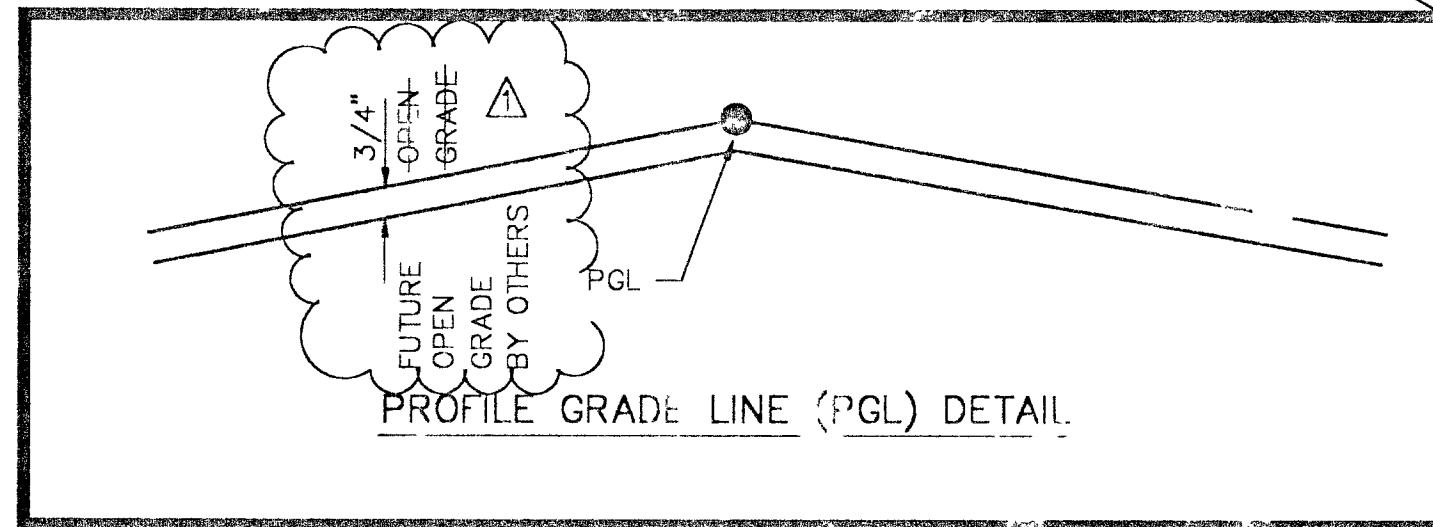

EXISTING SIDEWALK WIDTHS

SECTION	APPROX. WIDTH
CHARLES BLVD TO GASS AVENUE	7.5'
GASS AVENUE TO LEWIS AVENUE	5.0'
LEWIS AVENUE TO BRIDGER AVENUE	5.0'
BRIDGER AVENUE TO STEWART AVENUE	9.5'

(EXISTING SIDEWALKS ARE TO REMAIN IN PLACE UNDER THIS CONTRACT.)

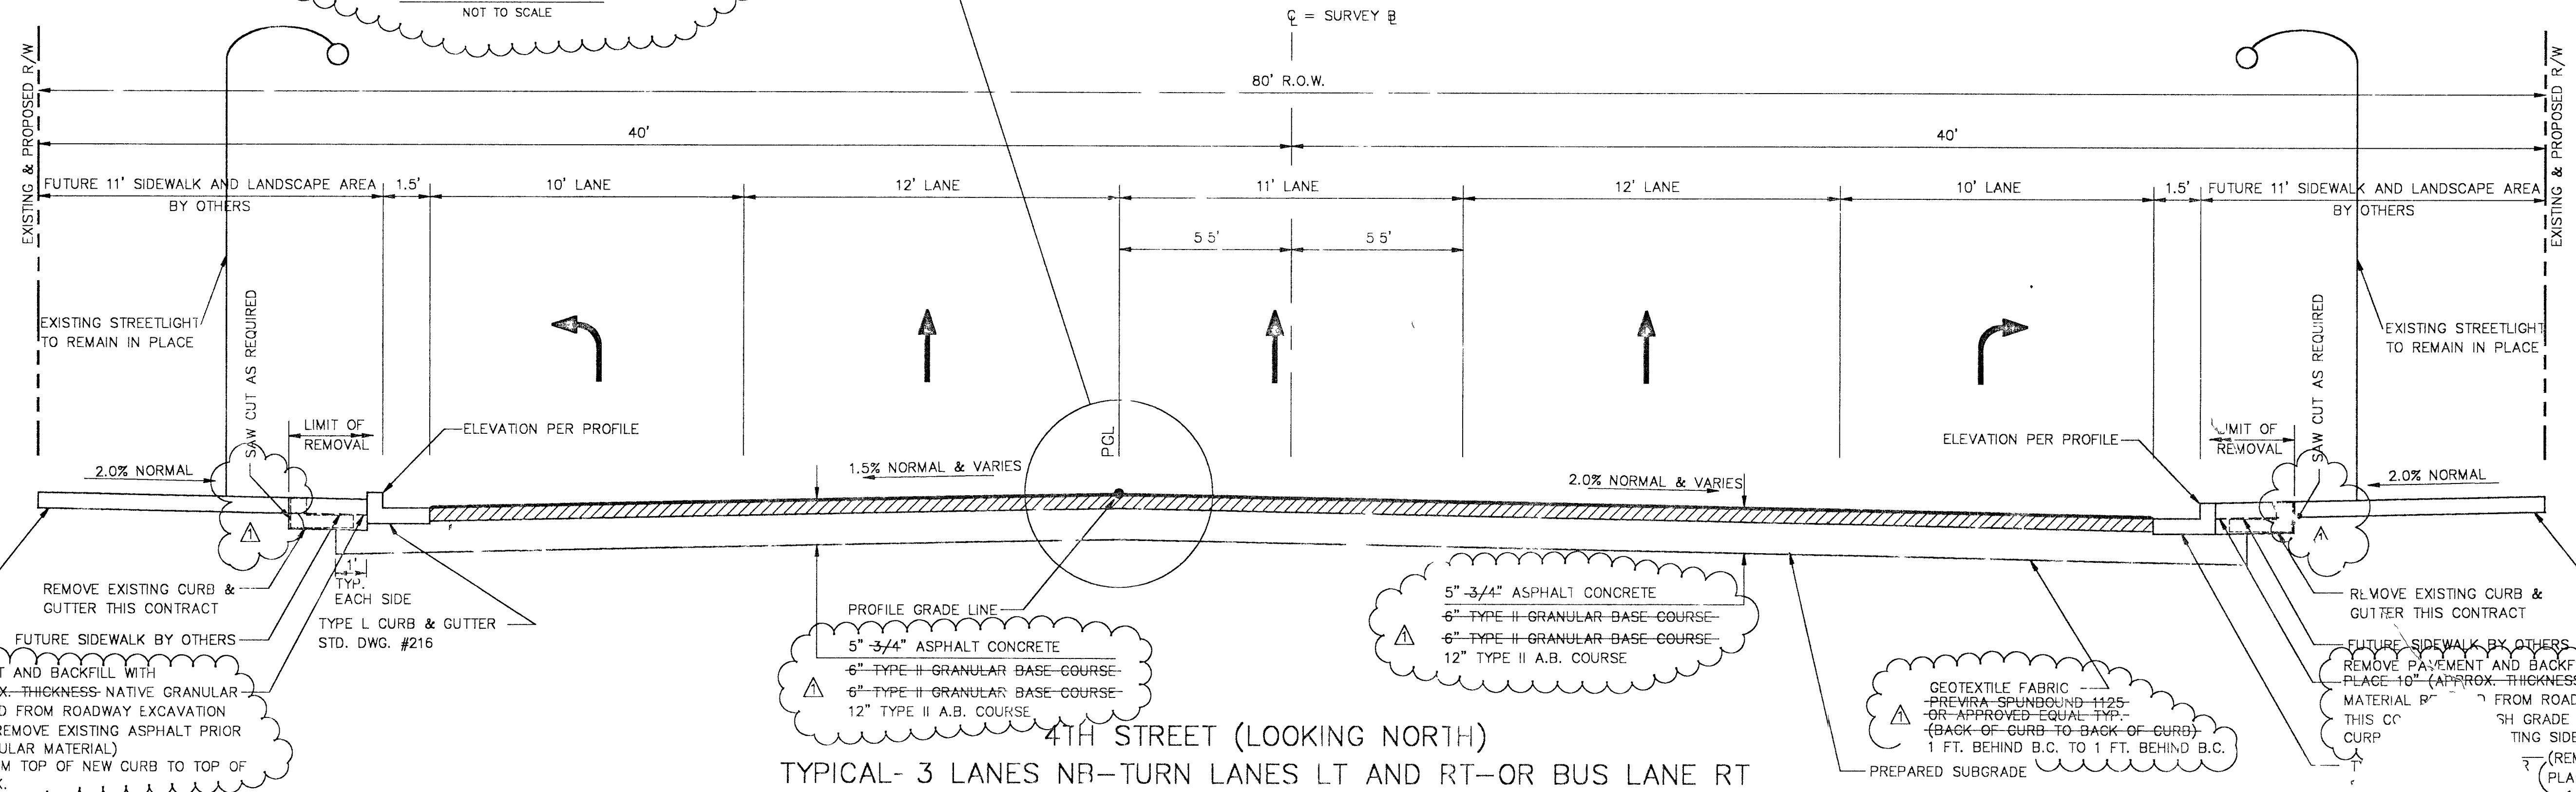

4TH STREET (LOOKING NORTH)
TYPICAL-3 LANES NB-TURN LANES LT AND RT-OR BUS LANE RT

Time 14:30:00
Date 12/12/1994
Drawing File 990302

24966


NO.	REVISIONS AND ADDITIONS AS PER ADDENDUM 1.	DATE	BY
1	REVISIONS	12/13/94	LAB

Large Brundage
12-13-94

Kimley-Horn and Associates, Inc.
Las Vegas, Nevada

DESIGNED BY JHK
DRAWN BY CWE
CHECKED BY LAB
NOTE BOOK NO.

© 1994

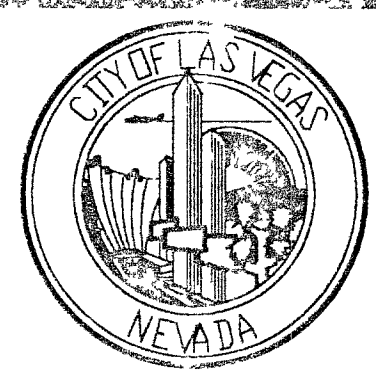

DOWNTOWN CORRIDOR IMPROVEMENTS
CITY OF LAS VEGAS DEPT. OF PUBLIC WORKS
LAS VEGAS, NEVADA

CONFORMED:
1-16-95
DATE 12/94
SCALE NA

ONS

DWG. NO. 107-1
FILE NO.