


- 1 INSTALL TEMPORARY LANE LINE (4" SOLID WHITE PAINT) WITH SPACING AS SHOWN ON SHEET M-1. Δ
- 2 INSTALL LANE LINE (AS PER UNIFORM STD. DWG. CLARK COUNTY AREA #246, TYPE 'F' MARKERS) Δ
- 3 INSTALL TEMPORARY TURN BAY (4" SOLID WHITE PAINT) CONTINUOUS THROUGHOUT TURN BAY.
- 4 INSTALL TURN BAY MARKINGS (AS PER UNIFORM STD. DWG. CLARK COUNTY AREA #246) Δ
- 5 INSTALL TRAFFIC SEPARATION GORE AREA MARKINGS (AS PER UNIFORM STD. DWG. CLARK COUNTY AREA #245) USING 8" SOLID YELLOW PAINT FOR BORDER IN LIEU OF PAVEMENT MARKERS CONTINUOUS THROUGHOUT. Δ
- 6 INSTALL 4" SOLID WHITE PARKING STALL PAINT LINE (SEE DETAIL THIS PAGE)
- 7 INSTALL 24" STOP BAR (GOLD-POLYMER-FILM) (SOLID WHITE PAINT) Δ
- 8 INSTALL WHITE 12" CROSSWALK LINES, TYPE II (10' CLEAR WIDTH BETWEEN LINES) USING SOLID WHITE PAINT Δ
- 9 INSTALL WHITE PAVEMENT ARROW (GOLD-POLYMER-FILM) (SOLID WHITE PAINT) Δ
- 10 INSTALL WHITE PAVEMENT "ONLY" (GOLD-POLYMER-FILM) (SOLID WHITE PAINT) Δ
- 11 TEMPORARY INSTALL WHITE PAVEMENT "BUS" (GOLD-POLYMER-FILM) Δ
- 12 INSTALL TYPE 1 CENTERLINE (AS PER UNIFORM STD. DWG. CLARK COUNTY AREA #244) Δ USING 2-4" SOLID YELLOW PAINT STRIPS 4" APART CONTINUOUS THROUGHOUT
- 13 EXISTING STRIPING PATTERN AND PAVEMENT LEGEND TO REMAIN
- 14 INSTALL RED PAINT ON TOP AND FACE OF CURB Δ

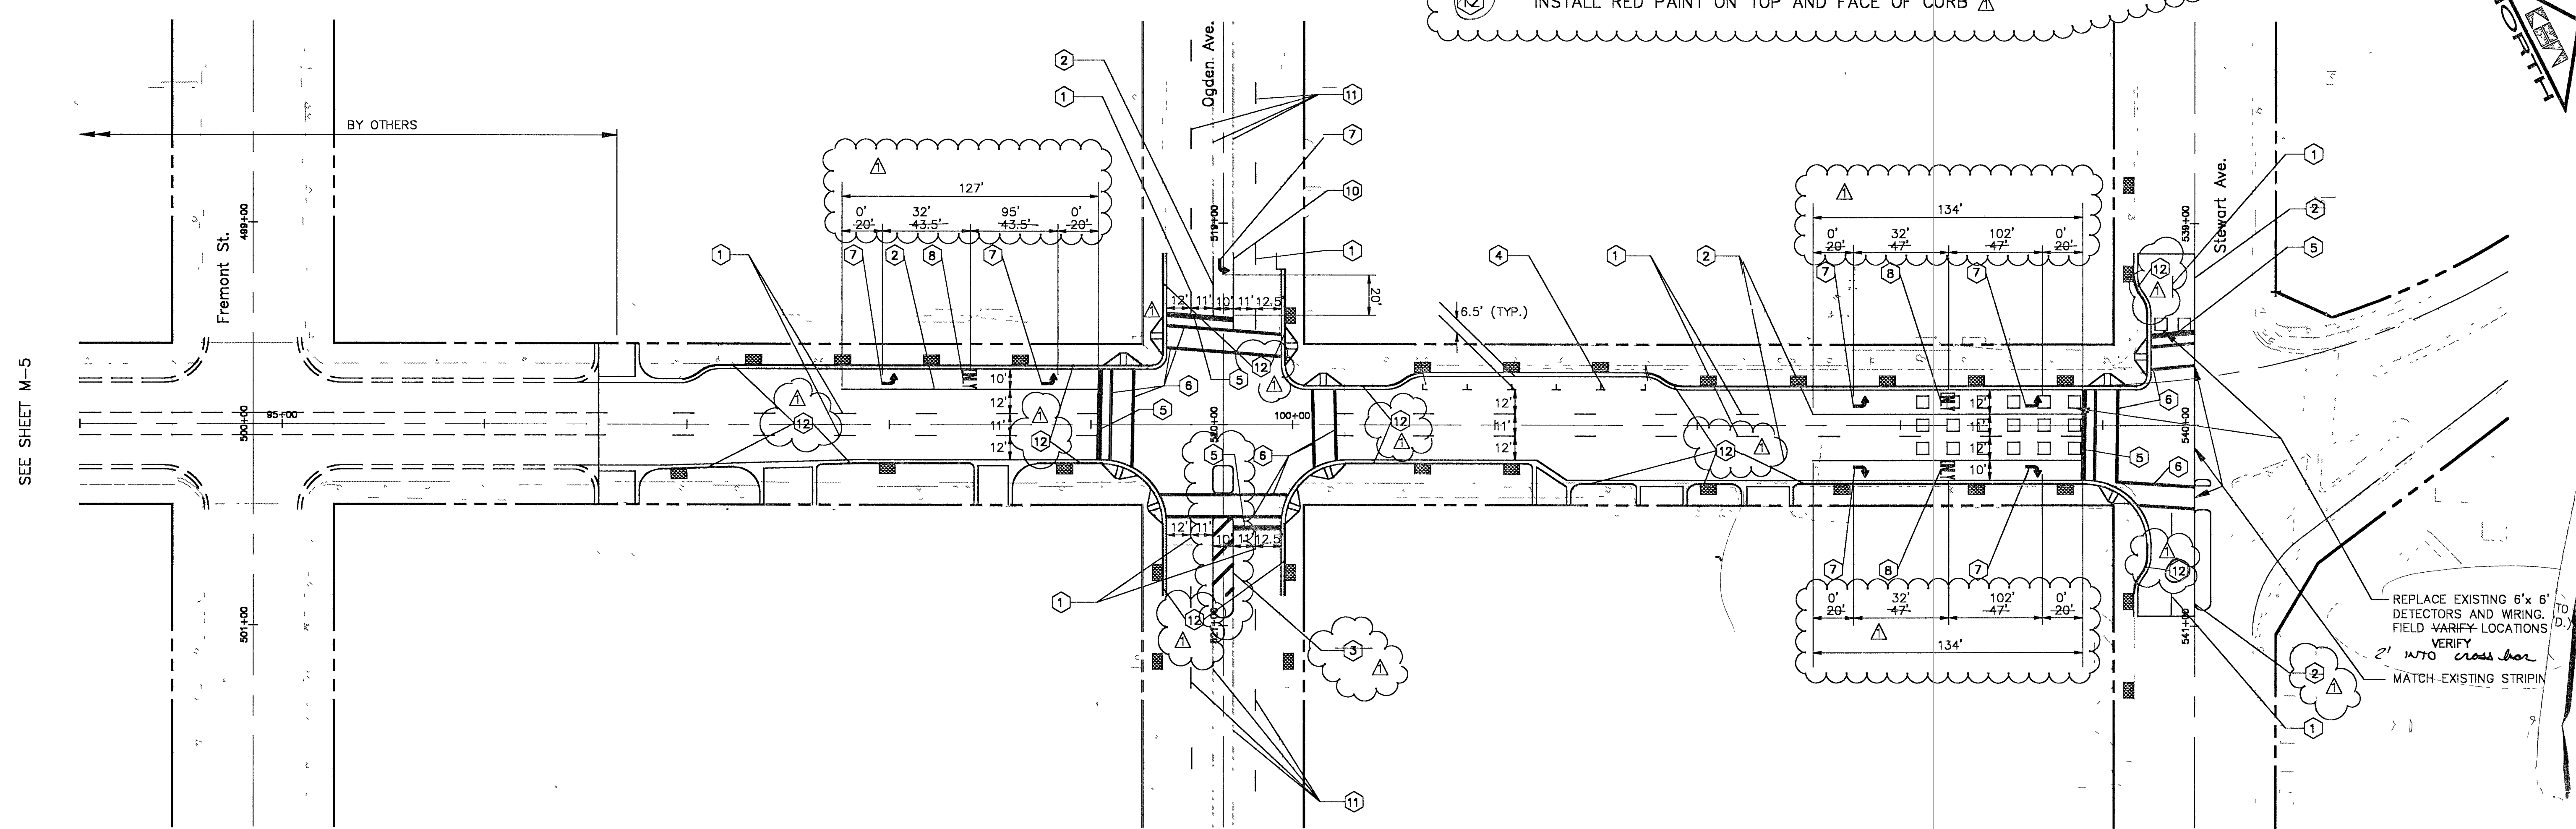


SEE SHEET M-5

Time: 15:15:00.0
Date: 12/15/1994
Drawing File: 990302\M-6

94999			
NO.	REVISIONS	DATE	BY
1	REVISIONS IN ACCORDANCE WITH ADDENDUM 1	12/13/94	LAB

Layne Brandt
1-16-95

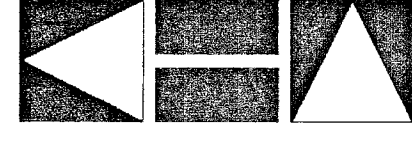 **Kimley-Horn and Associates, Inc.**
Las Vegas, Nevada © 1994

DESIGNED BY CDR
DRAWN BY CDR
CHECKED BY *LAB*
NOTE BOOK NO.



DOWNTOWN CORRIDOR IMPROVEMENTS
CITY OF LAS VEGAS DEPT. OF PUBLIC WORKS
LAS VEGAS, NEVADA

CONFORMED:
1-16-95
DATE 12/94
SCALE
1" = 40'

MARKING PLAN
94+00 TO ST 104+24

DWG. NO.
FILE NO. 9903
SHEET
M

Call before you Dig
1-800-227-2600