



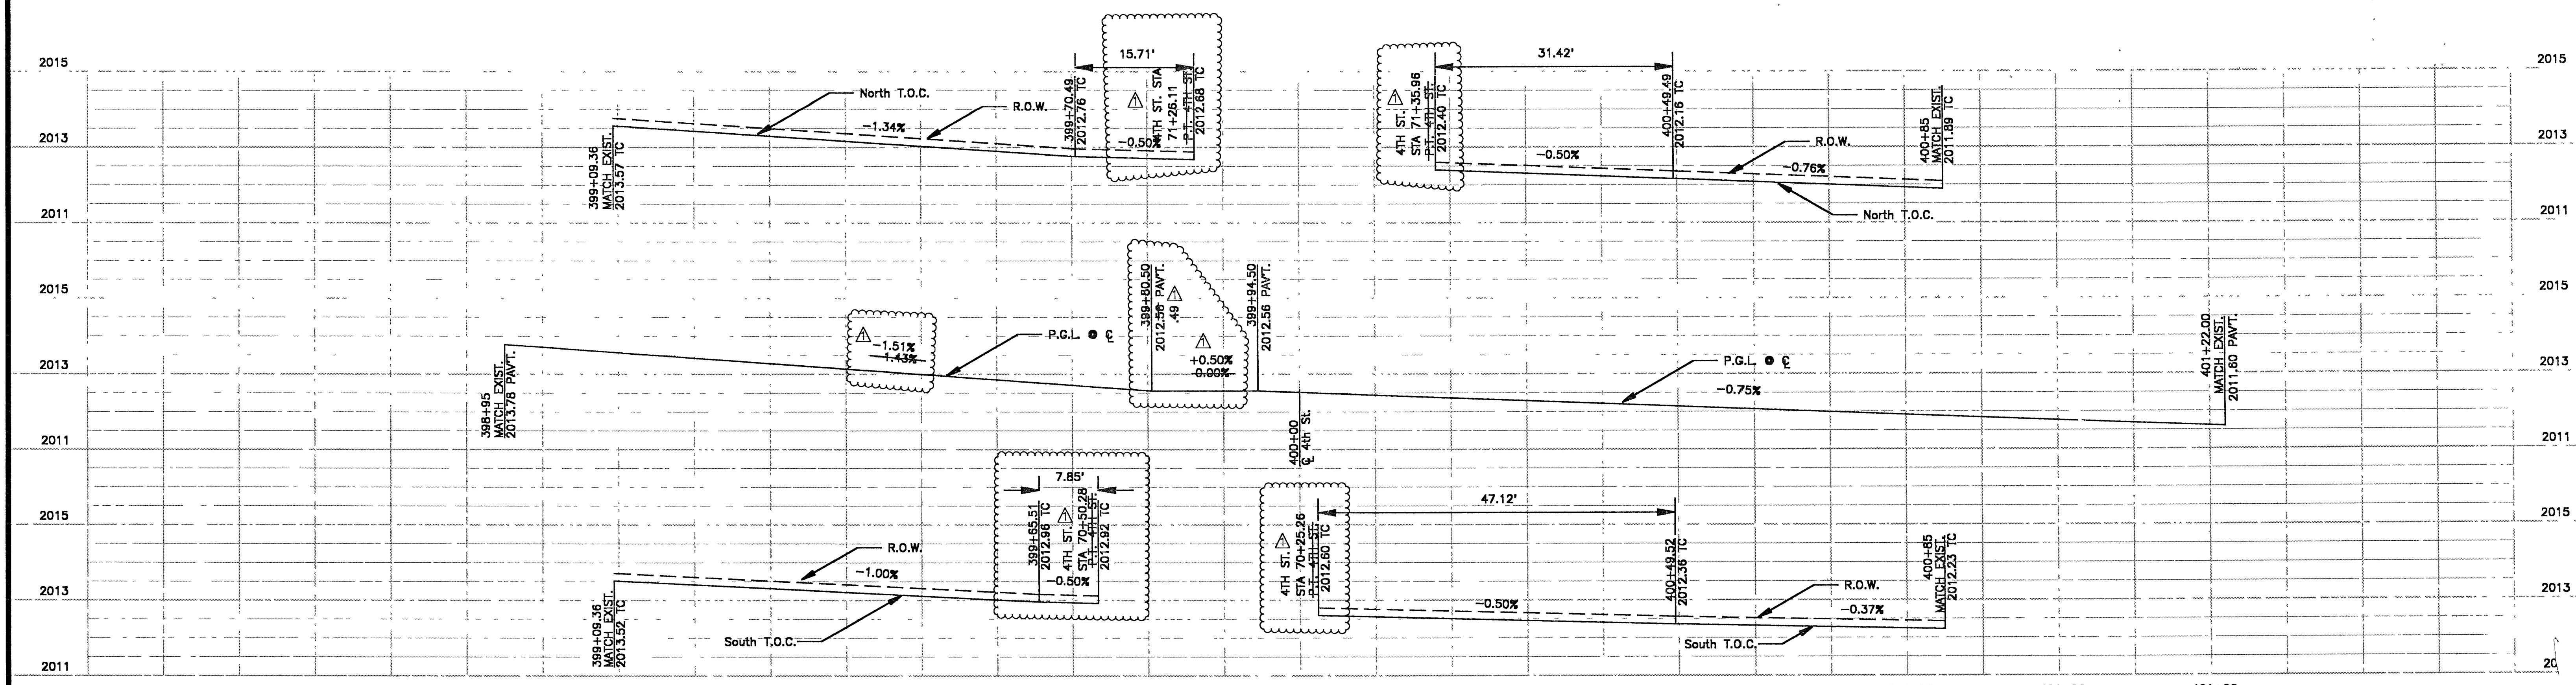

Bonneville Ave.

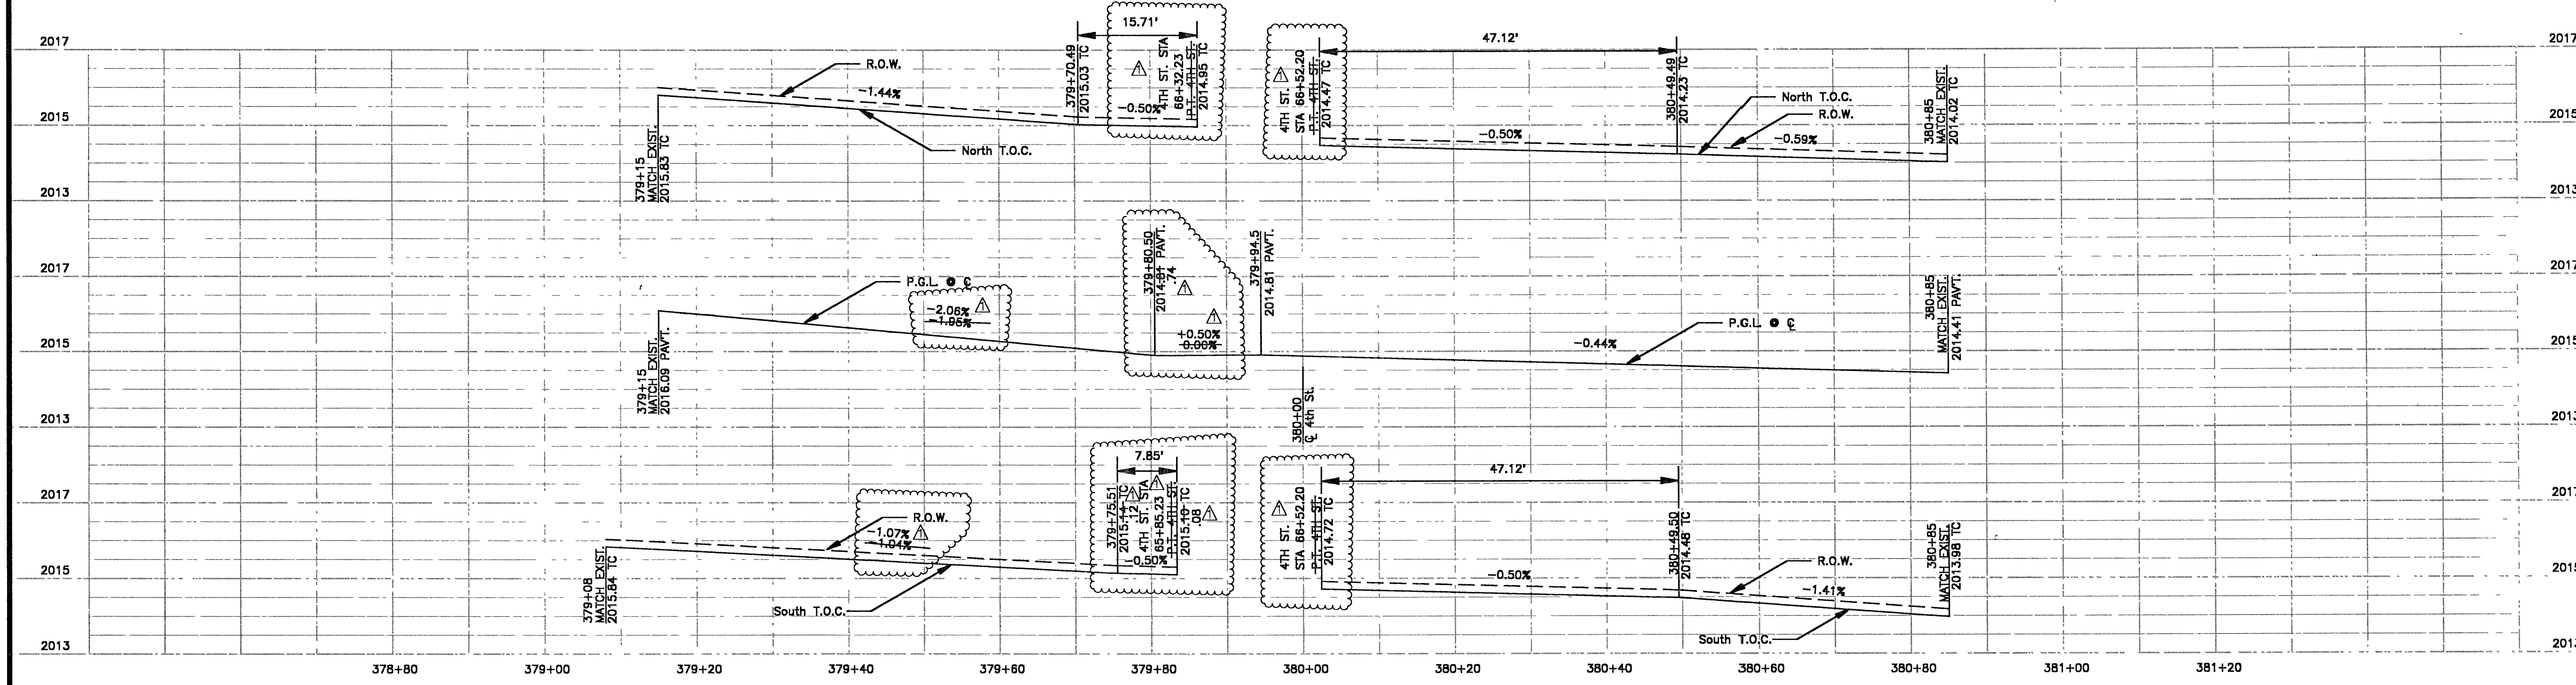


Garces Ave.


Time: 15:45:00.0
Date: 12/13/1994
Drawing File: 990302\c-8

94975			
REVISIONS IN ACCORDANCE WITH ADDENDUM 1	12/13/94	246	
NO.	REVISIONS	DATE	BY

Layne Brundage
1-16-95

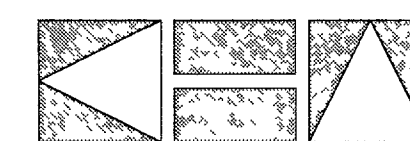 **Kimley-Horn and Associates, Inc.**
Las Vegas, Nevada © 1994

DESIGNED BY RKS
DRAWN BY RKS
CHECKED BY *LJB*
NOTE BOOK NO.

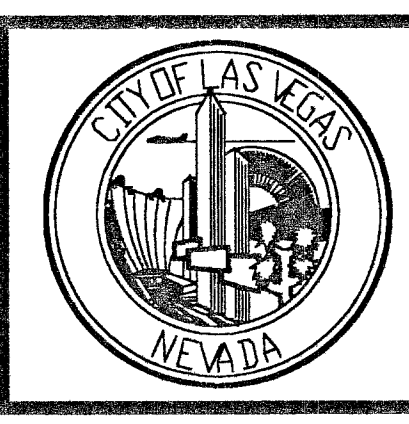

DOWNTOWN CORRIDOR IMPROVEMENTS
CITY OF LAS VEGAS DEPT. OF PUBLIC WORKS
LAS VEGAS, NEVADA

CALCULATED:
1-16-95
DATE 12/94
SCALE
1"=10' H
1"=2' V

**Cross Street Profiles—
Garces Ave. & Bonneville Ave.**

DWG. NO. 107-V-2288
FILE NO. 9903.02
SHEET C-8