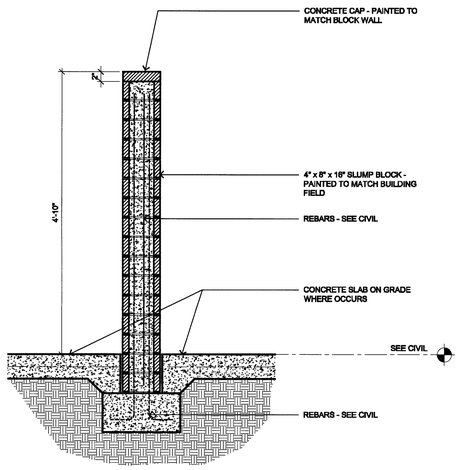

5 SCREEN WALL SECTION

1"=1'-0"

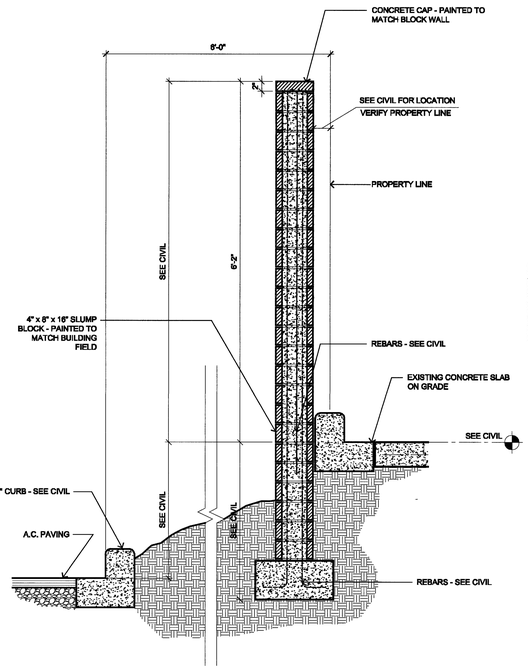

6 SECURITY WALL SECTION

1"=1'-0"

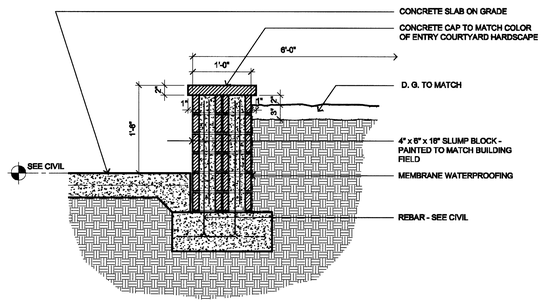

3 PLANTER SITTING WALL DETAIL

1"=1'-0"

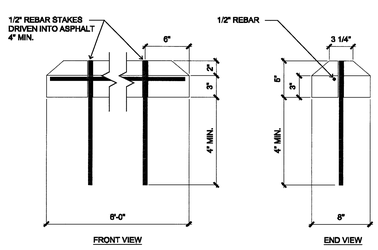

7 PARKING BUMPER

NOT TO SCALE

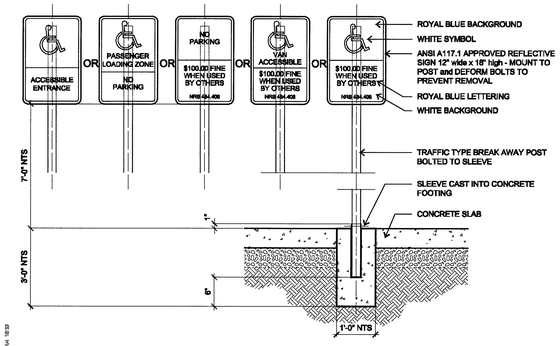

4 ELEVATION OF HANDICAP SIGN

NOT TO SCALE

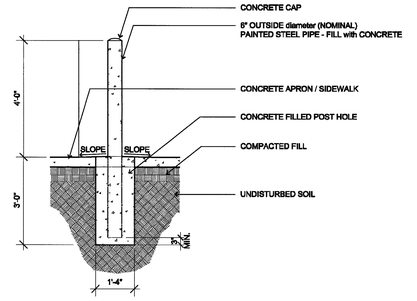

8 PIPE BOLLARD DETAIL

1/2"=1'-0"

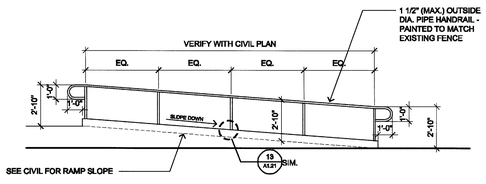

12 ELEVATION RAMP

1/4"=1'-0"

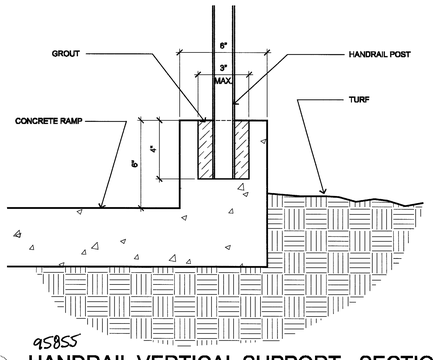

95855

13 HANDRAIL VERTICAL SUPPORT - SECTION

3"=1'-0"

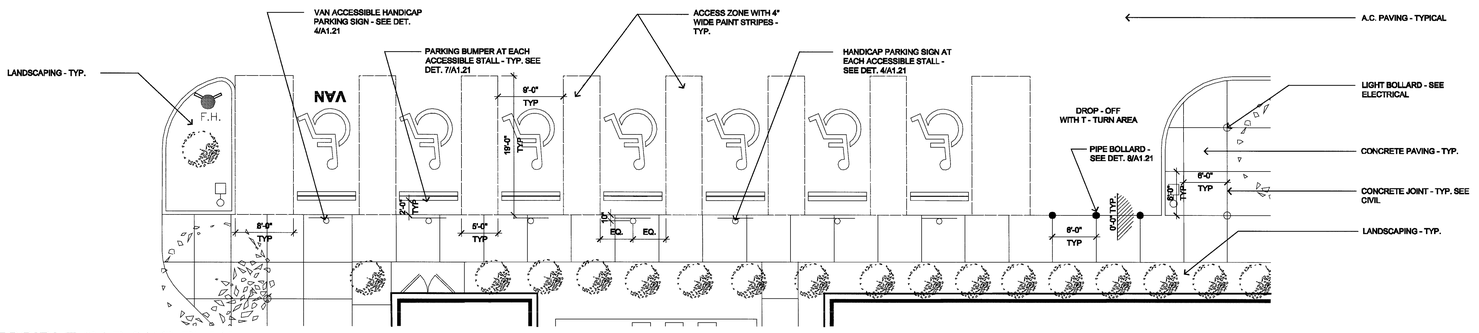

14 ACCESSIBLE PARKING PLAN

1/8"=1'-0"

REVISIONS

CONSULTANT

JMA ARCHITECTURE STUDIOS

2000

10150 COMMERCE CROSS DRIVE

THE DRAWINGS AND SPECIFICATIONS RETAINED BY THE CLIENT MAY BE UTILIZED ONLY FOR OCCUPYING THE PROJECT FOR WHICH THEY WERE PREPARED AND NOT FOR THE CONSTRUCTION OF ANY OTHER PROJECT IN A 0.625 MILE

RECORD DRAWING

This record drawing dated December 29 2005 has been prepared in part based upon information furnished by others

While this information is believed to be reliable JMA Architecture Studios cannot assure its accuracy and thus is not responsible for the accuracy of this record drawing or for any errors or omissions which may have been incorporated into it as a result

Those relying on this record document are advised to obtain independent verification of its accuracy before applying it for any purpose

CITY OF LAS VEGAS

DOWNTOWN SENIOR SERVICES CENTER

NEIGHBORHOOD SERVICES

BID SET

STAMP

OWNER: CITY OF LAS VEGAS
DEPARTMENT OF PUBLIC WORKS
ARCHITECTURAL SERVICES

400 EAST STEWART AVENUE
LAS VEGAS, NEVADA 89101
PHONE: (702) 229-6525
FAX: (702) 382-3232
TDD: (702) 386-9108

DRAWN	B. Bulanov
FILE	
DATE	September 8, 2004
SCALE	See Details
MED NO	04.15341.01
CLV DWG NO	521-287
	Site Details
SHT NO	A1.21

BUILDING 2 and 3

DRAWINGS AS INSTRUMENTS OF SERVICE ARE THE PROPERTY OF THE DESIGN PROFESSIONAL WHOSE STAMP OF CERTIFICATION APPEARS ON THE DRAWINGS AND SPECIFICATIONS ANY USE OR REPRODUCTION IN WHOLE OR IN PART WITHOUT WRITTEN CONSENT IS STRICTLY PROHIBITED COPIES OF THE DRAWINGS AND SPECIFICATIONS RETAINED BY THE CLIENT MAY BE UTILIZED ONLY FOR OCCUPYING THE PROJECT FOR WHICH THEY WERE PREPARED AND NOT FOR THE CONSTRUCTION OF ANY OTHER PROJECT IN A 0.625 MILE