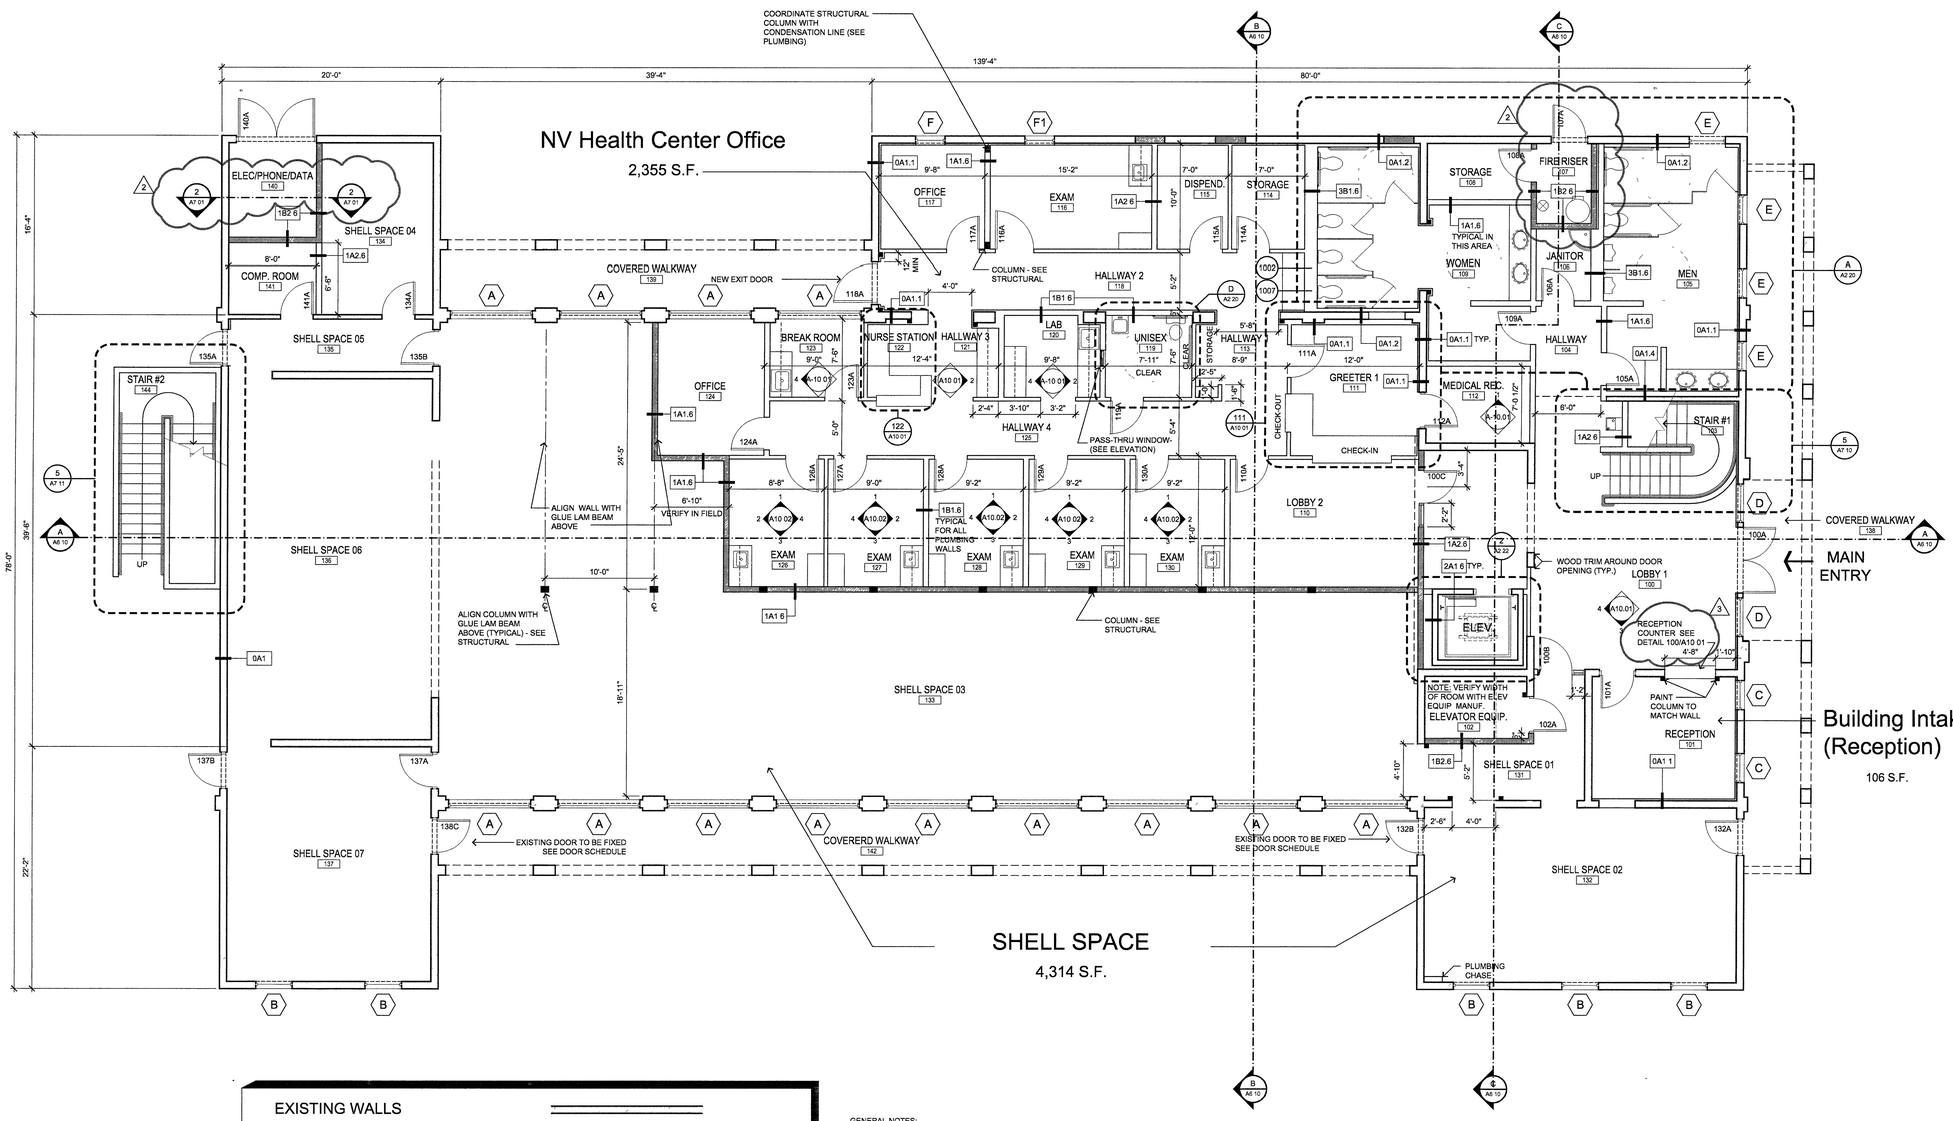

EXISTING WALLS	
DENOTES NEW PROPOSED DEMISING WALL LOCATIONS	1A1 6 UNLESS NOTED ON PLAN
DENOTES NEW PROPOSED WALL LOCATIONS (4" MTL STUDS)	1B1 4 UNLESS NOTED ON PLAN

GENERAL NOTES:

1. ALL EXPANSION / CONTRACTION AND CONTROL JOINTS SHALL BE REPAIRED AT EXISTING INTERIOR SLABS ON GRADE SHELL SPACE NOT IN SCOPE OF WORK

2. ALL STRUCTURAL COLUMNS TO BE PART OF BASE BID

A BUILDING 2 - FIRST FLOOR PLAN

3/16"=1'-0" 86160

REVISIONS
2 6/24/04 Plan Check (Arch.
3 7/14/04 Plan Check (Arch.

CONSULTANT

JMA ARCHITECTURE STUDIOS
10150 COTTONTOP CROSS DRIVE LAS VEGAS, NEVADA 89144 (702)233 2033

CITY OF LAS VEGAS
DOWNTOWN SENIOR SERVICES CENTER
NEIGHBORHOOD SERVICES

BID SET

STAMP

OWNER: CITY OF LAS VEGAS
DEPARTMENT OF PUBLIC WORKS
ARCHITECTURAL SERVICES

400 EAST STEWART AVENUE
LAS VEGAS, NEVADA 89101
PHONE: (702) 229-6535
FAX: (702) 382-3232
TDD: (702) 386-9108

DRAWN	B. Bulanov
FILE	
DATE	September 8, 2004
SCALE	3/16" = 1'-0"
BID NO	04 15341 01
CLV DWG NO	521-287
	First Floor Plan
SHT NO	A2.10

BUILDING 2