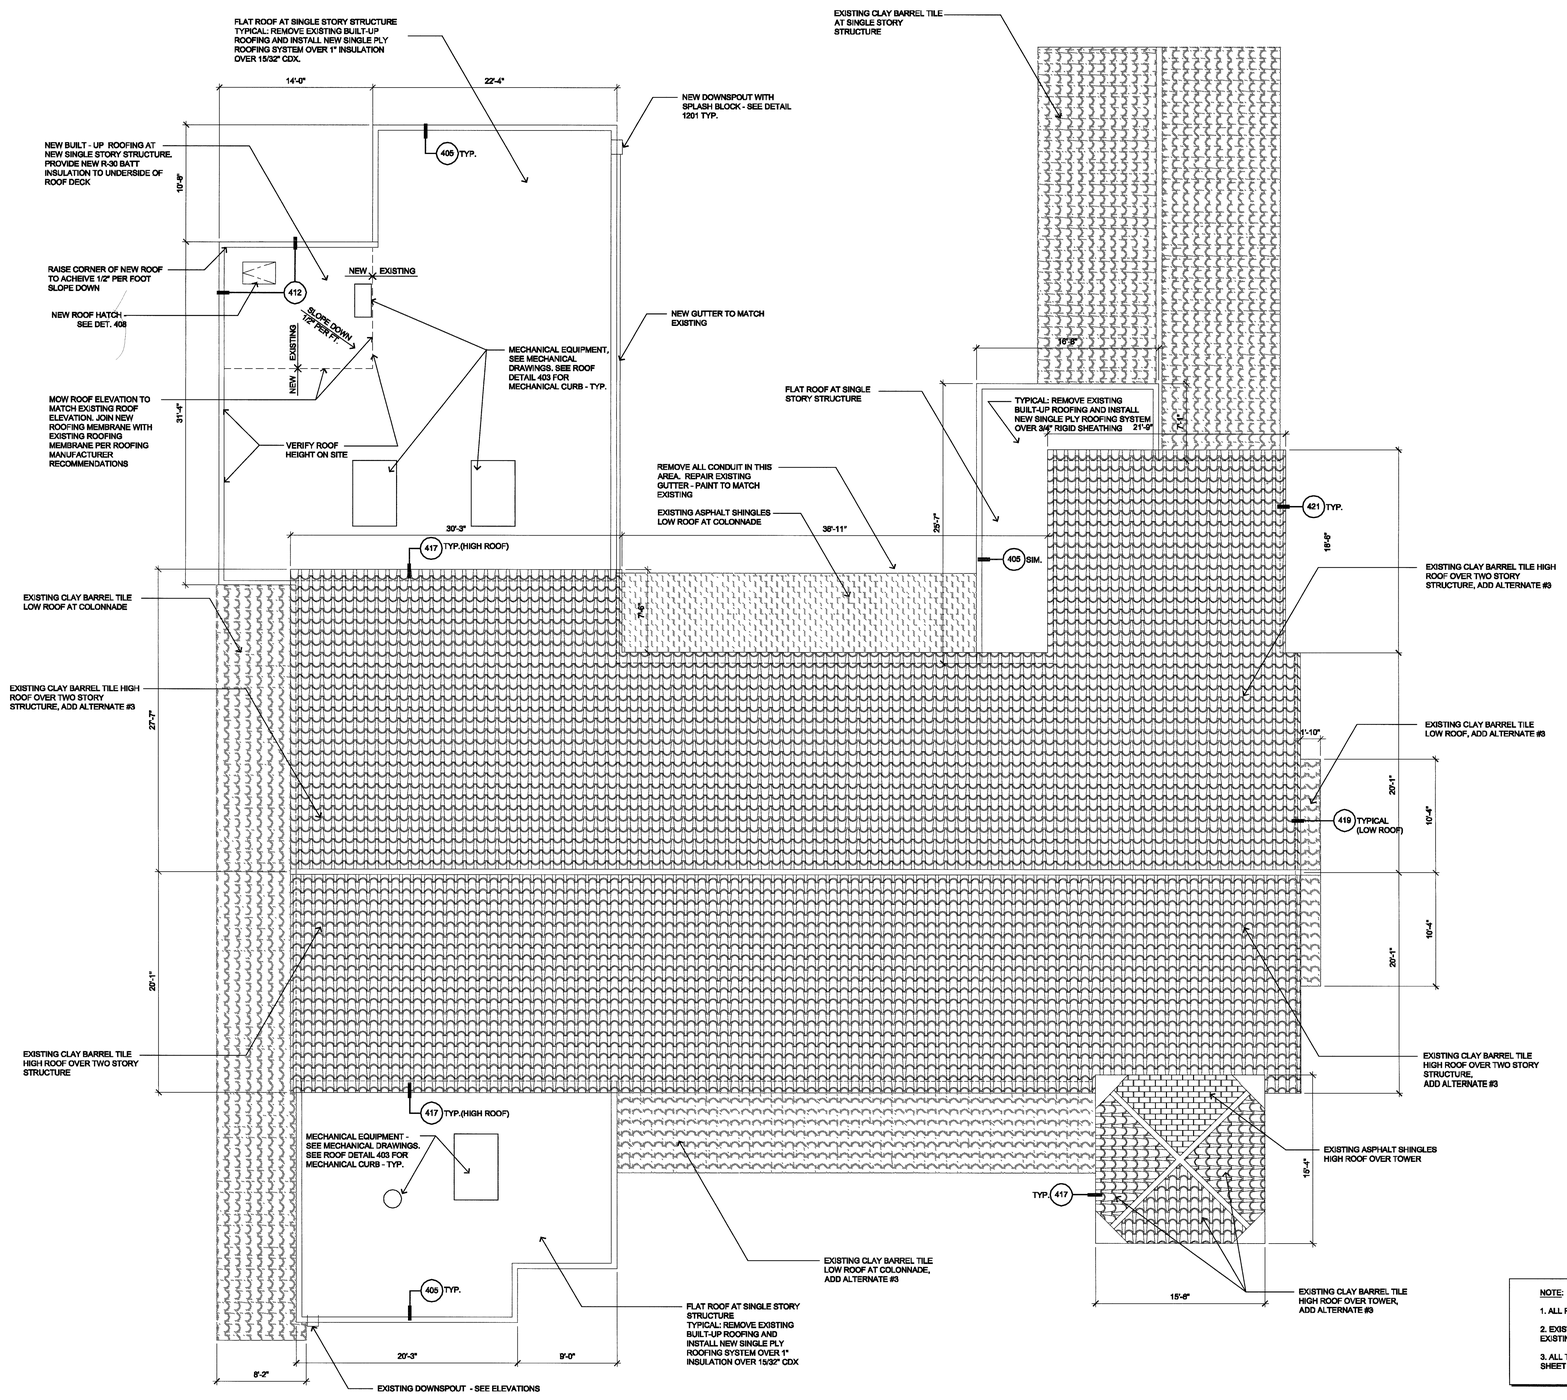

NOTE:

1. ALL ROOF DIMENSIONS TO BE VERIFIED ON FIELD
2. EXISTING SLOPE AT ALL FLAT ROOFS TO DRAIN AT EXISTING DOWN SPOUTS
3. ALL TILE AND ASPHALT ROOFING INDICATED ON THE SHEET IS TO BE BY OTHERS

95878

A BUILDING 3 - ROOF PLAN

3/16"=1'-0"

REVISIONS

CONSULTANT

JMA ARCHITECTURE STUDIOS

10150 COTTONWOOD CROSS DRIVE 2003

RECORD DRAWING

This record drawing, dated December 29 2005 has been prepared in part based upon information furnished by others.

While this information is believed to be reliable JMA Architecture Studios cannot assure its accuracy and thus is not responsible for the accuracy of this record drawing or for any errors or omissions which may have been incorporated into it as a result.

Those relying on this record document are advised to obtain independent verification of its accuracy before applying it for any purpose

CITY OF LAS VEGAS

DOWNTOWN SENIOR SERVICES CENTER

NEIGHBORHOOD SERVICES

BID SET

STAMP

OWNER: CITY OF LAS VEGAS
DEPARTMENT OF PUBLIC WORKS
ARCHITECTURAL SERVICES

400 EAST STEWART AVENUE
LAS VEGAS, NEVADA 89101
PHONE: (702) 229-6539
FAX: (702) 382-3232
TDD: (702) 386-9108

DRAWN	B. Balanov
FILE	
DATE	September 8, 2004
SCALE	3/16" = 1'-0"
BID NO	04.15341.01
CLV DWG NO	521-287
	Roof Plan
SHT NO	A4.20

BUILDING 3

DRAWINGS AS INSTRUMENTS OF SERVICE ARE THE PROPERTY OF THE DESIGN PROFESSIONAL WHOSE STAMP OF CERTIFICATION APPEARS ON THE DRAWINGS AND SPECIFICATIONS RETAINED BY THE CLIENT MAY BE UTILIZED ONLY FOR OCCUPYING THE PROJECT FOR WHICH THEY WERE PREPARED AND NOT FOR THE CONSTRUCTION OF ANY OTHER PROJECT. N A C 623.190
STRICTLY PROHIBITED COPIES OF THE DRAWINGS AND SPECIFICATIONS APPEARS ON THE DESIGN PROFESSIONAL WHOSE STAMP OF CERTIFICATION APPEARS ON THE DRAWINGS AND SPECIFICATIONS ANY USE OR REPRODUCTION, IN WHOLE OR IN PART WITHOUT WRITTEN CONSENT IS STRICTLY PROHIBITED.