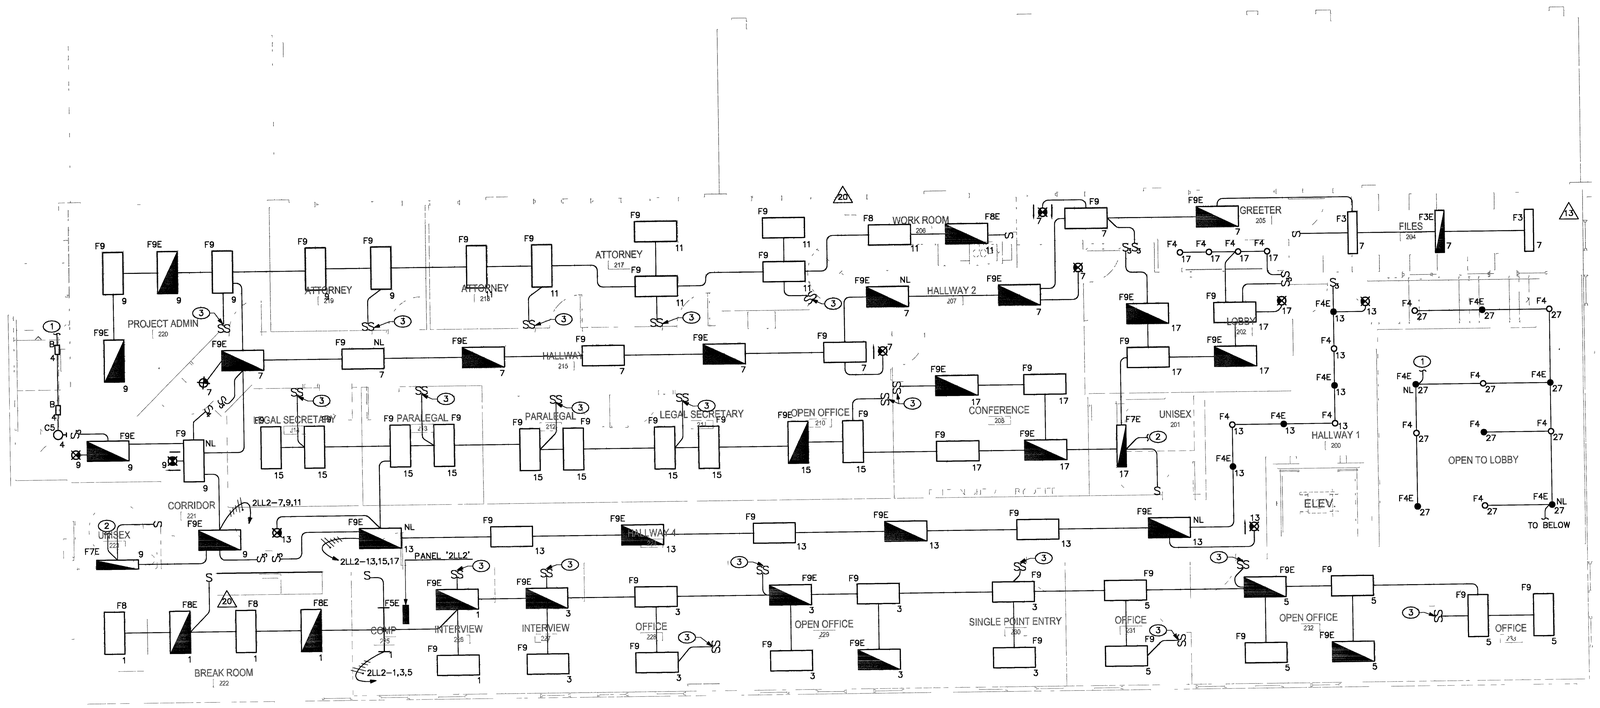

LIGHTING PLAN FLOOR 2 BUILDING II

SCALE: 3/16"=1'-0"

GENERAL NOTES

1. SEE POWER PLANS FOR LOCATIONS OF PANELBOARDS.
2. SEE ARCHITECTURAL DRAWINGS FOR ADDITIONAL INFORMATION AND EXACT FIXTURE LOCATIONS.
3. COORDINATE LOCATIONS OF REQUIRED LIGHTING TRANSFORMERS WITH ARCHITECT PRIOR TO ROUGH-IN. PROVIDE ACCESS PANEL OR CONNECTION ABOVE ACCESSIBLE CEILING AND OVERCURRENT PROTECTION PER NEC REQUIREMENTS IF NOT INTEGRAL WITH FIXTURE.
4. VERIFY EGRESS PATHS WITH FINAL ARCHITECTURAL EXITING PLANS. PROVIDE ANY ADDITIONAL EXIT SIGNS REQUIRED BY THE AUTHORITY HAVING JURISDICTION FOR APPROVAL. RECORD LOCATION OF ANY ADDITIONAL EXIT SIGNS ON RECORD DRAWINGS.
5. PROVIDE AN UNSWITCHED CONDUCTOR TO ALL EXIT SIGNS AND EMERGENCY LIGHTING FIXTURES.
6. ALL 20A, 120V BRANCH CIRCUITS IN EXCESS OF 75 FT SHALL HAVE #10 AWG CONDUCTORS AND CONDUIT UPSIZED ACCORDINGLY.
7. MULTIPLE SWITCHES LOCATED IN ONE LOCATION SHALL BE MOUNTED UNDER COMMON GANGED FACEPLATE. MULTIPLE SINGLE GANG FACEPLATES ARE NOT ACCEPTABLE.

SHEET NOTES

(1) REFER TO LIGHTING PLAN ON SHEET E2.01 FOR CONTINUATION OF CIRCUIT.

(2) REFER TO POWER PLAN ON SHEET E3.02 FOR CONTINUATION OF CIRCUIT.

(3) PROVIDE DUAL-LEVEL SWITCHING.

RECORD DRAWINGS
Date- 01/25/06 This record drawing has been prepared in part, based upon information furnished by others. While this information is believed to be reliable, Harris Consulting Engineers LLC cannot assure it's accuracy, and is not responsible for the accuracy of this record drawing or for any errors or omissions which may have been incorporated into it as a result. Those relying on this record drawing are advised to obtain independent verification of it's accuracy before applying it for any purpose.

CONSULTING ENGINEERS
D. HARRIS LLC
770 Pilot Road, Suite L Las Vegas, Nevada 89119
Tel 702/269-1575 Fax 702/269-1574

PROJECT NO: 23154.30
DESIGNED BY: S. PAY
CHECKED BY: P. WHISENHUNT
DRAWN BY: R. PUERNER
PM: G. GOINS

9508

REVISIONS
13 4-22-05 GENERAL
20 01-25-06 RECORD DRAWING

CONSULTANT

JMA ARCHITECTURE STUDIOS
10150 COVINGTON CROSS DRIVE LAS VEGAS, NEVADA 89144 (702)233-2033

CITY OF LAS VEGAS
DOWNTOWN SENIOR SERVICES CENTER
NEIGHBORHOOD SERVICES

RECORD SET

STAMP

OWNER: CITY OF LAS VEGAS
DEPARTMENT OF PUBLIC WORKS
ARCHITECTURAL SERVICES

400 EAST STEWART AVENUE
LAS VEGAS, NEVADA 89101
PHONE (702) 229-6535
FAX (702) 382-3232
TDD (702) 386-9108

DRAWN	R. PUERNER
FILE	E2.01.DWG
DATE	September 8, 2004
SCALE	3/16" = 1'-0"
BID NO	04.B.34.U01
CLV DWG NO	B21-281
SHT NO	LIGHTING PLAN FLOOR 2

BUILDING

E2.02

DRAWINGS AS INSTRUMENTS OF SERVICE ARE THE PROPERTY OF THE DESIGN PROFESSIONAL WHOSE STAMP OF CERTIFICATION APPEARS ON THE DRAWINGS AND SPECIFICATIONS. ANY USE OR REPRODUCTION IN WHOLE OR IN PART WITHOUT WRITTEN CONSENT IS STRICTLY PROHIBITED COPIES OF THE DRAWINGS AND SPECIFICATIONS RETAINED BY THE CLIENT MAY BE UTILIZED ONLY FOR ACQUIRING THE PRODUCT FOR WHICH THEY WERE PREPARED AND NOT FOR THE CONSTRUCTION OF ANY OTHER PRODUCT © A.E.S. 833-700