


DATE: _____ BY: _____
 ORIGINAL SURVEY PLANNED PORTED NOTE BOOK AREAS CHECKED

DATE: _____ BY: _____
 ORIGINAL SURVEY PLANNED PORTED NOTE BOOK AREAS CHECKED

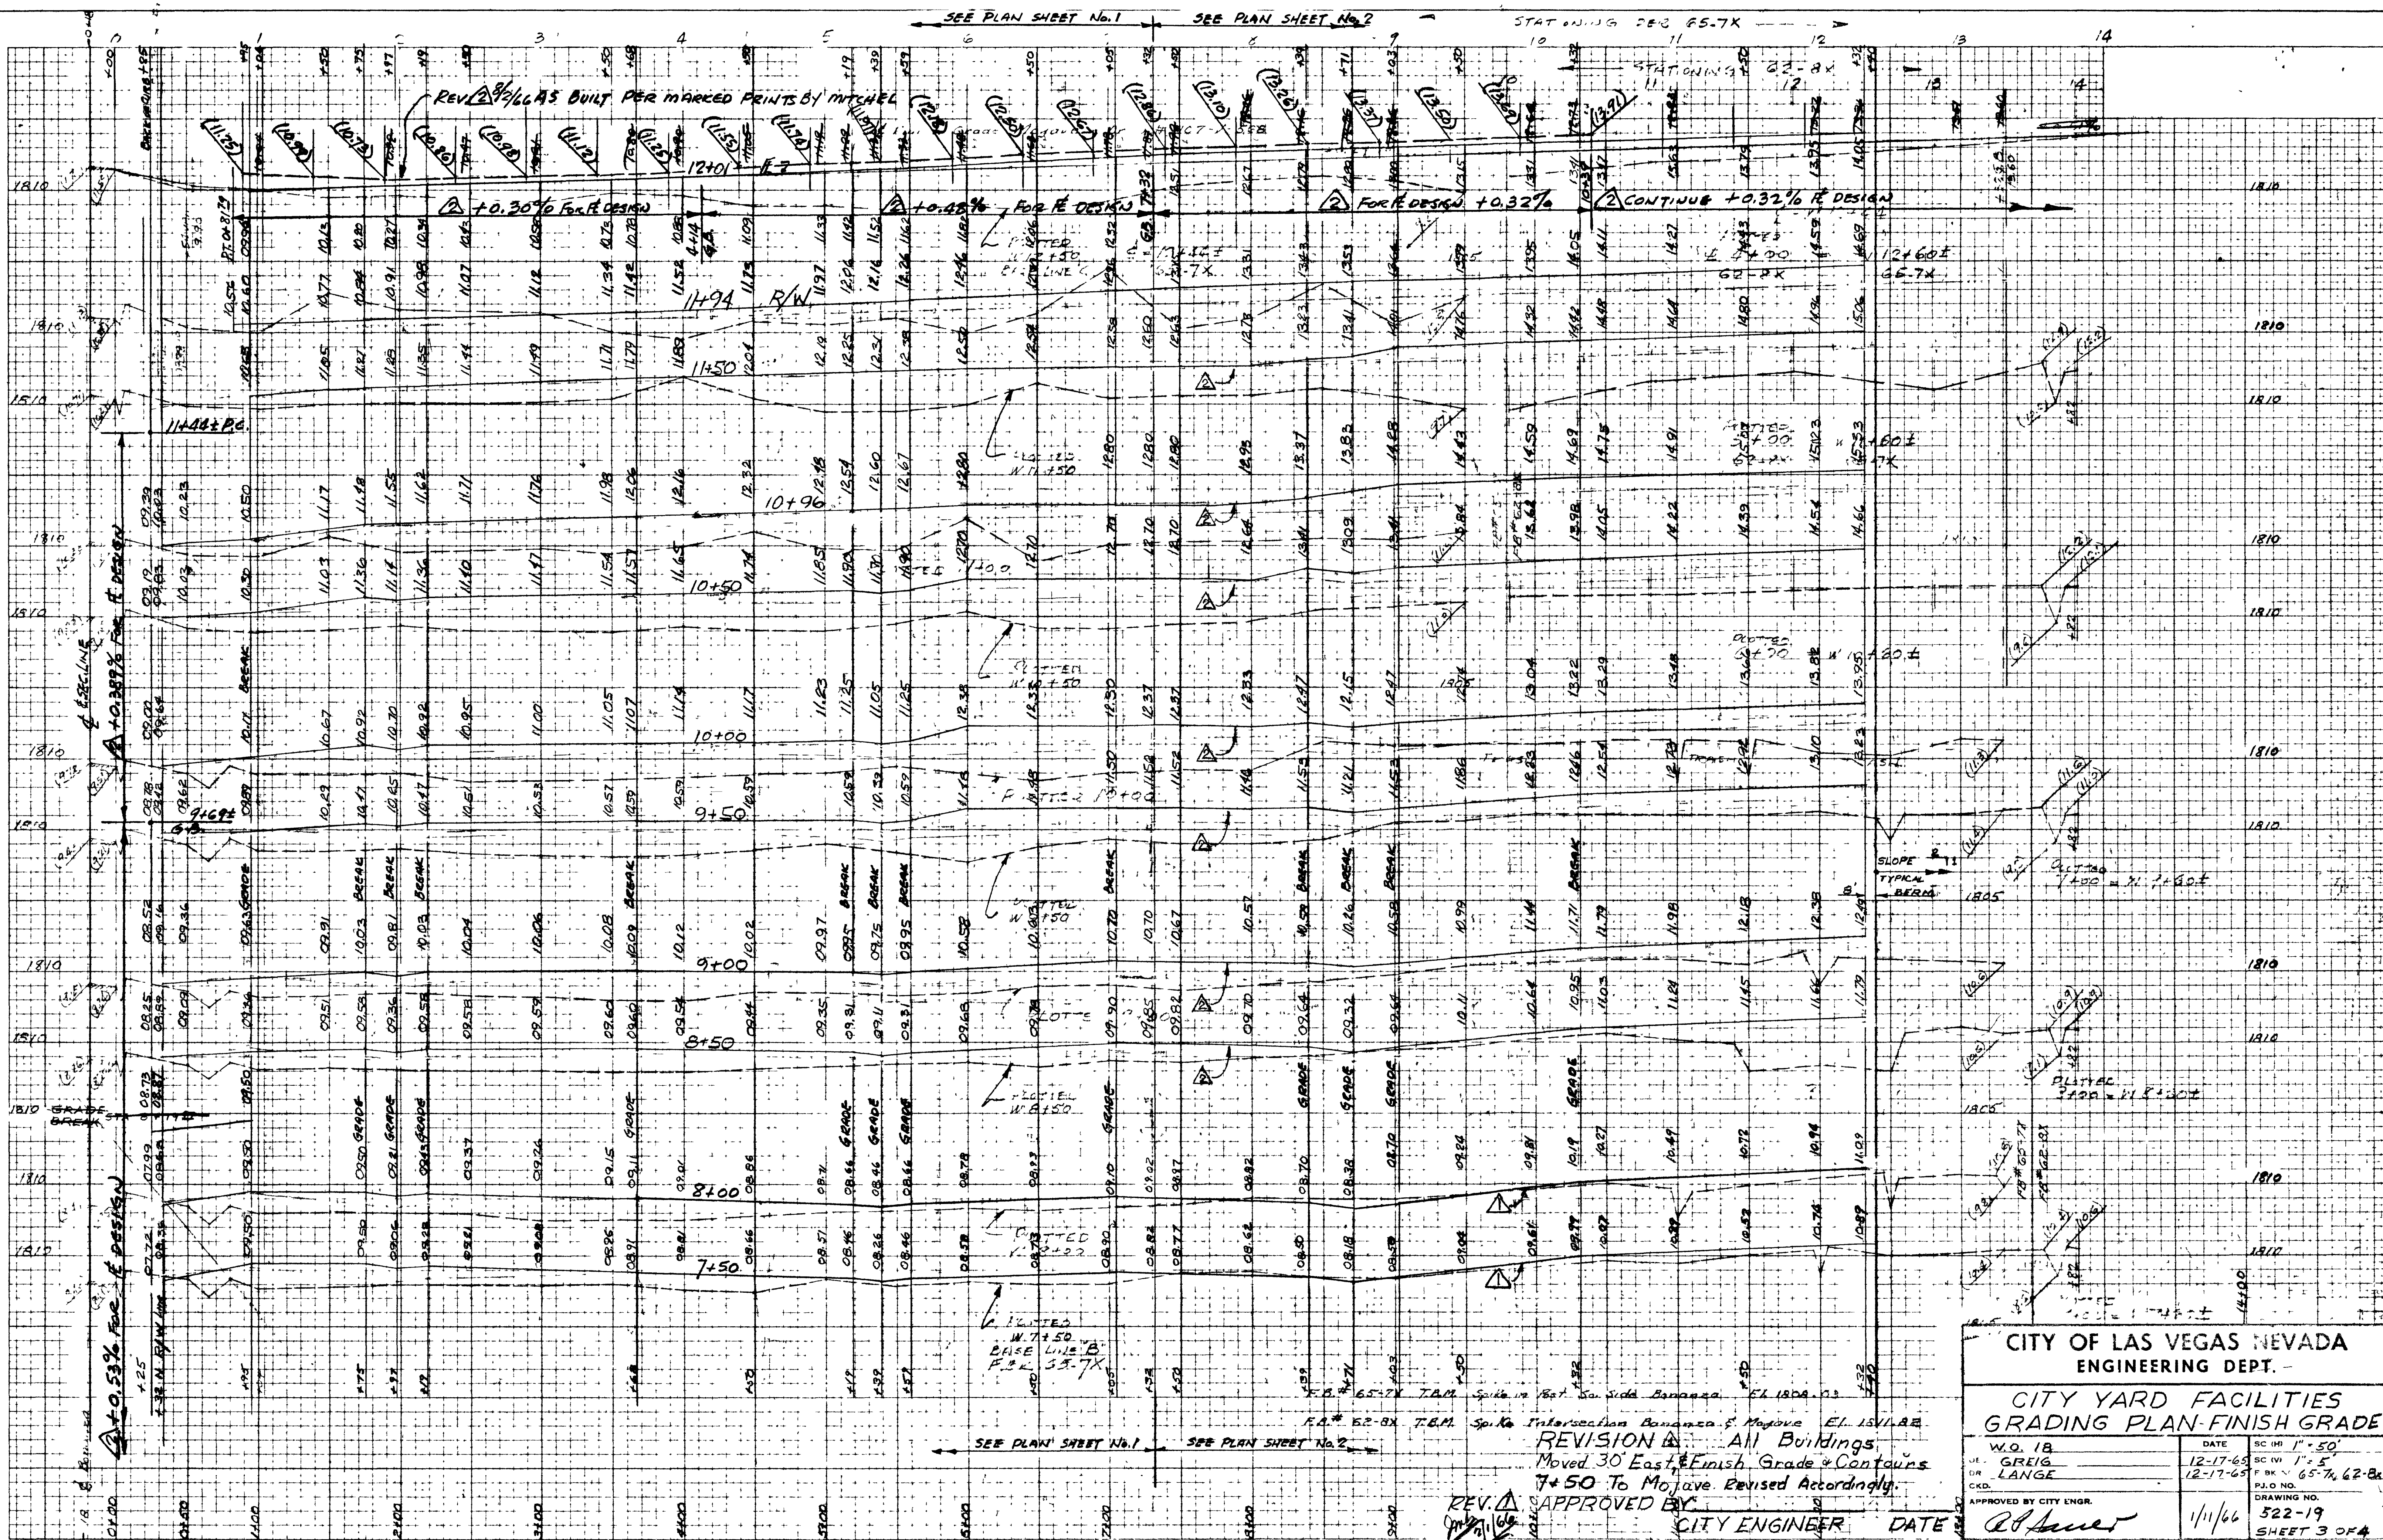

SEE PLAN SHEET No. 1 SEE PLAN SHEET No. 2 STATIONING 65-7X

SEE PLAN SHEET No. 1 SEE PLAN SHEET No. 2


CITY OF LAS VEGAS NEVADA
 ENGINEERING DEPT.
 CITY YARD FACILITIES
 GRADING PLAN-FINISH GRADE

W.D. 18	DATE	SC 1/1"=50'
JR. GREIG	12-17-65	SC 1/1"=5'
DR. LANGE	12-17-65	P.J. NO. 65-7X, 62-Bx
C.D.		DRAWING NO. 522-19
APPROVED BY: [Signature]	DATE: 1/11/66	SHEET 3 OF 4

PLATE 3-CROSS SECTION OF R.A.R. STANDARD THE "FREDERICK POST" CO. CHICAGO

SCALE 1/4"=1'-0" CITY YARDS

9434

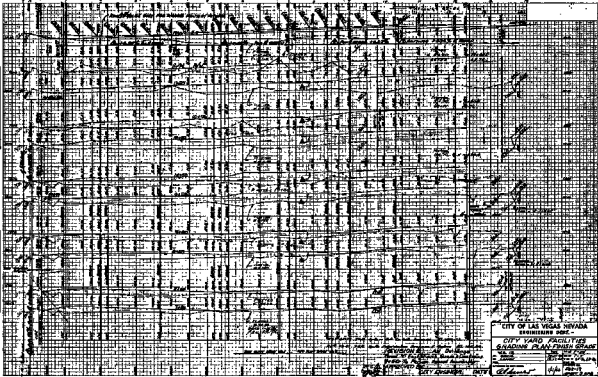

CITY OF LAS VEGAS NEVADA
ENGINEERING DEPT.

CITY YARD FACILITIES
SHADING PLAN-FINISH GRADE







