


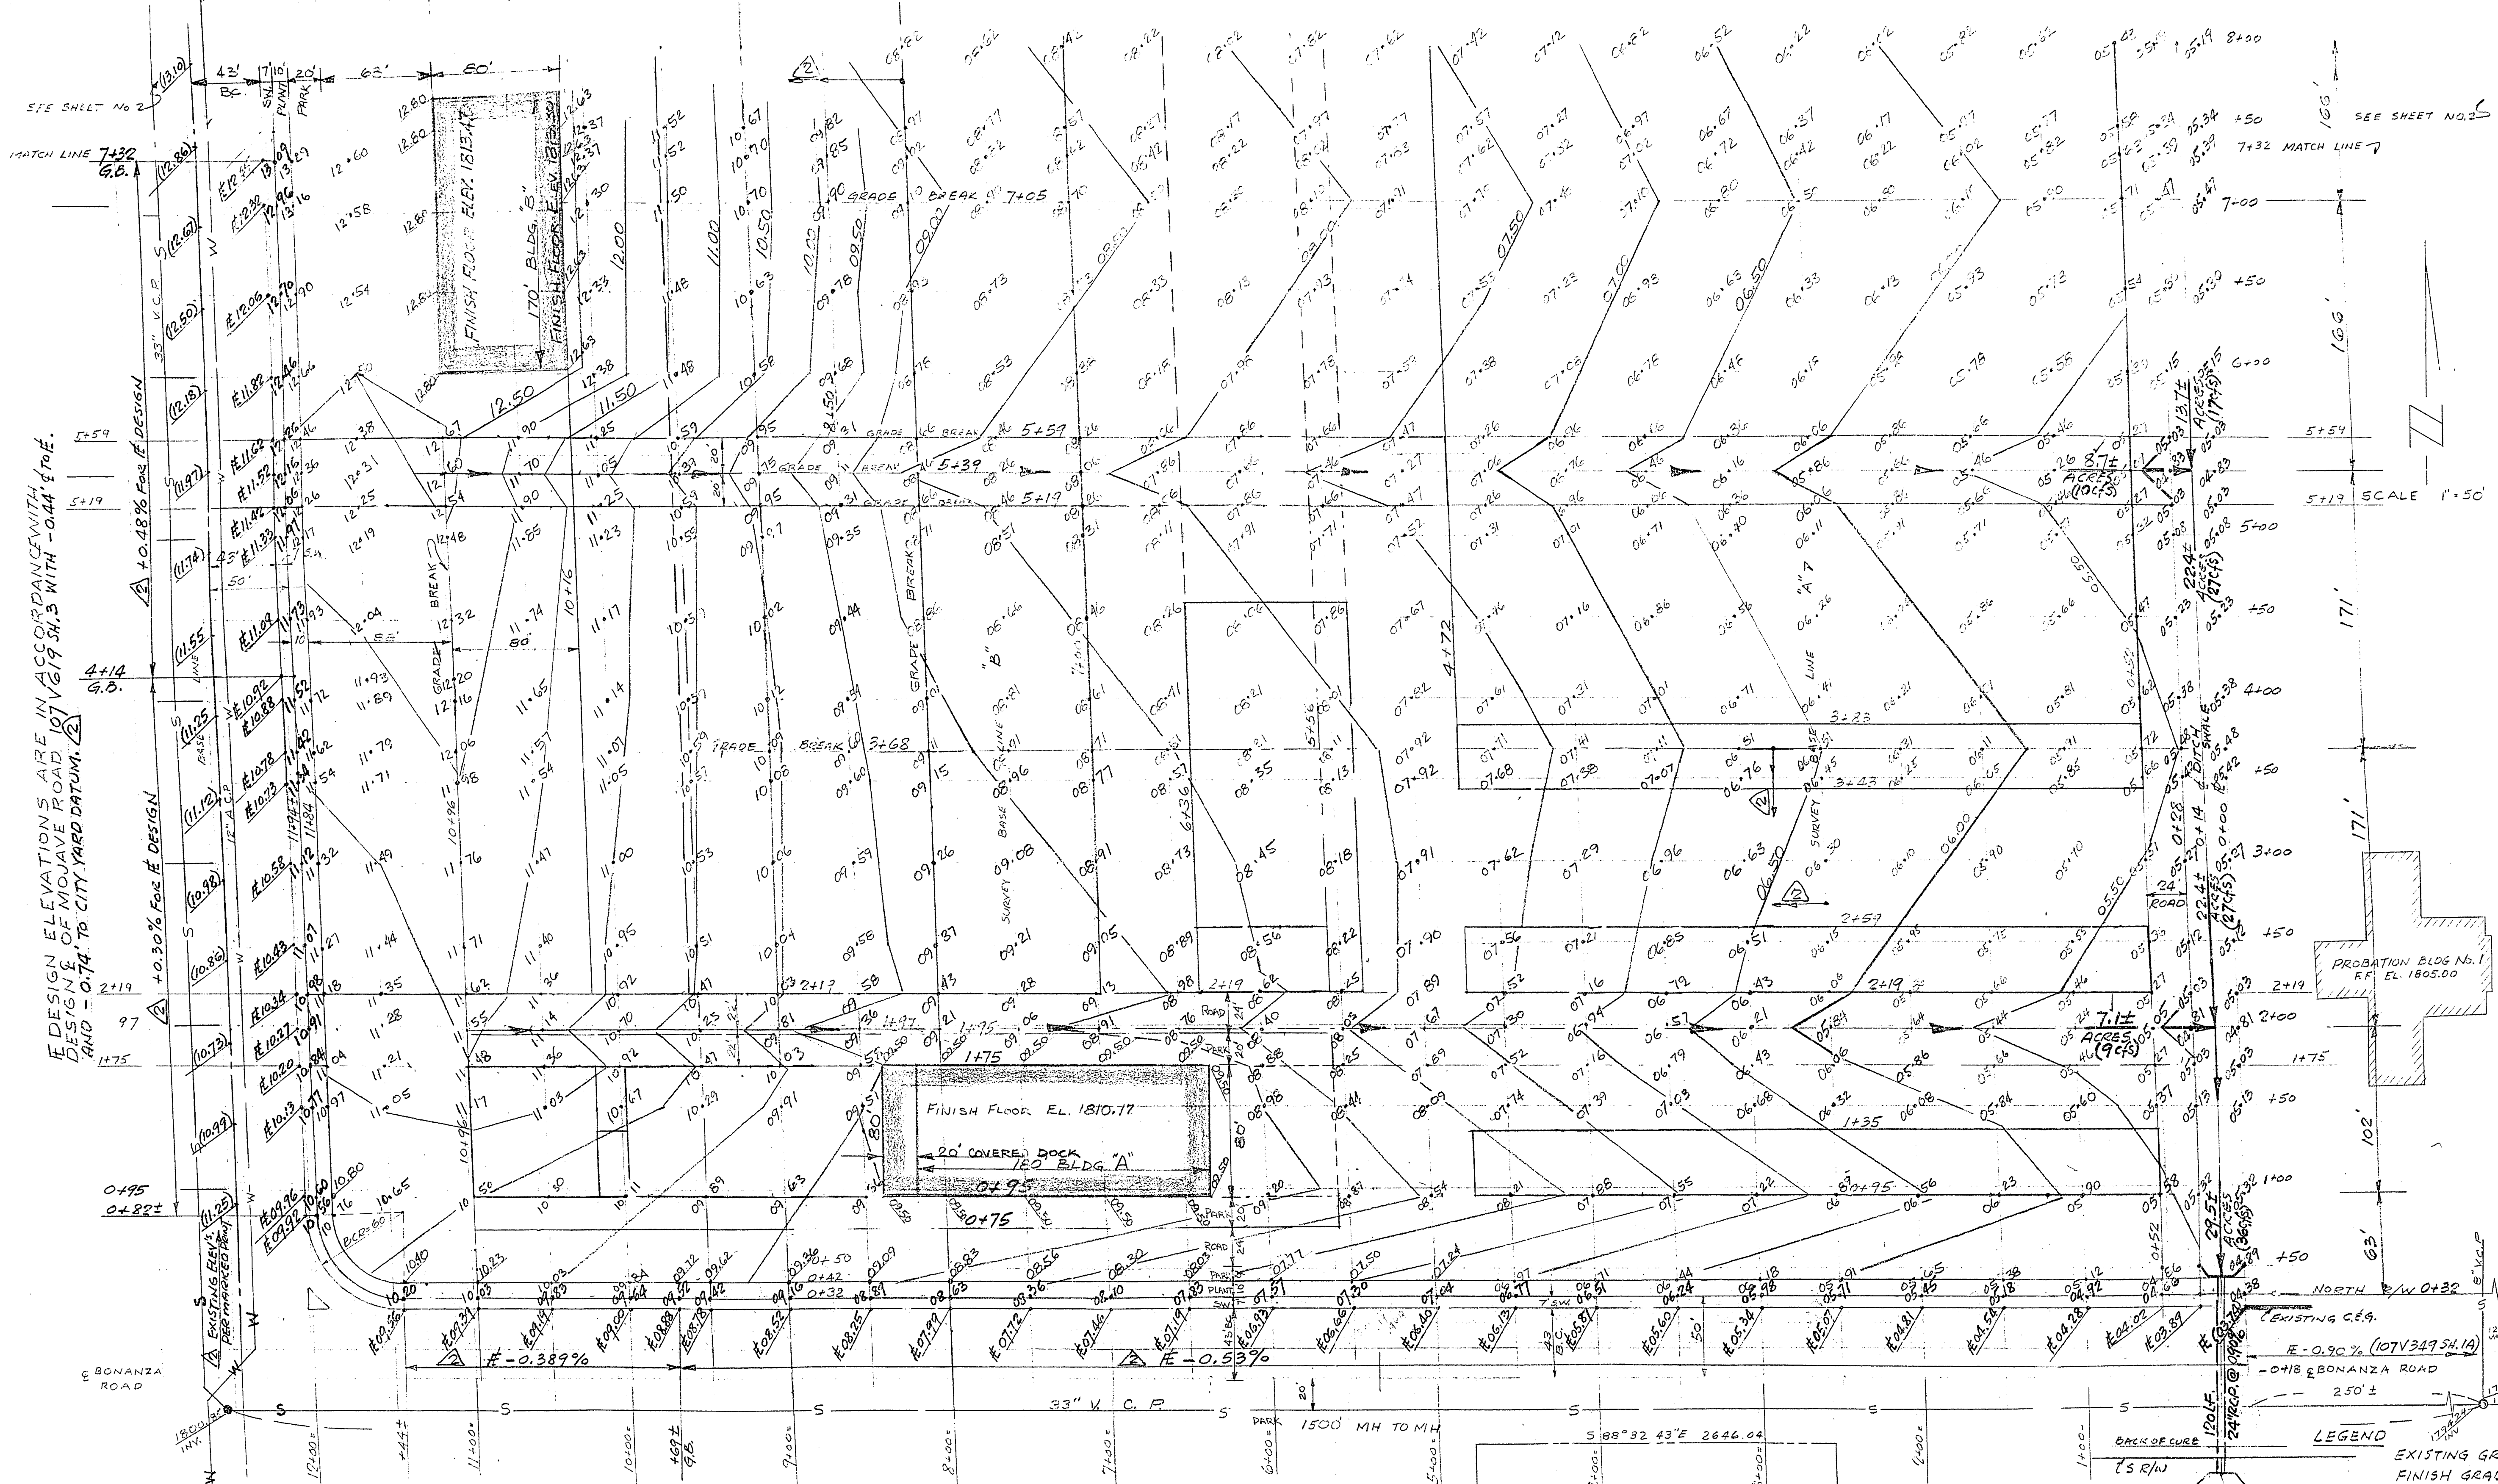


DESIGN ELEVATIONS ARE IN ACCORDANCE WITH
DESIGN OF MOJAVE ROAD 107V349B WITH -0.44% TO E.
AND -0.74% TO CITY YARD DATUM.

DESIGN ELEVATIONS ARE IN ACCORDANCE WITH
DESIGN OF BONANZA ROAD 107V349B -0.74% TO
CITY YARD DATUM.

REVISION
NEW CLV. B.M. USED AND
REDESIGNED ELEVATIONS
FROM 8+00 WEST TO MOJAVE, &
FROM 3+68 SOUTH TO BONANZA AND
WEST OF 2+50.

APPROVED BY CITY ENGINEER DATE

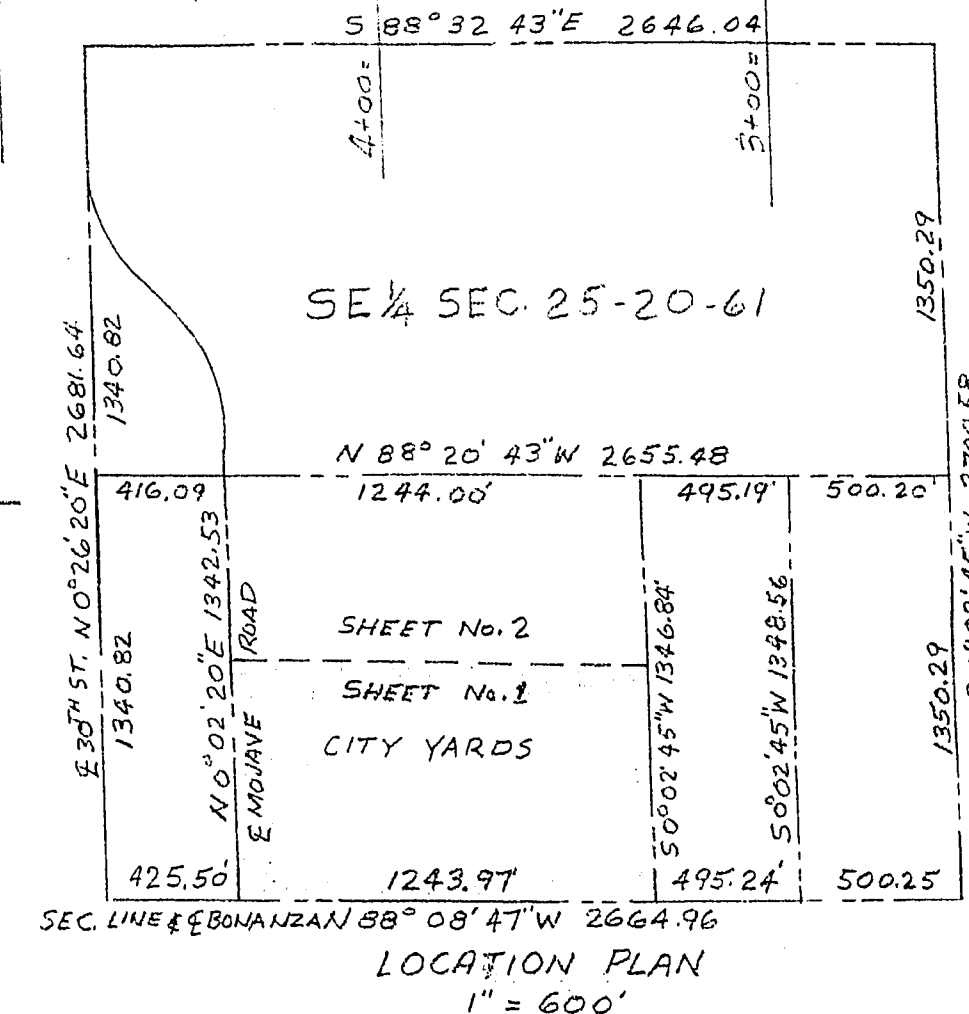

REFERENCE DRAWINGS
PROPOSED CITY YARD FACILITIES 522V18
STREET DESIGN - BONANZA ROAD 107V349B
" " - MOJAVE ROAD 107V619
" " - JUVENILE CENTER 107V349
CROSS SECTIONS SEE SHEETS 3 & 4
PROPOSED CITY YARD FACILITIES 522V18A

CITY YARD B.M. ELEV. 1812.49

LEGEND
EXISTING GROUND CONTOURS (07.0)
FINISH GRADE (07.00)
EXISTING ELEVATIONS (07.00)
DESIGN - FINISH GRADE ELEV. (07.00)
ALL BUILDINGS MOVED 30'
REVISION FINISH GRADE & CONTOURS 5+50 TO MOJAVE
APPROVED BY CITY ENGINEER DATE

CITY OF LAS VEGAS, NEVADA
ENGINEERING DEPT.
CITY YARD FACILITIES
GRADING PLAN - FINISH GRADE
W.O. 689
1/1/66 522-19
SHEET 1 OF 4
SHEET 1 OF 4