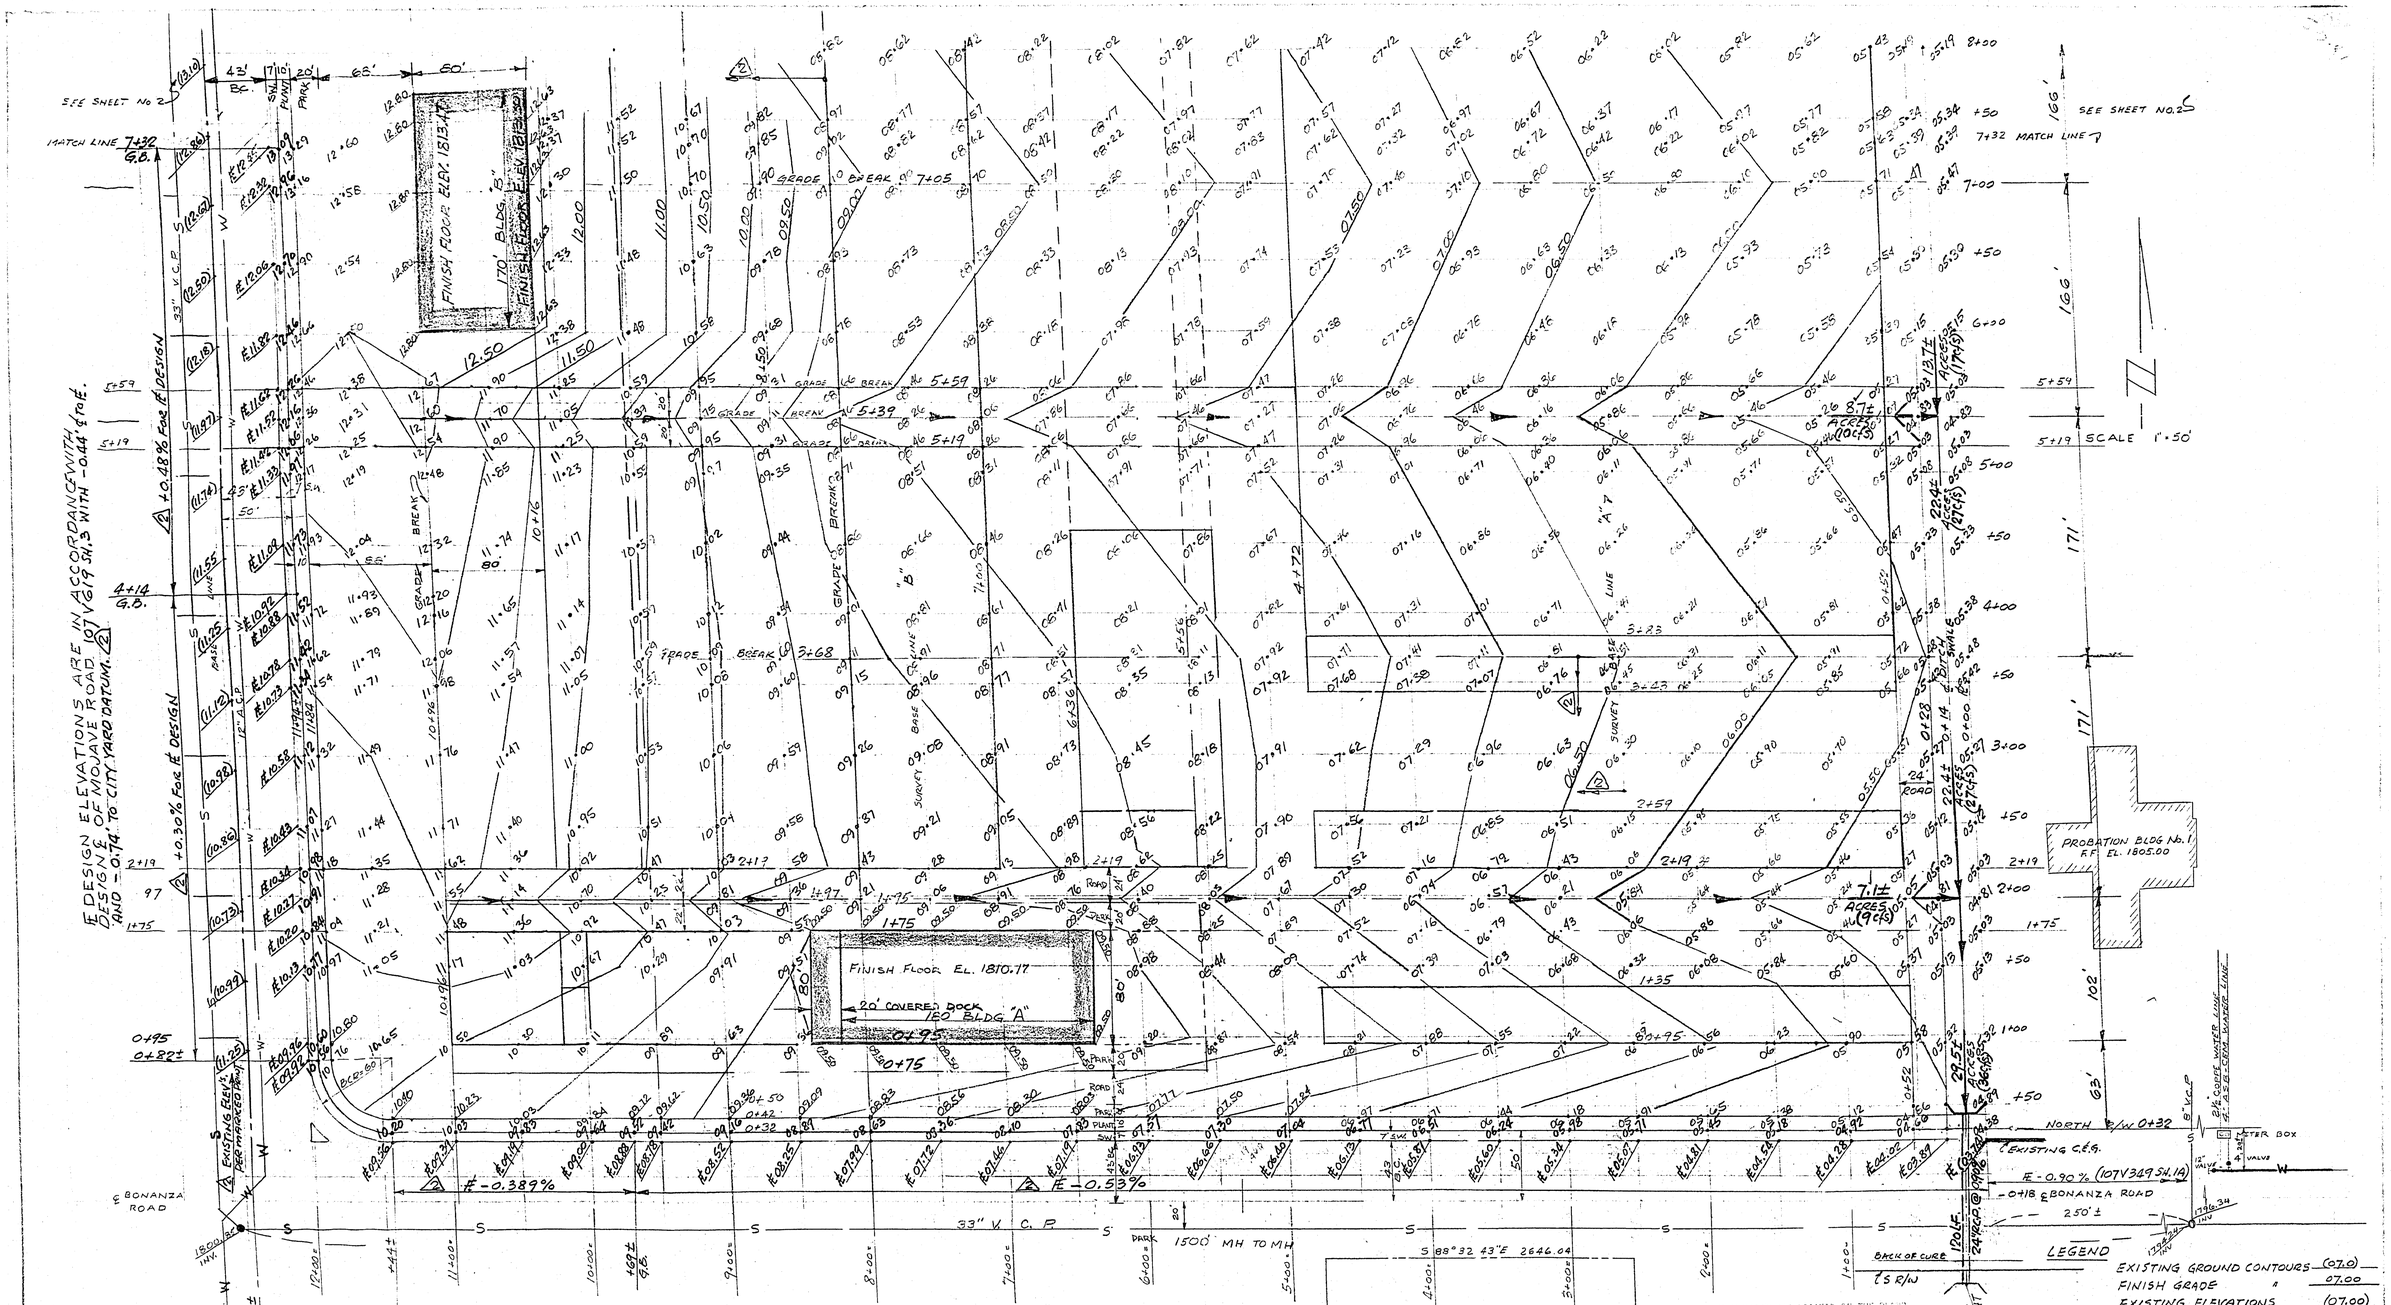

℄ DESIGN ELEVATIONS ARE IN ACCORDANCE WITH DESIGN OF BONANZA ROAD 107V349B - 0.74' TO CITY YARD DATUM. 2

℄ DESIGN ELEVATIONS ARE IN ACCORDANCE WITH DESIGN OF MOJAVE ROAD 107V619 SH. 3 WITH -0.44' TO CITY YARD DATUM. 2

WE 8/10/66 REVISION 2 — NEW C.L.V. B.M. USED AND REDESIGNED ELEVATIONS FROM 8+00 WEST TO MOJAVE & FROM 3+68 SOUTH TO BONANZA AND WEST OF 2+50.

APPROVED BY _____ CITY ENGINEER _____ DATE

EXISTING BUILDINGS ARE LOCATED ON THE PLANS FOR THE CONVENIENCE OF THE CONTRACTOR WHO MAY USE THEM AS HE SEES FIT.

REFERENCE DRAWINGS

PROPOSED CITY YARD FACILITIES 522V18

2 STREET DESIGN - BONANZA ROAD 107V349B

2 " " - MOJAVE ROAD 107V619

" " - JUVENILE CENTER 107V349

CROSS SECTIONS SEE SHEETS #3 & #4

PROPOSED CITY YARD FACILITIES 522V16A

2 CITY YARD B.M. ELEV. 1812.49

2/1/66 REVISION 2 FINISH GRADE + CONTOURS 5+50 TO MOJAVE

APPROVED BY _____ CITY ENGINEER _____ DATE

2 ~~T.B.M. SPIKE IN POST SOUTH SIDE BONANZA ELEV. 1808.08~~

CITY OF LAS VEGAS NEVADA
ENGINEERING DEPT.

CITY YARD FACILITIES
GRADING PLAN - FINISH GRADE

W.O. 689	DATE	SCALE 1" = 50'
DR. G.E.G.		CONTOURS AT 0.5'
CK. LANGE		
CHIEF ENGR.		
PROJECT ENGR.		PROJECT NO.
PROJECT BY CITY ENGR. R P Lanes	1/1/66	522-19
		SHEET 1 OF 4

SHEET 1 OF 4