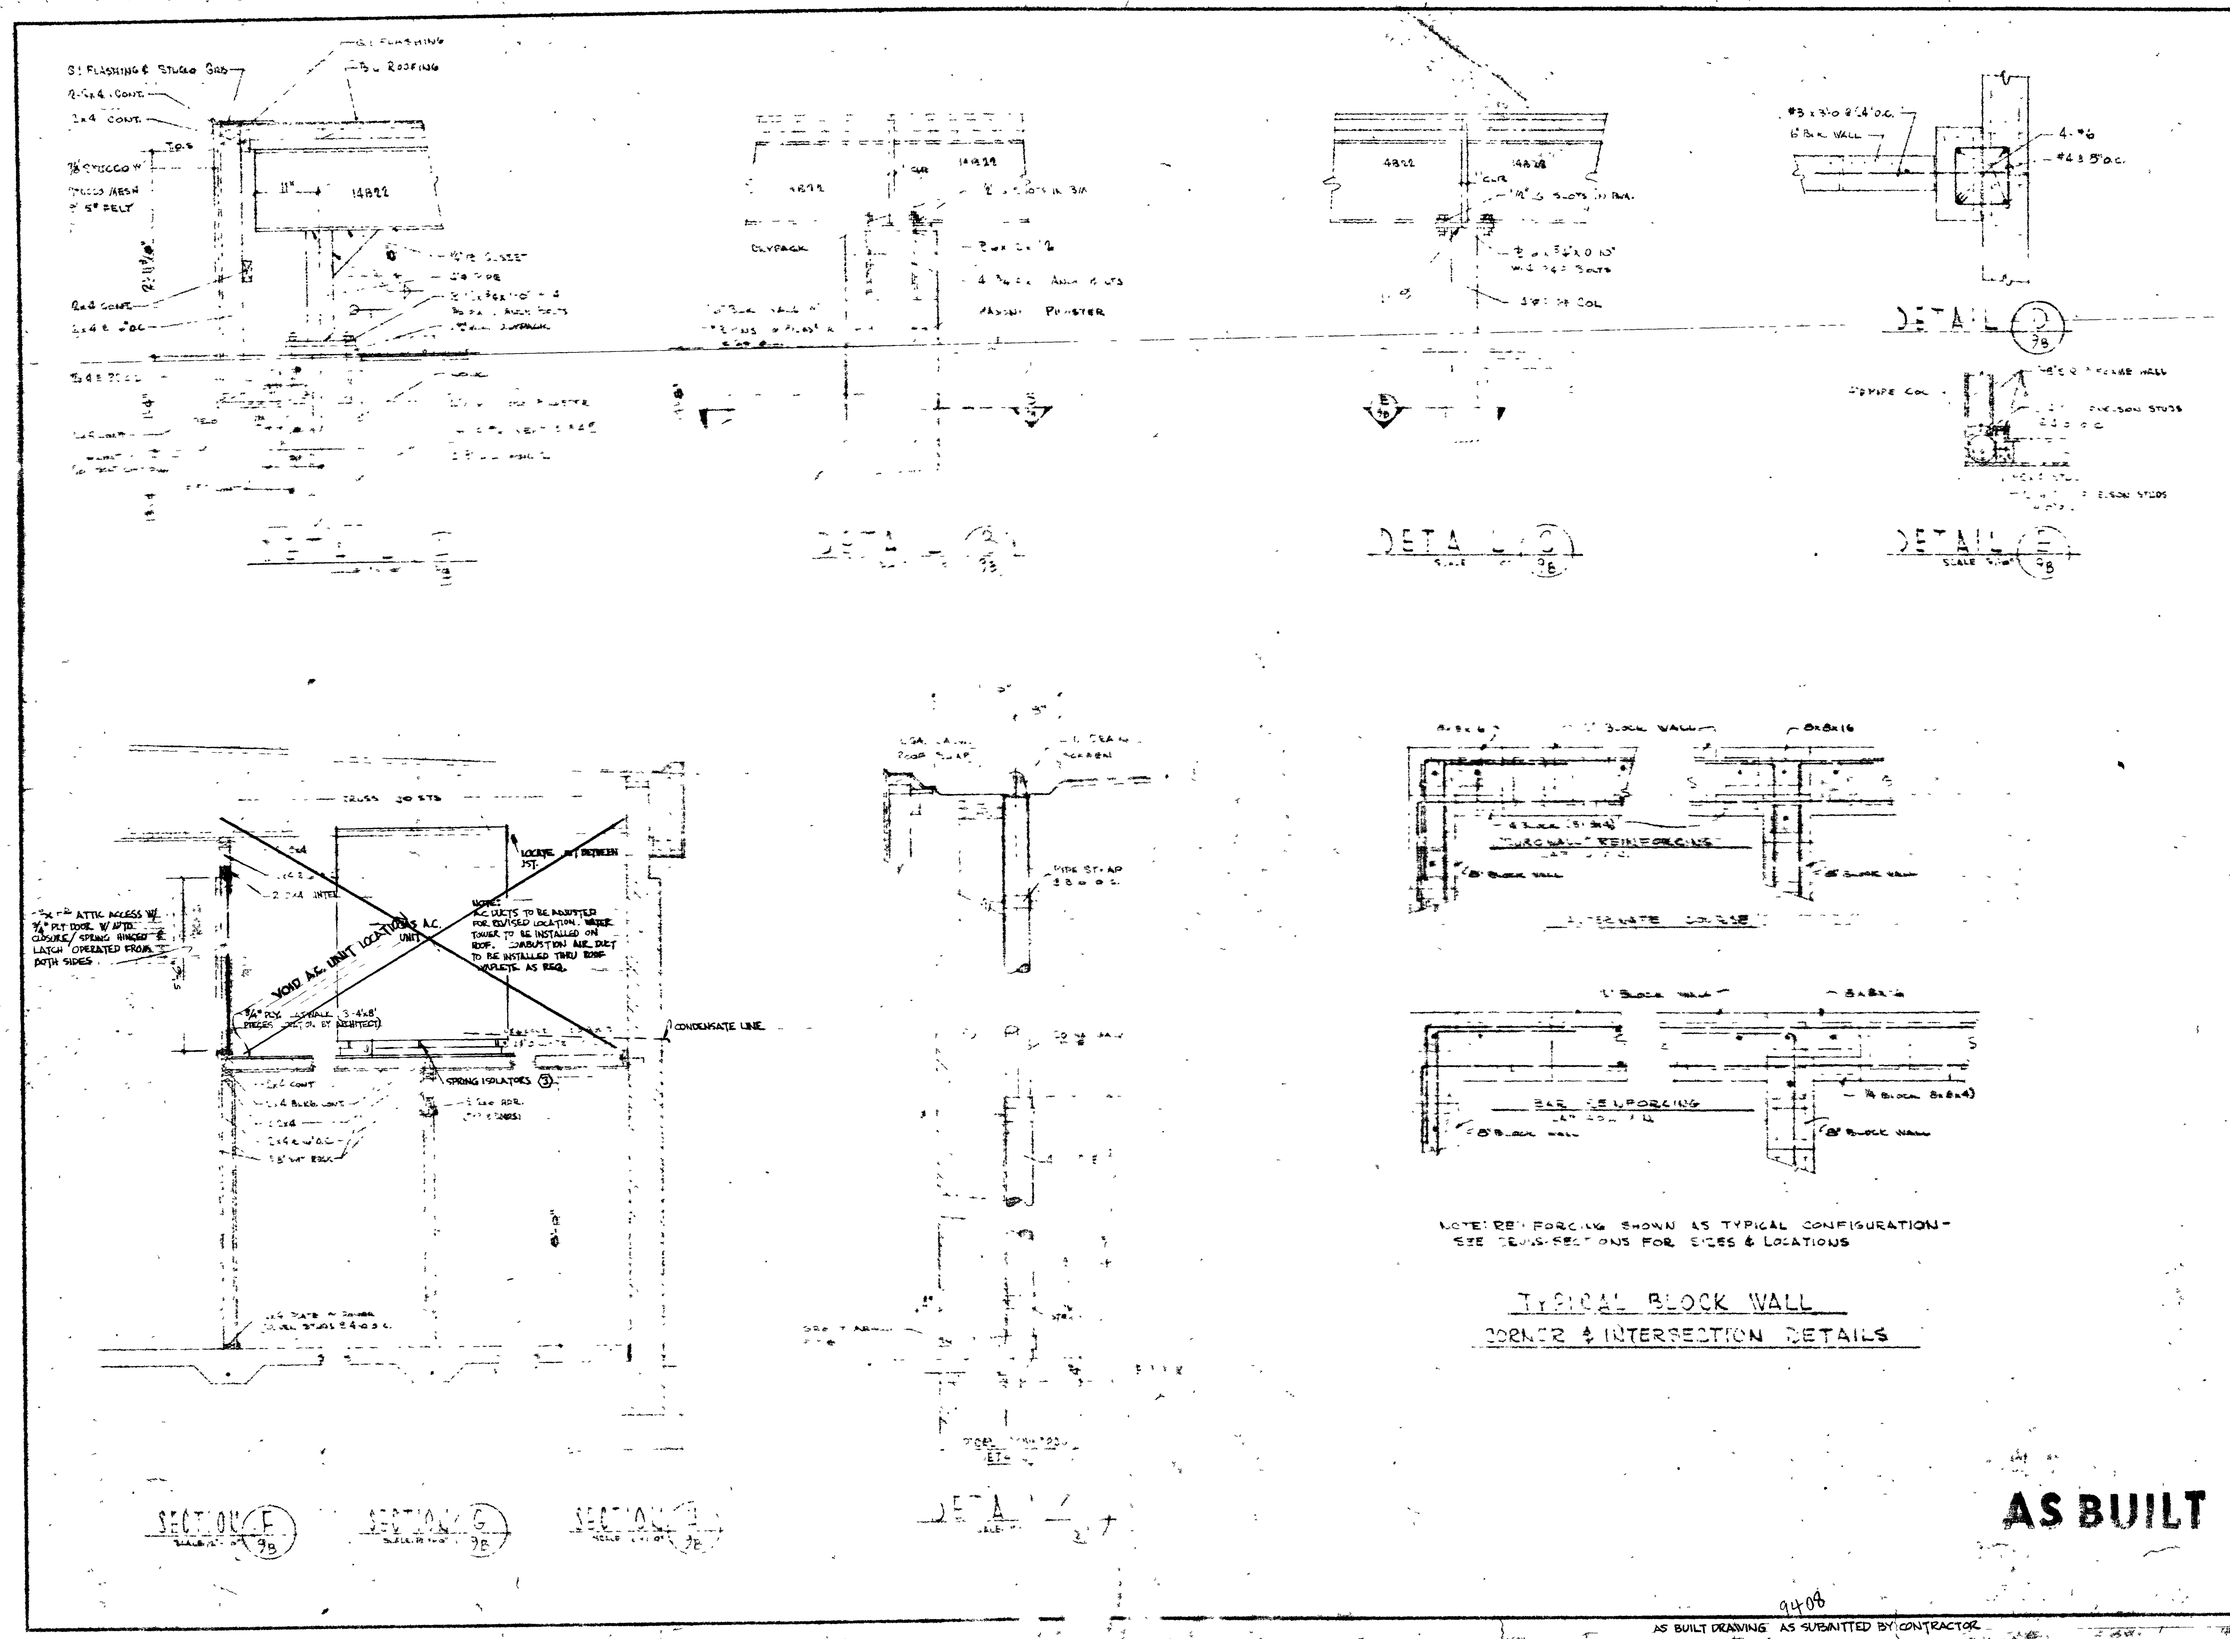

REVISIONS

1
2 REVISED DETAIL 9B RELOCATING A.C. UNIT 12-16-66
3 SPRING ISOLATORS - SHIT TURNED 12-23-66
4
5
6
7
8

DATE 3 3 66

DRAWN BY ALD

CHECKED BY

J. K. T. Belcher A.I.A.
LAS VEGAS, NEVADA

FOR THE CITY OF LAS VEGAS, NEVADA

SHEET TITLE DETAILS

JOB TITLE CITY YARD FACILITIES

JOB 6310

SHEET 9B

OF

9408

AS BUILT DRAWING AS SUBMITTED BY CONTRACTOR

522-29

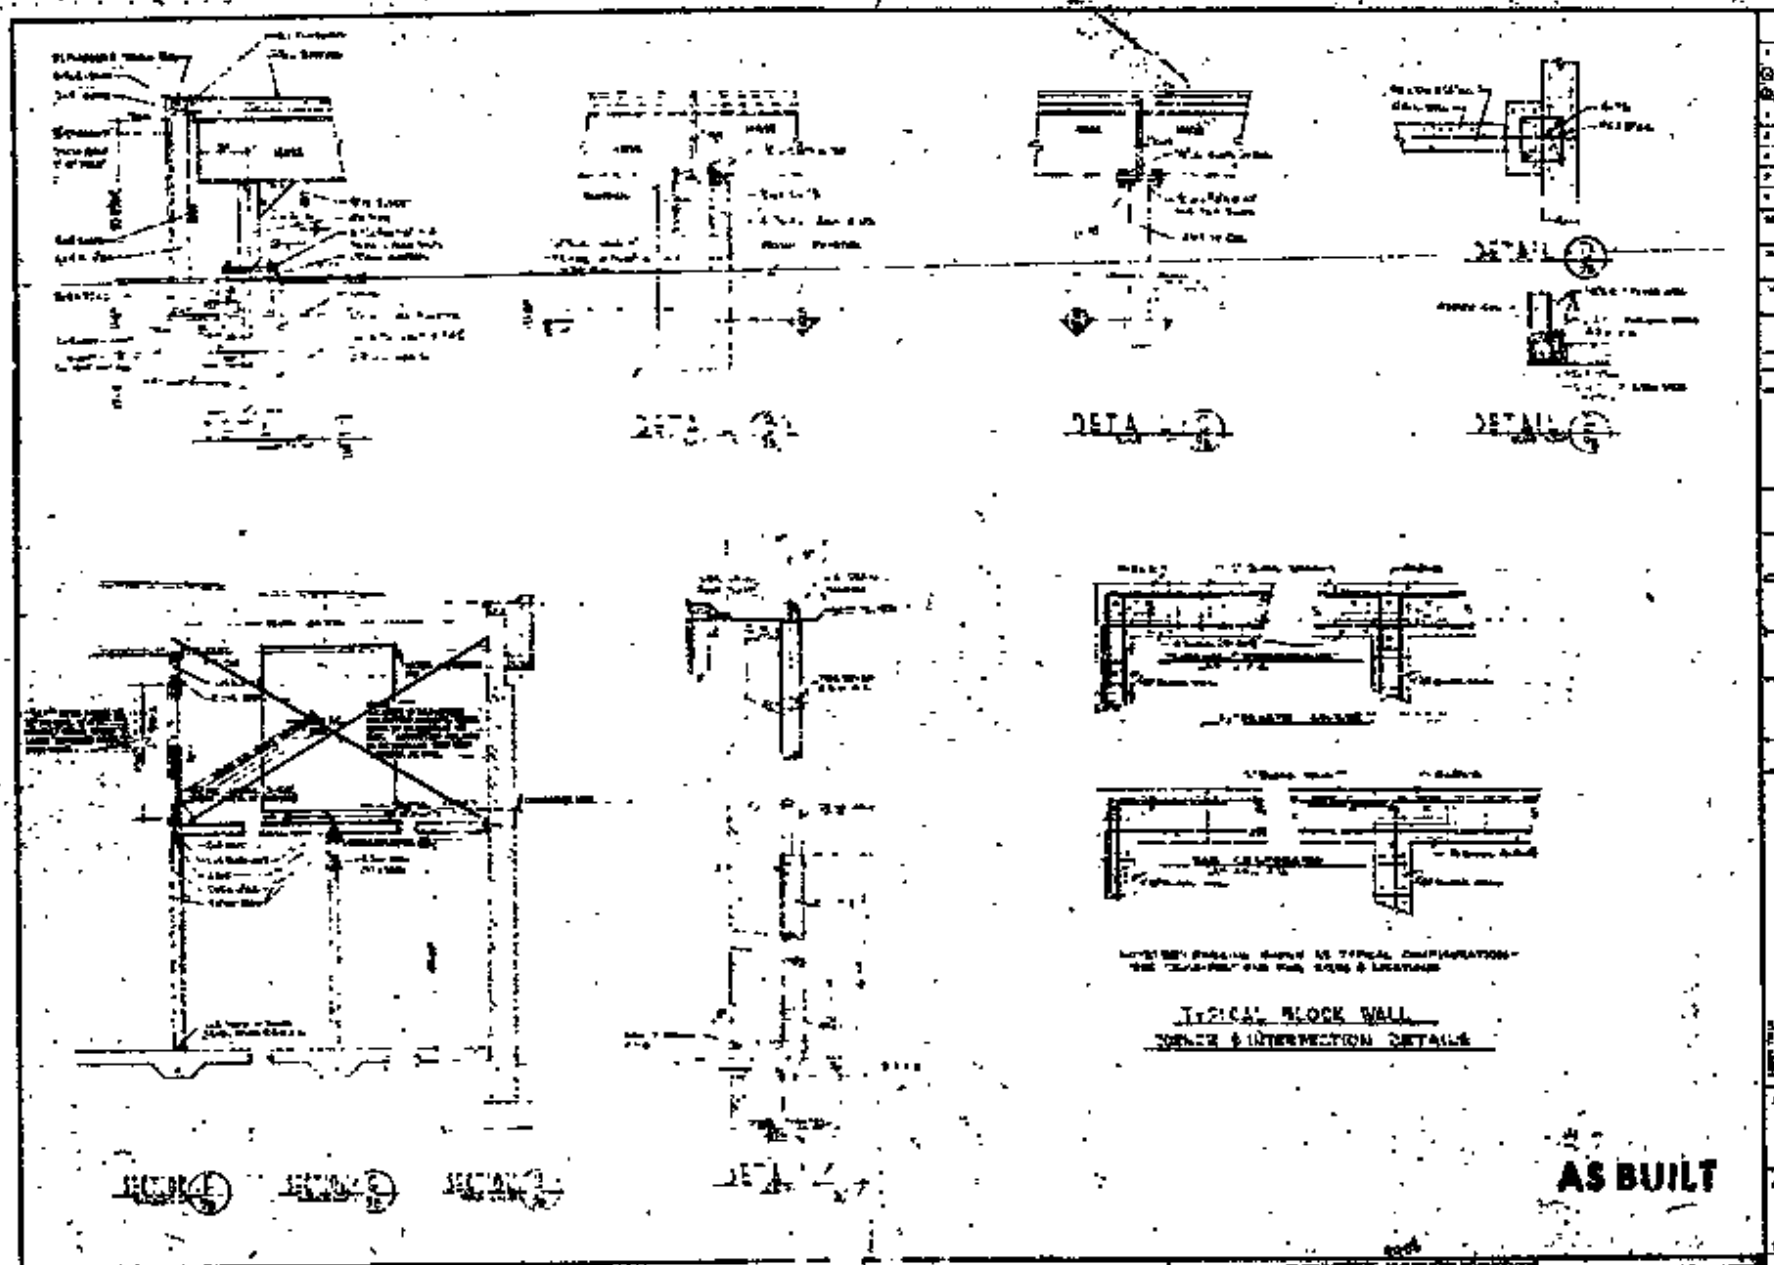
DETAIL
DETAIL
DETAIL
DETAIL
DETAIL
DETAIL
DETAIL
DETAIL
TYPICAL BLOCK WALL
CORNER & INTERSECTION DETAILS
AS BUILT
DETAILS
CITY YARD FACILITIES
CITY OF LAS VEGAS, NEVADA
6310
9s