



**City of Las Vegas, Nevada**  
 Department of  
 Community Planning and Development

**CITY YARDS MASTER PLAN**

- LEGEND:**
- EXISTING OR PROPOSED BUILDING
  - FUTURE EXPANSION
  - VEHICLE FLOW
  - SECURITY FENCING & GATES
  - LANDSCAPE SCREENING

**APPROVALS**

*[Signature]* 10/22/78  
 CITY MANAGER DATE:

*[Signature]* 10-27-78  
 DEPUTY CITY MANAGER COMMUNITY SERVICES

*[Signature]* 10/27/78  
 DEPUTY CITY MANAGER SUPPORT SERVICES

*[Signature]* 10/25/78  
 DIRECTOR PUBLIC SERVICES

*[Signature]* 10/26/78  
 DIRECTOR RECREATION & LEISURE


*[Signature]* 10-28-78  
 ACTING DIRECTOR COMMUNITY PLANNING & DEVELOPMENT

*[Signature]* 10/25/78  
 DIRECTOR MUNICIPAL SERVICES

*[Signature]* 10/25/78  
 DIRECTOR OFFICE OF ARCHITECTURAL SERVICES

BONANZA ROAD

MOJAVE ROAD

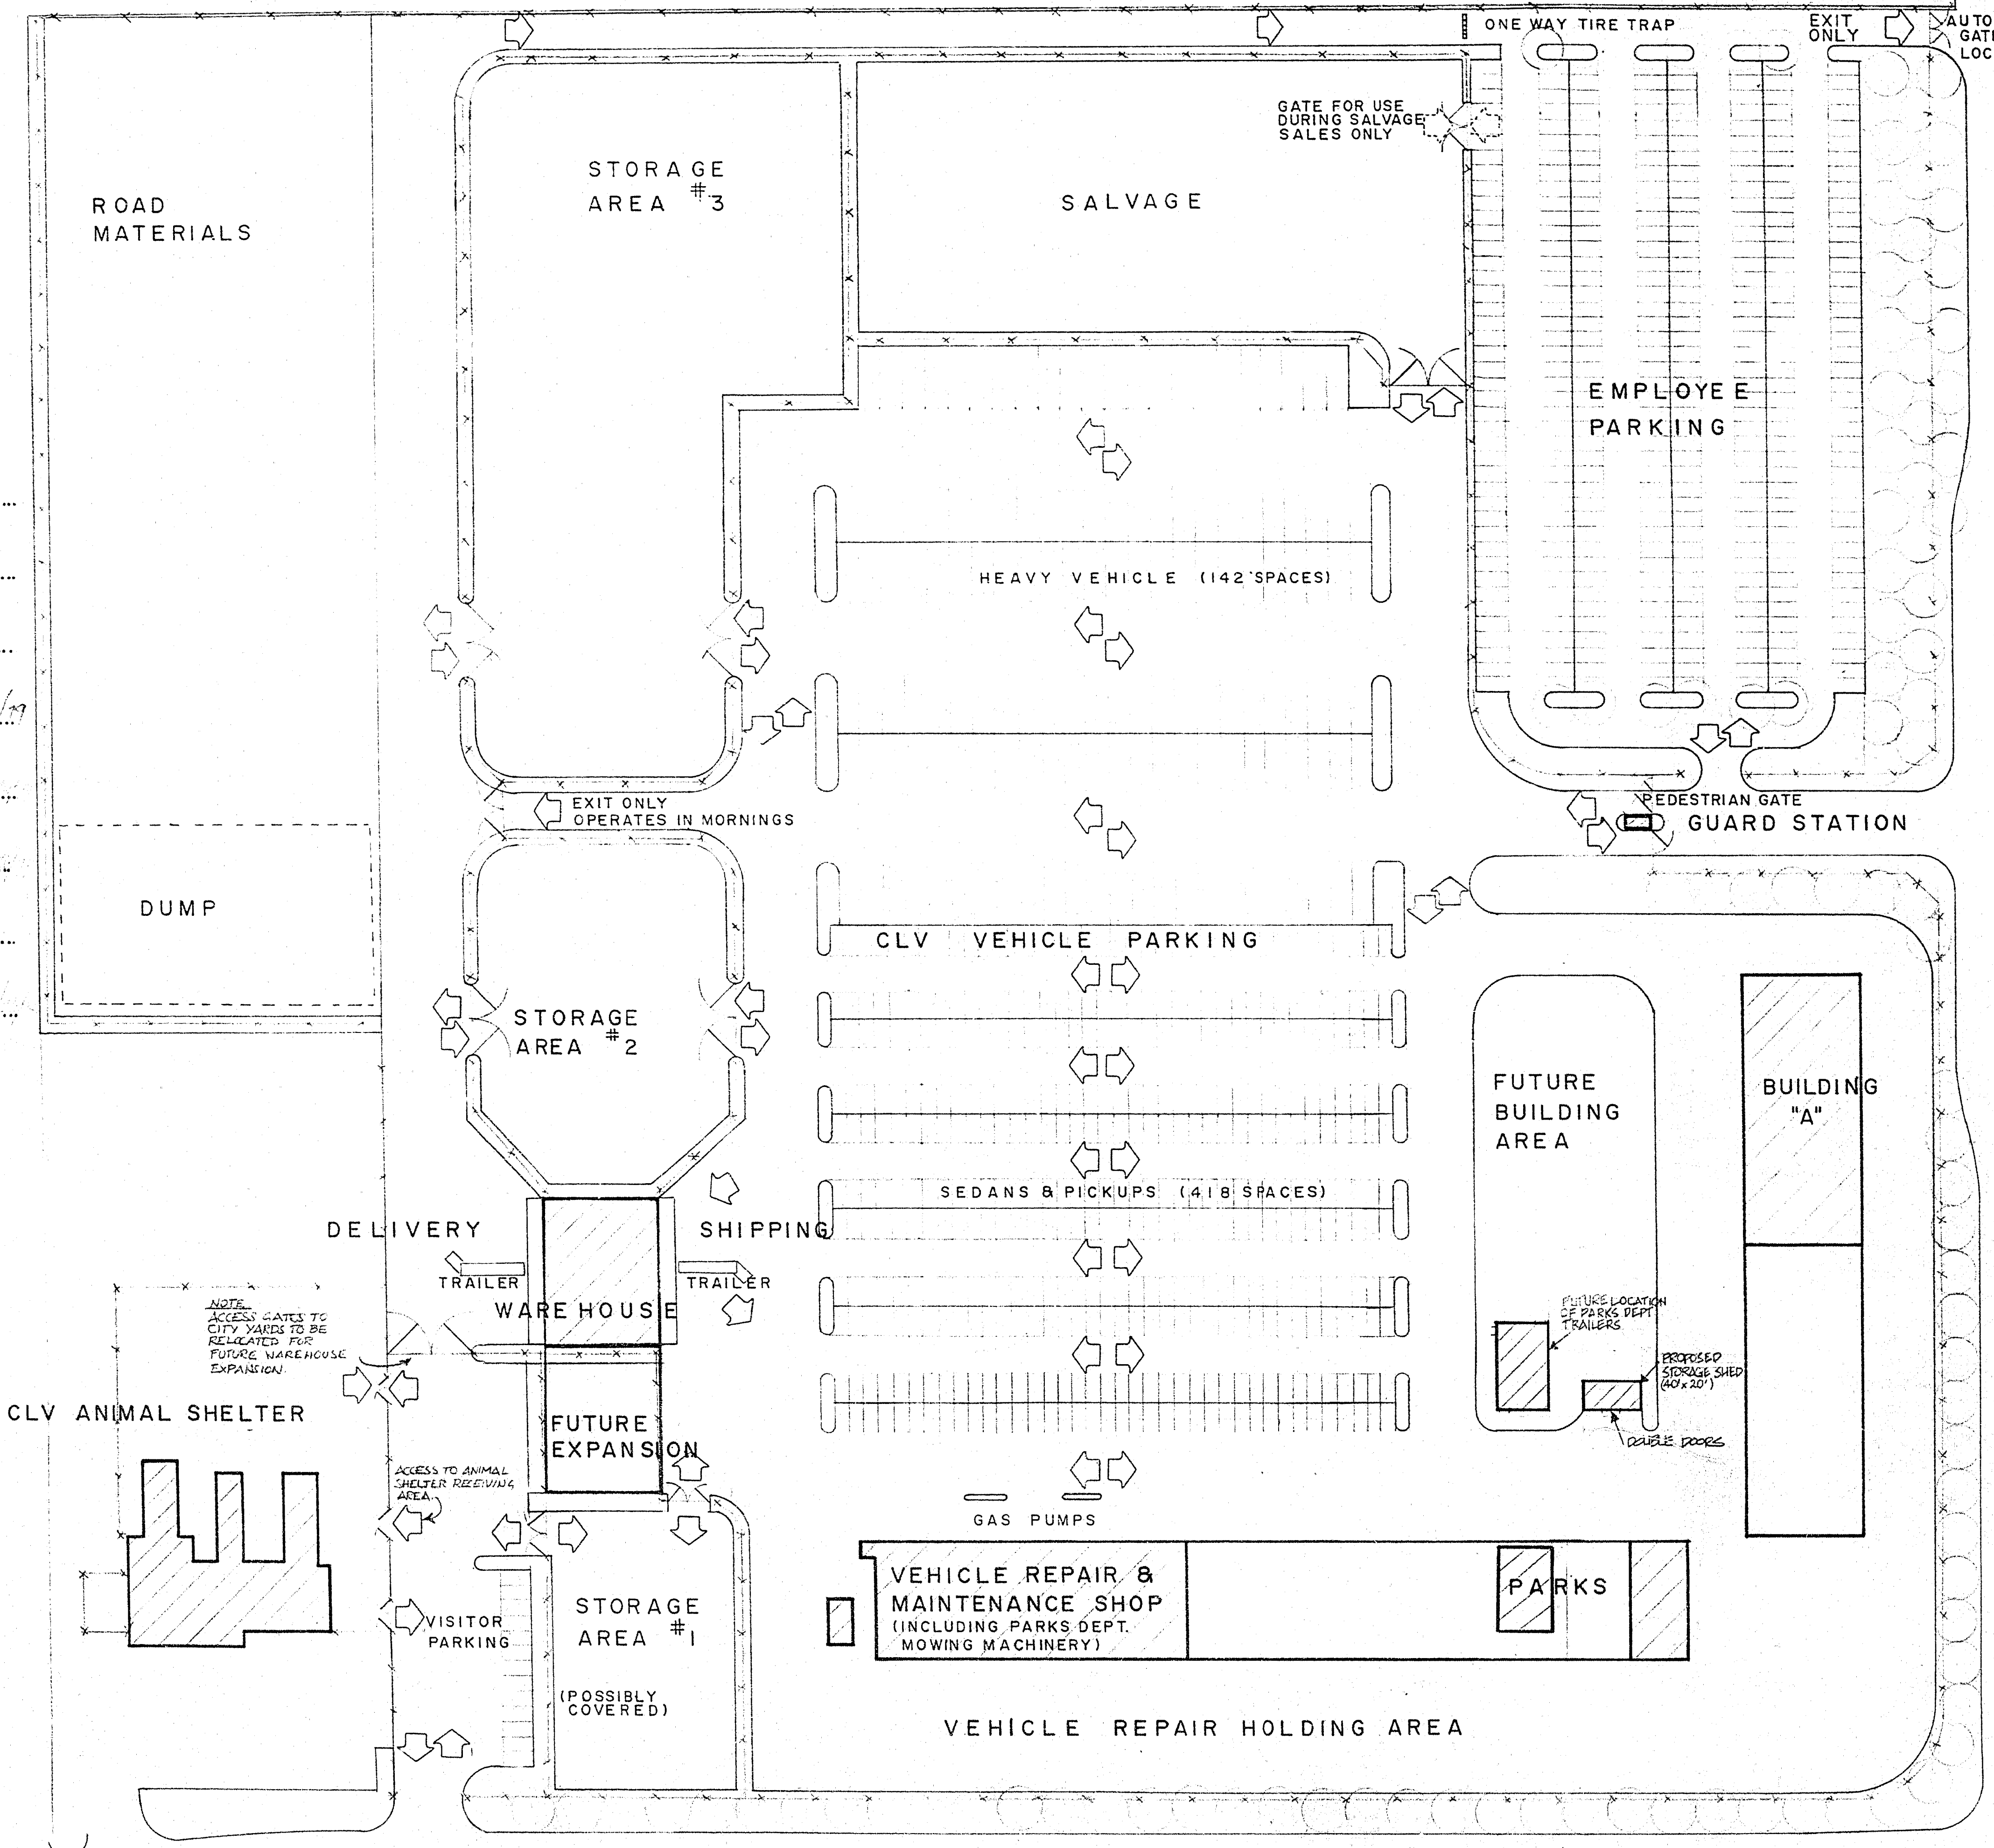

Revision A  
 Parks Storage Shed  
 APPROVALS

CITY MGR. \_\_\_\_\_

D.C. MGR. C.S. \_\_\_\_\_

D.C. MGR. S.S. \_\_\_\_\_


*[Signature]*  
 DIR. P.S.

*[Signature]*  
 DIR. R & L

*[Signature]*  
 DIR. C.P. & D.

*[Signature]*  
 DIR. M.S.

*[Signature]*  
 DIR. O.A.S.

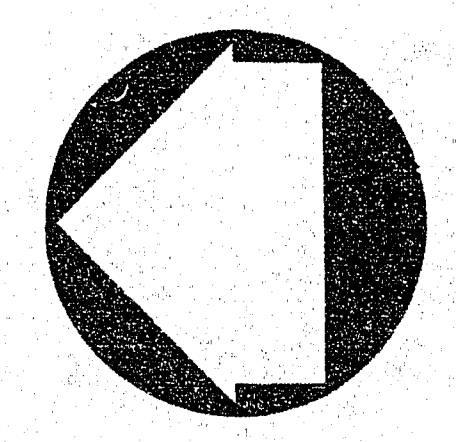

Sheet 2 A  
 Drawing No. \_\_\_\_\_  
 W. O. No. \_\_\_\_\_  
 of \_\_\_\_\_