



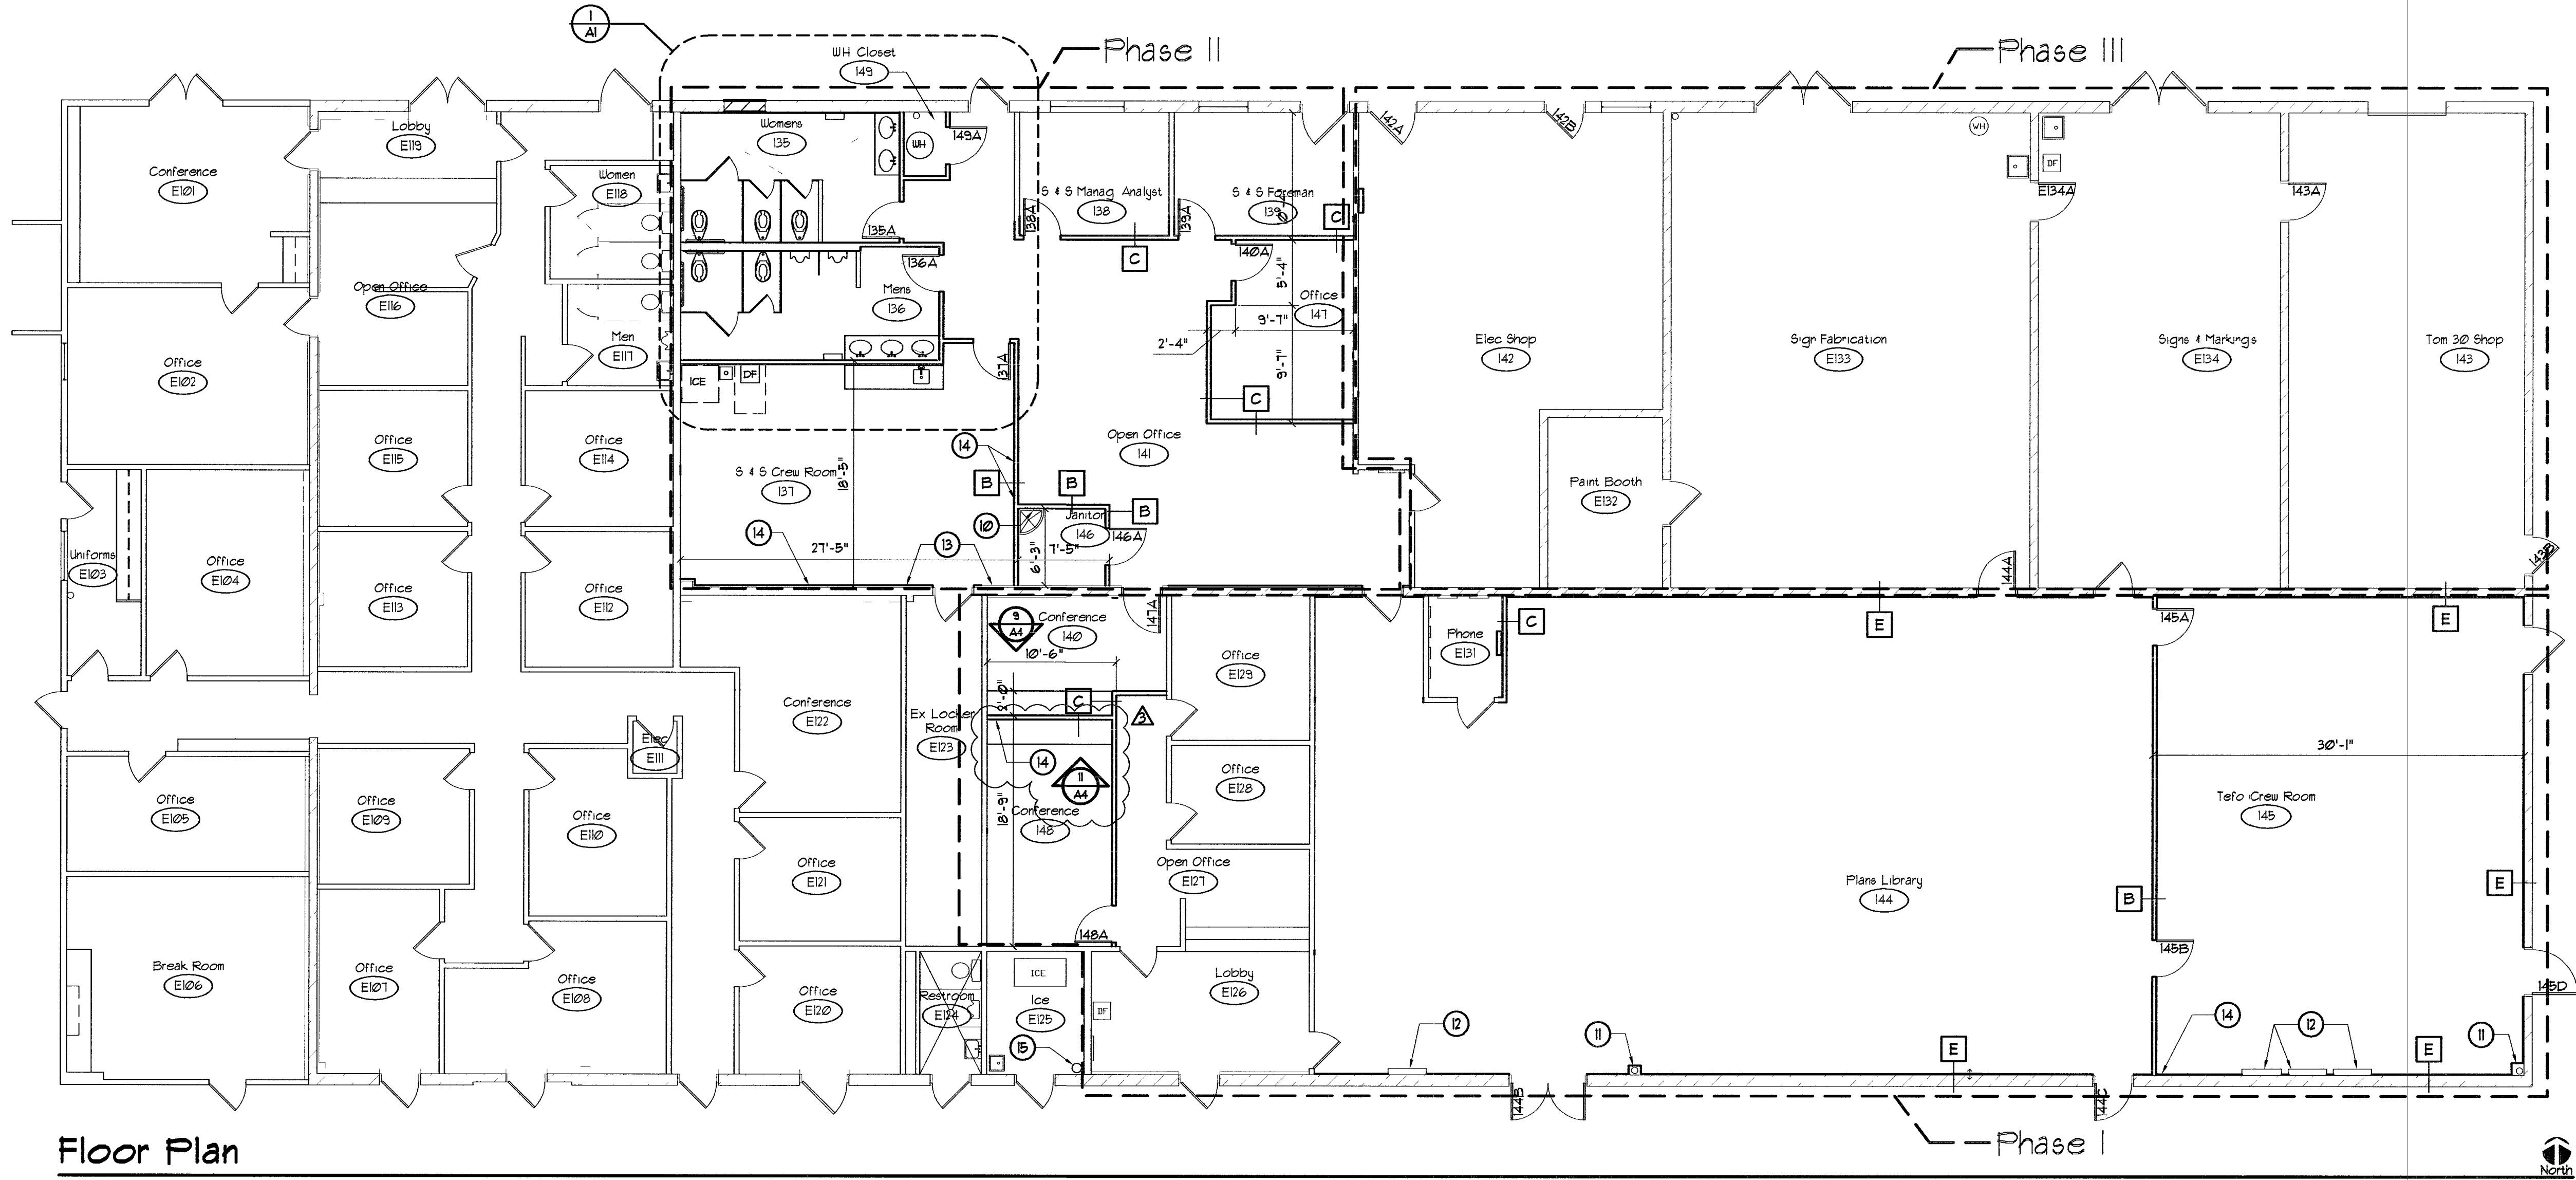

Floor Plan
 Scale: 1/8" = 1'-0"

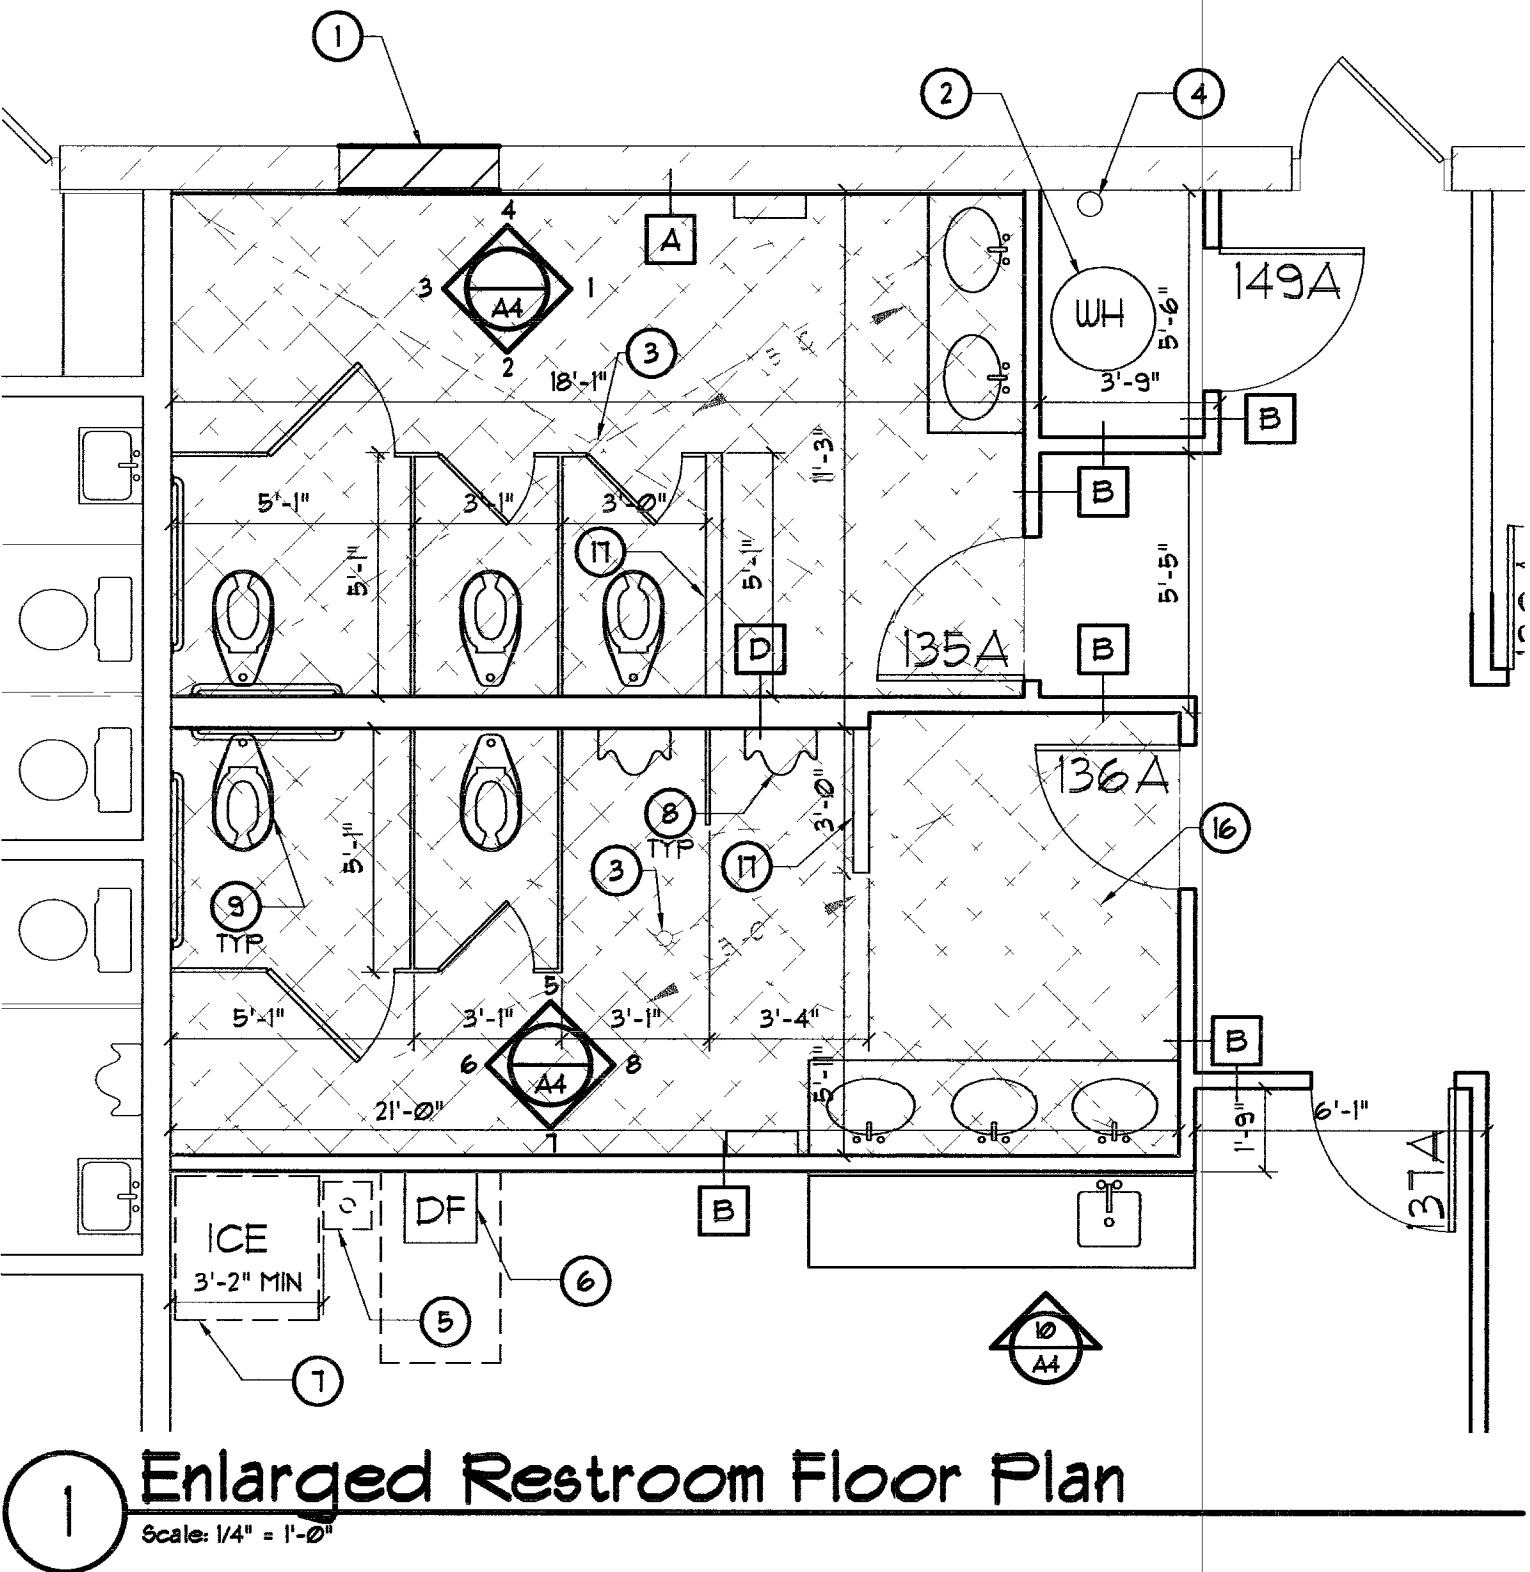

Enlarged Restroom Floor Plan
 Scale: 1/4" = 1'-0"

LEGEND	
	EXISTING STUD WALL
	NEW STUD WALL
	EXISTING DOOR
	NEW DOOR - SEE DOOR SCHEDULE FOR TYPE
	WALL TYPES - SEE SHEET A3

General Floor Plan Notes

1. WORK TO BE COMPLETED IN PHASES - SEE DEMO FLOOR PLAN FOR PHASE AREAS

Floor Plan Notes

1. FILL IN OPENING W/ MASONRY TO MATCH EXISTING DEPTH AND FINISH
2. WATER HEATER - SEE PLUMBING DRAWINGS
3. FLOOR DRAIN - SEE PLUMBING DRAWINGS - SLOPE FLOOR FOR POSITIVE DRAINAGE
4. EXISTING ROOF DRAIN - PROTECT DURING CONSTRUCTION
5. FLOOR SINK - SEE PLUMBING DRAWINGS
6. DRINKING FOUNTAIN - SEE PLUMBING DRAWINGS
7. ICE MACHINE - SEE PLUMBING DRAWINGS
8. URINAL - SEE PLUMBING DRAWINGS
9. WATER CLOSET - SEE PLUMBING DRAWINGS
10. MOP SINK - SEE PLUMBING DRAWINGS
11. BOX OUT STUDS AROUND EXISTING DRAIN PIPE - MINIMIZE SIZE
12. FURR OUT WALL AROUND EXISTING ELECTRICAL PANELS
13. MATCH EXISTING DEPTH OF FURRING
14. PROVIDE STEEL BACKING PLATE IN WALL - SEE FURNITURE PLAN
15. LOCATION OF NEW FIRE RISER
16. CFT-1 FLOOR TILE AT 45° ANGLE
17. CONSTRUCT WALL TO BE 6'-0" AFF - BRACE AT FLOOR IF REQUIRED PROVIDE TILE FINISH TO 6'-0" AFF. ON SIDE NEAREST FIXTURE SEE ELEVATIONS FOR MORE INFORMATION



REVISIONS
 1/21/05
 OWNER CHANGES

CONSULTANT

CLV East Yard Building "A" Interior Remodel
 3104 E Bonanza Road
 Floor Plan

STAMP

OWNER: CITY OF LAS VEGAS
 DEPARTMENT OF PUBLIC WORKS
 ARCHITECTURAL SERVICES

400 EAST STEWART AVENUE
 LAS VEGAS, NEVADA 89101
 PHONE: (702) 225-6535
 FAX: (702) 384-4846
 TDD: (702) 386-9108

DRAWN: map
 FILE: bldgA-A1
 DATE: 11/19/04
 SCALE: full

BID NO.

CLV DWG NO. 522-V25-2

SHT NO.

A1