



NOTES:

1. COAT OUTLET AND VALVE WITH EPOXY PER SPECS. SECTION 1502.
2. WRAP OUTLET AND VALVE WITH TWO LAYERS OF POLYETHYLENE FILM PER SPECS. SECTION 1502.
3. INSTALL VALVES CLOSED.

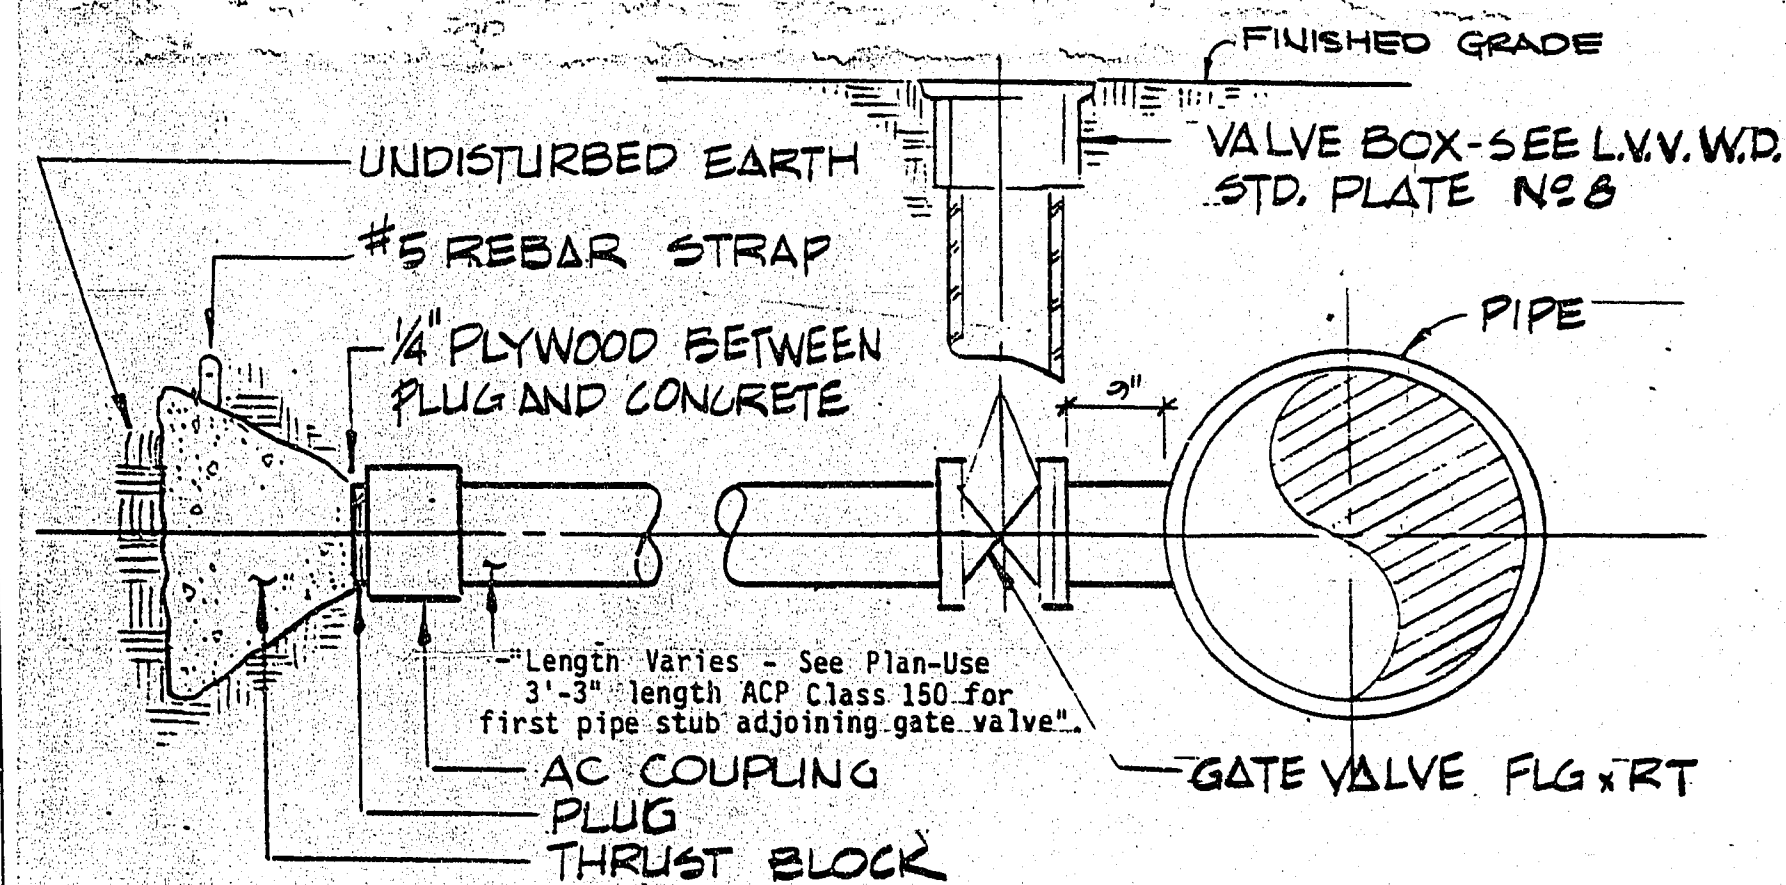


OUTLET DETAIL TYPE "A"
NO SCALE

4
12

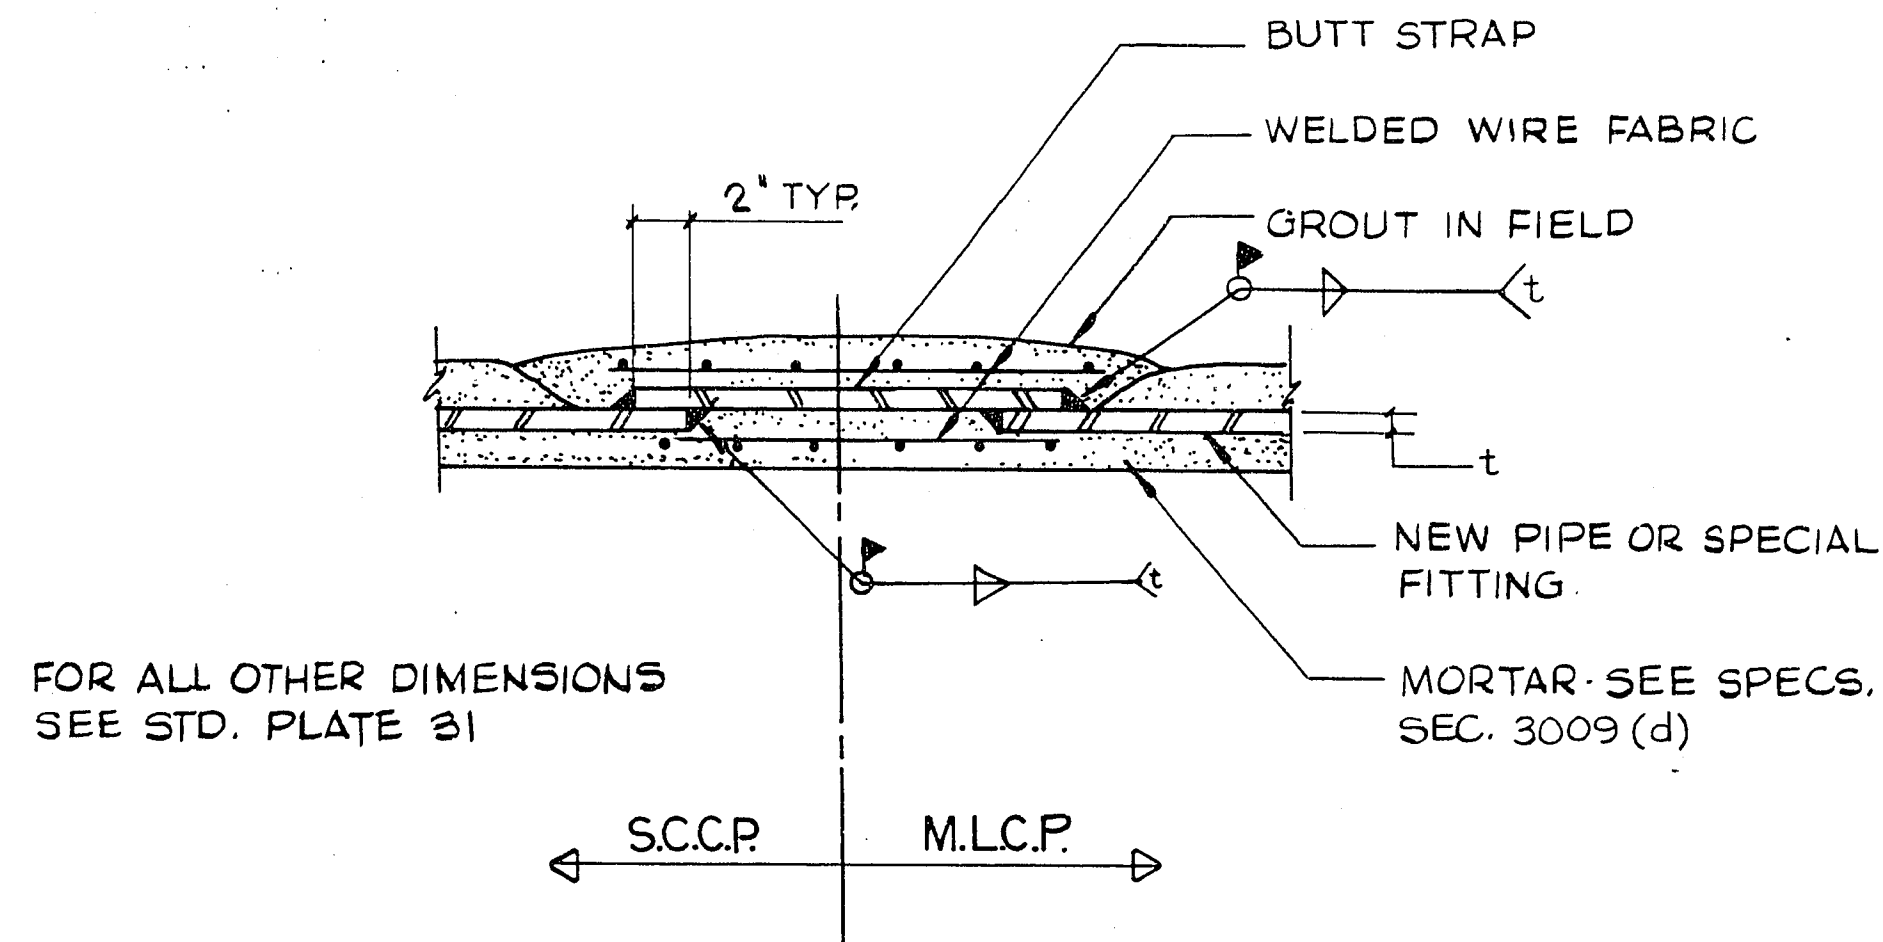


BUTT STRAP JOINT AT CONNECTIONS TO EXISTING STEEL PIPE (TYP)

3
12

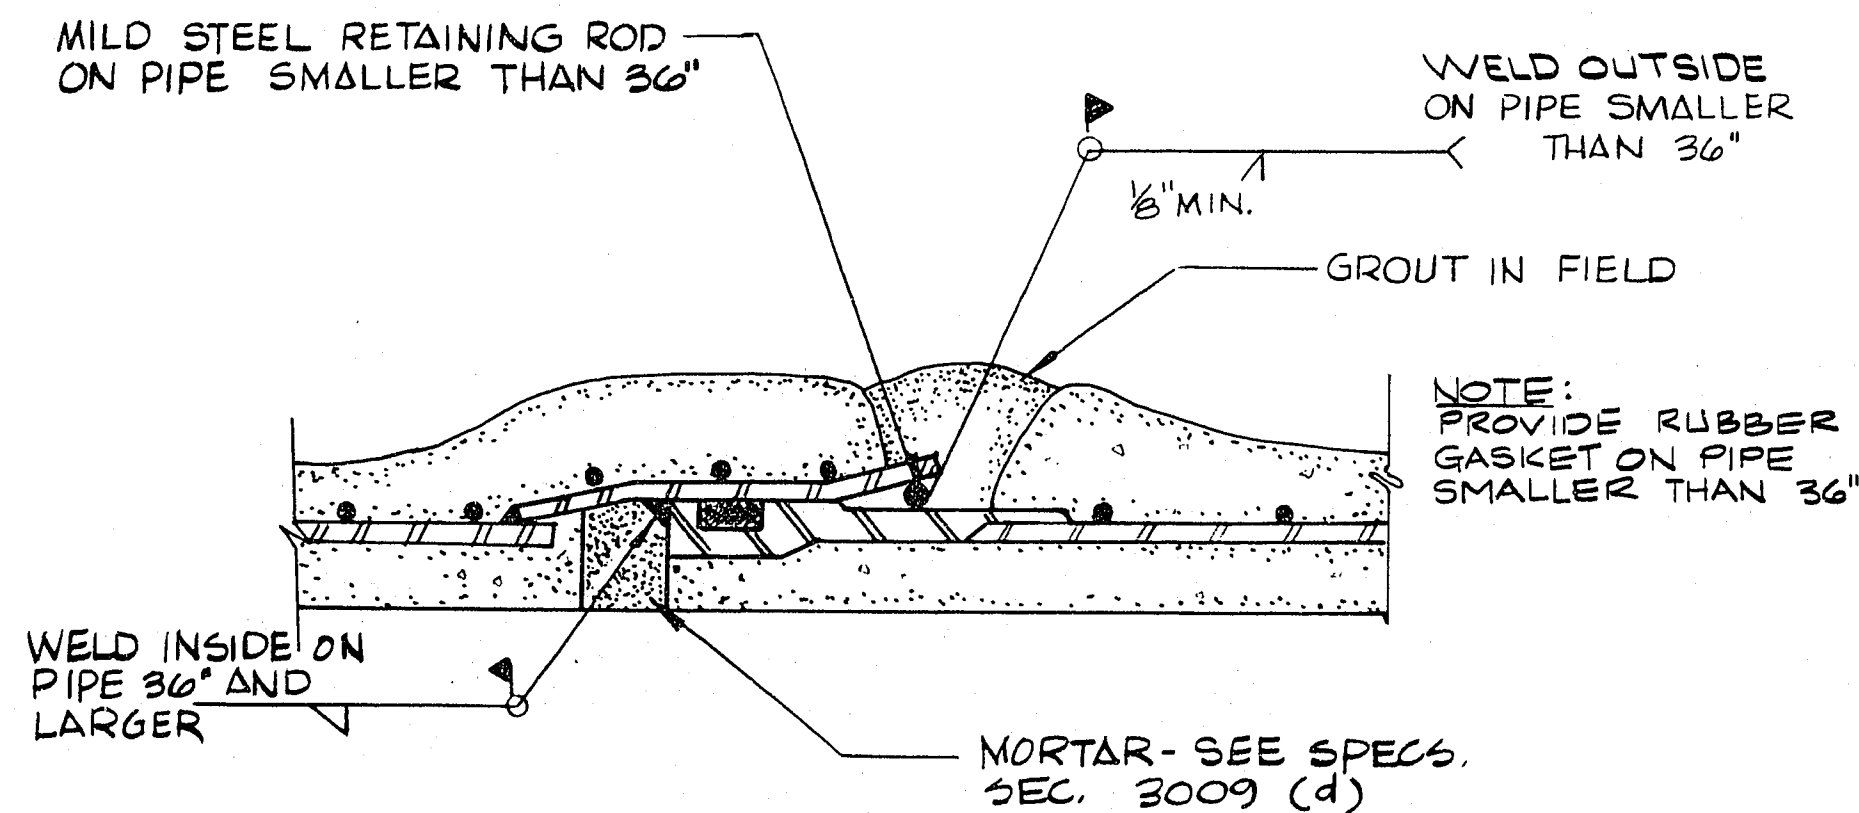


FIELD WELD DETAIL

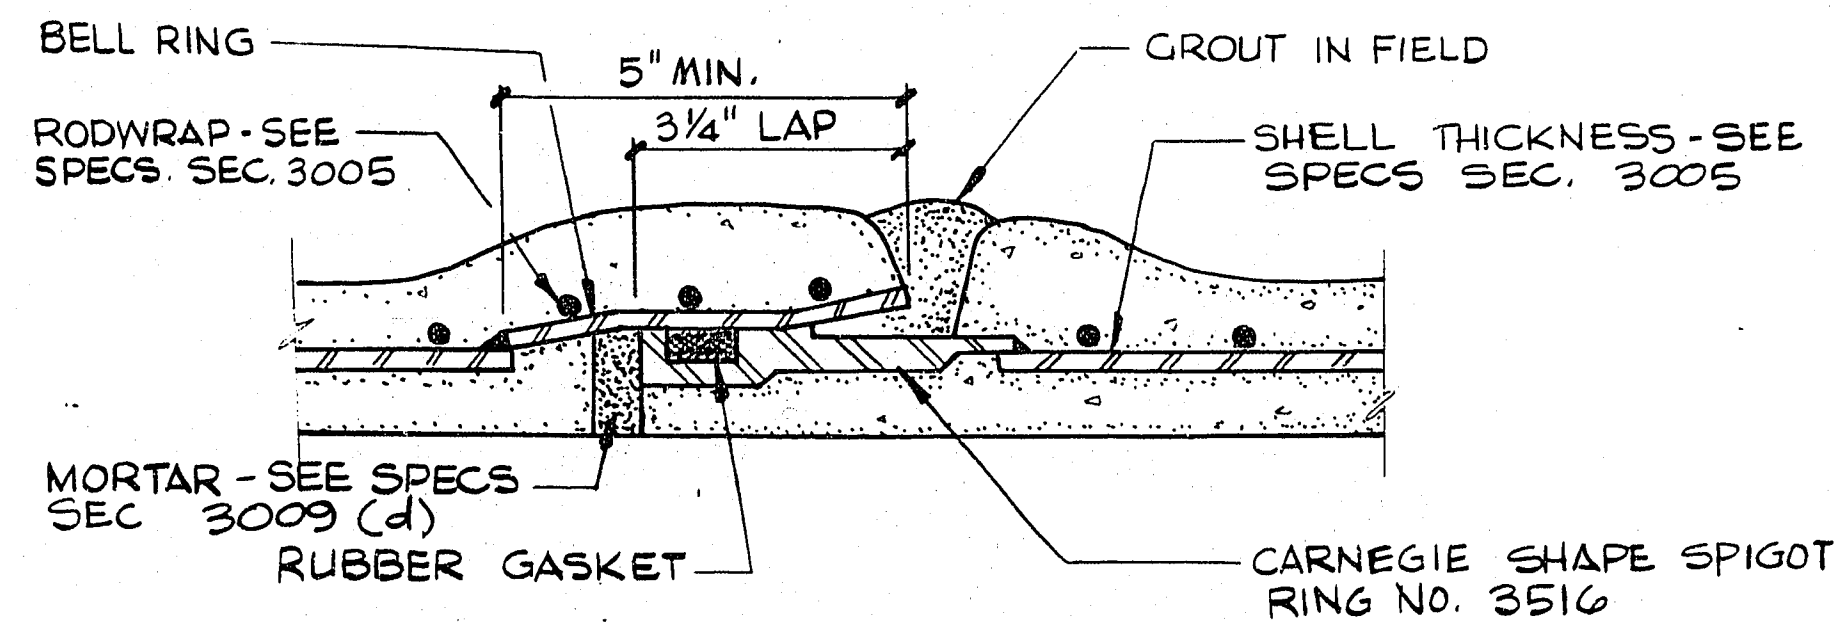


BELL & SPIGOT JOINT

STEEL CYLINDER CONCRETE PIPE


2
12

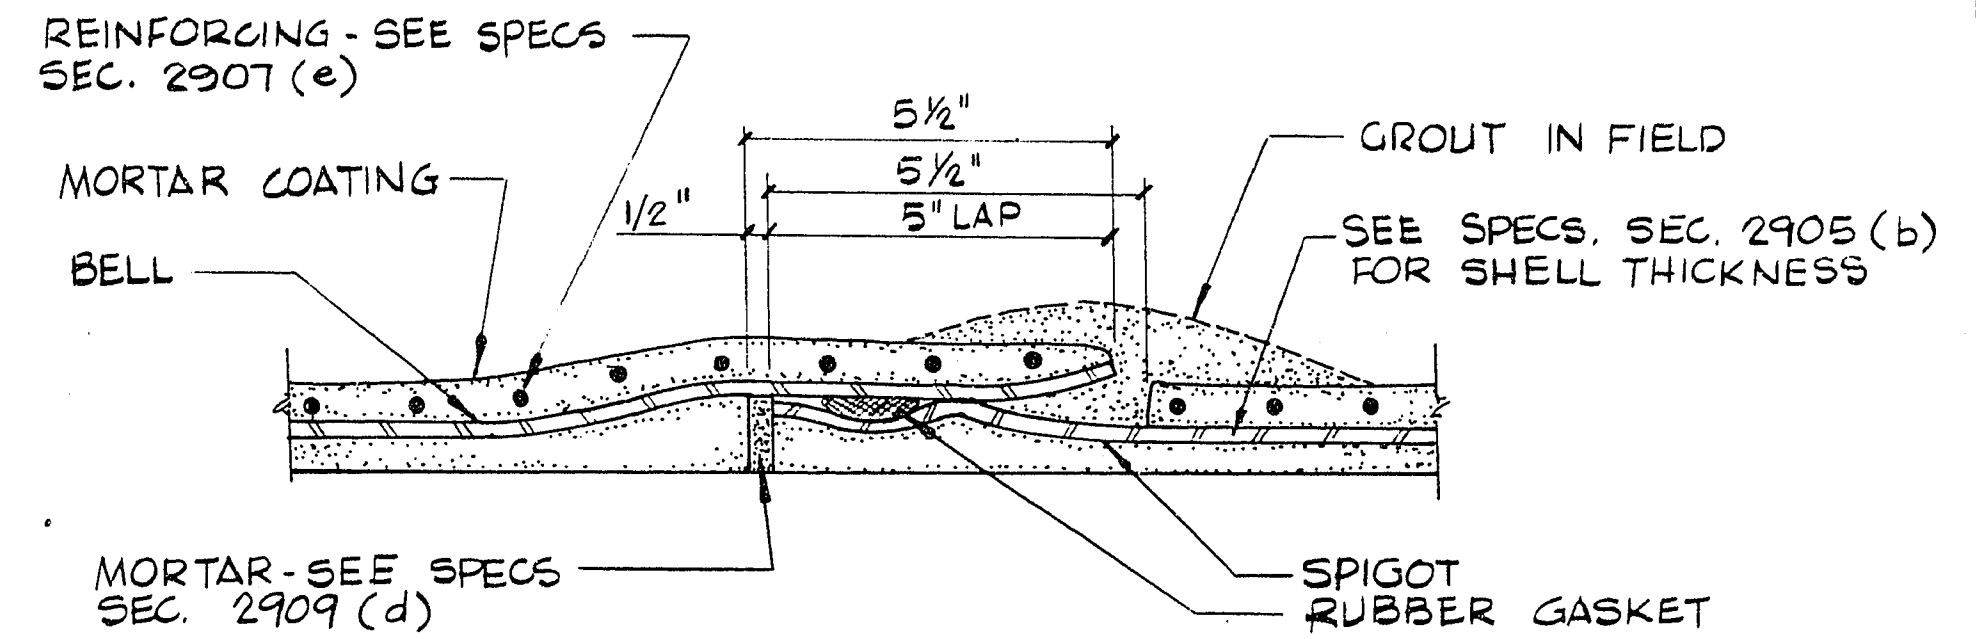

DEEP BELL
M.L.C.S.P. SHOWN - DIMENSIONS OF BELL TYPICAL FOR S.C.C.P.

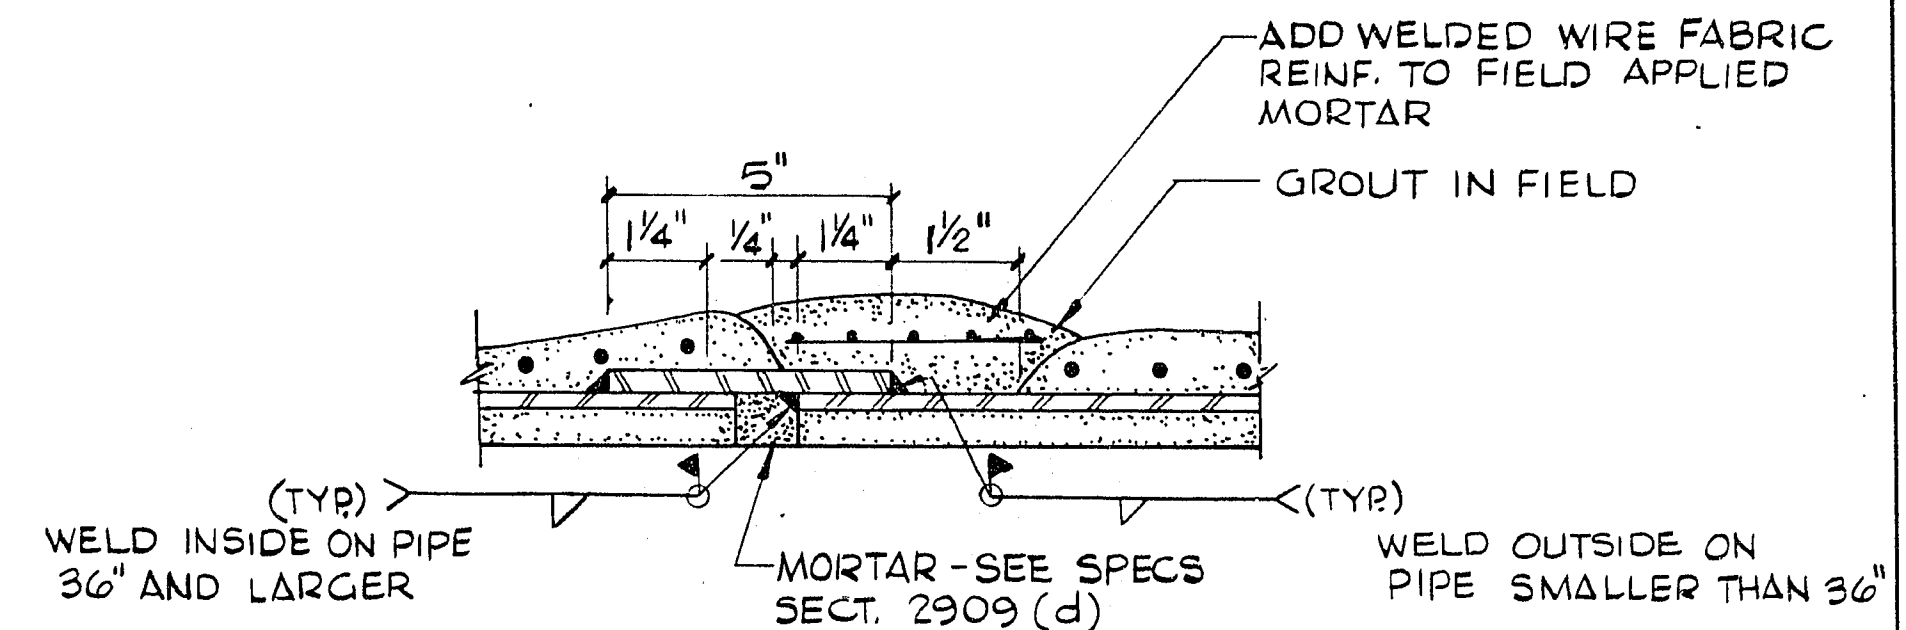


SLIP JOINT ALTERNATE "B"

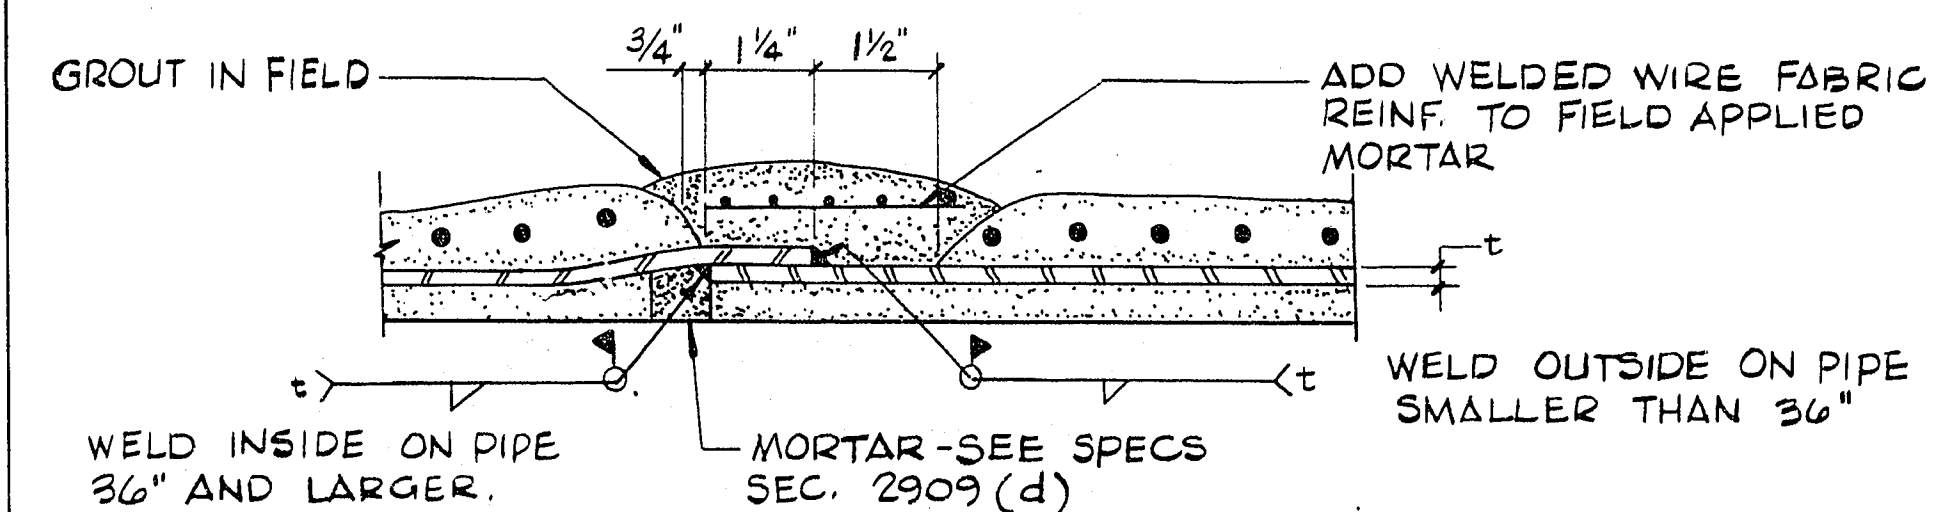

SLIP JOINT ALTERNATE "A"

FIELD WELD JOINTS

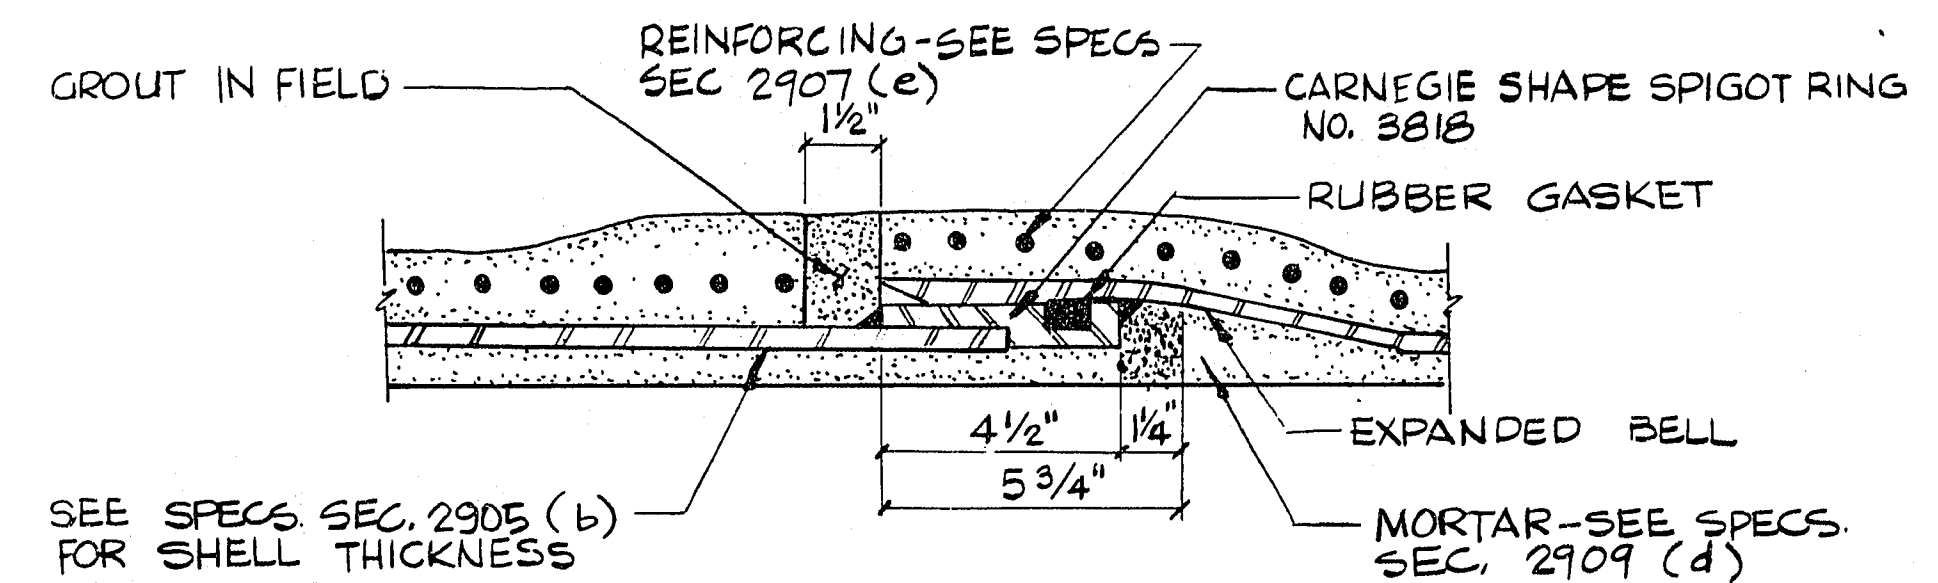

BELL & SPIGOT JOINT

LAS VEGAS VALLEY WATER DISTRICT

PRESSURE TEST DATE 11/15

STATE HEALTH SAMPLE DATE N/A

INSPECTOR DAVID MATHIS

MORTAR LINED & COATED STEEL PIPE

1
12

DEL. E. WEBB COMMUNITIES INC.
2745 ZONE PIPELINE PHASE II
PIPING DETAILS III

SHEET
12
OF 13 SHEETS