

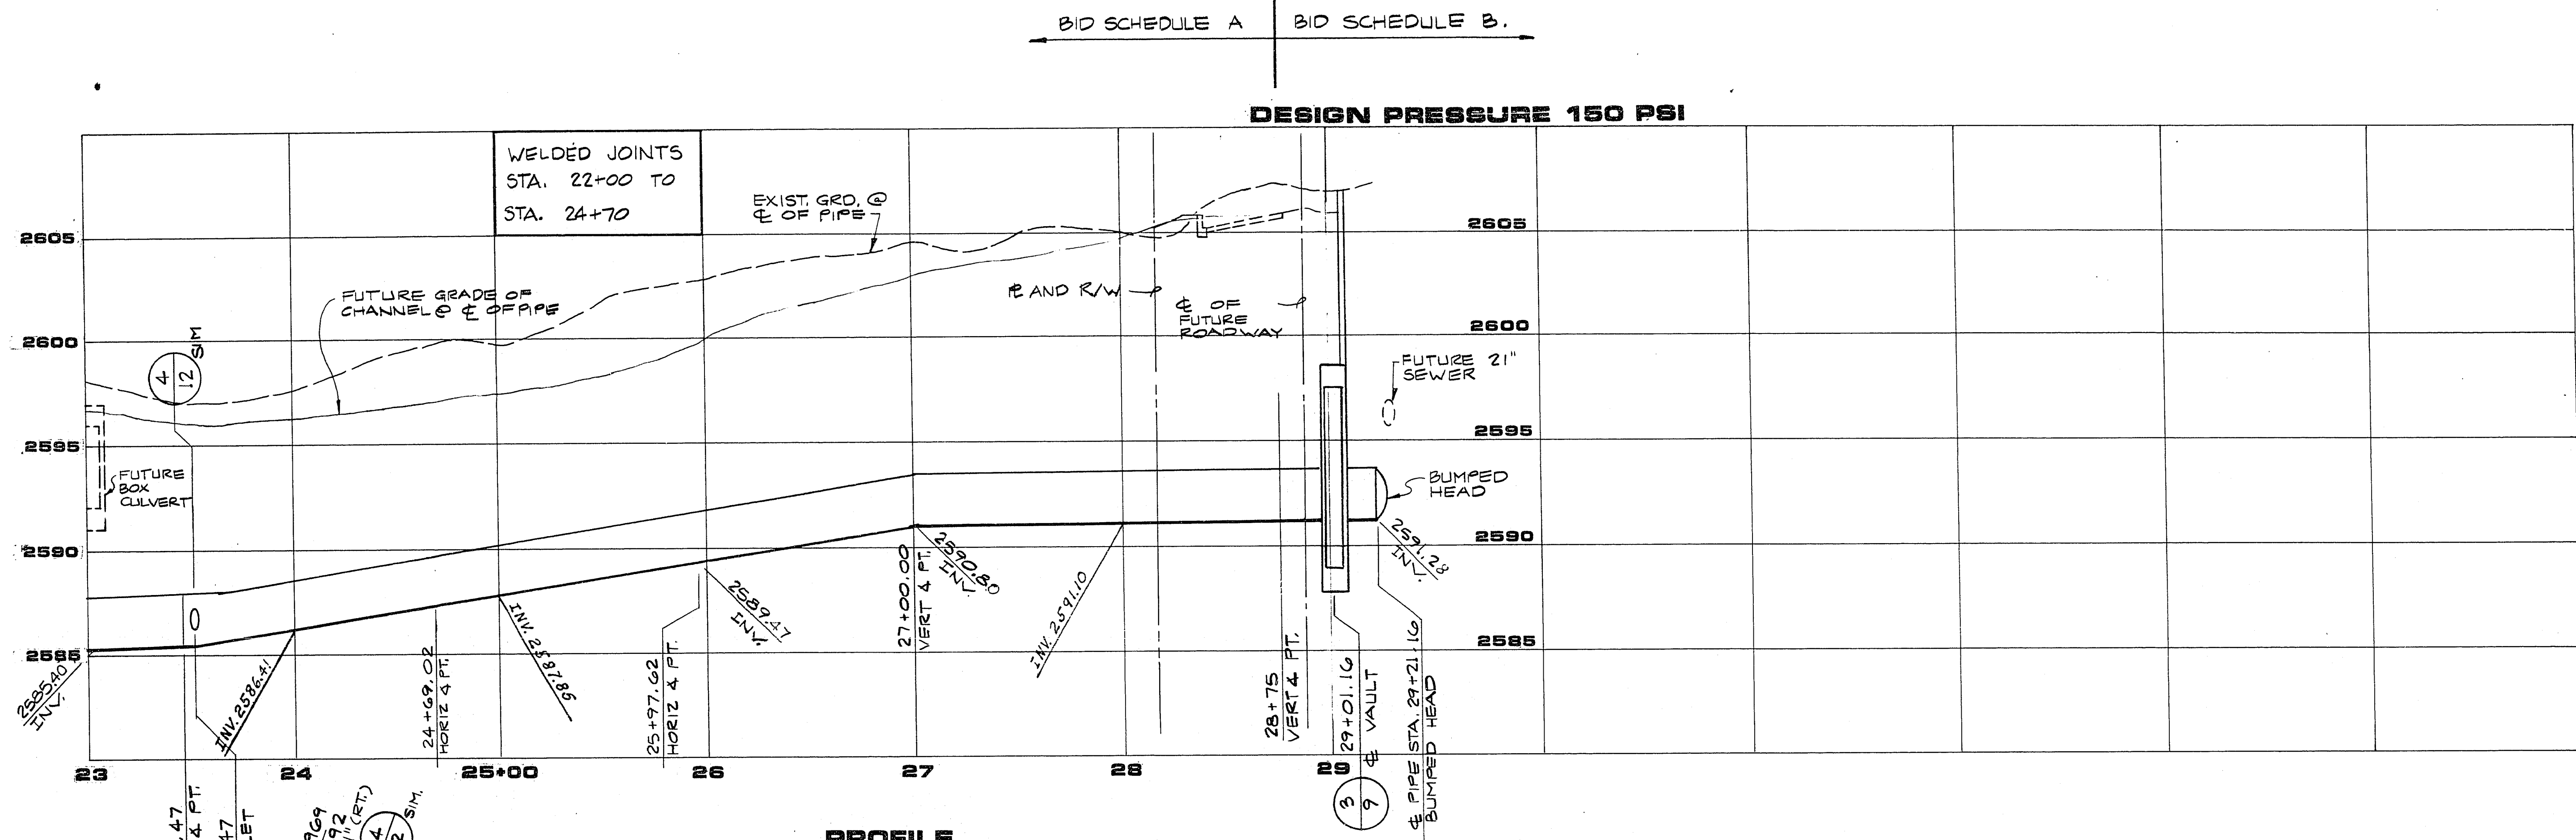


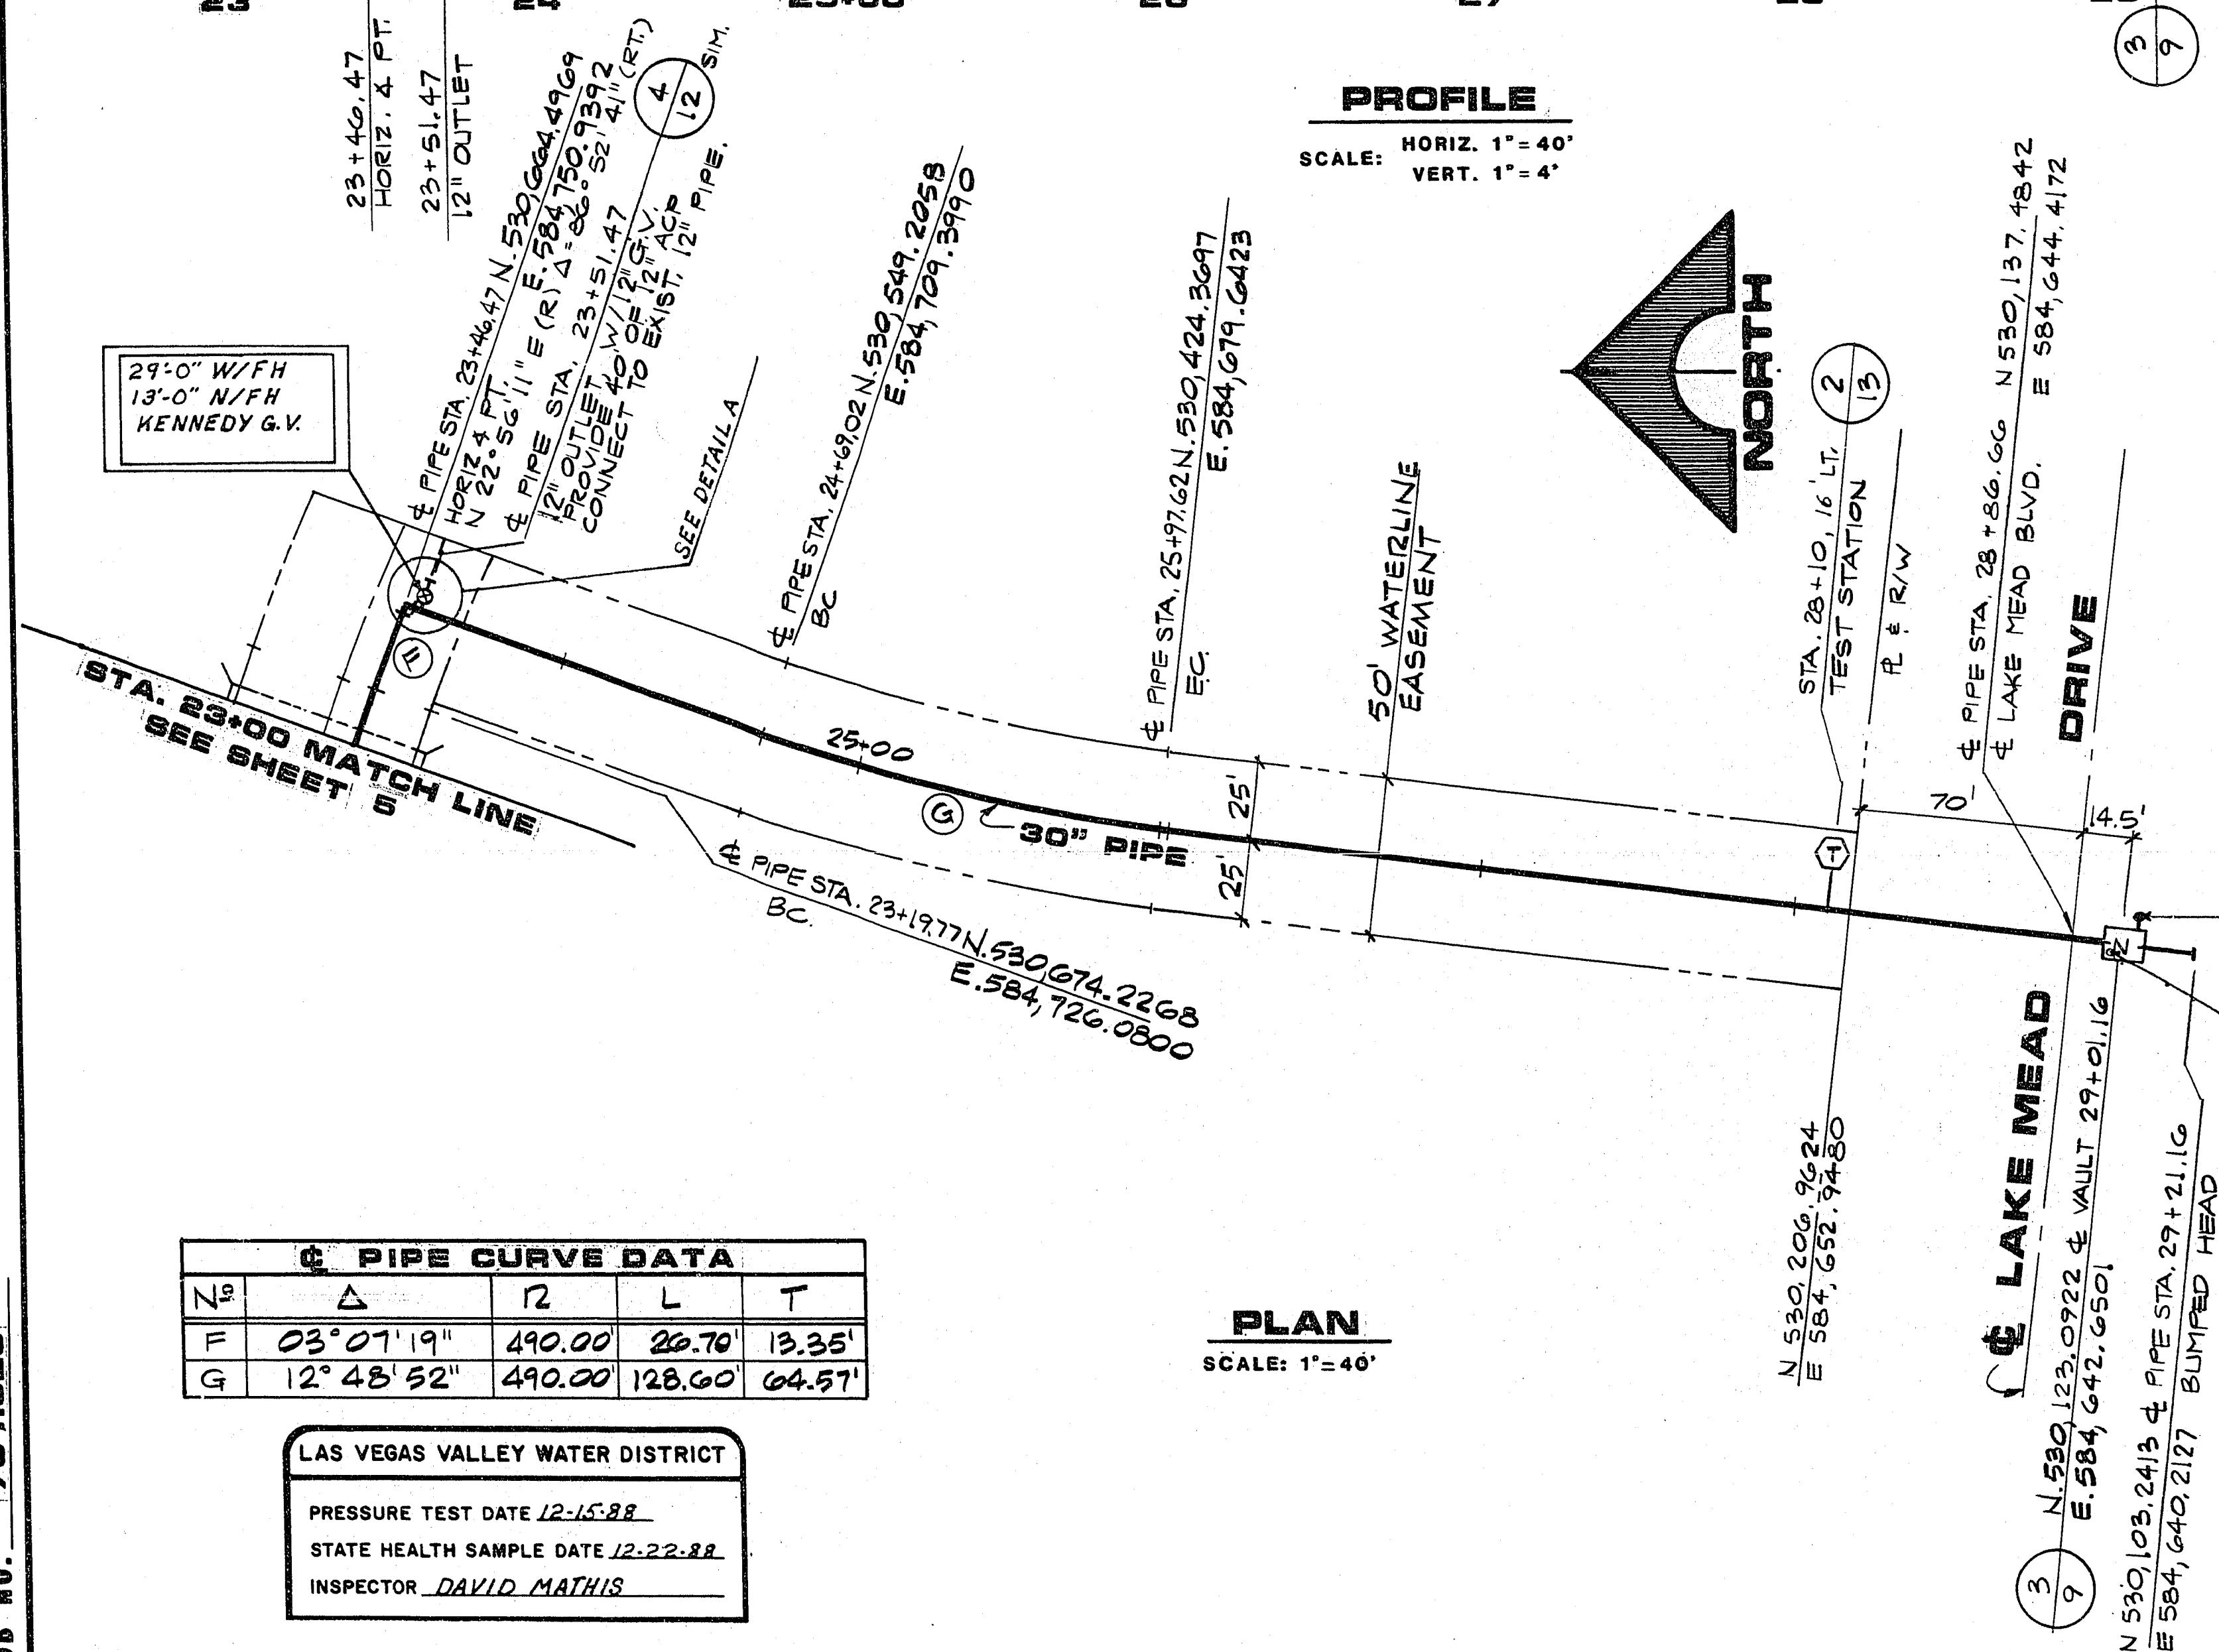

PROFILE

SCALE: HORIZ. 1" = 40'
VERT. 1" = 4'

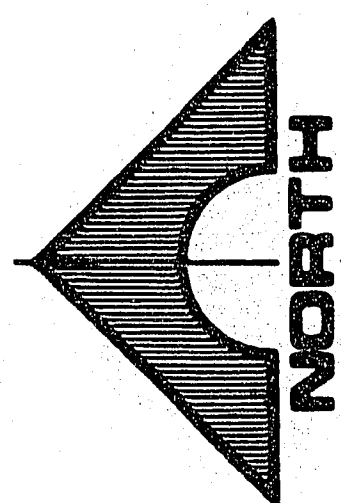

PLAN

SCALE: 1" = 40'

C PIPE CURVE DATA				
N ^o	Δ	R	L	T
F	03° 01' 19"	490.00	20.70'	13.35'
G	12° 48' 52"	490.00	128.60'	64.57'

LAS VEGAS VALLEY WATER DISTRICT

PRESSURE TEST DATE 12-15-88

STATE HEALTH SAMPLE DATE 12-22-88

INSPECTOR DAVID MATHIS

NOTES:

1. STREETS AND UTILITIES UNDER CONSTRUCTION BY OTHERS SEE SPECIFICATIONS SECTION 1028 FOR CONDITION OF SITE DURING CONSTRUCTION OF THIS CONTRACT. SITE WILL BE ROUGH GRADED TO WITHIN 6-INCHES OF FINISHED GRADE FOR THIS CONTRACT.
2. SET VALVE BOXES AND OTHER SURFACE APPURTENANCES TO FINISHED GRADE AS SHOWN ON PROFILE.
3. SEE DETAIL 2/11 FOR TYPICAL TRENCH SECTION.
4. STA. 4+50 TO STA. **28+75** (SCHEDULE A). SEE SPECIFICATIONS FOR COMPLETION REQUIREMENTS. PROVIDE TEMPORARY TEST HEAD AT STA. 4+50. AND **28+75**.

