
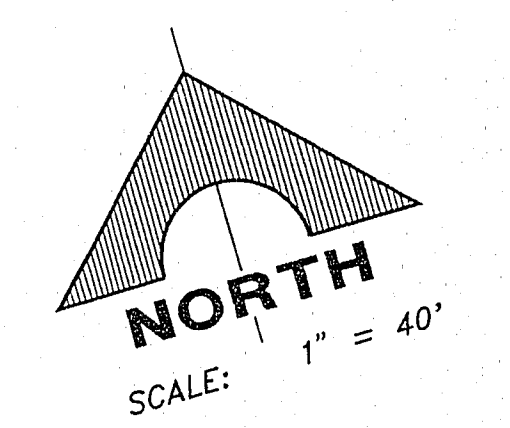
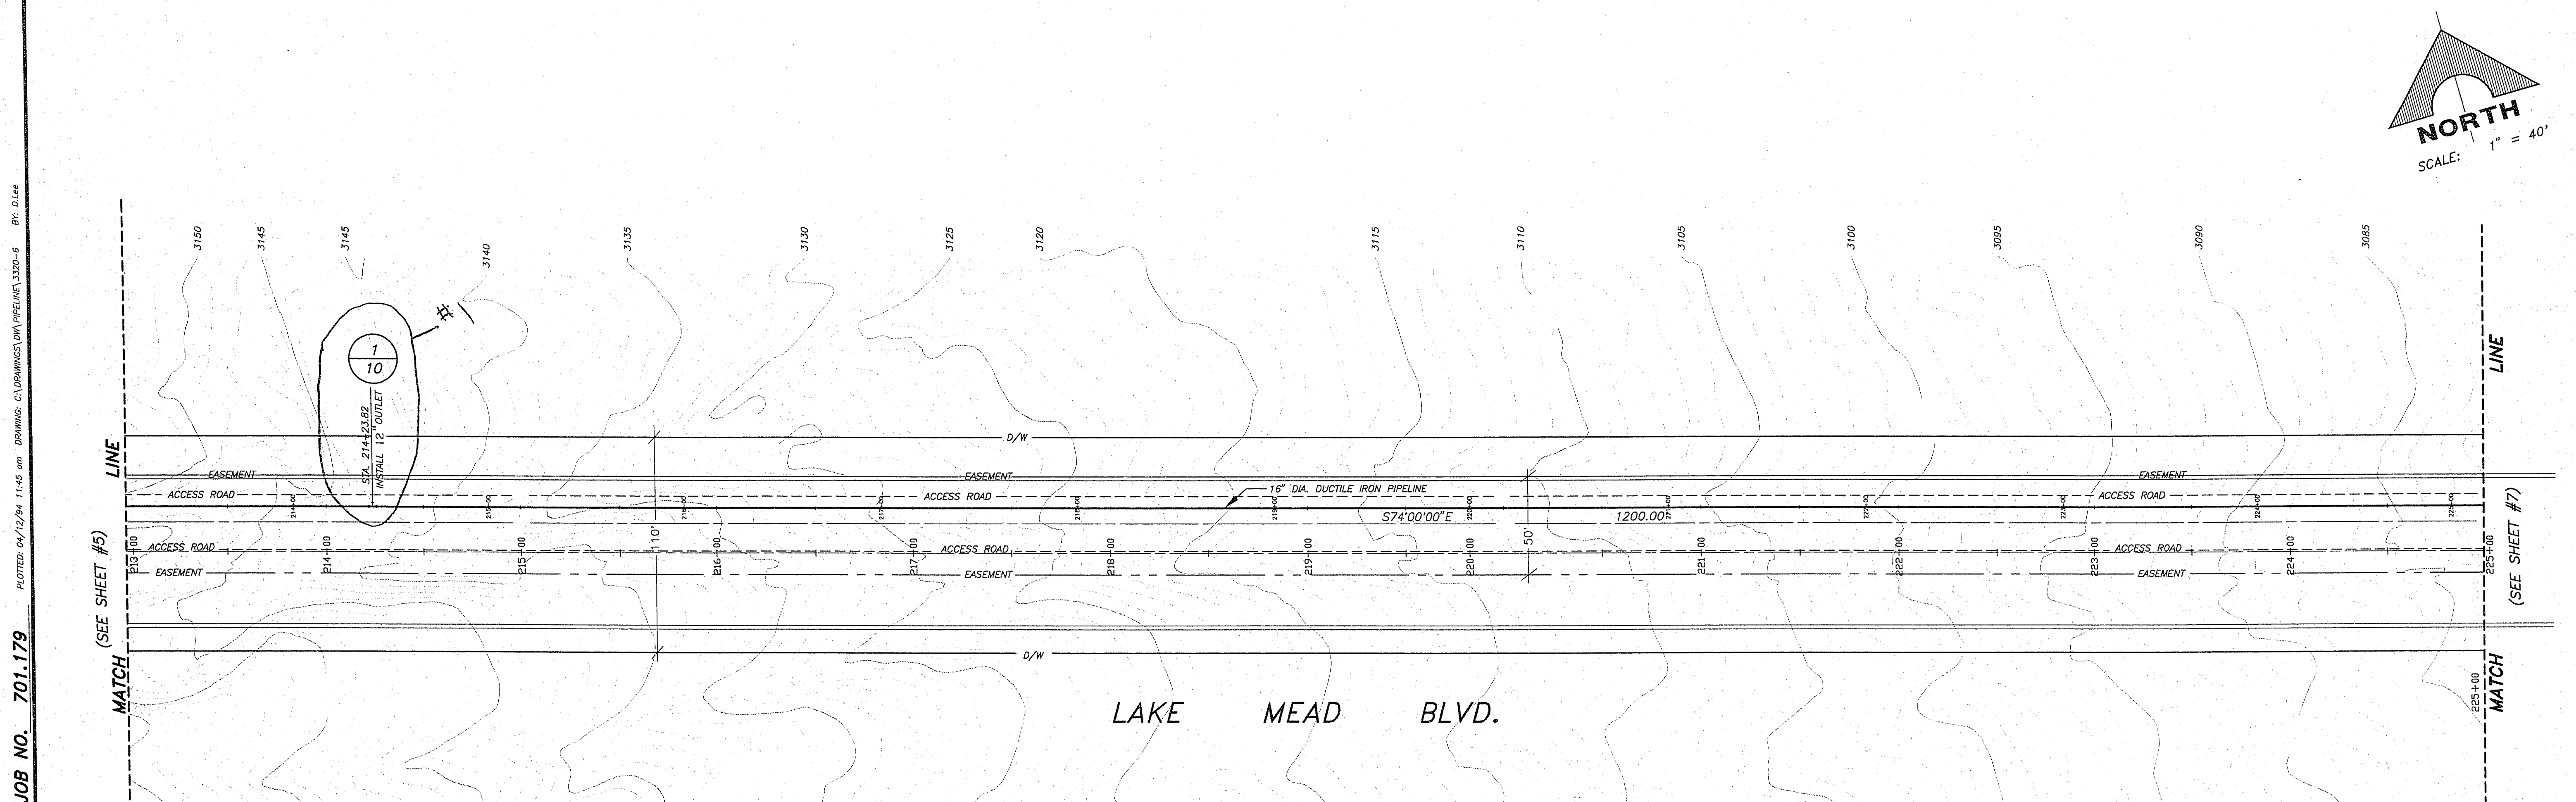


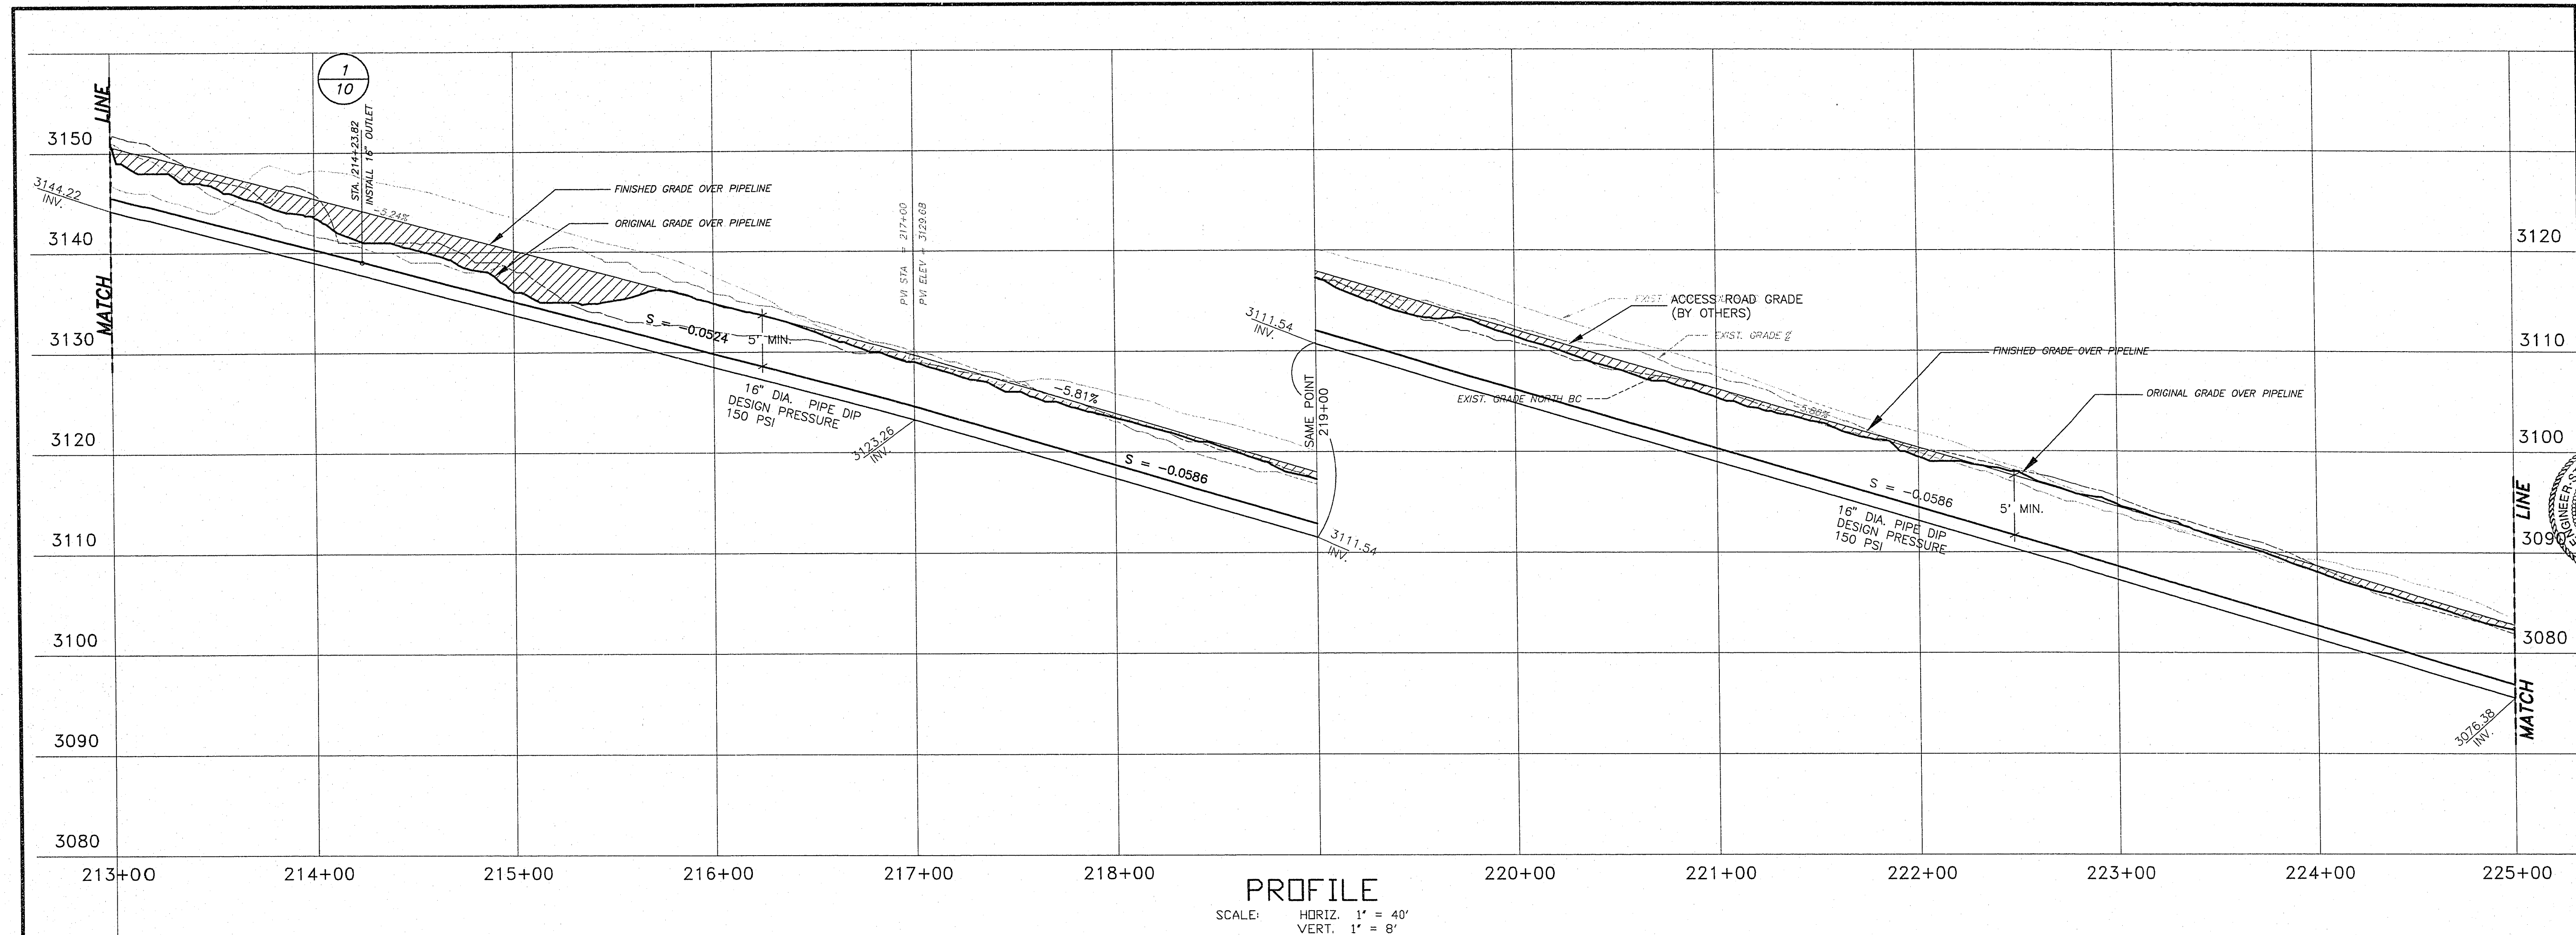

REV	DATE	DESCRIPTION	CLV	DATE
1	5-24-01	OUTLET 12" 16" DIA	1	5-24-01

ENGINEER: G.C. WALLACE, INC.
DESIGNED: HOWARD K. WALLACE
CHECKED: HOWARD K. WALLACE
IN CHARGE: HOWARD K. WALLACE
PROJECT: 1555 SOUTH RAINBOW BLVD., LAS VEGAS, NEVADA 89102

G.C. WALLACE, INC.
Engineering/Architecture

DEL WEBB COMMUNITIES, INC.
SUN CITY LAS VEGAS
PIPELINE PROFILE
STATION 213+00 TO STATION 225+00

SHEET
6
OF 14 SHEETS