



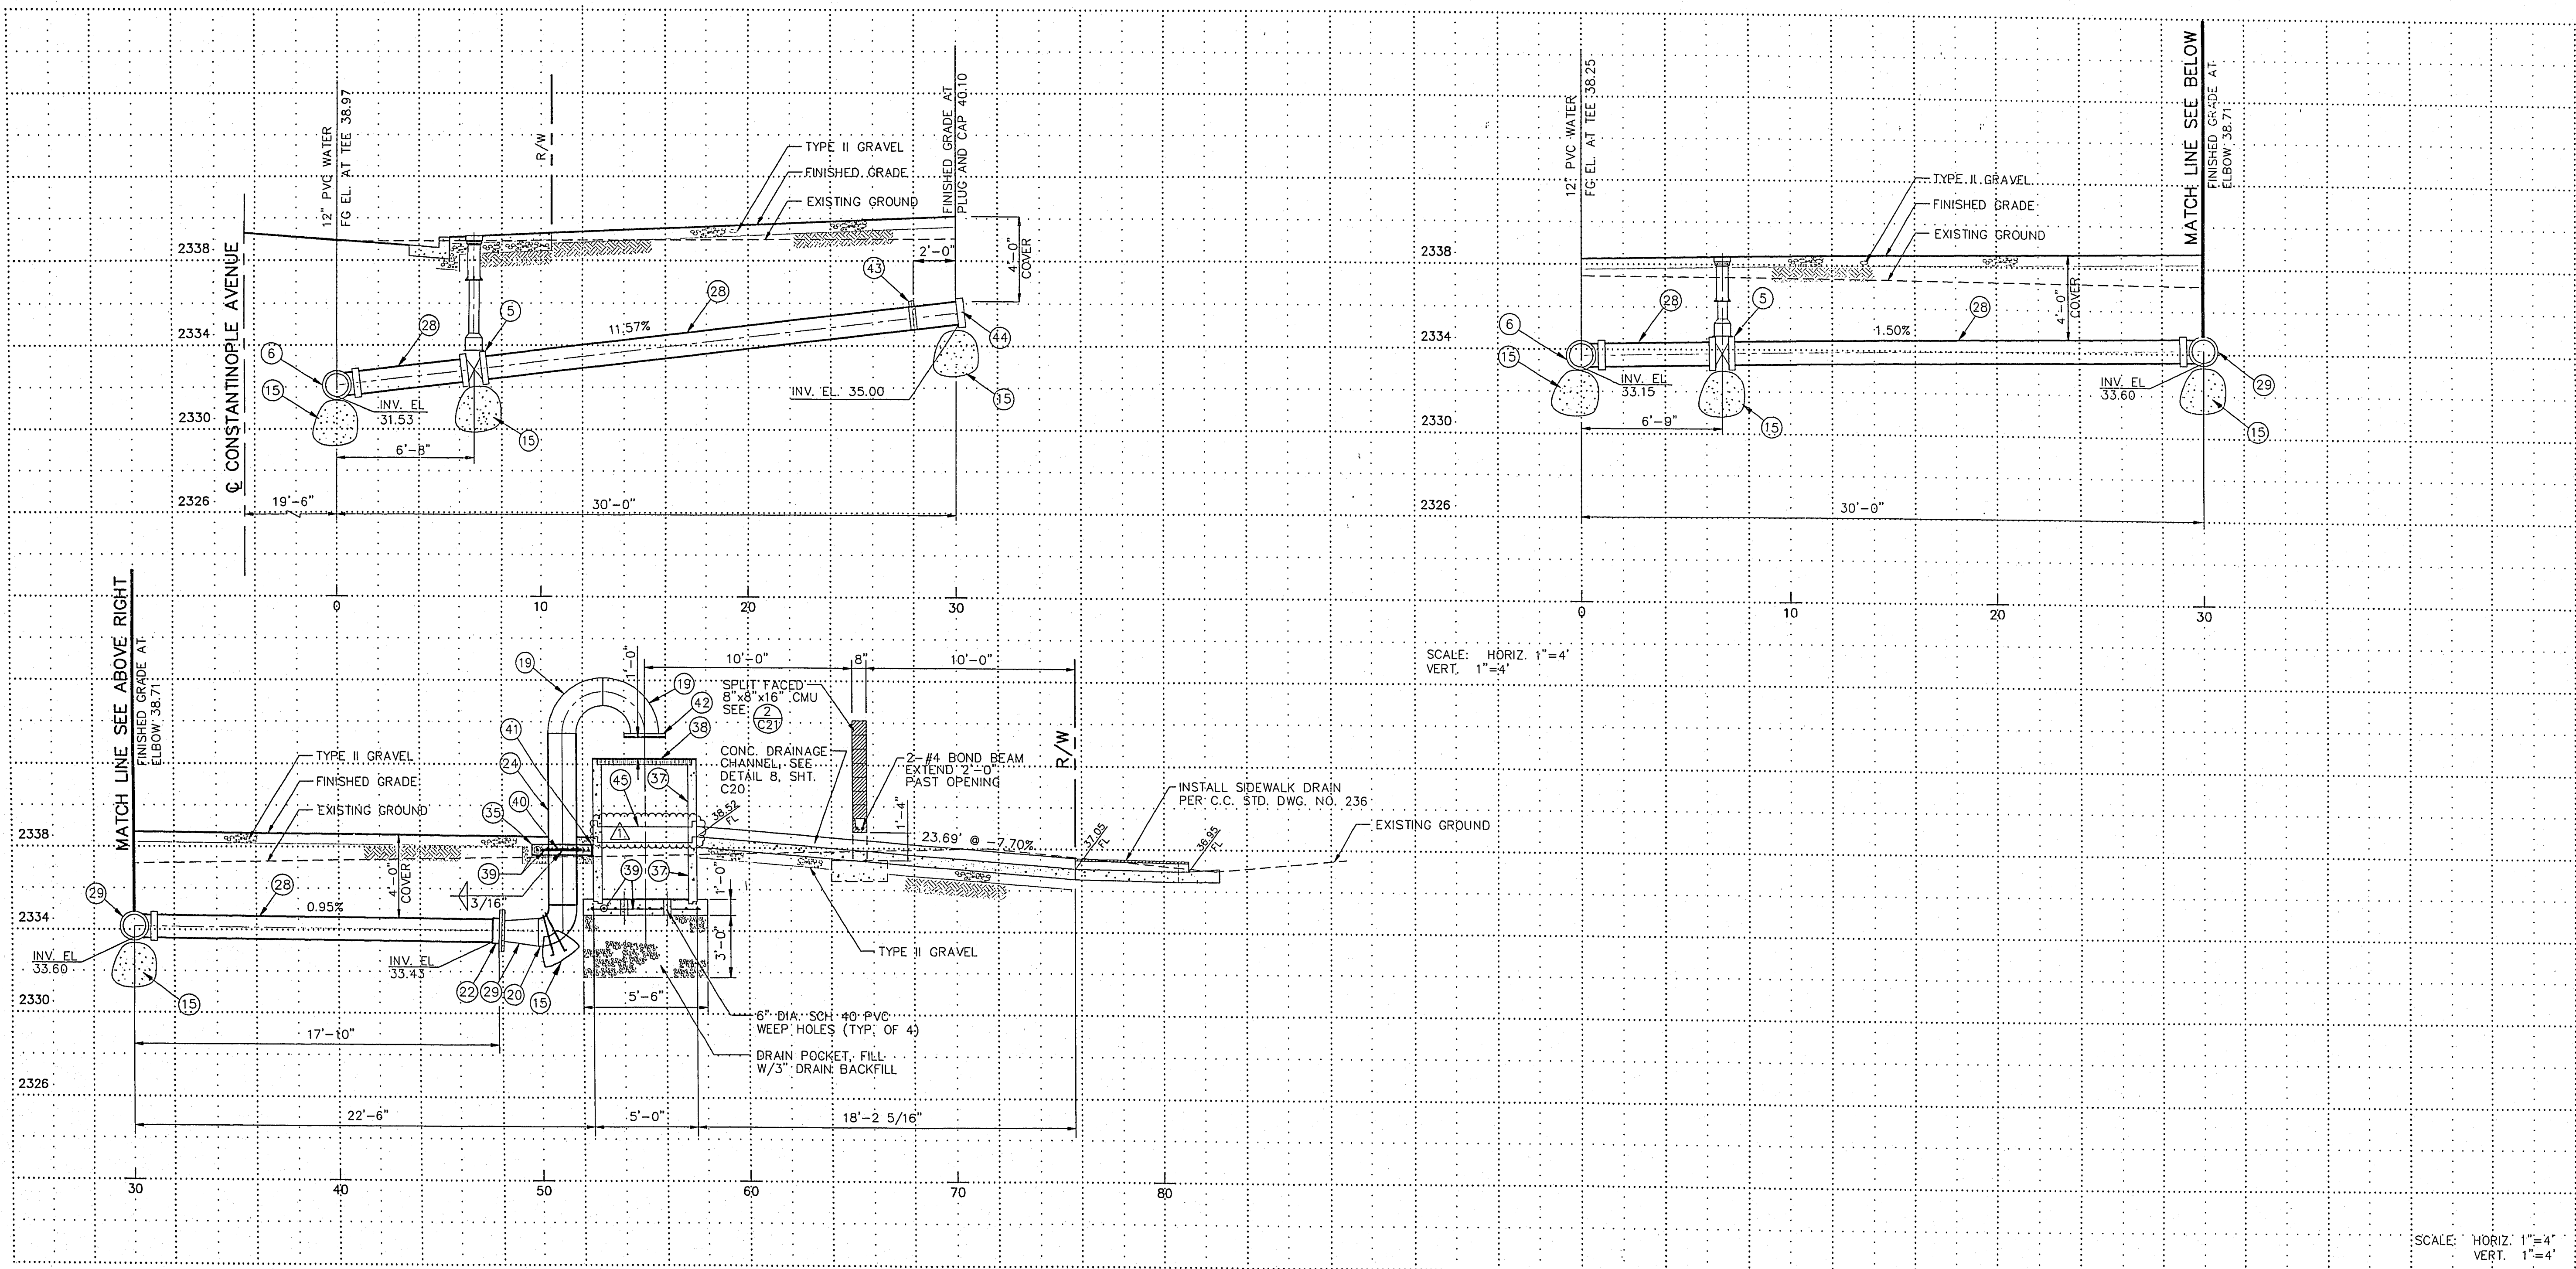

SPEC. DIV./SEC.	ITEM	DESCRIPTION	SPEC. DIV./SEC.	ITEM	DESCRIPTION
3605	5	12" PUSH-ON GATE VALVE W/ VALVE BOX (LVVWD STD. PLATE #8), AND ANCHOR BLOCK (LVVWD STD. PLATE #3)	41	41	JOINT FILLER MATERIAL
DIV. 34	6	12" O.I. PUSH-ON TEE	42	42	16" COMPANION FLANGE W/ SS INSECT SCREEN
AS NOTED	15	CONCRETE THRUST BLOCK (SEE LVVWD STD. PLATE #5)	43	43	2" MANUAL BLOW-OFF ASSEMBLY W/ VALVE BOX, SEE LVVWD STD. PLATE #4
4105	19	16" STL ML DISCHARGE ELBOW, EXTERIOR PAINTED	DIV. 34	44	12" CAP (FOR FUTURE RECHARGE LINE)
			3311	45	9" PRECAST CONCRETE 60" DIA. MANHOLE SECTION W/ 2" NOTCH CUT FOR DRAINAGE
DIV. 34	22	12" FLG X PVC ADAPTER			
DIV. 29	24	16" STEEL PIPE, MLC			
DIV. 34	26	12" BLIND FLANGE			
AS NOTED	28	12" DRAINAGE DISCHARGE LINE			
DIV. 34	29	16"x12" MLC STEEL CONCENTRIC REDUCER			
DIV. 33	35	6" THICK X 36" SQUARE CONCENTRIC COLLAR			
3311	37	3'-0" PRECAST CONCRETE 60" DIA. MANHOLE SECTION			
AS NOTED	38	TWO PIECE GRATE 66" DIA. R-8851 180° ROUND			
		NEENAH FOUNDRY CO. OR APPROVED EQUAL			
DIV. 18	39	#4 REBAR @ 9" EACH WAY			
-	40	3/8" STEEL PLATE X 24" O.D. FLANGE			

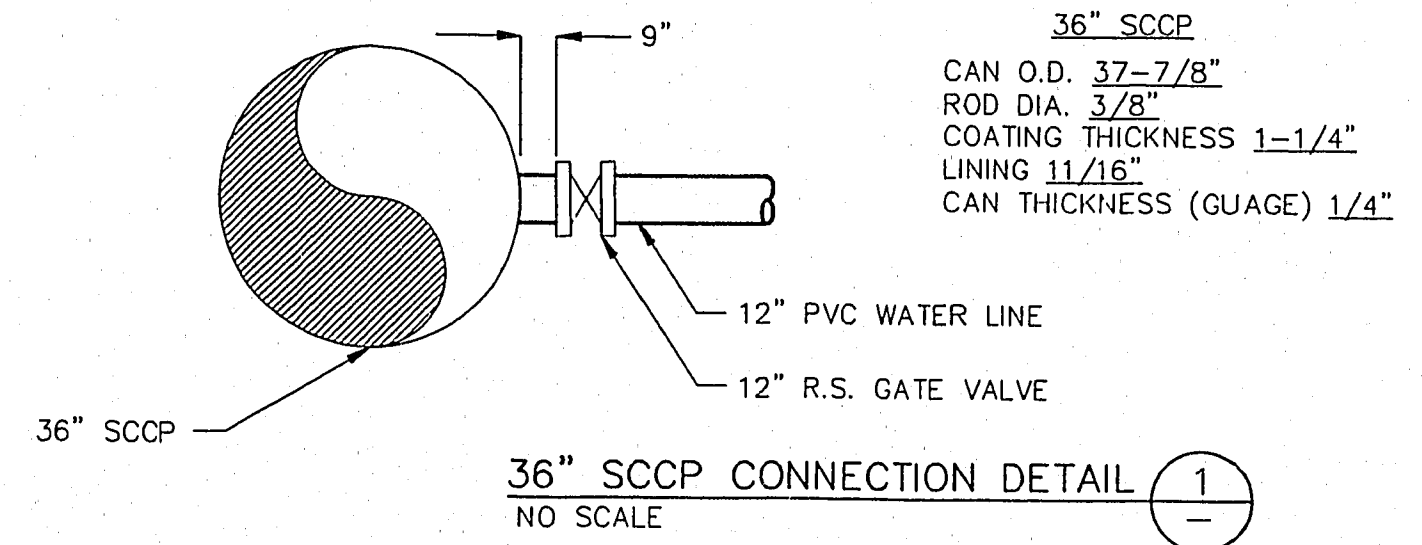

NOTE: THE MORTAR LINING OF STEEL PIPE, GROUNDING RINGS AND FLOW METER SHALL HAVE THE SAME INSIDE DIAMETER $\pm 1/32"$.

1	9" INCH SECTION ADDED	GB	1/95	W/P
REV.	DESCRIPTION	BY	DATE	CHK'D

SCALE:	FILE NO: 71494C16	DATE: 10/17/94	RECOMMENDED
AS SHOWN	DRAWN: MJD	DATE: 10/17/94	BARTON T. SMITH
	CHECKED: MHP	DATE: 10/17/94	2652
			DATE
			MARK H. PETERSON
			8838
			DATE

LAS VEGAS VALLEY WATER DISTRICT
1001 SOUTH VALLEY VIEW BOULEVARD
LAS VEGAS, NEVADA 89153

EQUIP WELL NO. 93 AND WELL NO. 94.
PUMP PIPING PROFILE,
WELL NO. 94

DRAWING NUMBER
714
REF. SHEET NO. C16
SHEET 18 OF 39