




City of Las Vegas, Nevada  
**Department of Design and Development**  
 Thomas B. Graham, AICP, RLA, Director

DESIGN BY: DRJ/CML  
 DRAWN BY: CML  
 DATE: 1/8/87

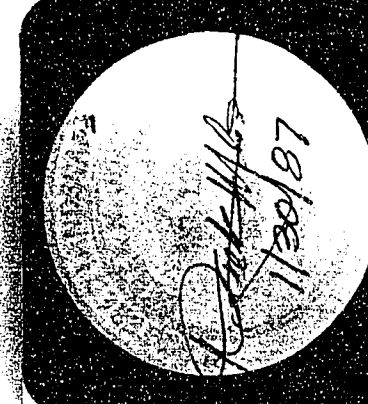

**DOWNTOWN TRANSPORTATION CENTER AMENITIES**  
 Ext. Furniture/Planter-Planting Sch. & Details


PROJECT NO. WU9040  
 DRAWING NO. 590-2F  
 SHEET 33 OF 41  
 L1

**Plant Schedule/Planter Fill Proportions/Planter Mix**

Number	Planter Size	Plant Material	Plant Size	Plant Size	Plant Size
25	2'Dia. x 22"H.	Catharanthus roseus, Madagascar Periwinkle(S)/ Antirrhinum majus, Magic Carpet-Snaps(W)	8" O.C.	67	2'Dia. x 22"H.
26	2'Dia. x 22"H.	Same as No. 25		68	2'Dia. x 22"H.
27	4'Dia. x 36"H.	Chamaerops humilis, Mediter-ranean Fan Palm/Vinca major, Periwinkle/Catharanthus roseus, Madagascar Periwinkle	15 Gal. Flats 6"O.C. Pony Pack 8"O.C.	69	3'Dia. x 22"H.
28	4'Dia. x 22"H.	Same as No. 27		70	4'Dia. x 36"H.
29	4'Dia. x 30"H.	Pittosporum tobira 'Wheeler's Dwarf, Dwf. Pittosporum	5 Gal.	71	3'Dia. x 30"H.
30	6'Dia. x 36"H.	Same as No. 27		72	6'Dia. x 30"H.
31	3'Dia. x 30"H.	Same as No. 25		73	3'Dia. x 30"H.
32	3'Dia. x 22"H.	Lantana montevidensis, Trail-ing Lantana	1 Gal.	74	4'Dia. x 36"H.
33	2'Dia. x 22"H.	Same as No. 32		75	4'Dia. x 22"H.
34	2'Dia. x 22"H.	Same as No. 32		76	2'Dia. x 22"H.
35	4'Dia. x 36"H.	Same as No. 29		77	4'Dia. x 36"H.
36	2'Dia. x 22"H.	Same as No. 32		78	2'Dia. x 22"H.
37	4'Dia. x 36"H.	Same as No. 29		79	2'Dia. x 22"H.
38	2'Dia. x 22"H.	Same as No. 32		80	6'Dia. x 22"H.
43	3'Dia. x 30"H.	Same as No. 41		85	4'Dia. x 30"H.
44	3'Dia. x 22"H.	Same as No. 41		86	2'Dia. x 22"H.
45	6'Dia. x 36"H.	Same as No. 27		87	6'Dia. x 22"H.
46	4'Dia. x 30"H.	Same as No. 39		88	4'Dia. x 22"H.
47	3'Dia. x 22"H.	Same as No. 41		89	4'Dia. x 30"H.
48	6'Dia. x 36"H.	Same as No. 27		90	6'Dia. x 36"H.
49	6'Dia. x 30"H.	Chamaerops excelsa, Windmill Palm, Vinca major, Periwinkle/Catharanthus roseus, Madagasc-car Periwinkle(S)	15 Gal. Flats 6"O.C. Pony Pack 8"O.C.	91	4'Dia. x 30"H.
50	6'Dia. x 36"H.	Same as No. 49(except palm)	24" Box	92	4'Dia. x 30"H.
51	3'Dia. x 22"H.	Same as No. 40		93	4'Dia. x 30"H.
53	3'Dia. x 22"H.	Same as No. 40		95	2'Dia. x 22"H.
54	3'Dia. x 22"H.	Same as No. 40		96	2'Dia. x 22"H.
55	4'Dia. x 30"H.	Same as No. 39		97	2'Dia. x 22"H.
56	2'Dia. x 22"H.	Same as No. 41		98	3'Dia. x 22"H.
57	2'Dia. x 22"H.	Same as No. 41		99	2'Dia. x 22"H.
58	2'Dia. x 30"H.	Same as No. 27		100	2'Dia. x 22"H.
59	6'Dia. x 30"H.	Same as No. 27		101	4'Dia. x 30"H.
60	3'Dia. x 22"H.	Same as No. 40		102	2'Dia. x 22"H.
61	3'Dia. x 30"H.	Nerium oleander 'Petite Pink', Dwf. Oleander	5 Gal.	103	2'Dia. x 22"H.
62	4'Dia. x 36"H.	Same as No. 29		104	2'Dia. x 22"H.
63	3'Dia. x 30"H.	Same as No. 61		105	2'Dia. x 22"H.
64	2'Dia. x 22"H.	Tagetes patula, French Mari-golds(S)/Viola cornuta, Tuft-ed Pansy(W)	Pony Pack 8"O.C.	106	2'Dia. x 22"H.
65	3'Dia. x 22"H.	Same as No. 64		107	2'Dia. x 22"H.
66	3'Dia. x 30"H.	Same as No. 64		108	2'Dia. x 22"H.

NOTE: Summer annuals (S)  
 Winter annuals (W)  
 \*Exterior Planter numbers from 25-108\*

**Planter Fill Proportions**

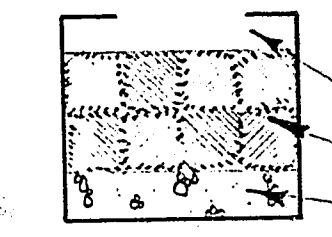


Height of Planter	A	B	C
22"	2"	16"	4"
30"	3"	23"	4"
36"	3"	29"	4"

Material	Proportion
Silt Fill	3 Parts
Organic Soil Amendment (Kalbab Mulch)	2 Parts

NOTE:  
 1. PROVIDE (3) 3/4" HOLES IN EA. PLANTER.  
 2. PLANTS TO BE SEASONAL  
 3. PLACE 4" OF CHARCOAL IN EACH PLANTER.  
 4. PLACE WIRE MESH OVER EACH DRAIN HOLE ON INSIDE OF PLANTER, SUCH THAT SOIL WILL BE CONTAINED IN PLANTER.

NOTE:  
 ALL WORK THIS SHEET  
 BID GROUP #3,  
 BASE BID

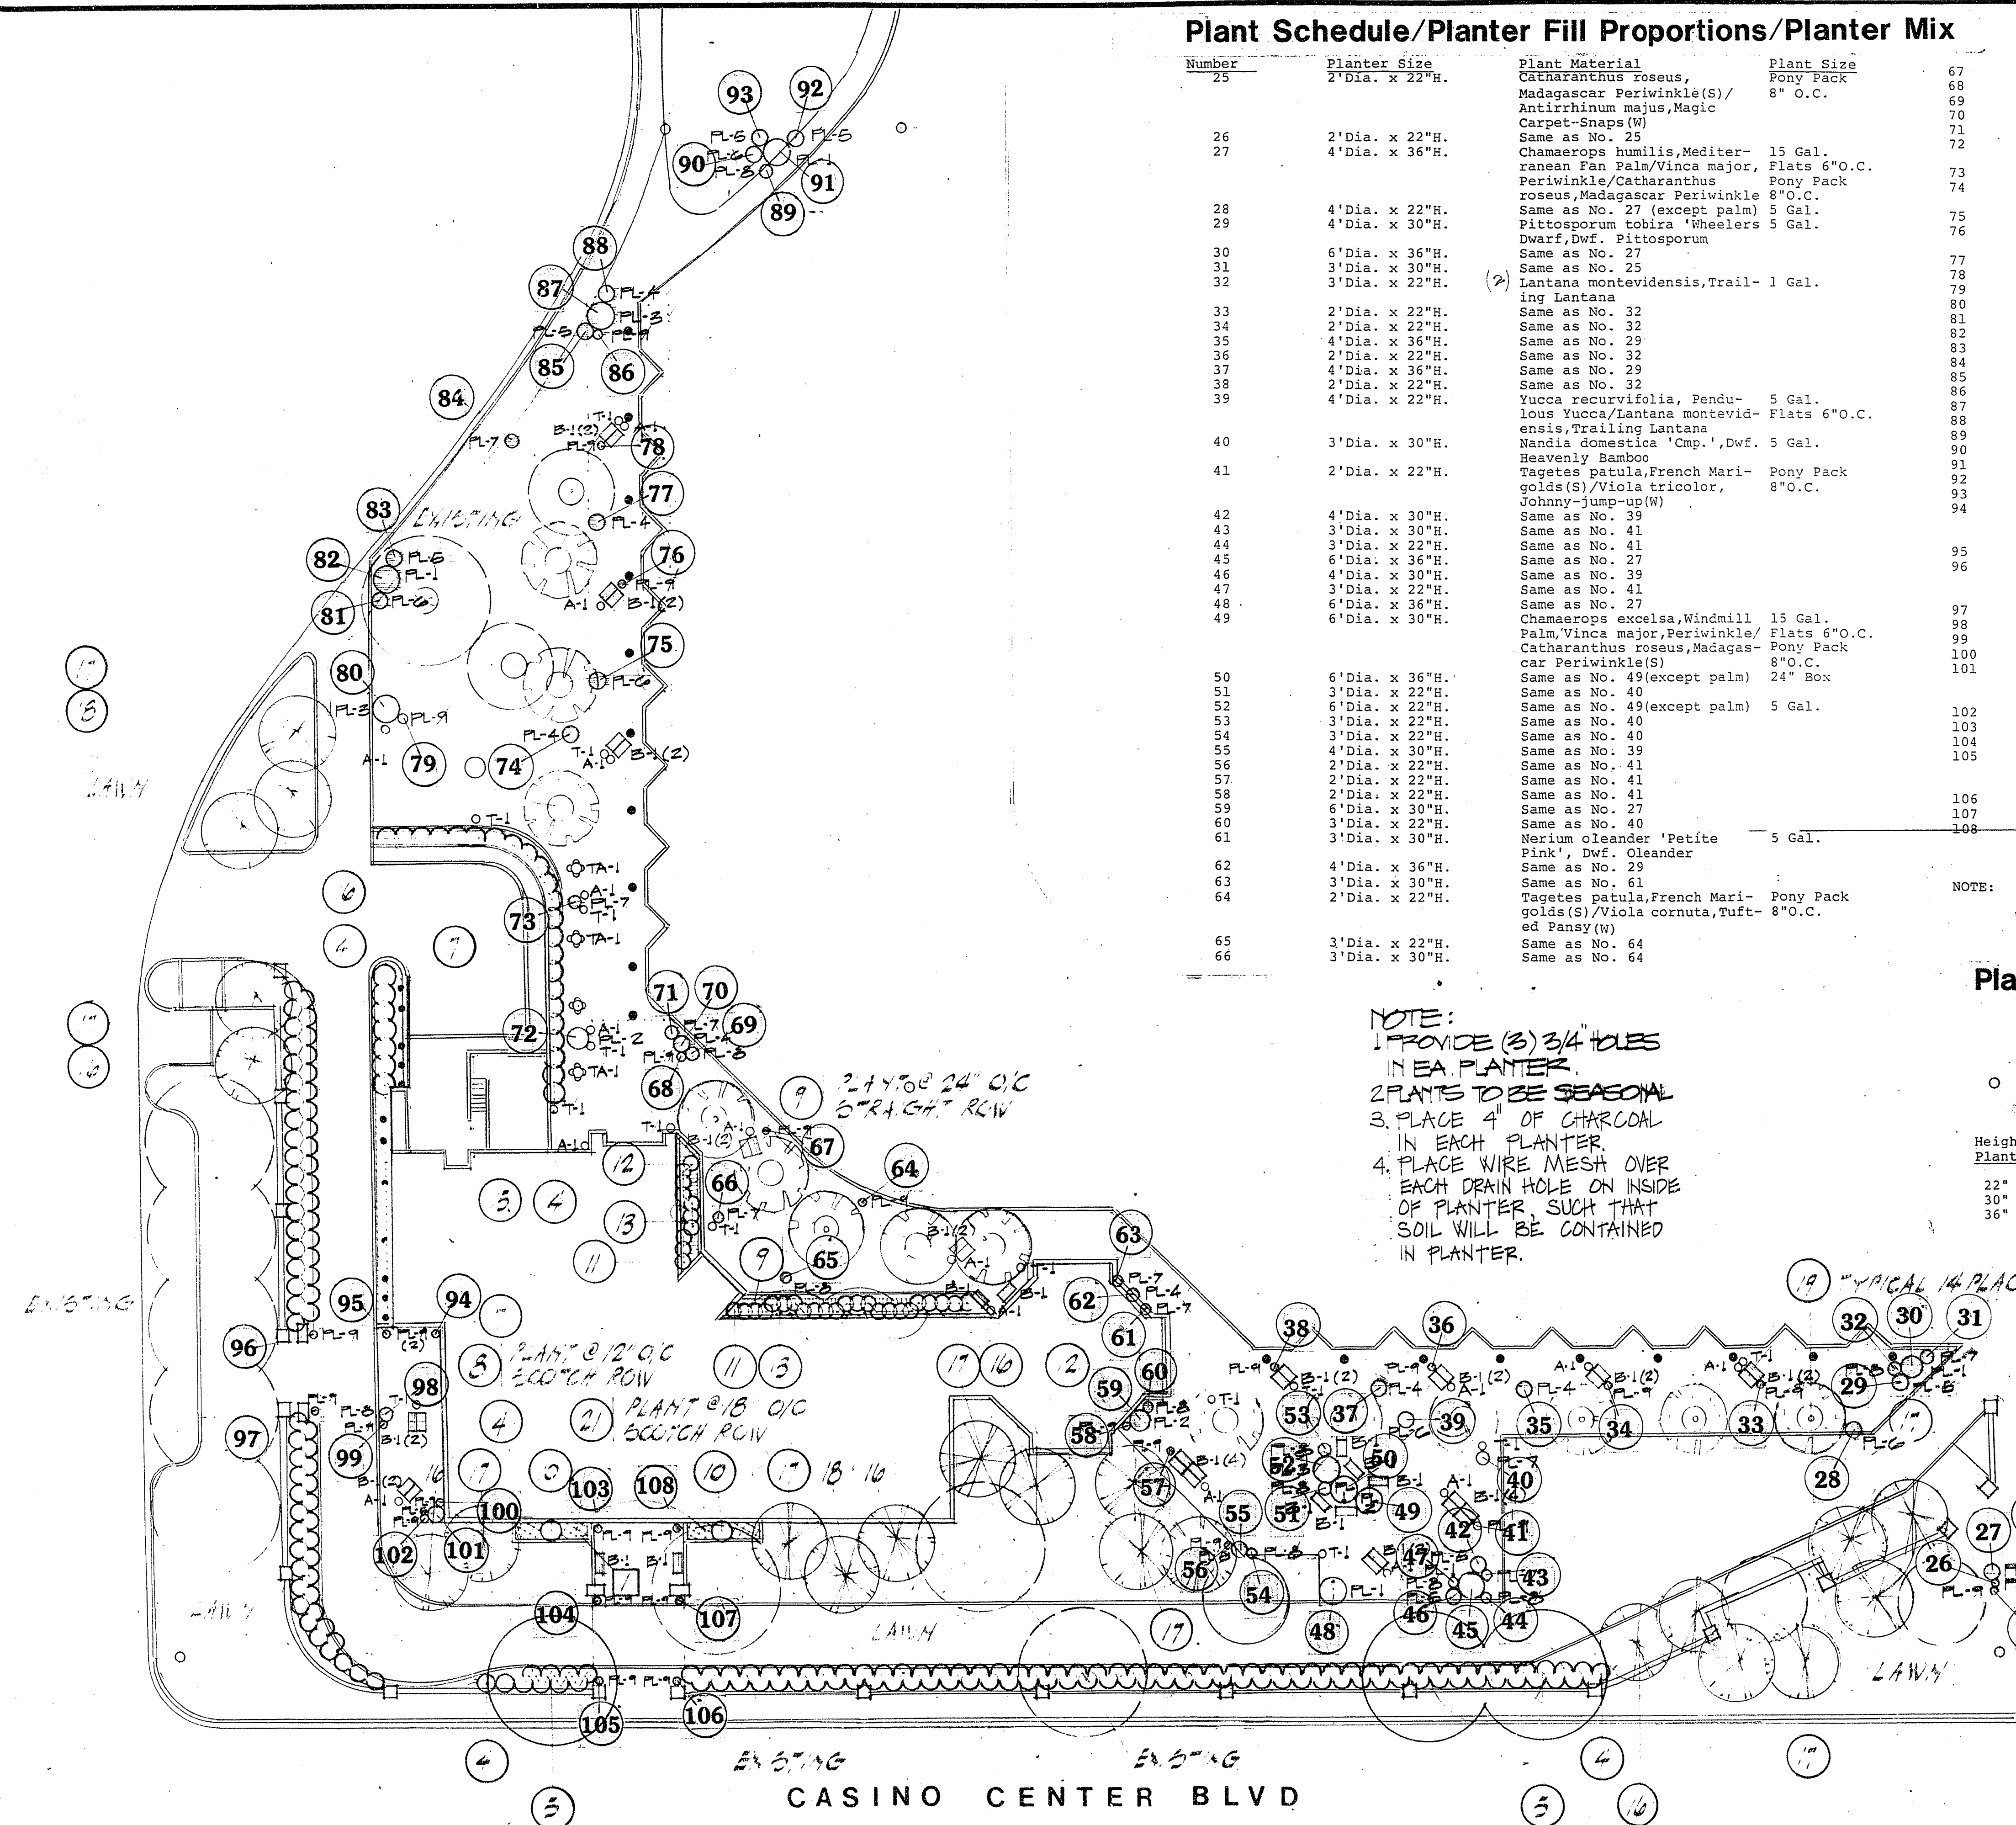

**LANDSCAPE / SITE FURNITURE / EXTERIOR PLANTERS**

SCALE 1" = 20'