



REVISIONS
4-48-00: right revision to wall

CONSULTANT
1100 GRIER DRIVE
LAS VEGAS, NEVADA 89119
PHONE (702) 361-9050
FAX (702) 361-0659
Stantec

ELKHORN & DURANGO PARK - PHASE 2

DEPARTMENT OF PUBLIC WORKS
ARCHITECTURAL SERVICES

400 EAST INTERSTATE AVENUE
LAS VEGAS, NEVADA 89101
PHONE: (702) 229-8535
FAX: (702) 382-3232
TDD: (702) 386-9108

PROJECT MANAGER
CLAIR LEWIS, ASLA

DRAWN
CLR

FILE
8/22/04

DATE
4/00

SCALE
SEE DETAIL


PROJECT
ELKHORN & DURANGO PARK, PHASE 2

SHEET NO
SD-4


DATE
SHEET 29 OF 44

DEPARTMENT OF PUBLIC WORKS

SITE DETAILS

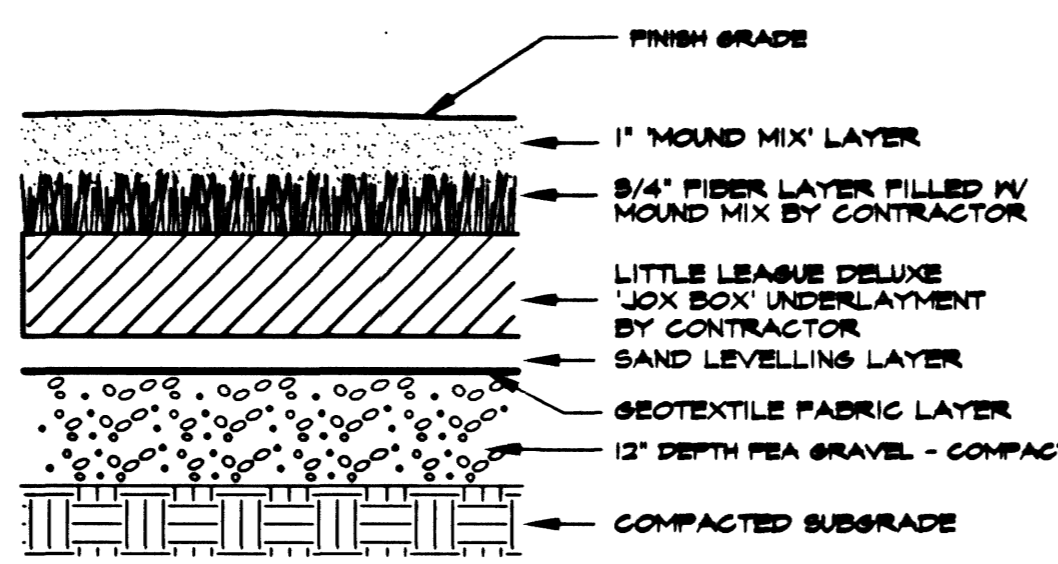


SECTION 'A'

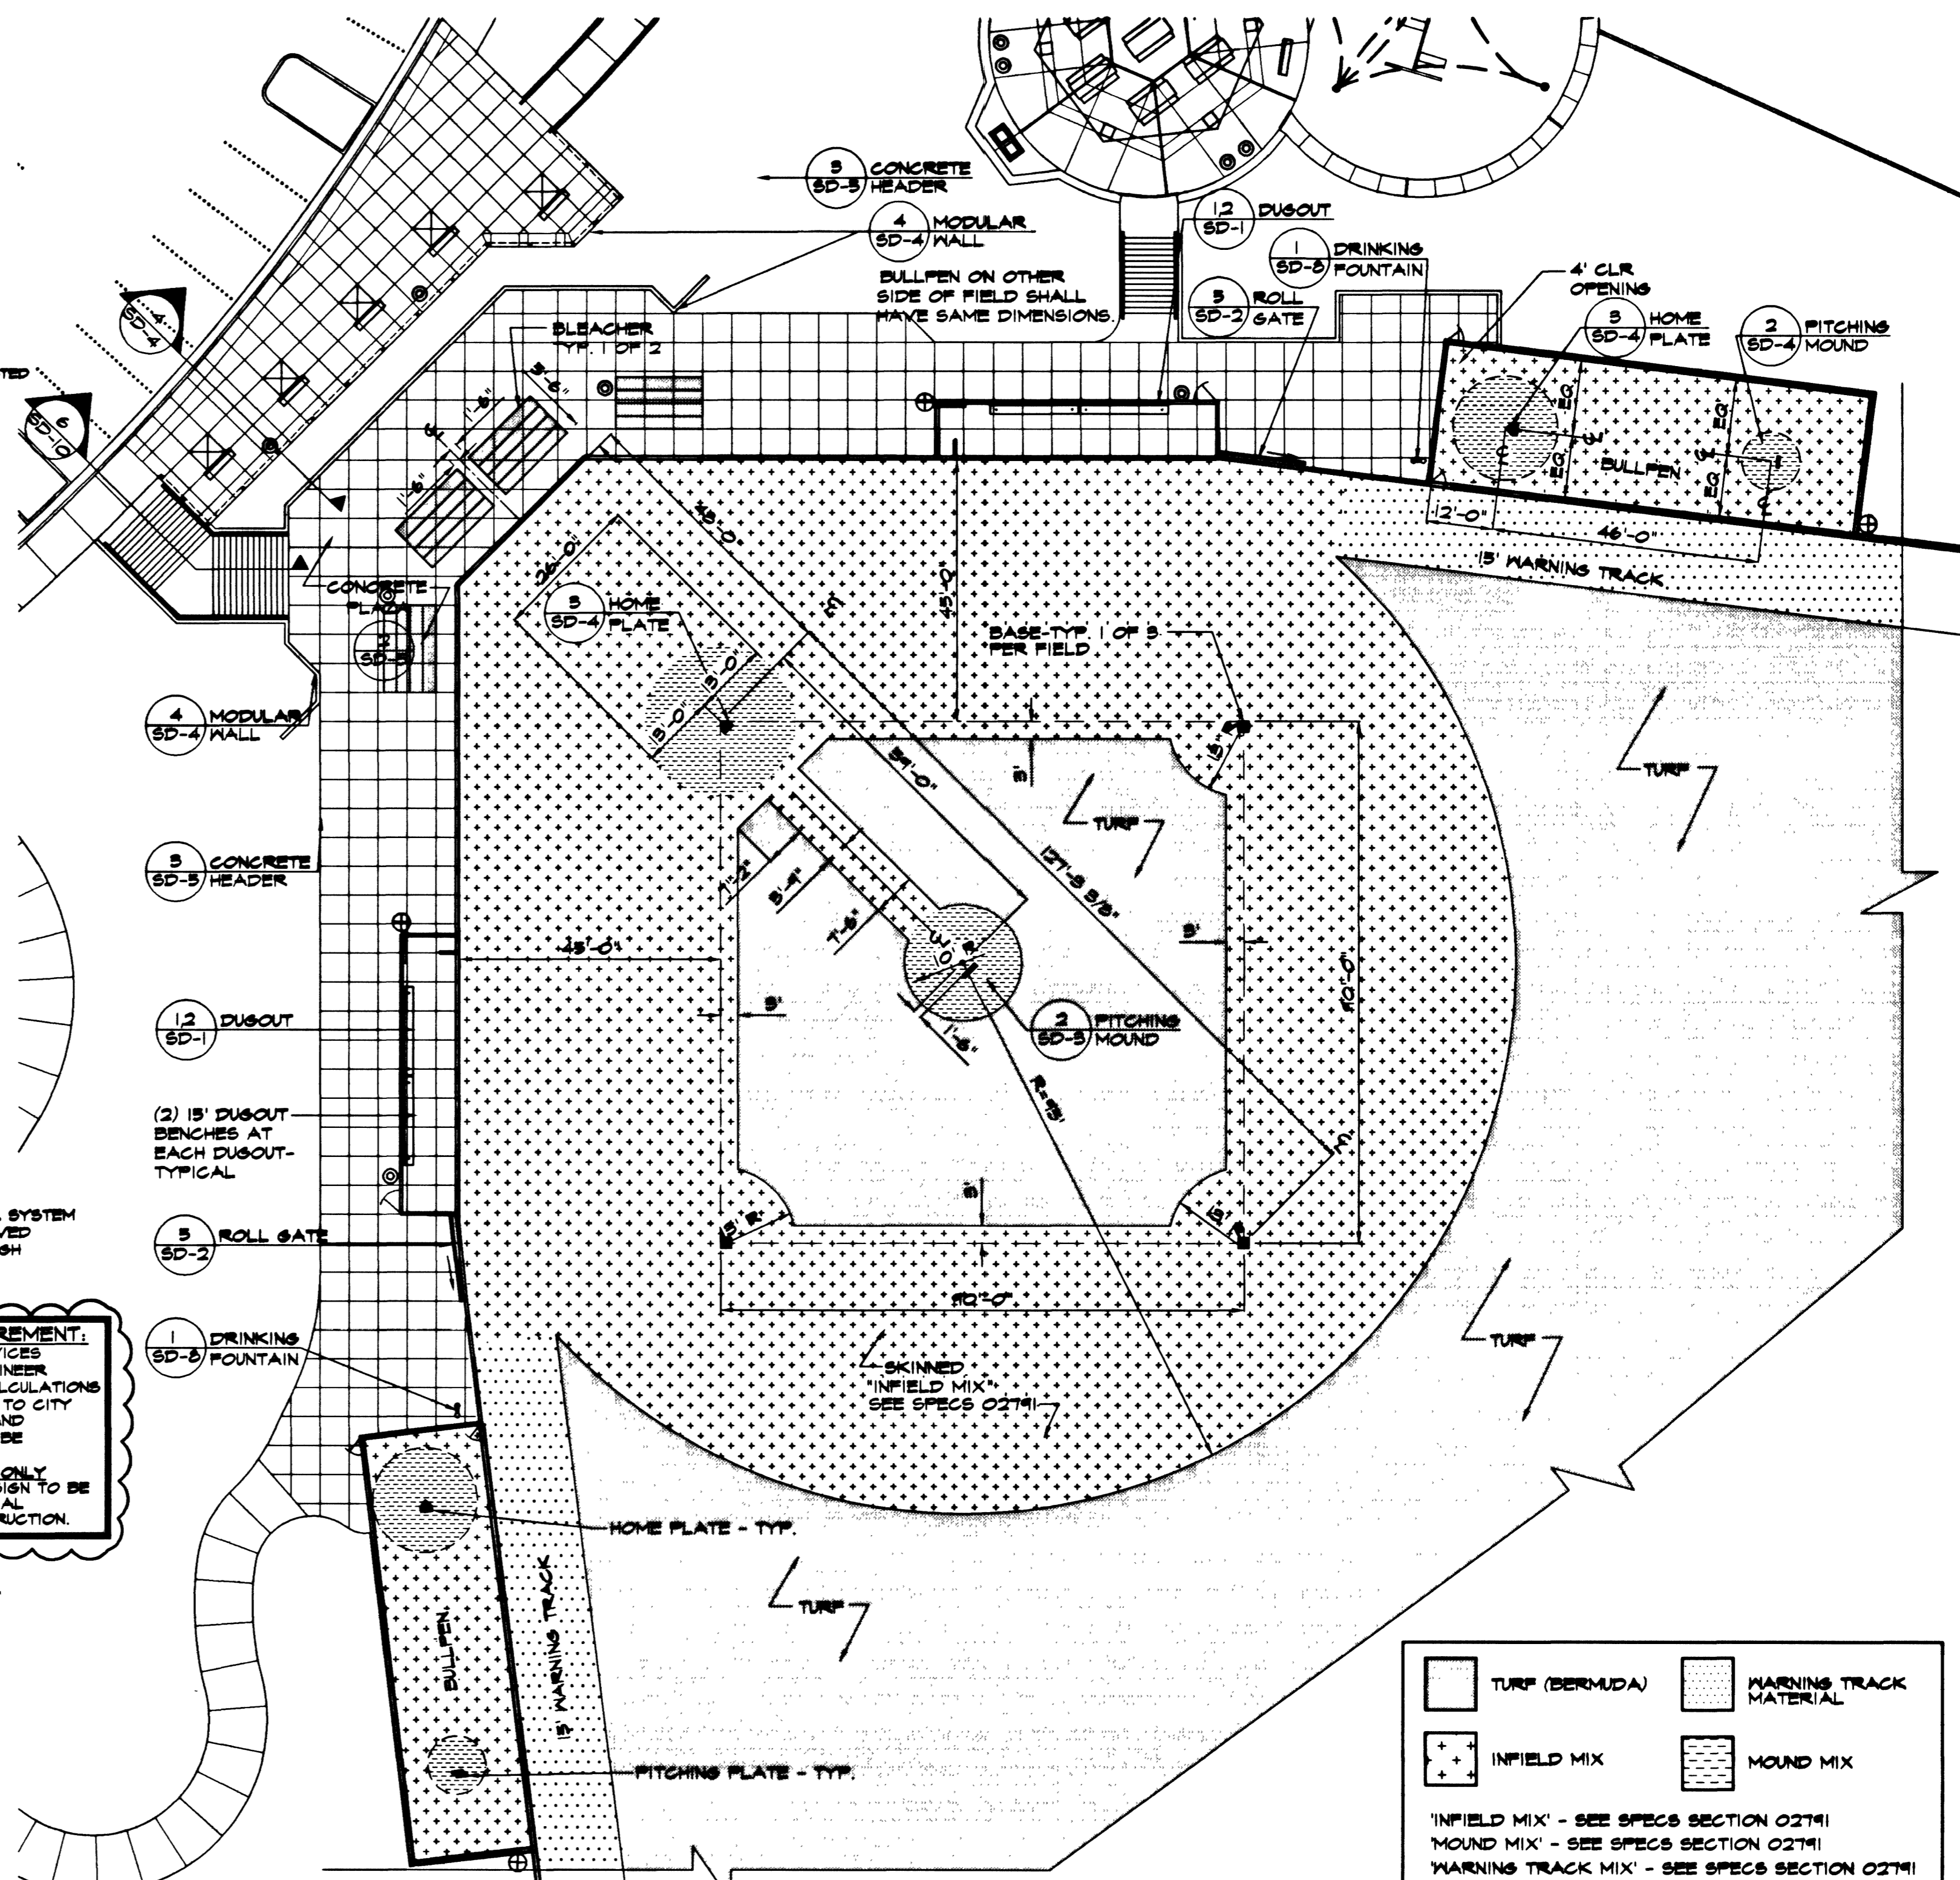


1 BASEBALL INFELD LAYOUT/PLAZA PLAN

SCALE 1"=20'-0"


3 BASEBALL HOME PLATE

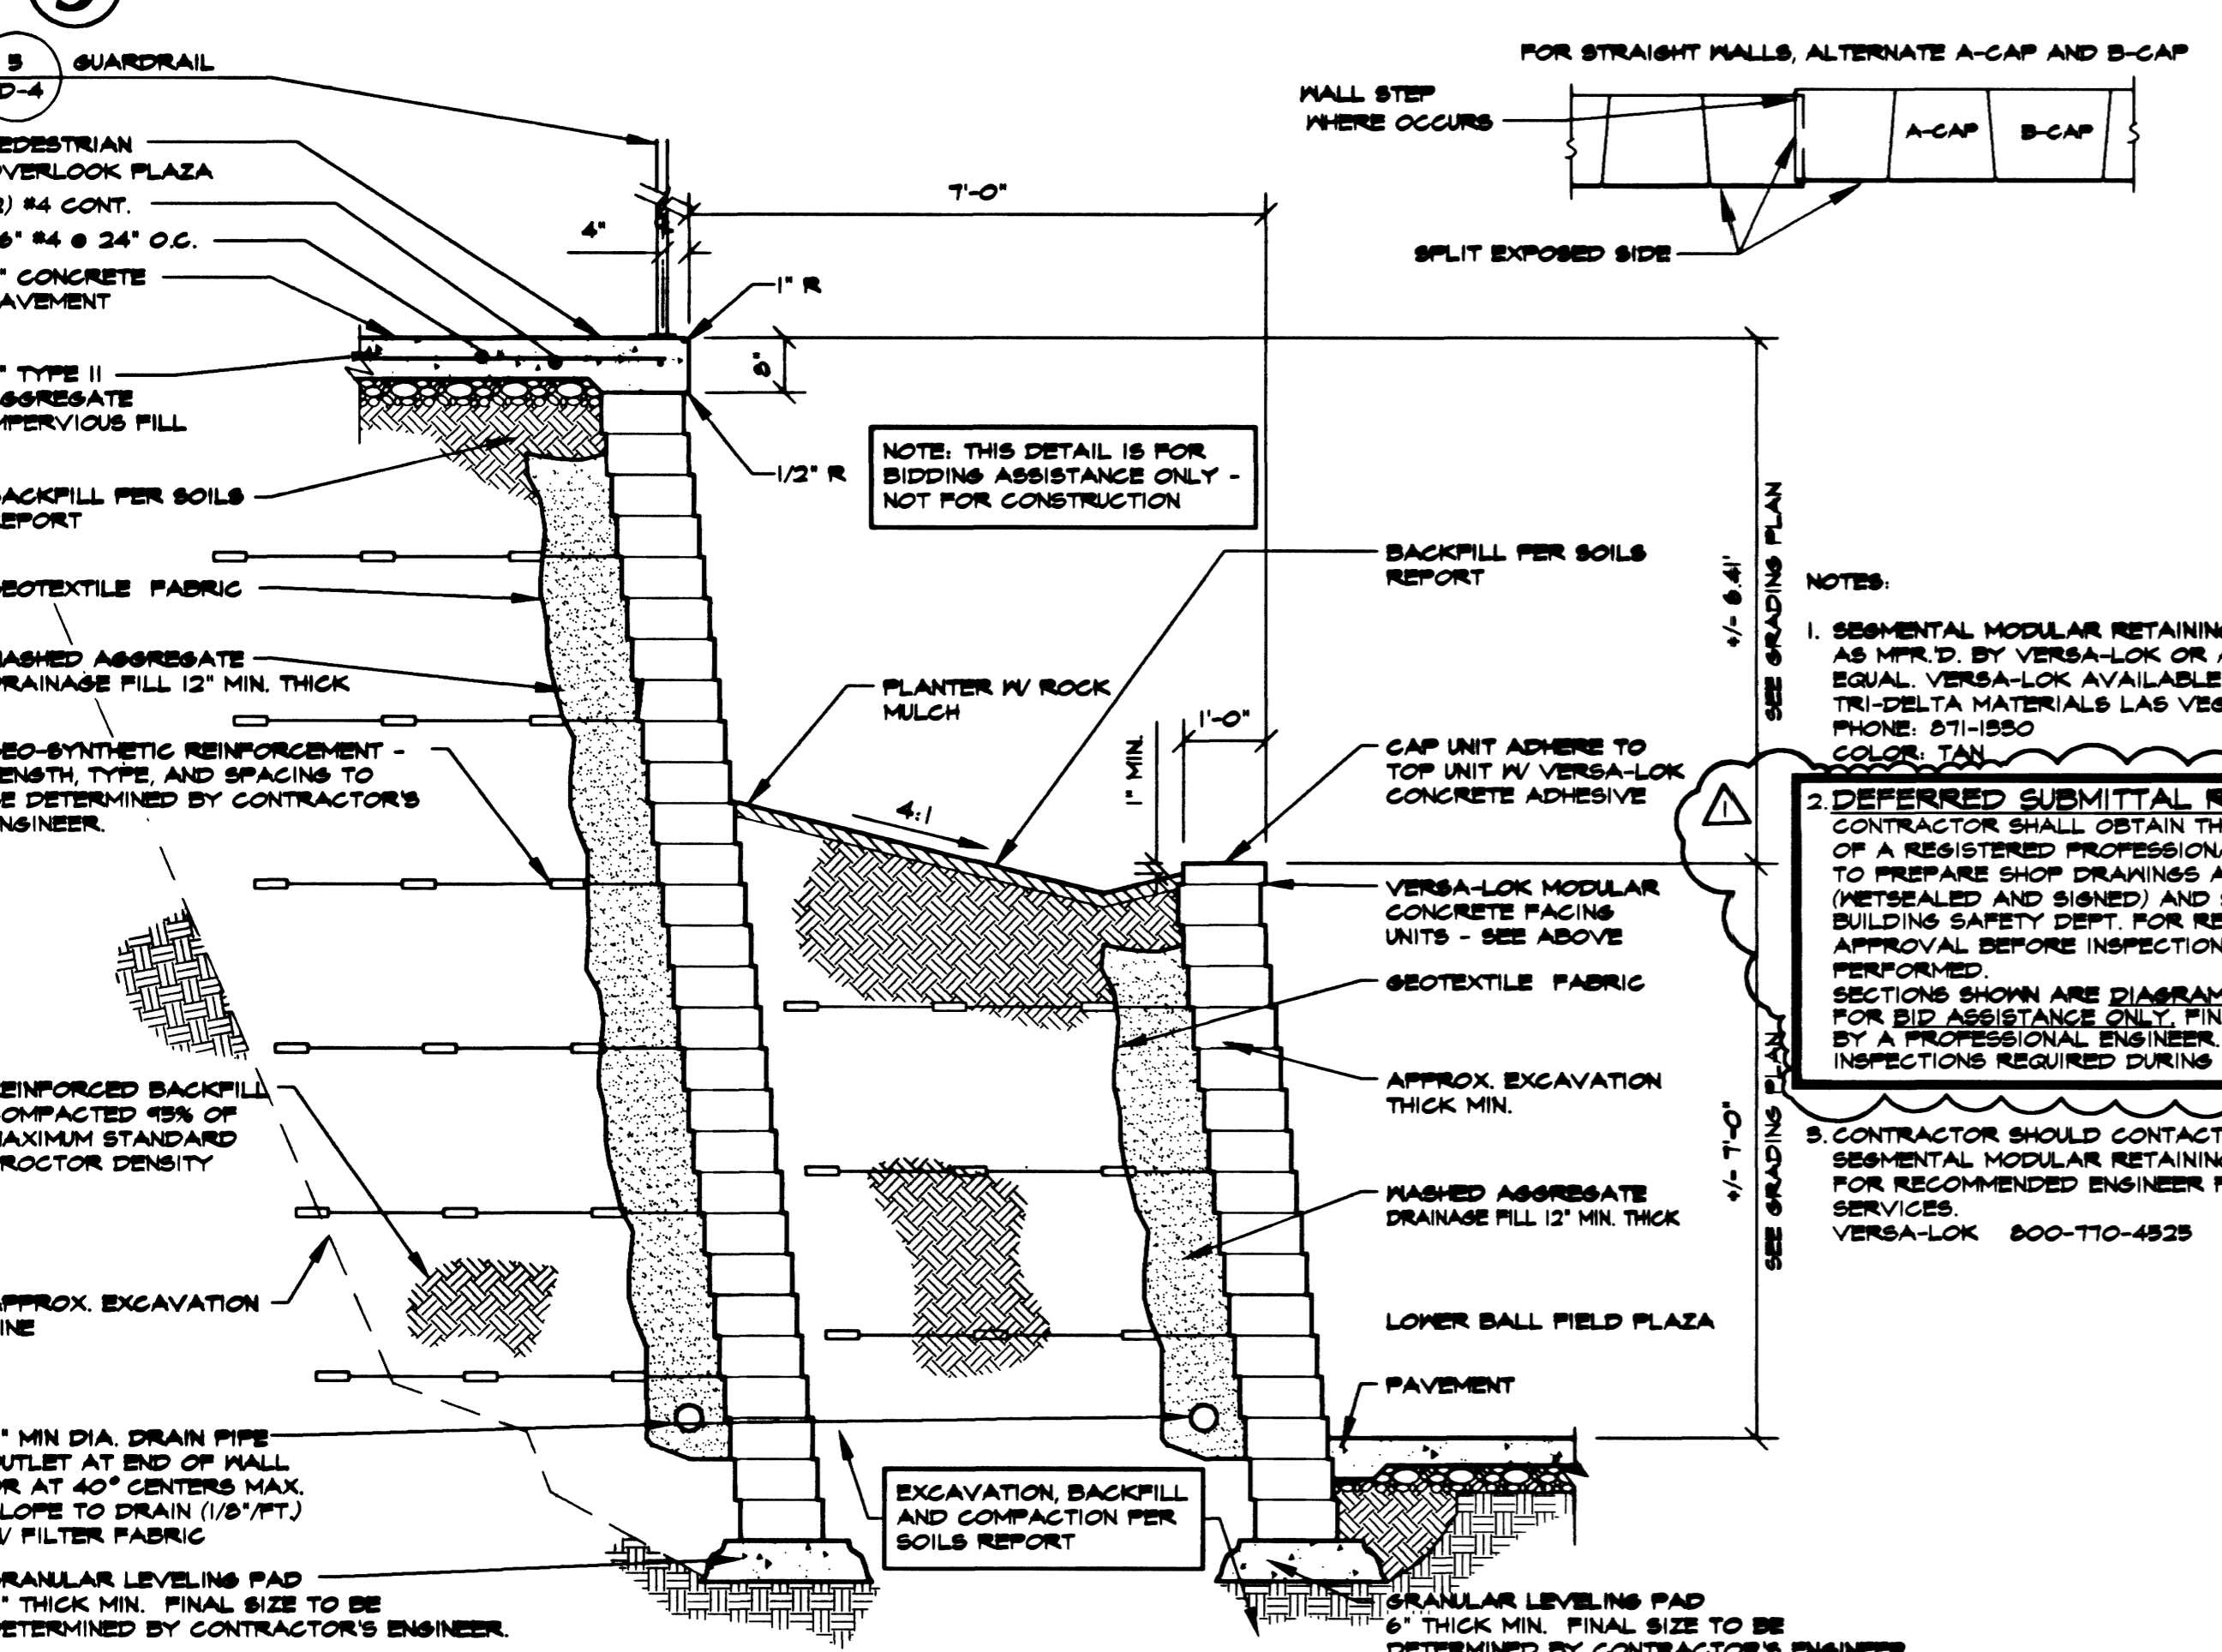


4 MODULAR WALLS @ BASEBALL FIELD PLAZA

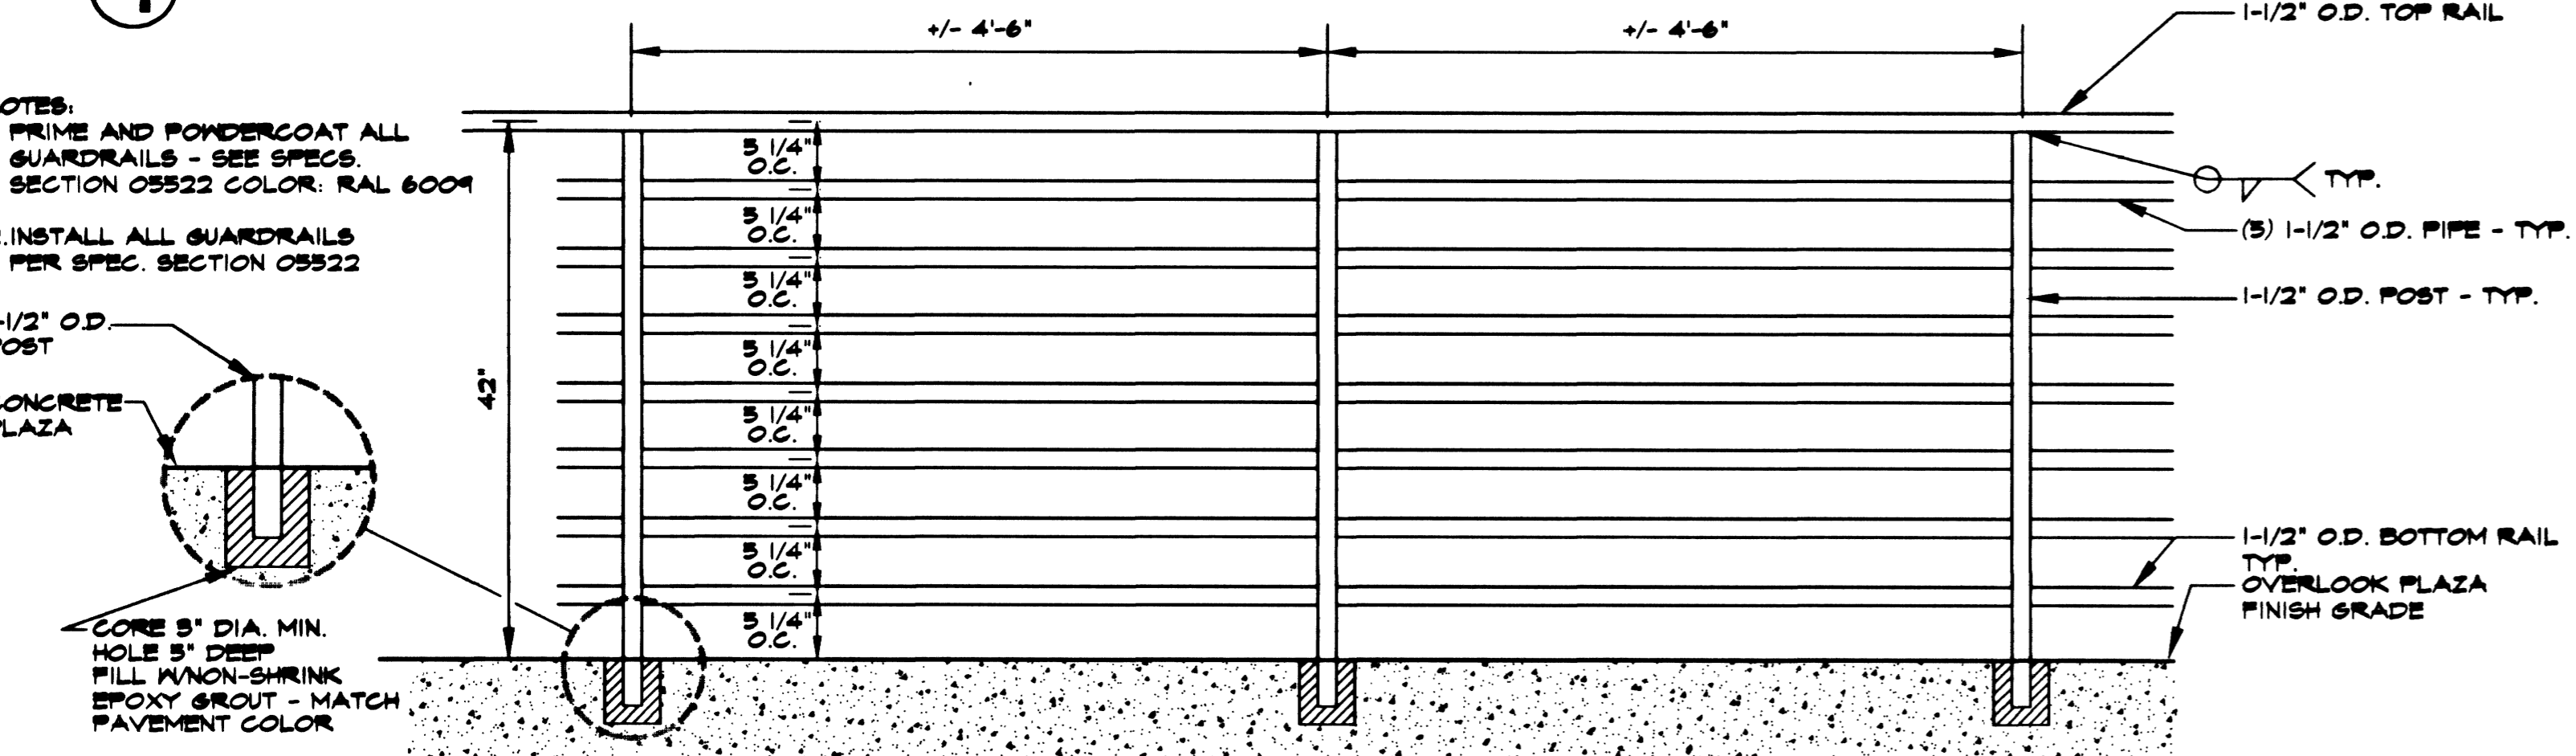

5 42\"/>

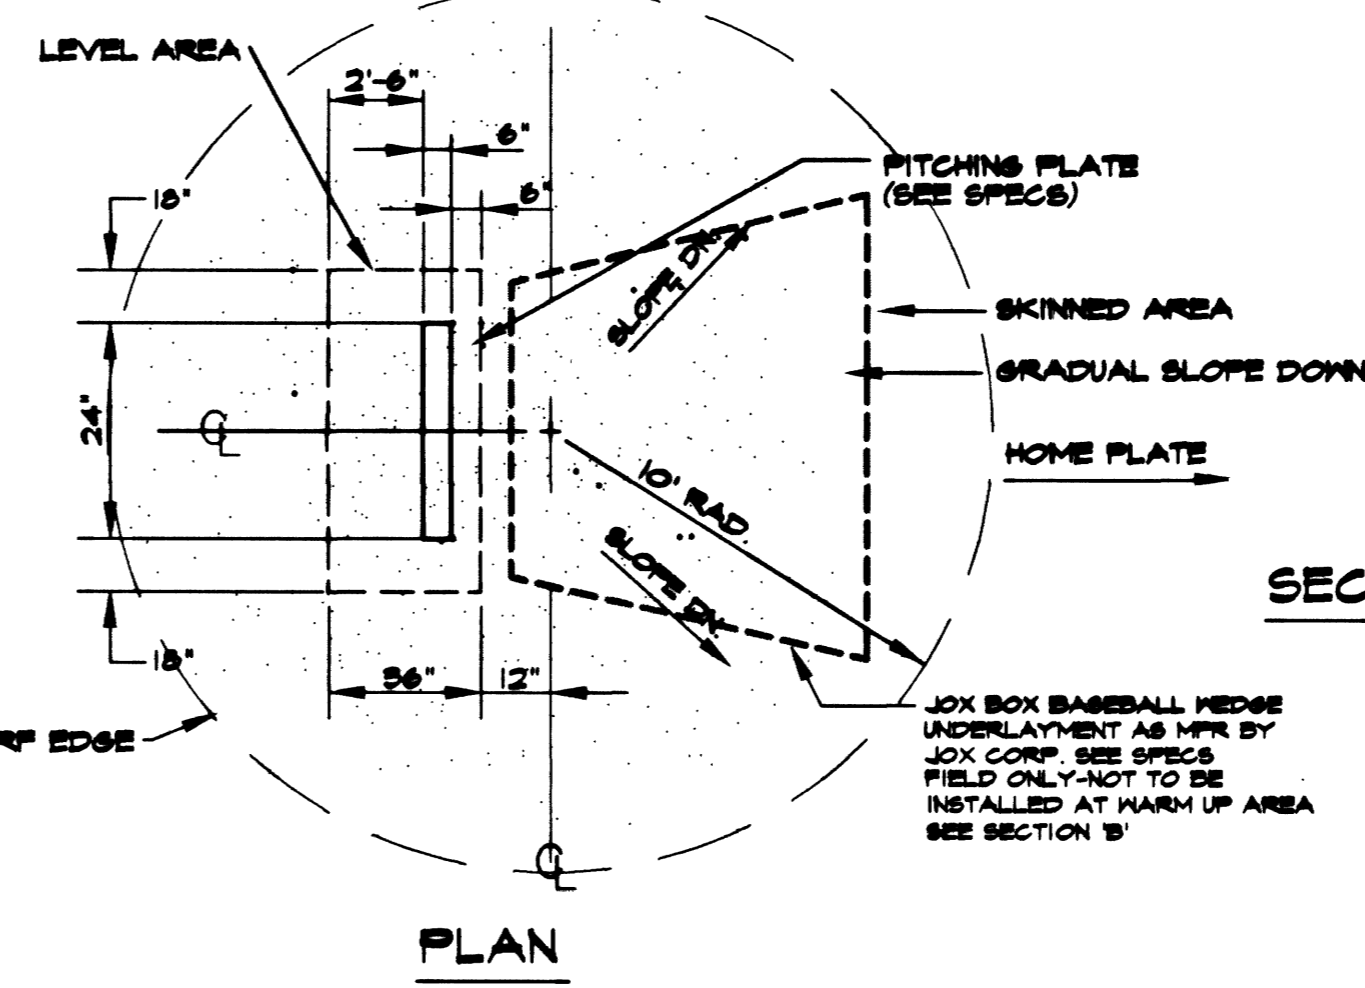

2 BASEBALL PITCHING MOUND

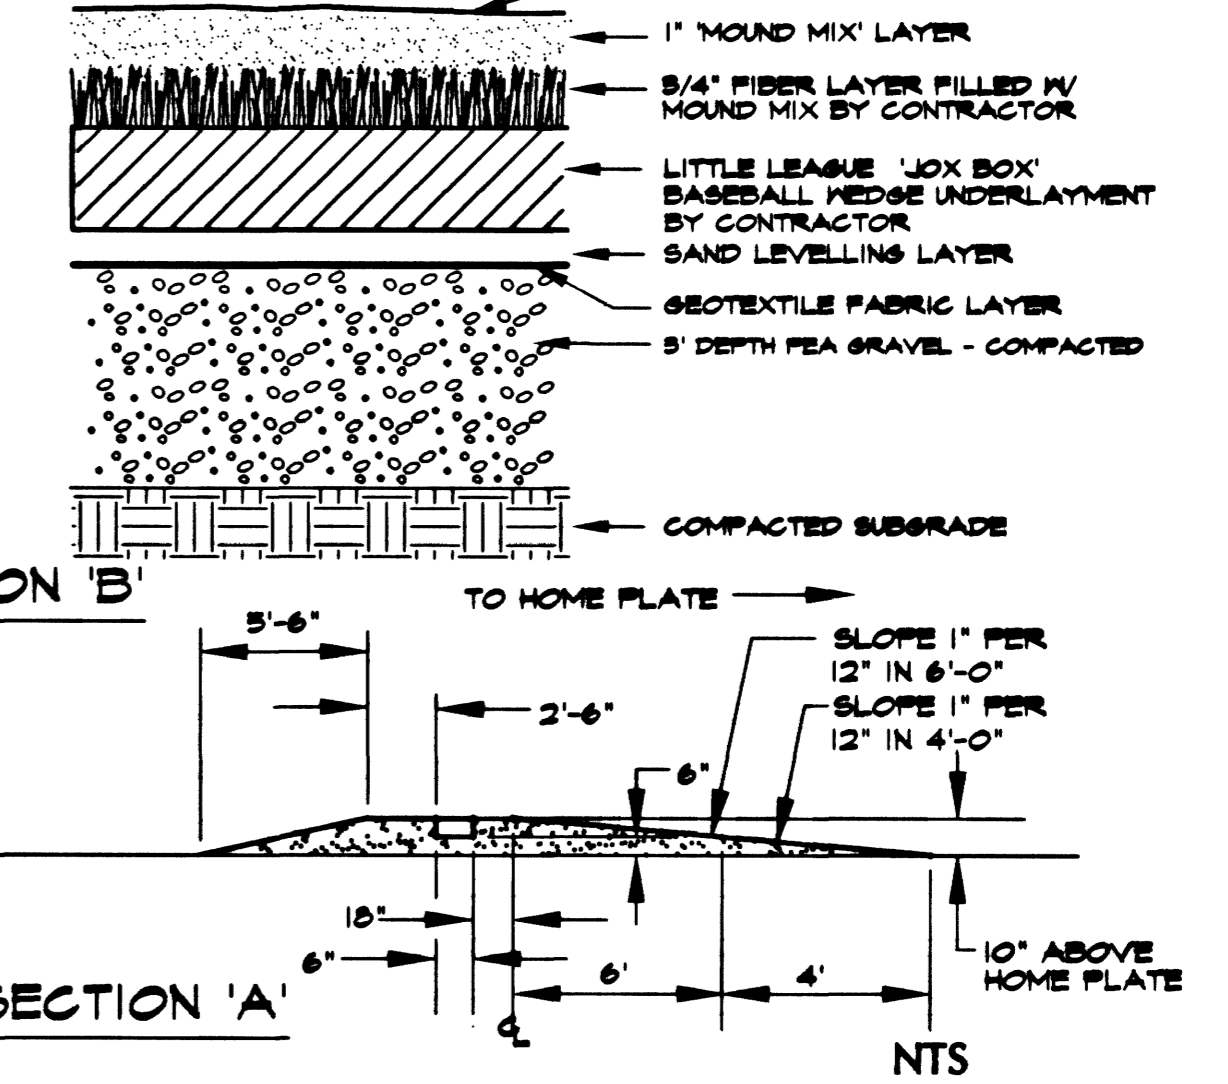

SECTION 'A'

SECTION 'B'