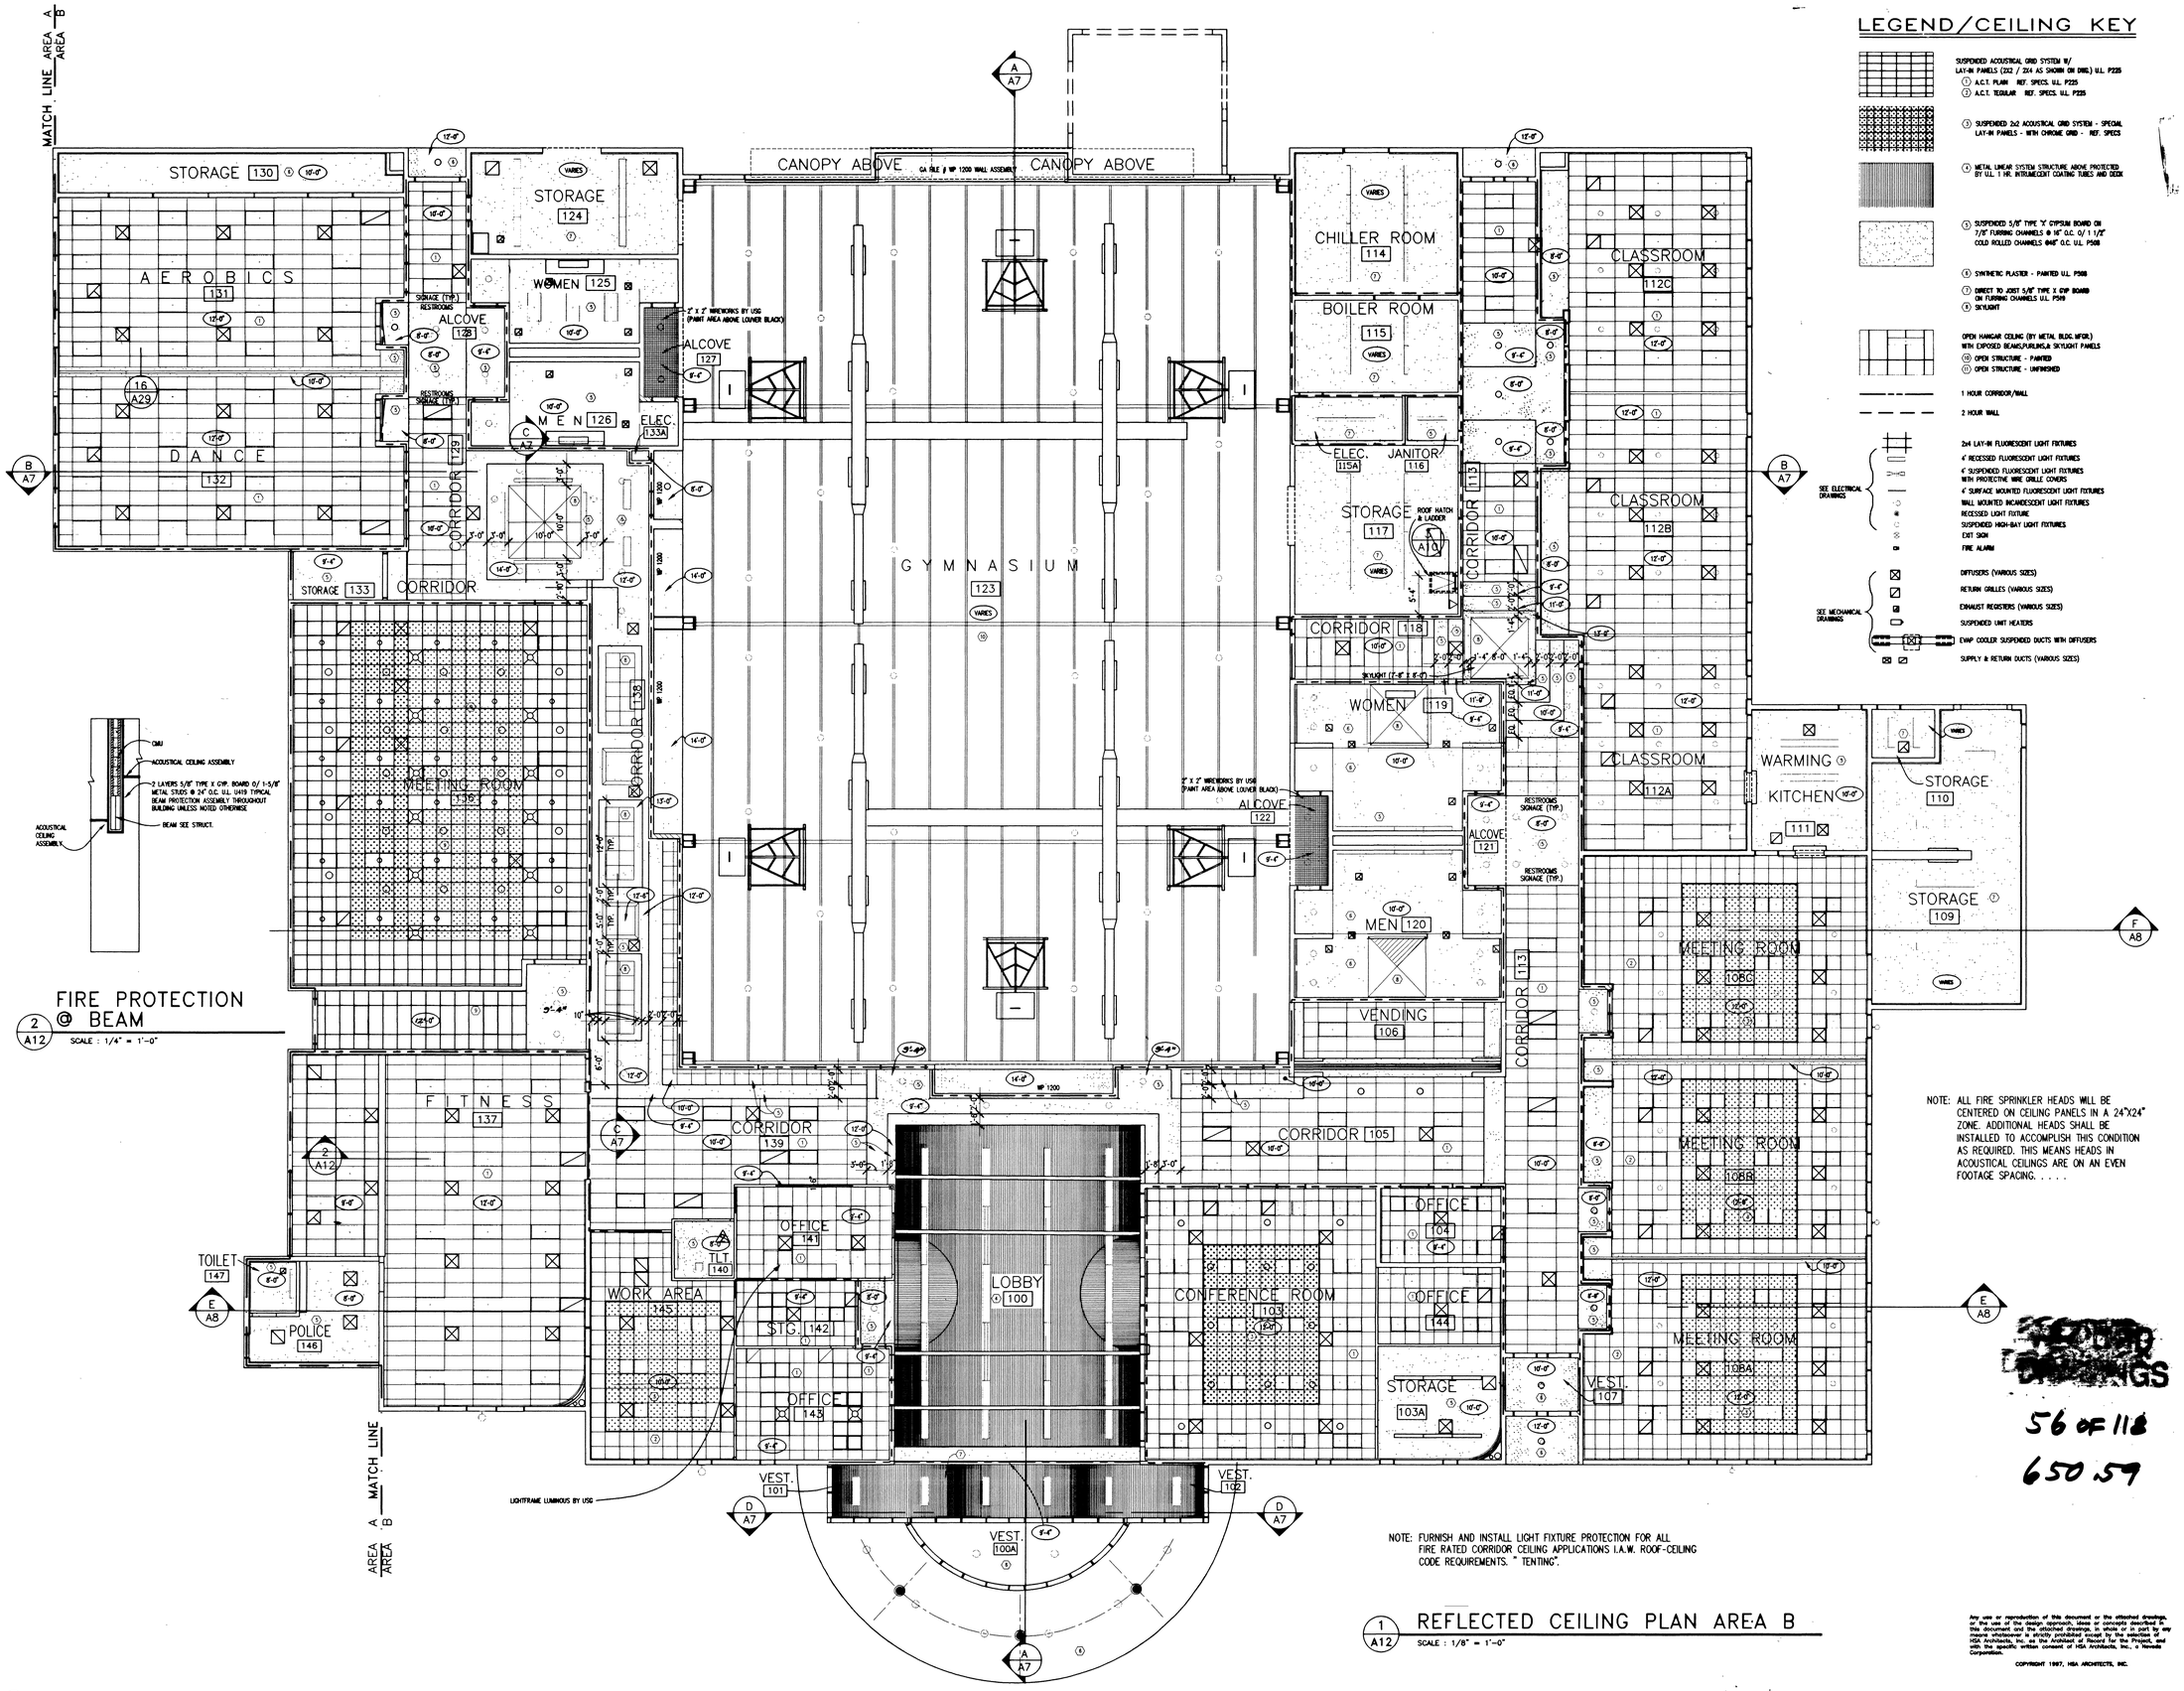

LEGEND/CEILING KEY

SUSPENDED ACOUSTICAL GRID SYSTEM W/ LAY-IN PANELS (2X2 / 2X4 AS SHOWN ON DWG.) U.L. P225
1. A.C.T. PLAIN REF. SPECS. U.L. P225
2. A.C.T. TEGULAR REF. SPECS. U.L. P225
3. SUSPENDED 2x2 ACOUSTICAL GRID SYSTEM - SPECIAL LAY-IN PANELS - WITH CHROME GRID - REF. SPECS
4. METAL LINEAR SYSTEM STRUCTURE ABOVE PROTECTED BY U.L. 1 HR. INTUMECENT COATING TUBES AND DECK
5. SUSPENDED 5/8" TYPE 'X' GYPSUM BOARD ON 7/8" FURRING CHANNELS @ 16" O.C. O/ 1 1/2" COLD ROLLED CHANNELS @48" O.C. U.L. P508
6. SYNTHETIC PLASTER - PAINTED U.L. P508
7. DIRECT TO JOIST 5/8" TYPE X GYP BOARD ON FURRING CHANNELS U.L. P549
8. SKYLIGHT
9. OPEN HANGAR CEILING (BY METAL BLDG. MFGR.) WITH EXPOSED BEAMS/PURLINS,& SKYLIGHT PANELS
10. OPEN STRUCTURE - PAINTED
11. OPEN STRUCTURE - UNFINISHED

1 HOUR CORRIDOR/WALL
2 HOUR WALL

SEE ELECTRICAL DRAWINGS:
2x4 LAY-IN FLUORESCENT LIGHT FIXTURES
4' RECESSED FLUORESCENT LIGHT FIXTURES
4' SUSPENDED FLUORESCENT LIGHT FIXTURES WITH PROTECTIVE WIRE GRILLE COVERS
4' SURFACE MOUNTED FLUORESCENT LIGHT FIXTURES
WALL MOUNTED INCANDESCENT LIGHT FIXTURES
RECESSED LIGHT FIXTURE
SUSPENDED HIGH-BAY LIGHT FIXTURES
EXIT SIGN
FIRE ALARM

SEE MECHANICAL DRAWINGS:
DIFFUSERS (VARIOUS SIZES)
RETURN GRILLES (VARIOUS SIZES)
EXHAUST REGISTERS (VARIOUS SIZES)
SUSPENDED UNIT HEATERS
EVAP COOLER SUSPENDED DUCTS WITH DIFFUSERS
SUPPLY & RETURN DUCTS (VARIOUS SIZES)

REVISION	DESCRIPTION	DATE

WAYNE SCHREINER AIA
THOMAS M. SILVA AIA
1525 WEST OAKEY BLVD.
LAS VEGAS, NV. 89102
(702) 383-0077
FAX (702) 383-0027
HSA ARCHITECTS

Sheet Title: REFLECTED CEILING PLAN AREA B

Job Title: CITY OF LAS VEGAS DEPARTMENT OF PARK AND LEISURE ACTIVITIES
DURANGO RECREATION FACILITY

Verify all Dimensions and Conditions at the Site

Job: 960901

Date: 20 FEB. 1998

Drawn By: CRL

Check: WPS

Sheet: A12

15 of 36

Any use or reproduction of this document or the attached drawings, or the use of the design approach, ideas or concepts described in this document and the attached drawings, in whole or in part by any means whatsoever is strictly prohibited except by the selection of HSA Architects, Inc. as the Architect of Record for the Project, and with the specific written consent of HSA Architects, Inc., a Nevada Corporation.

COPYRIGHT 1997, HSA ARCHITECTS, INC.

56 OF 118
650.59

27865