

LIGHTING FIXTURE SCHEDULE									
FIXTURE TYPE	VOLT	FLUOR	INCAN	OTHER	MOUNTING	LAMP(S)	CONTROL MEDIA (LENS, LOUVER, ETC.)	MANUFACTURER'S CATALOG NUMBER(S)	DESCRIPTIONS AND/OR REMARKS
A	277	X			GRID	(4) F0327B 3000K	1 1/2" x 1 1/2" x 1 PARACUBE LOUVER	LITHONIA 29PG 432PC2 2TT GEB10	2x4 4 LAMP FLUOR GRID TROFFER W/ PARACUBE LOUVER
AI	277	X			GRID	(4) F0327B 3000K	1 1/2" x 1 1/2" x 1 PARACUBE LOUVER	LITHONIA 29PG 432PC2 2TT GEB10 EL	2x4 4 LAMP FLUOR GRID TROFFER W/ PARACUBE LOUVER & EMERGENCY BATTERY BALLAST
B					NOT USED				
C	277	X			SURFACE	(2) F0327B 3000K	1 1/2" x 1 1/2" x 1 PARACUBE LOUVER	LITE CONTROL SD66N 24R8 PWA 2TT ELB	4' 2 LAMP SURFACE MOUNTED FLUOR
CI	277	X			SURFACE	(2) F0327B 3000K	1 1/2" x 1 1/2" x 1 PARACUBE LOUVER	LITE CONTROL SD66N 24R8 PWA 2TT ELB EF	4' 2 LAMP SURFACE MOUNTED FLUOR W/ EMERG BALLAST
D	277	X			RECESSED	(2) F13TDD87	-	LITHONIA AF2/13T 8AR 2TT	FLUORESCENT DOWNLIGHT
E	277		X		PER PLANS	LED	-	LITHONIA LES WIR 120/2TT ELN	EXIT SIGN FACES AND MOUNTING PER PLANS
E1	277		X		PER PLANS	LED	-	LITHONIA LQ1-SWIR 120/2TT EL	VANDELPROOF
E2	277		X		PER PLANS	LED	-	LITHONIA LES WIR 120/2TT ELN	EXIT SIGN FACES AND MOUNTING PER PLANS DOUBLE FACED
F	277		X		PENDANT	(1) M400/CAU	CLEAR GLASS	LITHONIA TE400 METM	400W METAL HALIDE HIGH BAY
G	120		X		PENDANT	(1) P630-3000V/93/30	CLEAR GLASS	LITHONIA TE300 LB INC W 120V	300W INCANDESCENT HIGH BAY
H	277		X		RECESSED	(1) M100/U	CLEAR GLASS	LITHONIA AH100/1 TMB GL	100W METAL HALIDE DOWNLIGHT
J					NOT USED				
K	277		X		SURF. WALL	(1) LUS20	GASKETED SAFETY GLASS & ANODIZED LOUVER	STAFF 4358-UH-2TT	WALL MTD 50W HPS WHITE FINISH
L	120		X		PROV. CLIPS TO CONCEAL BEHIND METAL WALL PANEL	XENON-METAL HALIDE	-	LUMINITE G-60 SERIES	FIBEROPTIC TUBING & ILLUM. PROVIDE APPR. 60' OF FIBER OPTIC TUBING. SEE ARCH. DETAILS FOR LAYOUT.
M	277	X			SURFACE	(2) F0327B 3000K	-	LITHONIA G232 2TT GEB10	4' FLUOR STRIP ABOVE LUMINOUS CLG.
N	277	X			SURFACE	(2) F0327B 3000K	FRISMATIC ACRYLIC	LITHONIA SB2 232 2TT GEB10	4' FLUOR WRAPAROUND
P	277	X			RECESSED	(1) F0327B 3000K	PARABOLIC BAFFLE	LITE CONTROL RD1N4R8 2TTV FB55 ELB	4' FLUORESCENT SLAT LIGHT SEE NOTE 1
PI	277	X			RECESSED	(1) F0327B 3000K	PARABOLIC BAFFLE	LITE CONTROL RD1N4R8 2TTV FB55EF ELB EF	4' FLUOR SLAT LIGHT W/ EMER. BATT. BALLAST SEE NOTE 1
Q	277	X			SURFACE	(2) F0327B 3000K	0.125" OPAL ACRYLIC LENS	LITHONIA 68 232 2TT GEB10	4' FLUOR STAGGERED STRIP & LENS. SEE ARCH. DETAIL
R	120		X		RECESSED	A19	-	LITHONIA A6MB	100W INCAN. DOWNLIGHT
S	277	X			SURFACE	(2) F0327B 3000K	-	LITHONIA AF 232 2TT GEB10	4' INDUSTRIAL FLUORESCENT
T	277	X			GRID	(4) F0327B 3000K	1 1/2" x 1 1/2" x 1 PARACUBE LOUVER	LITHONIA 29PG432PC2 2TT GEB10 CROSS MULLION	2x4 4 LAMP FLUORESCENT GRID TROFFER W/ PARACUBE LOUVER & CROSS MULLION
TI	277	X			GRID	(4) F0327B 3000K	1 1/2" x 1 1/2" x 1 PARACUBE LOUVER	LITHONIA 29PG432PC2 2TT GEB10 EL CROSS MULLION	2x4 4 LAMP FLUORESCENT TROFFER W/ PARACUBE LOUVER CROSS MULLION AND BATTERY BALLAST
U	277	X			GRID	(4) F0327B 3000K	1 1/2" x 1 1/2" x 1 PARACUBE LOUVER	LITHONIA 29PG432PC2 2TT GEB10 CHROME CROSS MULLION	2x4 4 LAMP FLUORESCENT GRID TROFFER W/ PARACUBE LOUVER & CHROME CROSS MULLION
UI	277	X			GRID	(4) F0327B 3000K	1 1/2" x 1 1/2" x 1 PARACUBE LOUVER	LITHONIA 29PG432PC2 2TT GEB10 EL CHROME CROSS MULLION	2x4 4 LAMP FLUORESCENT TROFFER W/ PARACUBE LOUVER CHROME CROSS MULLION & BATTERY BALLAST
V	277	X			REC. GYP.	(3) F0327B 3000K	1 1/2" x 1 1/2" x 1 PARACUBE LOUVER	LITHONIA 29FF332 PC2 2TT GEB10	2x4 3 LAMP FLUOR FLANGE TROFFER W/ PARACUBE LOUVER
VI	277	X			REC. GYP.	(3) F0327B 3000K	1 1/2" x 1 1/2" x 1 PARACUBE LOUVER	LITHONIA 29FF332PC2 2TT GEB10 EL	2x4 3 LAMP FLUOR FLANGE TROFFER W/ PARACUBE LOUVER & BATT. BALLAST
W, WI, W2					SEE DETAILS ON SHEET E22				
X	277	X			SURFACE	(4) F0327B 3000K	1 1/2" x 1 1/2" x 1 PARACUBE LOUVER	LITE CONTROL SD 66N 2848R8 2TT CUM FUA ELB	8' 4 LAMP SURFACE MOUNTED FLUORESCENT
XI	277	X			SURFACE	(4) F0327B 3000K	1 1/2" x 1 1/2" x 1 PARACUBE LOUVER	LITE CONTROL SD 66N 2848R8 2TT CUM FUA ELB-EF	8' 4 LAMP SURFACE MOUNTED FLUORESCENT W/ EMERGENCY BATT. PACK
Y	120	X			RECESSED	(1) F13DTT/D835	OPAL POLYCARBONATE	LITHONIA LP613DTT 120	WET LOCATION SHOWER LIGHT
Z					NOT USED				
AA					NOT USED				
BB	277		X		25' ROUND STEEL POLE	(4) F15W CLEAR METAL HALIDE 36x10 BEAM SPREAD	CAST GUARD	STERNER 18YK4N 36x10 F15H 2TTNS JF	POLE LIGHT W/ FOUR FIXTURES COLOR SELECTED BY ARCH. YOKE MOUNTED
CC	277		X		WALL MTD.	W/ UNIT	POLYCARBONATE SHIELD	LITHONIA 6ELM2-ELAV82	BATTERY PACK W/ (2) HEADS
DD	277		X		CONCRETE BASE	100W ED-TM4	CLEAR TEMPERED GLASS	BEGA 3483PH-T140-WPFI-120 FOR RECP. & 2TT FOR LIGHT-RECP.	100W METAL HALIDE BOLLARD W/ 20A DUPLEX GFI RECEPT. FLUSH IN POLE W/ WP. LOCKABLE COVER
EE					NOT USED				
FF					NOT USED				
HH	277	X			SURFACE	(4) F0327B 3000K	ACRYLIC LENS INJECTION MOLDED	LITHONIA VC432 2TT GEB10	2x4 SURFACE FLUORESCENT W/ WRAPAROUND LENS

* SEE STRUCTURAL PLANS FOR CONCRETE BASE REQUIREMENTS

ELECTRICAL SYMBOL LEGEND	
NOTE: MOUNTING HEIGHTS TO BE AS INDICATED ON THIS LEGEND UNLESS NOTED OTHERWISE ON PLANS	
LIGHTING FIXTURE SYMBOLS	POWER & CONTROL SYMBOLS
<p>○ CEILING MOUNTED FLUORESCENT FIXTURE - UPPER CASE LETTER DENOTES TYPE - LOWER CASE LETTER DENOTES SWITCHING - CENTER DIVIDER DENOTES CENTER CROSSMEMBER - SHADING INDICATES EMERGENCY BALLAST</p> <p>○ FIXTURE IN CEILING - TYPE AS SCHEDULED</p> <p>⚡ EMERGENCY BATTERY PACK LIGHT</p> <p>EXIT FIXTURE - SHADED AREA DENOTES LIGHTED FACE - ARROW DENOTES DIRECTION</p> <p>○ WALL MOUNTED FIXTURE</p> <p>○ POLE MOUNTED FIXTURE</p> <p>⚡ LIGHT TRACK WITH LIGHT FIXTURES</p>	<p>— SURFACE MOUNTED BRANCH CIRCUIT PANEL</p> <p>— FLUSH MOUNTED BRANCH CIRCUIT PANEL</p> <p>□ DISTRIBUTION PANEL OR SWITCHBOARD</p> <p>□ EQUIPMENT PANEL AS NOTED</p> <p>□ TRANSFORMER</p> <p>□ MAGNETIC MOTOR STARTER</p> <p>□ DISCONNECT SWITCH</p> <p>□ CONTACTOR</p> <p>□ MOTOR OUTLET</p> <p>ELB CONTROL DEVICE. LETTERS INDICATE TYPE: FLS = FLOAT SWITCH FS = FLOW SWITCH FIS = FOOT SWITCH LS = LIMIT SWITCH FE = PNEUMATIC SW. PS = PRESSURE SW.</p> <p>⊖ THERMOSTAT, 48" AFF.</p> <p>⊖ JUNCTION BOX</p> <p>⊖ JUNCTION BOX (WALL MOUNTED)</p> <p>⊖ TIME SWITCH, 48" AFF.</p>
RECEPTACLE & SWITCH SYMBOLS	CONDUIT & WIRING SYMBOLS
<p>⊖ SINGLE RECEPTACLE, 18" AFF.</p> <p>⊖ DUPLEX RECEPTACLE, 18" AFF.</p> <p>⊖ DUPLEX MOUNTED ABOVE COUNTER</p> <p>⊖ GROUND FAULT INTERRUPTER DUPLEX, 18" AFF.</p> <p>⊖ DUPLEX WITH WEATHERPROOF BOX AND COVER, 24" AFF.</p> <p>⊖ SPECIAL OUTLET AS NOTED, 18" AFF.</p> <p>⊖ FLOOR MOUNTED DUPLEX RECEPTACLE</p> <p>⊖ CLOCK OUTLET</p> <p>⊖ DOUBLE DUPLEX RECEPTACLE, 18" AFF.</p> <p>— FLUGMOLD STRIP</p> <p>⊖ SINGLE POLE SWITCH, 48" AFF.</p> <p>⊖ THREE WAY SWITCH, 48" AFF.</p> <p>⊖ FOUR WAY SWITCH, 48" AFF.</p> <p>⊖ KEYSwitch, 48" AFF.</p> <p>⊖ DIMMER SWITCH, 48" AFF.</p> <p>⊖ SWITCH WITH PILOT LIGHT, 48" AFF.</p> <p>⊖ MANUAL MOTOR STARTER</p> <p>⊖ MOMENTARY CONTACT SWITCH, 48" AFF.</p> <p>⊖ PHOTOELECTRIC SWITCH</p>	<p>— CONDUIT CONCEALED IN WALLS OR CEILING</p> <p>— UNDERGROUND OR UNDER SLAB RACEWAY</p> <p>— CONDUIT WITH BUSH ENDS</p> <p>A-133 HOME RUN TO PANEL 'A', CIRCUITS 1-35</p> <p>RACEWAY, EACH CROSS HATCH INDICATES ONE #2 CONDUCTOR, NO CROSS HATCHES INDICATES 2 #2 CONDUCTORS, LINE WITH DOT INDICATES GROUNDING CONDUCTOR</p> <p>— RACEWAY OR CONTINUATION</p> <p>— MINIMUM 3/4" TO TELEPHONE BOARD</p> <p>— MINIMUM 3/4" TO COMPUTER BOARD</p>
TELEPHONE SYSTEM SYMBOLS	FIRE ALARM SYSTEM SYMBOLS
<p>— TELEPHONE TERMINAL BOARD, SIZE AS NOTED ON PLANS</p> <p>⊖ TELEPHONE OUTLET, 18" AFF.</p> <p>⊖ WALL TELEPHONE</p> <p>⊖ PAY TELEPHONE</p> <p>⊖ COMPUTER OUTLET OR SPECIAL PURPOSE COMMUNICATION, 18" AFF.</p> <p>⊖ TELEPHONE OUTLET ABOVE COUNTER</p> <p>⊖ COMPUTER OUTLET ABOVE COUNTER</p> <p>⊖ FLOOR MOUNTED TELEPHONE OUTLET</p> <p>⊖ FLOOR MOUNTED COMPUTER OUTLET</p>	<p>⊖ FIRE ALARM PULL STATION, 48" AFF.</p> <p>⊖ HORN/LIGHT, 80" AFF.</p> <p>⊖ CHIME/LIGHT</p> <p>⊖ SMOKE DETECTOR</p> <p>⊖ HEAT DETECTOR</p> <p>⊖ DUCT SMOKE DETECTOR</p> <p>⊖ MAGNETIC DOOR HOLDER</p> <p>⊖ FLOW SWITCH</p> <p>⊖ TAMPER SWITCH</p> <p>⊖ REMOTE PILOT LIGHT FROM SMOKE DETECTORS, 80" AFF.</p>
COMMUNICATION SYSTEM SYMBOLS	MISCELLANEOUS
<p>⊖ TELEVISION OUTLET, 48" AFF.</p> <p>⊖ BELL</p> <p>⊖ RELAY</p> <p>⊖ CAMERA</p> <p>⊖ PUSH BUTTON, 48" AFF.</p>	<p>⊖ INDICATES MOTOR TYPE AND SCHEDULE NUMBER</p> <p>⊖ REFERENCE NOTE</p> <p>GFI GROUND FAULT INTERRUPTER</p> <p>WP. WEATHERPROOF</p> <p>AFF. ABOVE FINISHED FLOOR</p> <p>FACP FIRE ALARM CONTROL PANEL</p> <p>AUX. DEVICE WITH AUXILIARY CONTACTS</p> <p>ELR. END OF LINE RESISTOR</p> <p>ELWC. ELECTRICAL WATER COOLER</p> <p>C.O. CONDUIT ONLY</p> <p>I.G. ISOLATED GROUND</p>
SOUND SYSTEM SYMBOLS	
<p>⊖ SOUND SYSTEM SPEAKER</p> <p>⊖ MICROPHONE OUTLET, 18" AFF.</p> <p>⊖ VOLUME CONTROL, 48" AFF.</p>	


LIGHT FIXTURE SCHEDULE NOTES

- BEFORE ORDERING FIXTURES, VERIFY THAT FIXTURES ARE COMPATIBLE WITH THE METAL CEILING BEING INSTALLED. CATALOG NUMBERS MAY VARY DEPENDING ON THE MANUFACTURER OF CEILING.
- ALL FIXTURES W/EM BALLASTS SHALL HAVE A MINIMUM OUTPUT OF 1000 LUMENS WHEN OPERATING ON BATTERY POWER.

REVISION	DESCRIPTION	DATE	REV. BY

WAYNE SCREIBER AIA
THOMAS M. SILVA AIA

1525 WEST OAKLEY BLVD
LAS VEGAS, NV 89102
(702) 365-0077
FAX 365-0057

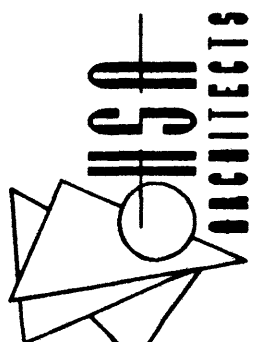

ELECTRICAL SYMBOLS & SCHEDULES
CITY OF LAS VEGAS DEPARTMENT OF PARK AND LEISURE ACTIVITIES
DURANGO RECREATION FACILITY
Verify all Dimensions and Conditions at the Site.

Sheet Title
Job 960901

Date 2-20-98

Drawn By MDV


Check ROK

Sheet

E10

of 107 (1/3)

1 OF 11

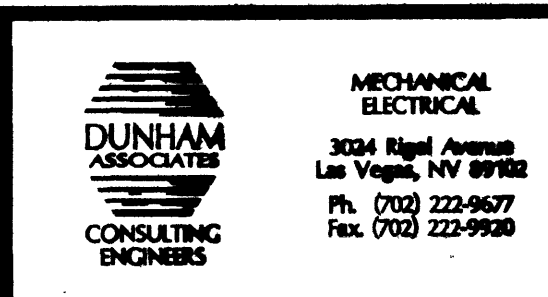

DUNHAM CONSULTING ENGINEERS

RECEIVED
RECORD
DRAWINGS
107 OF 118
650.57