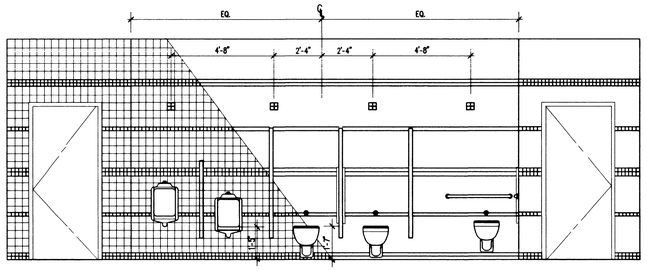

1 / A17 MEN'S TOILET ROOM 126

SCALE : 3/8" = 1'-0"

MEN'S TOILET RM. 120 SIM.

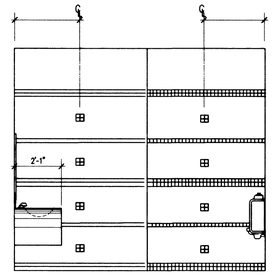

2 / A17 MEN'S TOILET ROOM 126

SCALE : 3/8" = 1'-0"

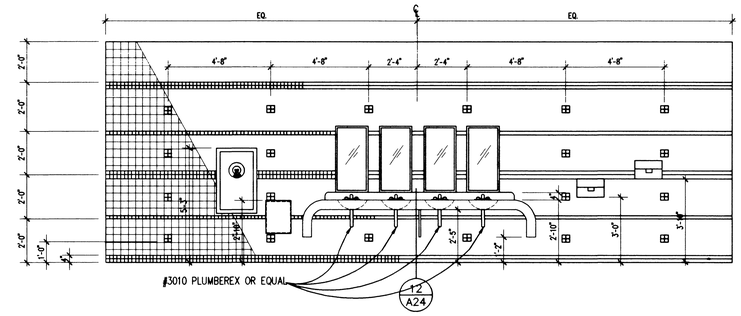

3 / A17 MEN'S TOILET ROOM 126

SCALE : 3/8" = 1'-0"

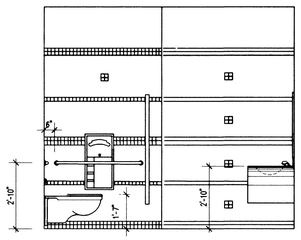

4 / A17 MEN'S TOILET ROOM 126

SCALE : 3/8" = 1'-0"

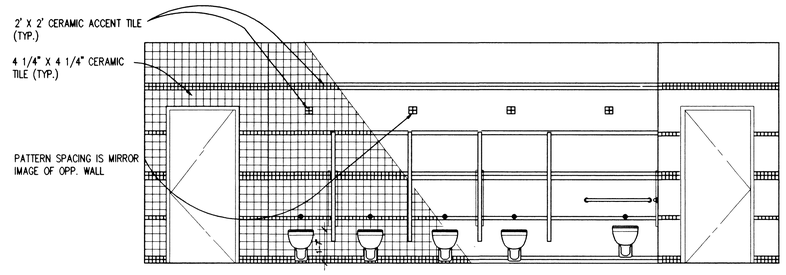

5 / A17 WOMEN'S TOILET ROOM 125

SCALE : 3/8" = 1'-0"

WOMEN'S TOILET RM. 119 SIM.

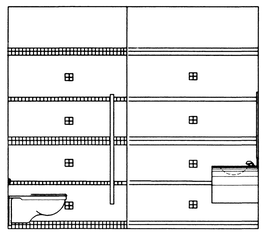

6 / A17 WOMEN'S TOILET ROOM 125

SCALE : 3/8" = 1'-0"

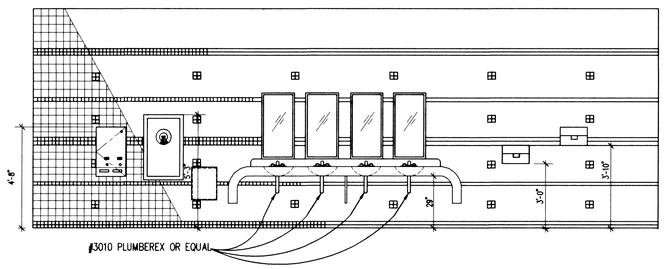

7 / A17 WOMEN'S TOILET ROOM 125

SCALE : 3/8" = 1'-0"

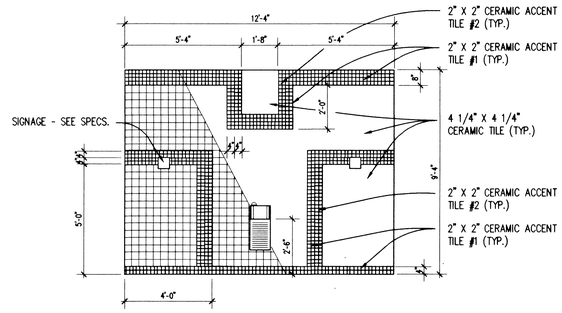

8 / A17 ALCOVE 127

SCALE : 3/8" = 1'-0"

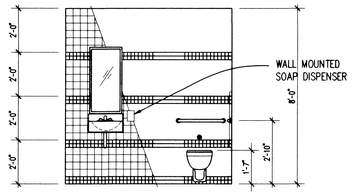

9 / A17 TOILET ROOM 140

SCALE : 3/8" = 1'-0"

TOILET RM. 161 SIM.

NOTE:
SEE ENLARGED PLAN SHEET A14
FOR TOILET ACCESSORIES

NOTE:
#3010 PLUMBEREX OR EQAUL @ ALL SINKS TYPICAL
ALL RESTROOM FIXTURES AND ACCESSORIES SHALL
MEET A.D.A. & '94 U.B.C. HANDICAP REQUIREMENTS

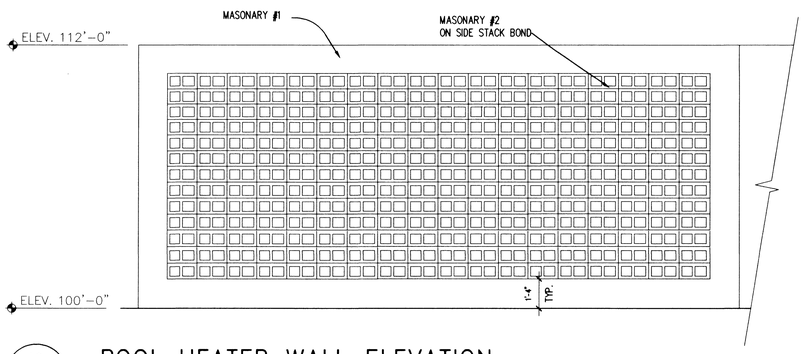

10 / A17 POOL HEATER WALL ELEVATION

SCALE : 3/8" = 1'-0"

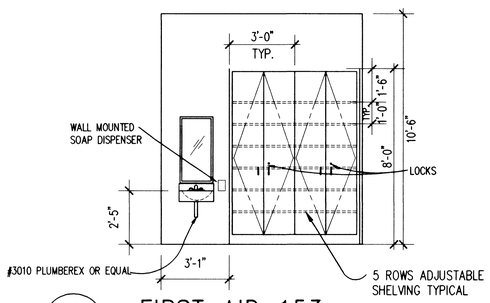

11 / A17 FIRST AID 153

SCALE : 3/8" = 1'-0"

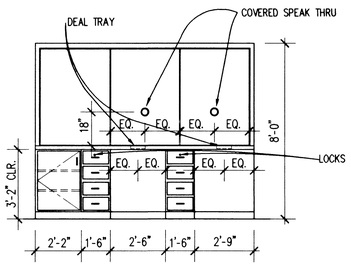

12 / A17 TICKETS 156

SCALE : 3/8" = 1'-0"

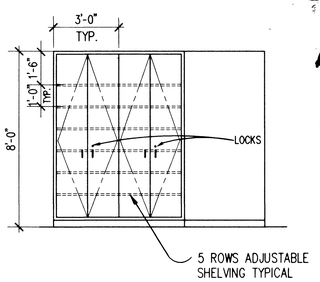

13 / A17 TICKETS 156

SCALE : 3/8" = 1'-0"

Any use or reproduction of this document or the attached drawings, or the use of the design approach, ideas or concepts described in this document and the attached drawings, in whole or in part by any means whatsoever is strictly prohibited except by the selection of HSA Architects, Inc. as the Architect of Record for the Project, and with the specific written consent of HSA Architects, Inc., a Nevada Corporation.

COPYRIGHT 1997, HSA ARCHITECTS, INC.

RECORD DRAWINGS

61 OF 118

650.59

REVISION	DESCRIPTION	DATE

WAYNE SCHREINER AIA
THOMAS M. SILVA AIA

HSA ARCHITECTS
1525 WEST OAKEY BLVD.
LAS VEGAS, NV. 89102
(702) 385-0077
FAX (702) 385-0057

Sheet Title: INTERIOR ELEVATIONS

Job Title: CITY OF LAS VEGAS DEPARTMENT OF PARK AND LEISURE ACTIVITIES
DURANGO RECREATION FACILITY

Verify all Dimensions and Conditions at the Site

Job	960901
Date	20 FEB. 1998
Drawn By	CRL
Check	WPS
Sheet	A17

61 of 118

20 of 36

650.59

27073