

REVISION	DESCRIPTION	DATE


REVISION	DESCRIPTION	DATE

WAYNE SCHREINER AIA
 THOMAS M. SILVA AIA
 1535 WEST OAKLEY BLVD.
 LAS VEGAS, NV, 89102
 (702) 383-0077
 FAX (702) 383-0057

HSA ARCHITECTS
 CITY OF LAS VEGAS DEPARTMENT OF PARK AND LEISURE ACTIVITIES
 DURANGO RECREATION FACILITY
 Verify all Dimensions and Conditions at the Site

Sheet Title	WALL SECTIONS
Job Title	CITY OF LAS VEGAS DEPARTMENT OF PARK AND LEISURE ACTIVITIES DURANGO RECREATION FACILITY
Job	960901
Date	20 FEB. 1998
Drawn By	CRL
Check	WPS
Sheet	A21
	67 of 118
	650.59
	26 of 36

67
26 of 36
650.59

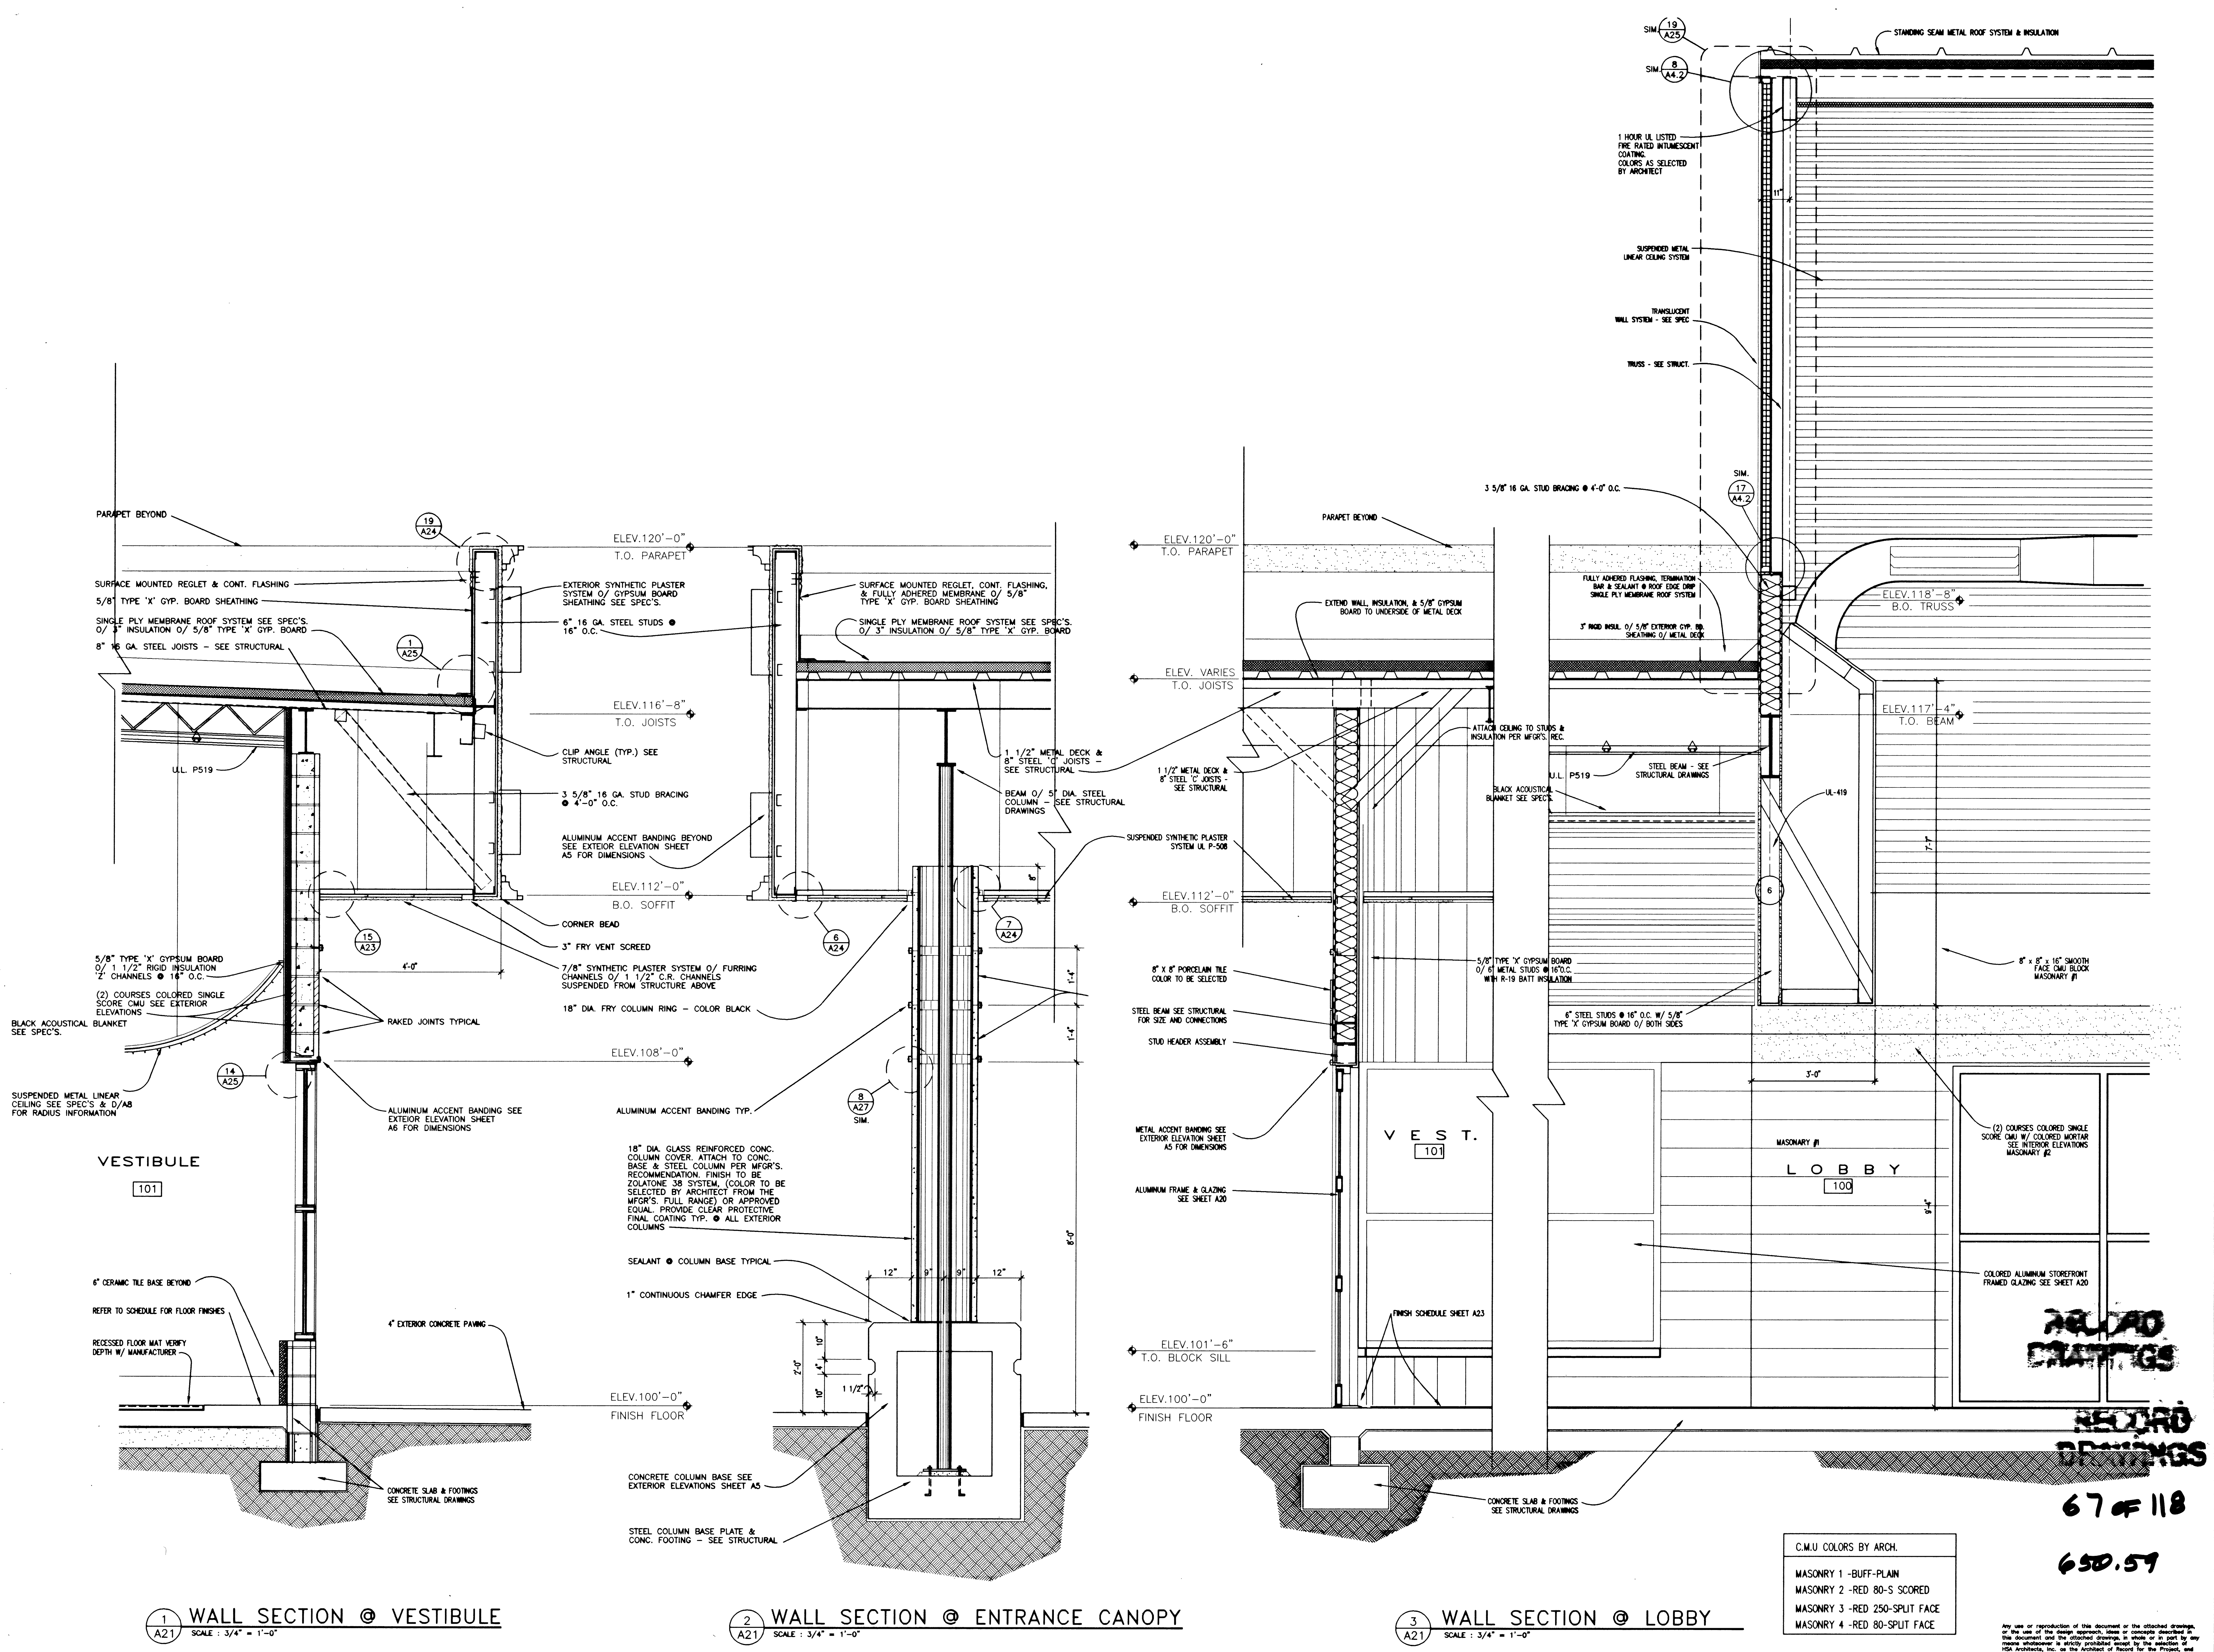

1 WALL SECTION @ VESTIBULE
 SCALE: 3/4" = 1'-0"

2 WALL SECTION @ ENTRANCE CANOPY
 SCALE: 3/4" = 1'-0"

3 WALL SECTION @ LOBBY
 SCALE: 3/4" = 1'-0"

C.M.U COLORS BY ARCH.
MASONRY 1 - BUFF-PLAIN
MASONRY 2 - RED 80-S SCORED
MASONRY 3 - RED 250-SPLIT FACE
MASONRY 4 - RED 80-SPLIT FACE

Any use or reproduction of this document or the attached drawings, or the use of the design approach, shall be in accordance with the terms of the contract and the attached drawings, to which it is part of the contract. No liability shall be assumed by the Architect for the design or construction of the project, or for the results of the design or construction of the project.

77679