


1 BATH HOUSE ROOF PLAN
SCALE: 1/8" = 1'-0"

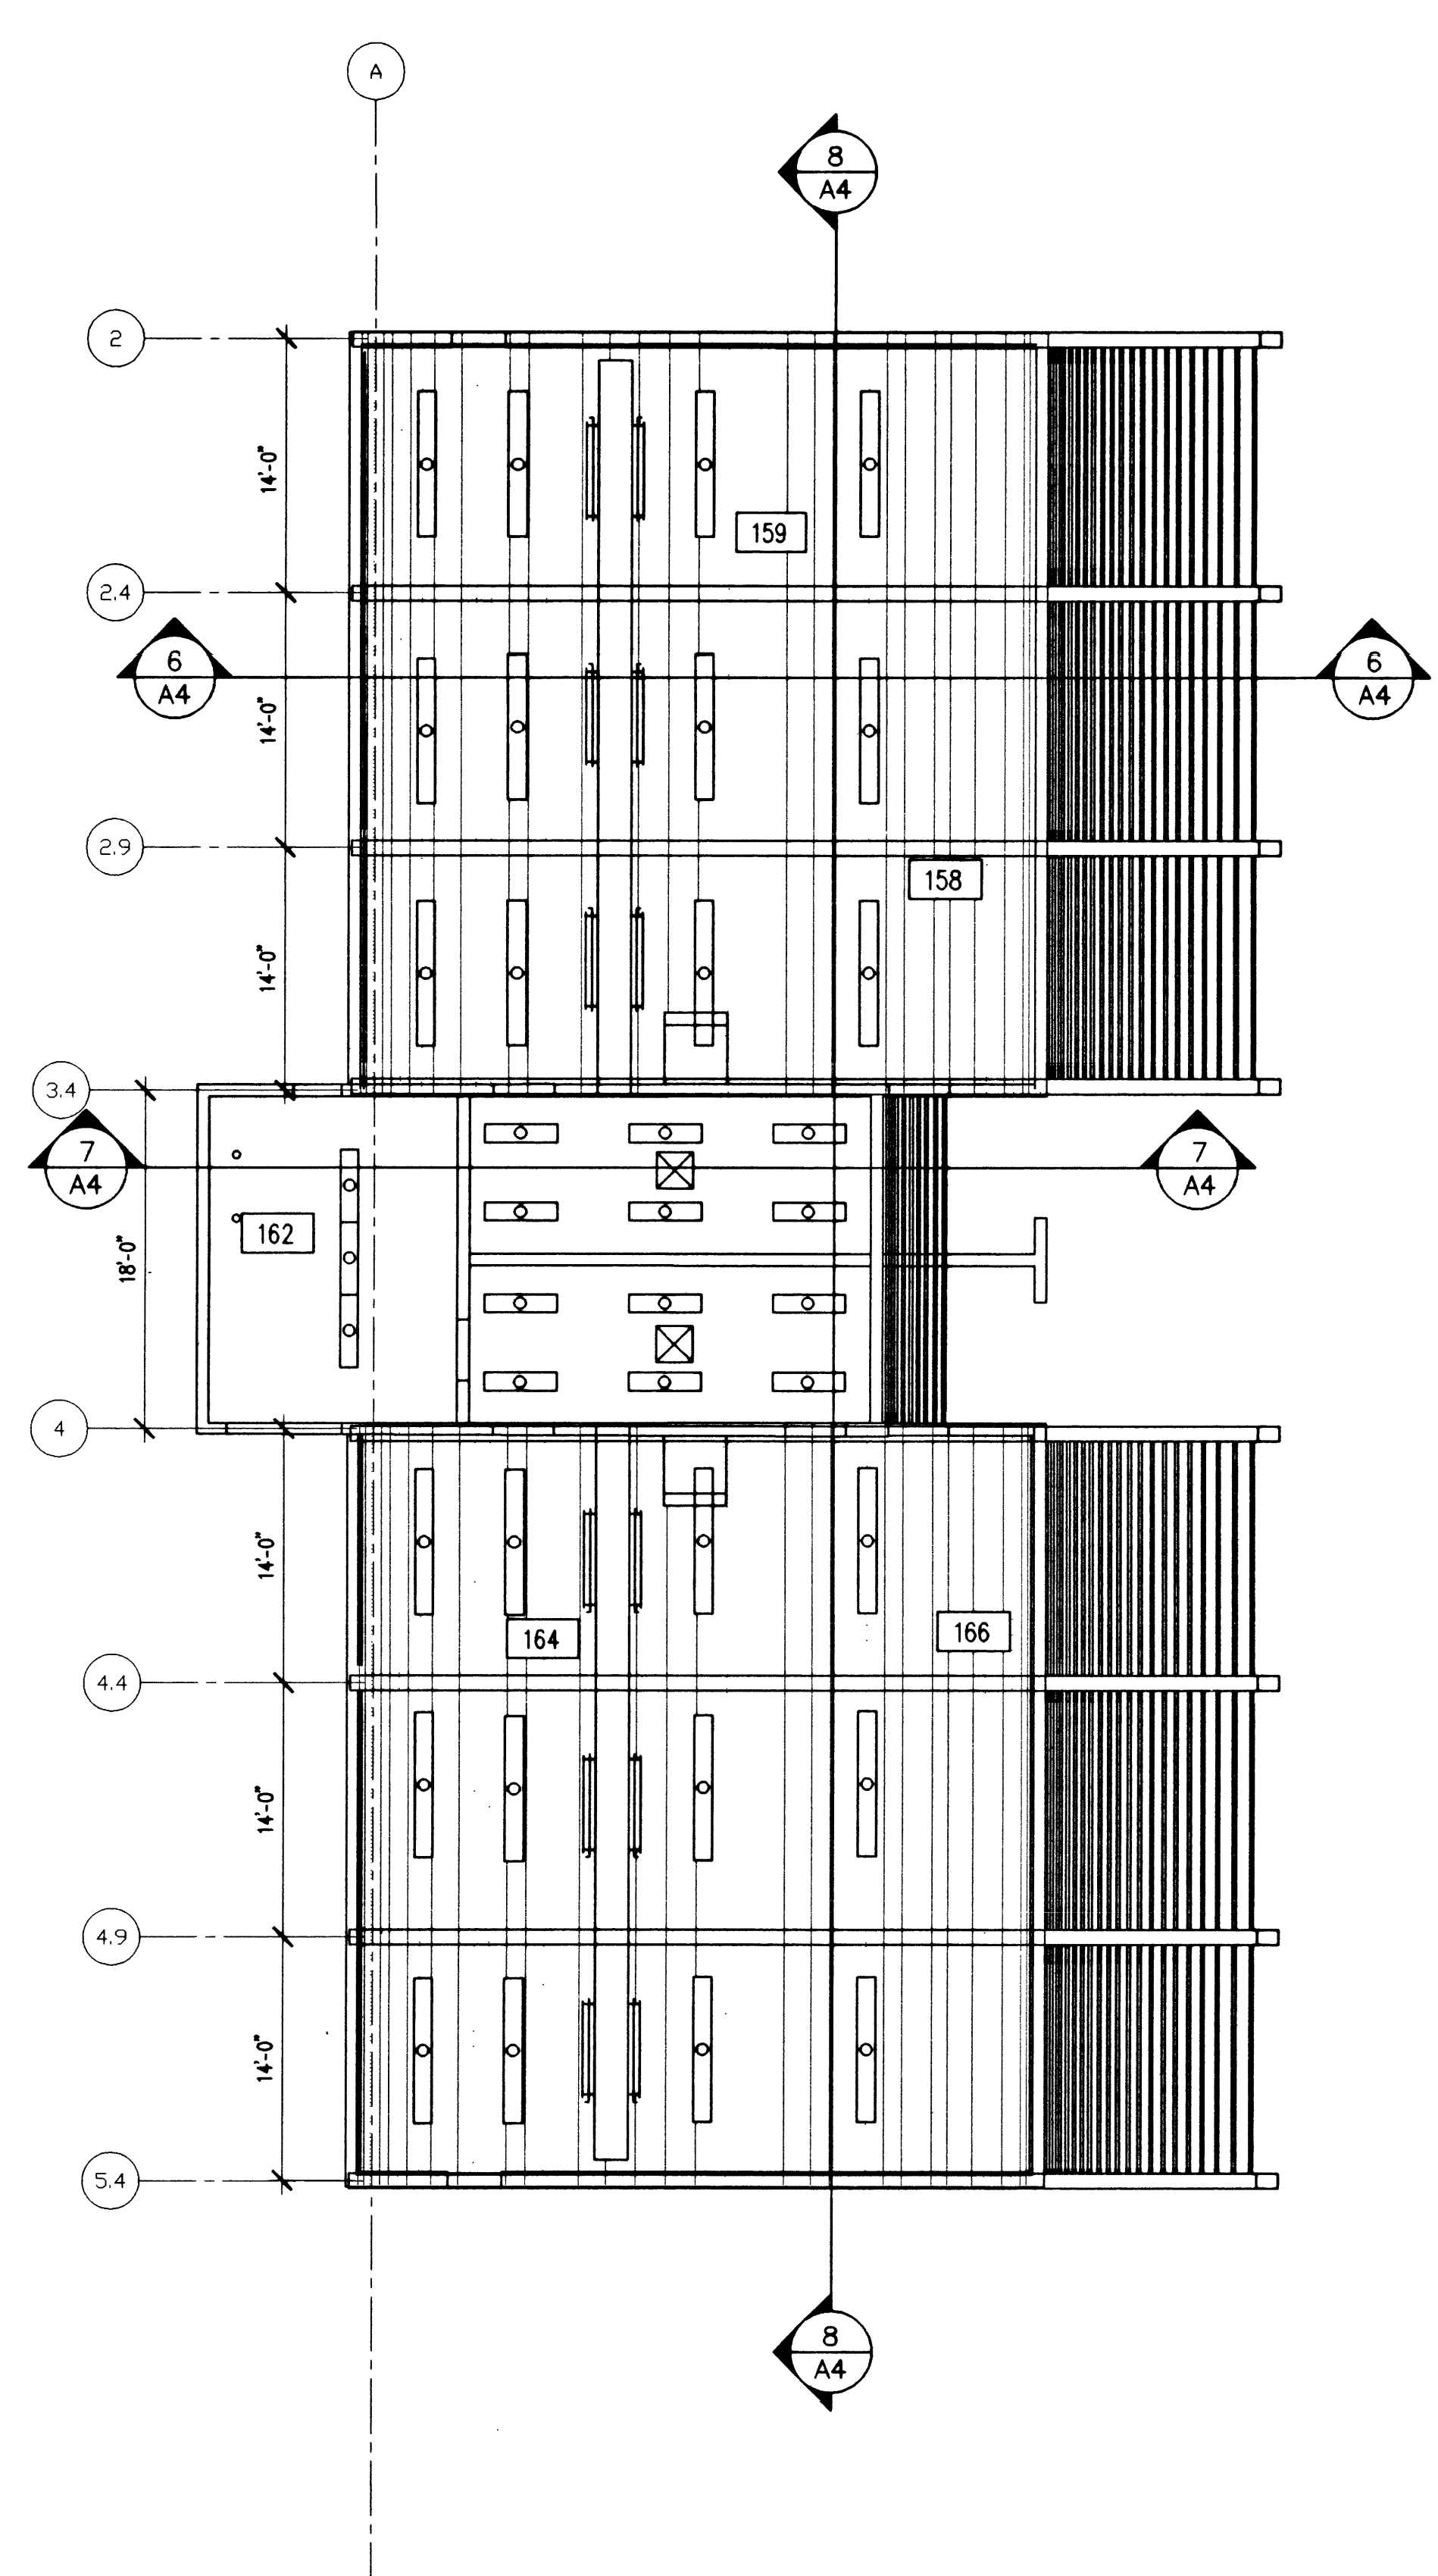

2 BATH HOUSE REFLECTED CEILING PLAN
SCALE: 1/8" = 1'-0"

LEGEND / CEILING KEY

	ALUMINUM TRELLIS BLADES
	ACCENT PAINTED EXPOSED STRUCTURAL MEMBER
	ACCENT PAINTED EXPOSED DUCT WORK
	LIGHT FIXTURE
	GYP. BOARD SOFFIT
	PAINTED EXPOSED METAL ROOF DECK

RECORD
DRAWINGS
RECORD
DRAWINGS

53 OF 118
650.59

--

REVISION	DESCRIPTION	DATE

WAYNE SCHREINER AIA
THOMAS M. SILVA AIA

1525 WEST OAKLEY BLVD.
LAS VEGAS, NV 89102
(702) 383-0077
FAX (702) 383-0057

Sheet Title	BATH HOUSE ROOF PLAN & REFLECTED CEILING PLAN
Job Title	CITY OF LAS VEGAS DEPARTMENT OF PARK AND LEISURE ACTIVITIES DURANGO RECREATION FACILITY
Job	960901
Date	20 FEB. 1998
Drawn By	CRL
Check	WPS
Sheet	A9
	73 OF 118 12 OF 36

Any use or reproduction of this document or the attached drawings, or the use of the design, apparatus, ideas or concepts described in this document and the attached drawings, in whole or in part by any person other than the architect is strictly prohibited except by the architect or ISA Architects, Inc. as the Architect of Record for the Project, and with the specific written consent of ISA Architects, Inc., a Nevada Corporation.

COPYRIGHT 1997, ISA ARCHITECTS, INC.

270653

650.59