



E BUILDING SECTION
SCALE: 1/8" = 1'-0"

CMU COLORS BY ARCH:


MASONRY 1 - BUFF PLUM
MASONRY 2 - RED 80-5 SCORED
MASONRY 3 - RED 250-SPLIT FACE
MASONRY 4 - RED 80-SPLIT FACE

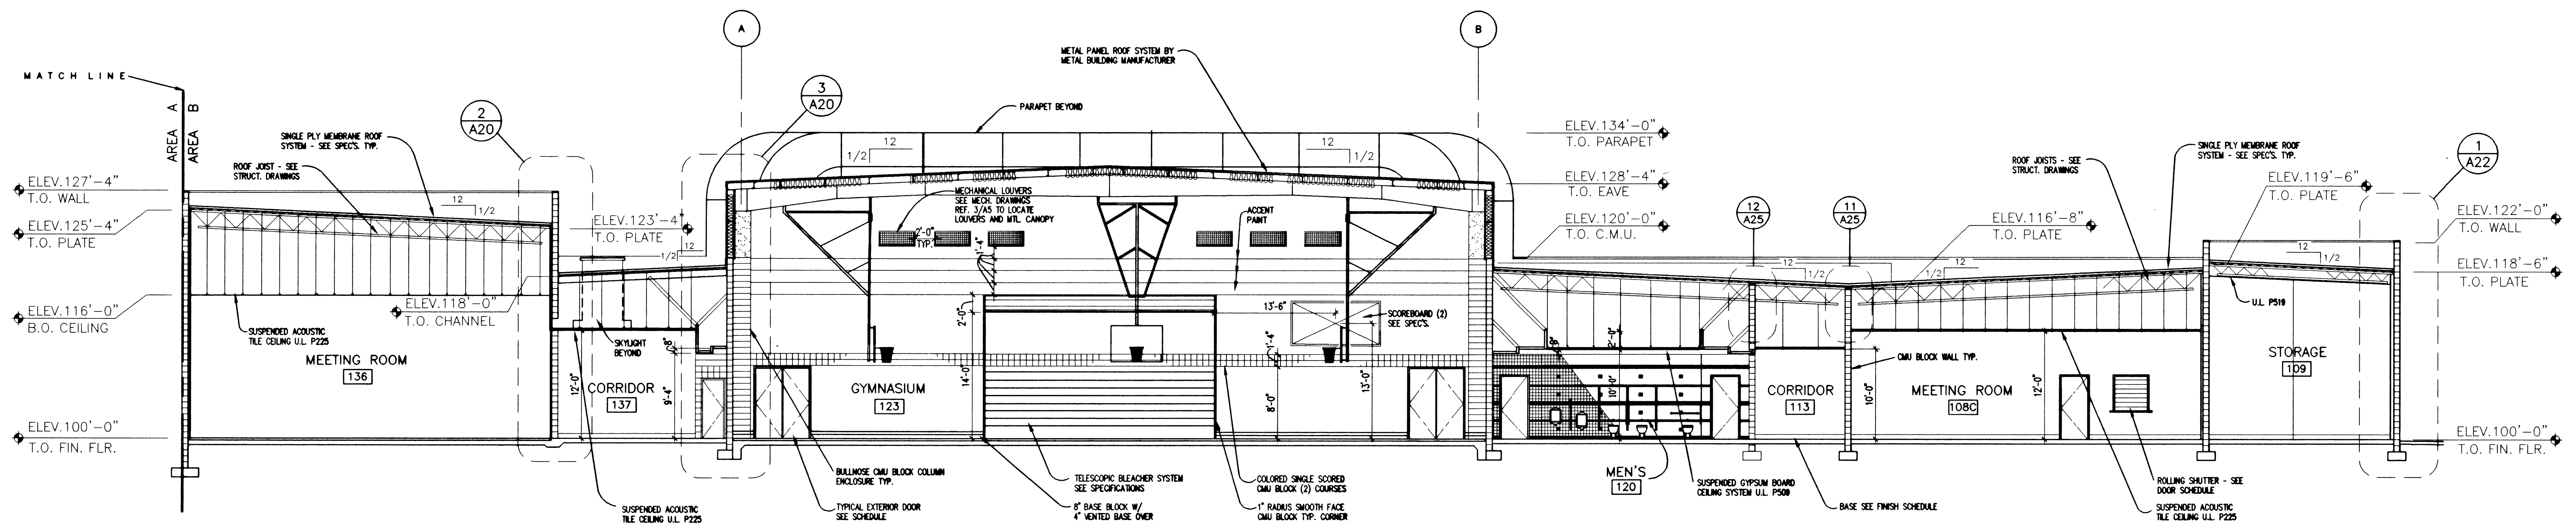

F BUILDING SECTION
SCALE: 1/8" = 1'-0"

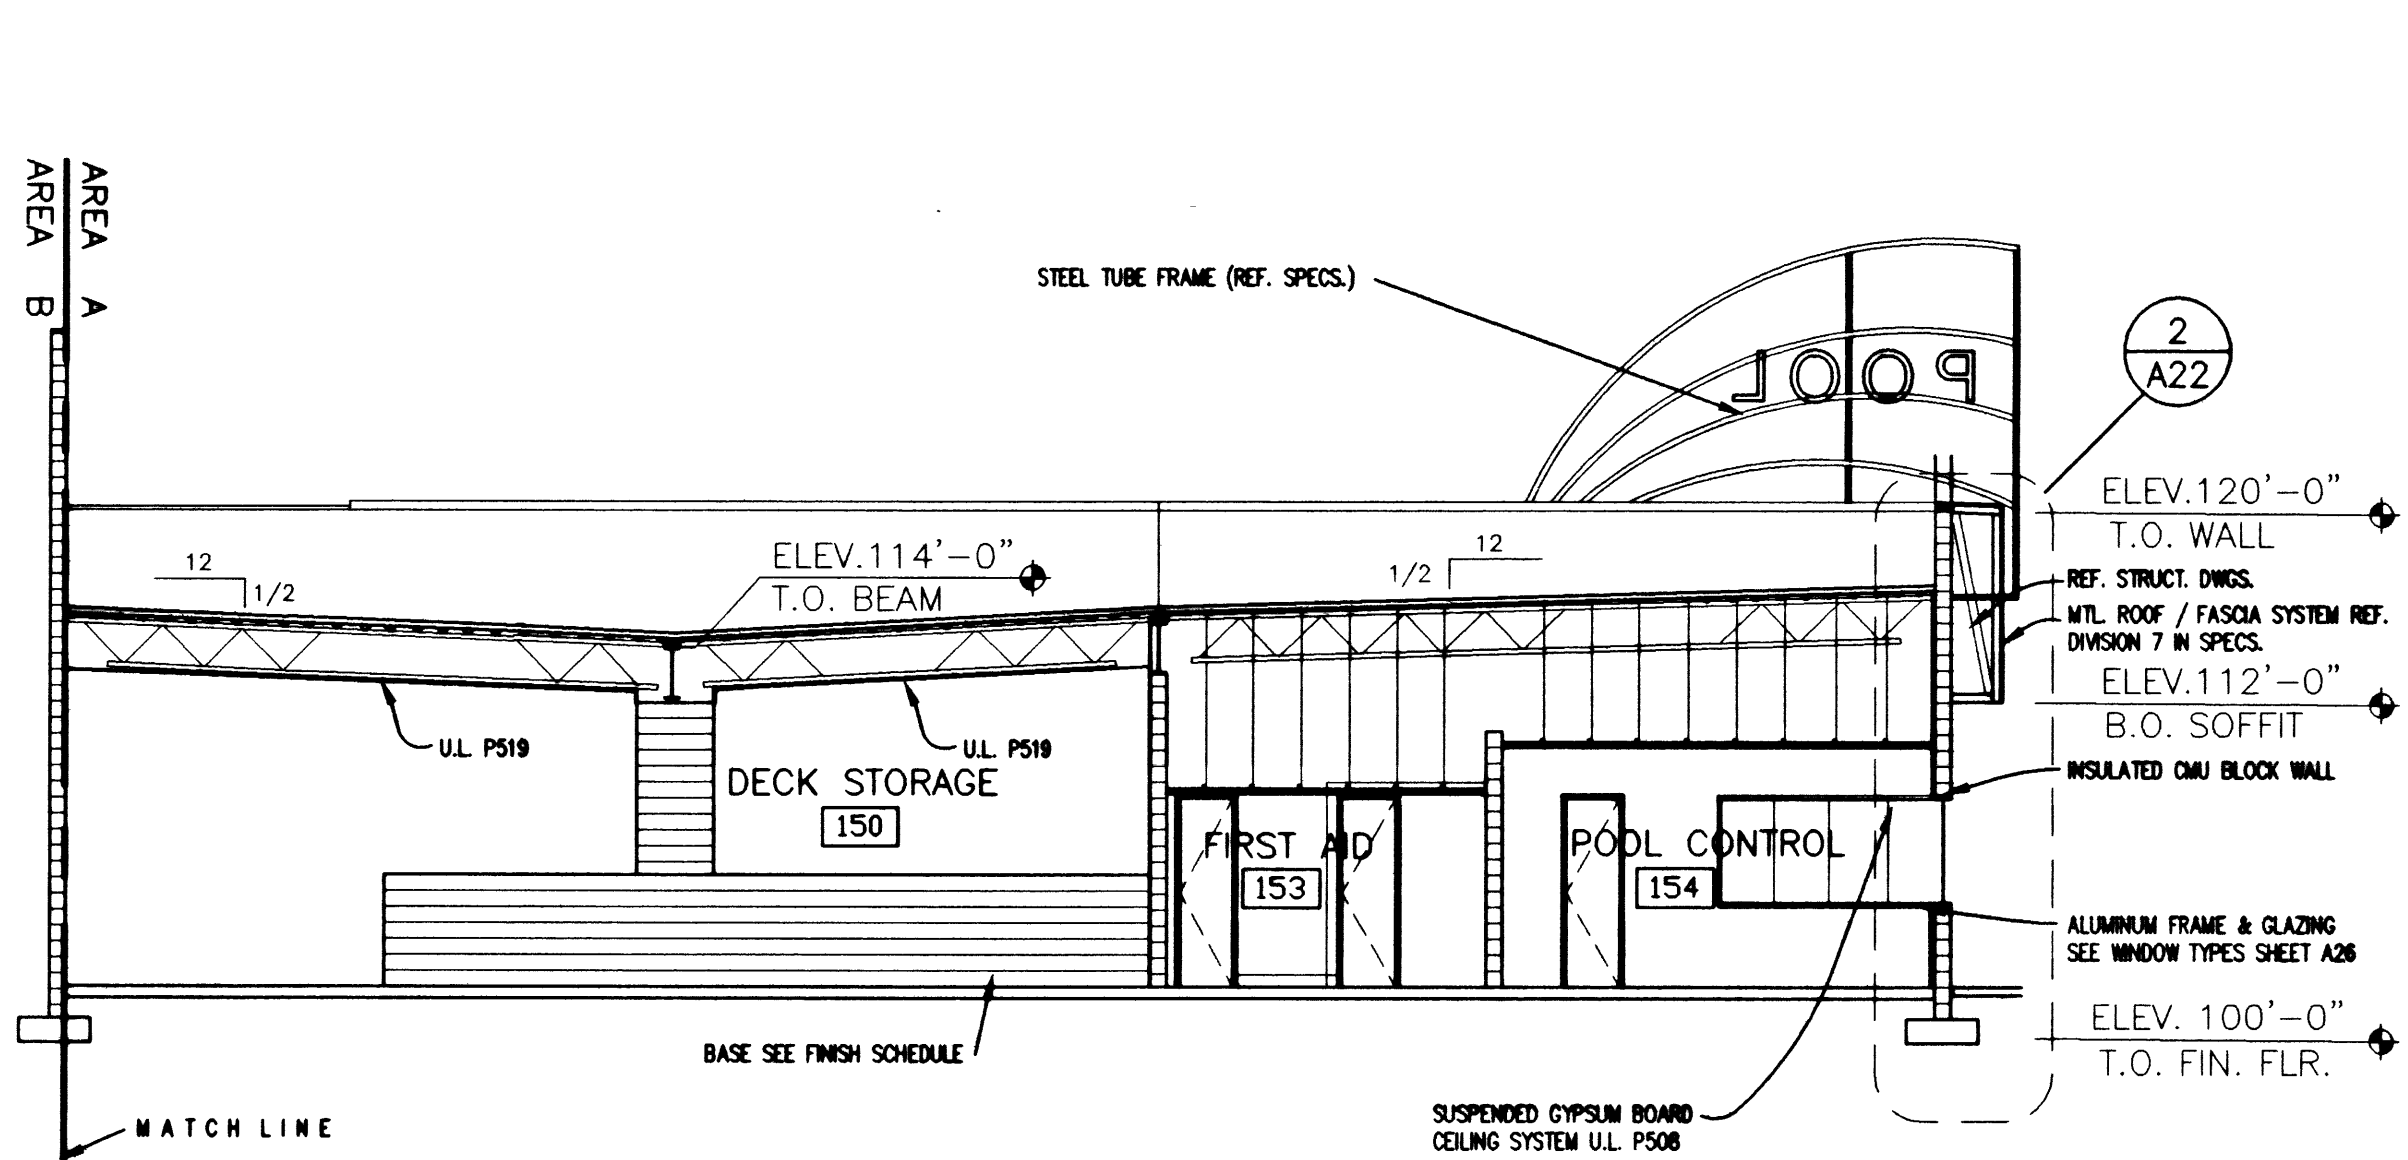

G BUILDING SECTION
SCALE: 1/8" = 1'-0"

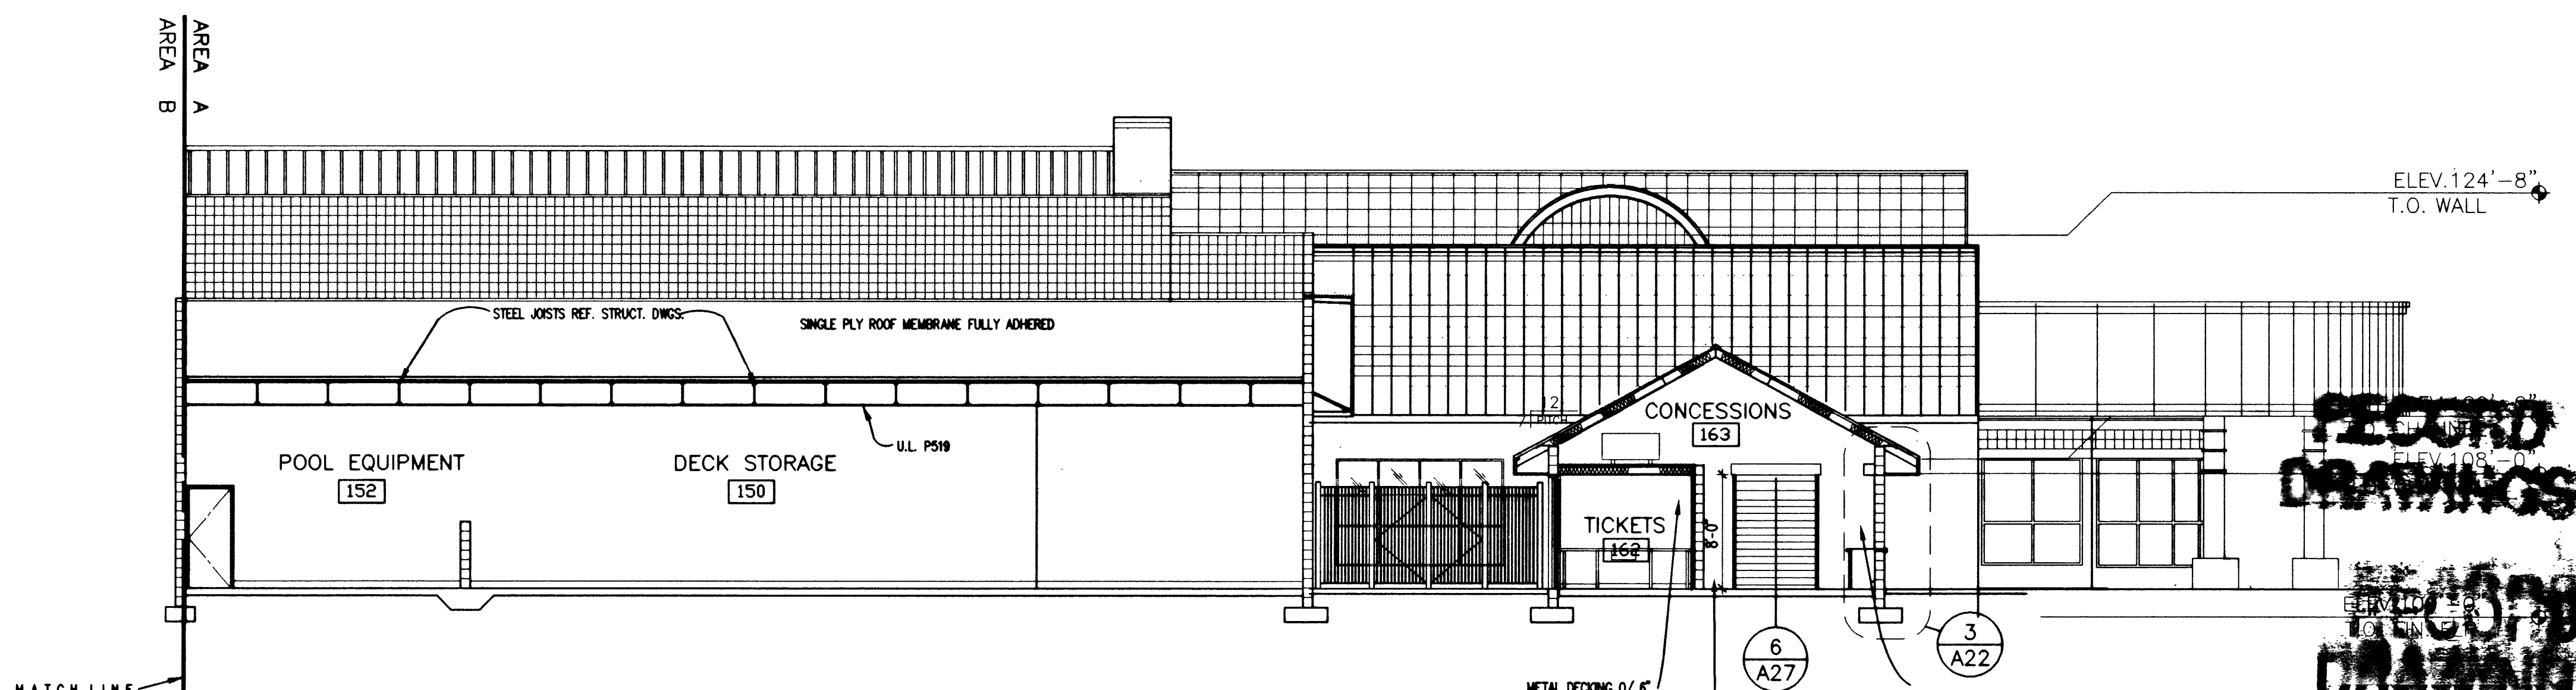

H BUILDING SECTION
SCALE: 1/8" = 1'-0"

DATE	
DESCRIPTION	
REVISION	
WAYNE SCHREINER AIA	THOMAS M. SILVA AIA
1525 WEST OAKLEY BLVD. LAS VEGAS, NV 89102 (702) 383-0077 FAX (702) 383-0087	HSA ARCHITECTS
BUILDING SECTIONS	Verify all Dimensions and Conditions at the Site
Street Title	CITY OF LAS VEGAS DEPARTMENT OF PARK AND LEISURE ACTIVITIES DURANGO RECREATION FACILITY
Job Title	
Job	960901
Date	20 FEB. 1998
Drawn By	CRL
Check	WPS
Sheet	A8
	52 of 118 650.59
	92 116 11 of 36
	650.59

27664 S

Any use or reproduction of this document or the attached drawings, or the use of the design approach, ideas or concepts described in this document and the attached drawings, in whole or in part by any person whatsoever is strictly prohibited except by the written consent of HSA Architects, Inc. 
COPYRIGHT 1997, HSA ARCHITECTS, INC.