




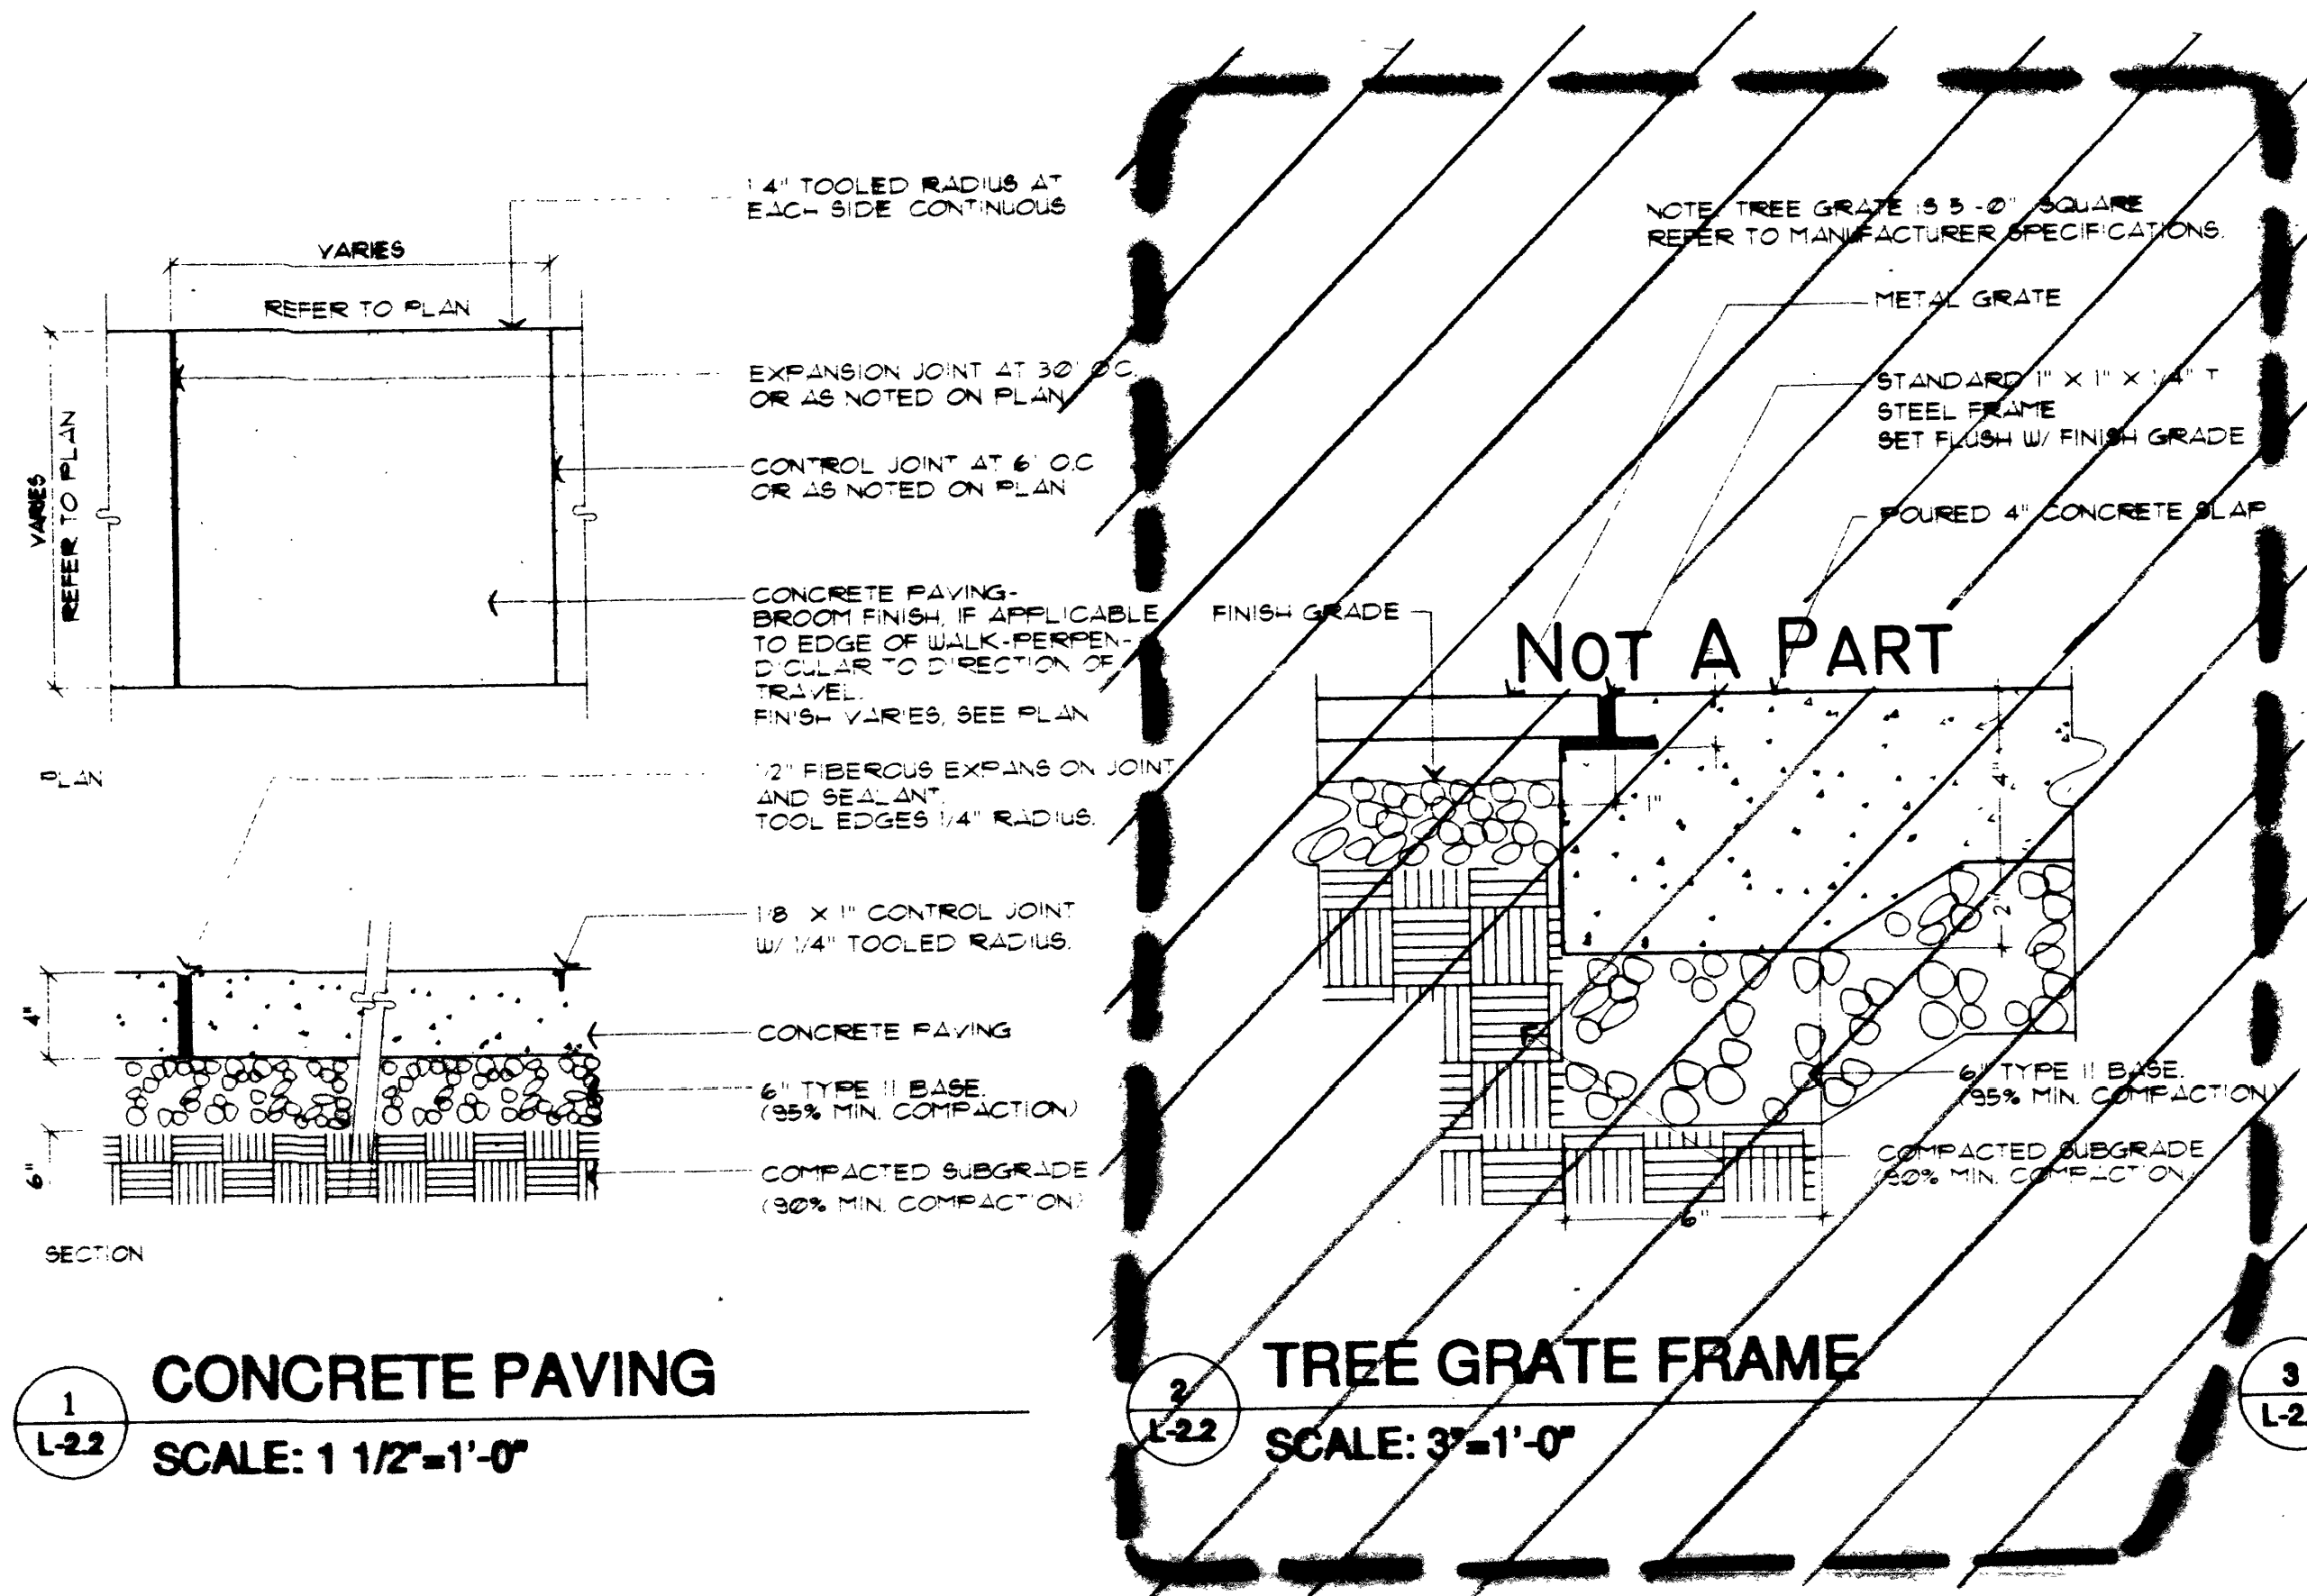

1 CONCRETE PAVING
SCALE: 1 1/2"=1'-0"

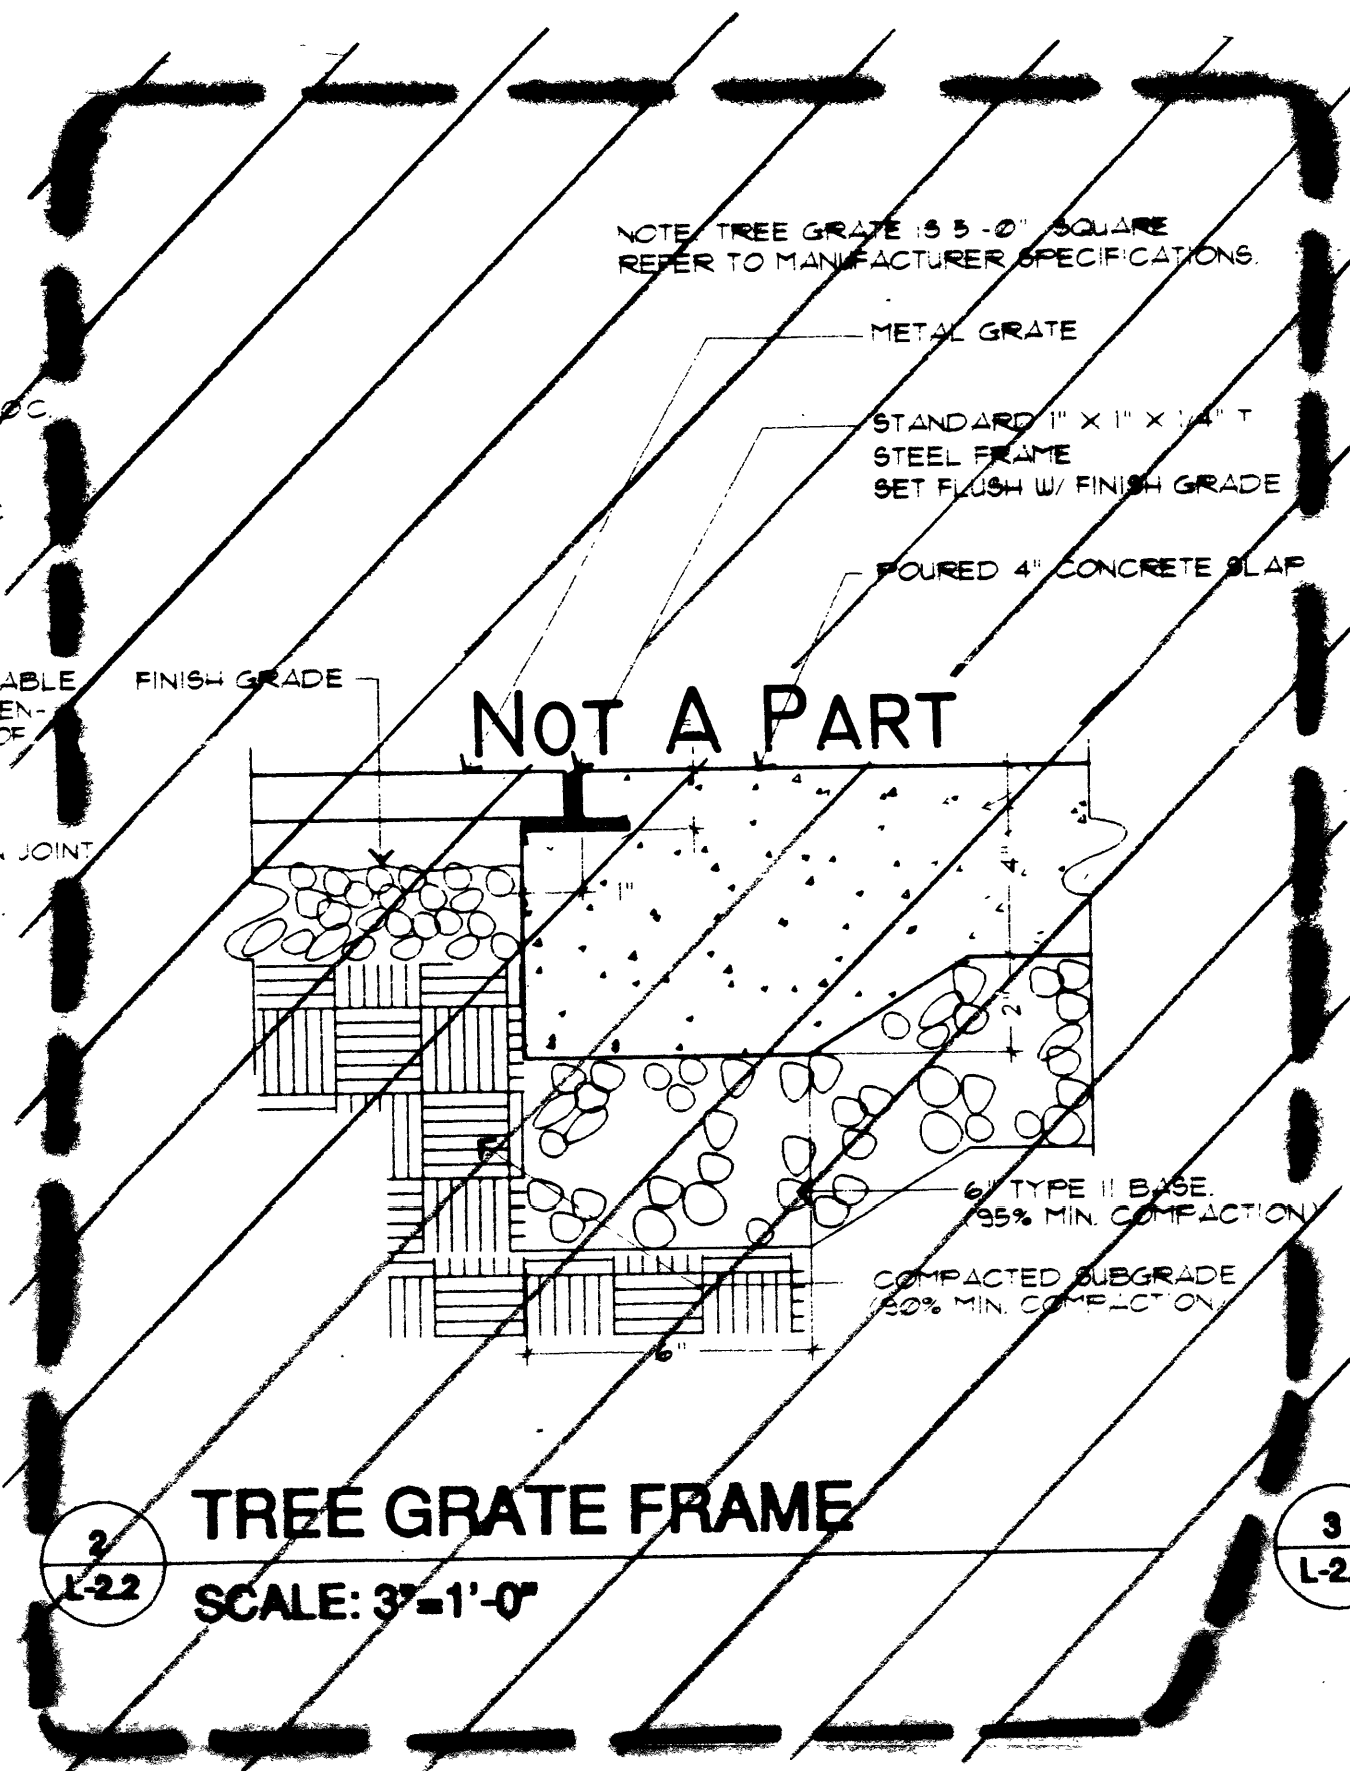


2 TREE GRATE FRAME
SCALE: 3"=1'-0"


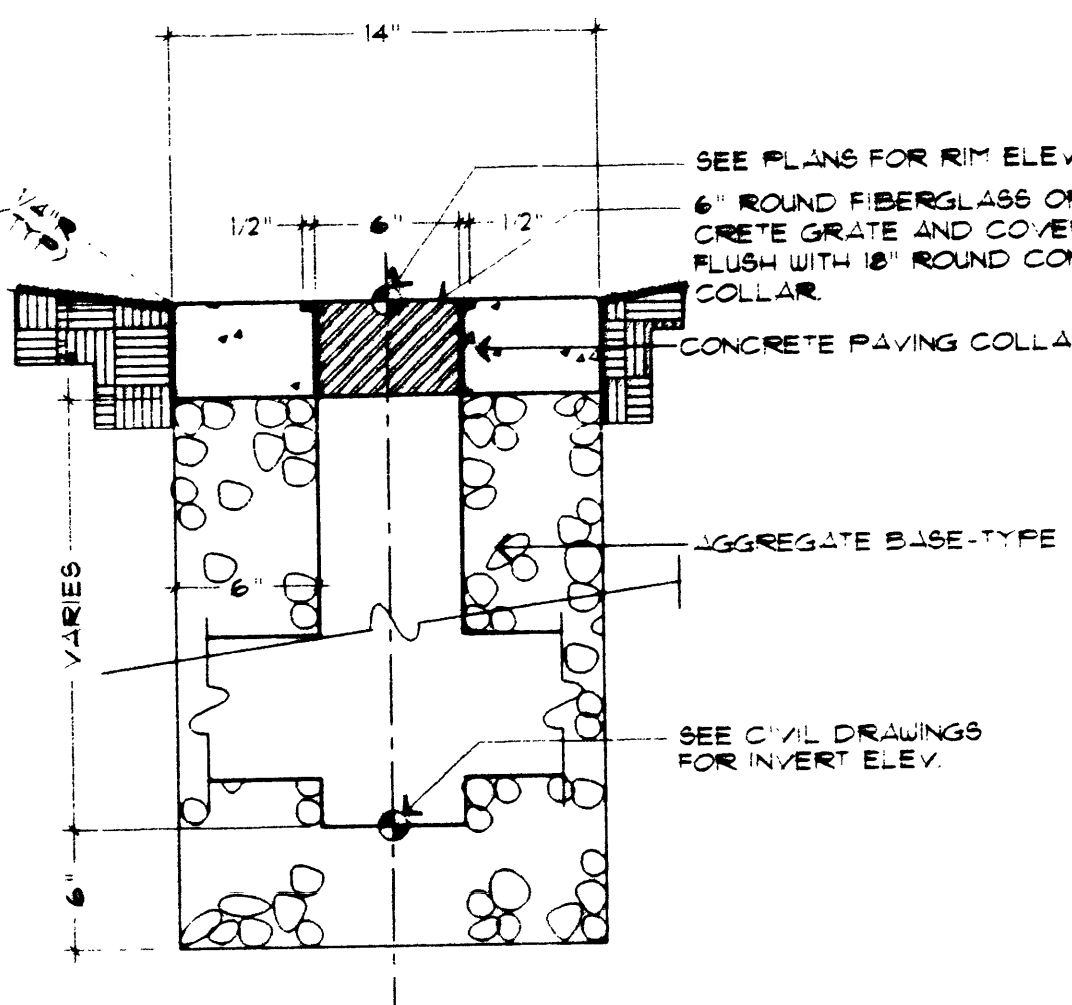


3 CATCH BASIN IN LAWN
SCALE: 1 1/2"=1'-0"


4 CONCRETE HEADER
SCALE: 1"=1'-0"

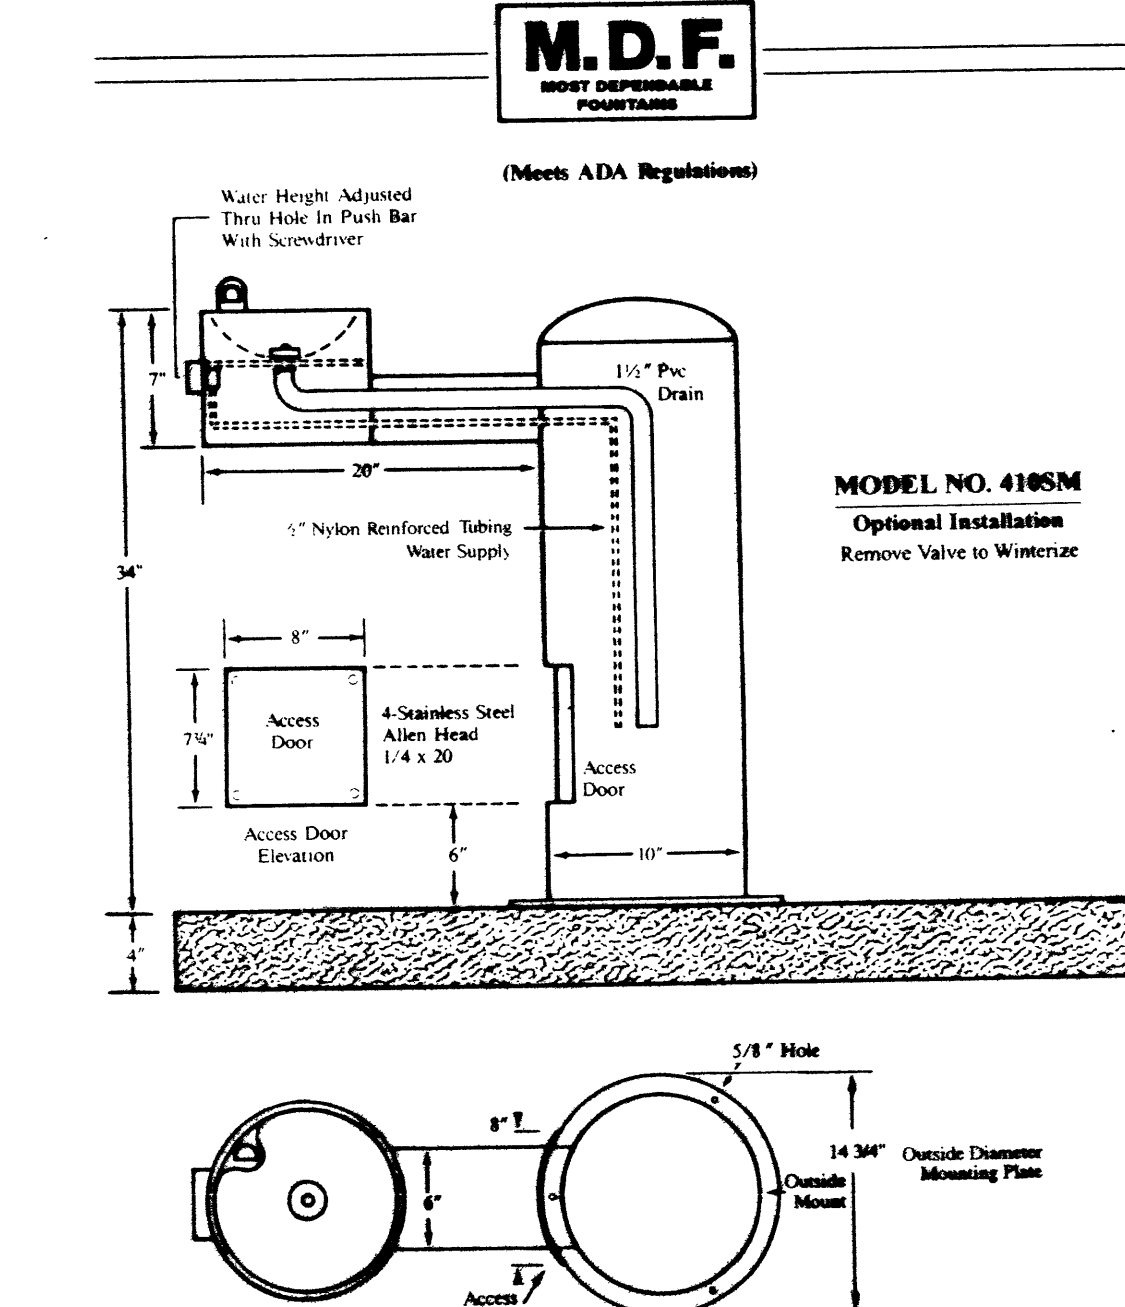


5 F.G. @ CURB AND WALKWAY
SCALE: 1"=1'-0"

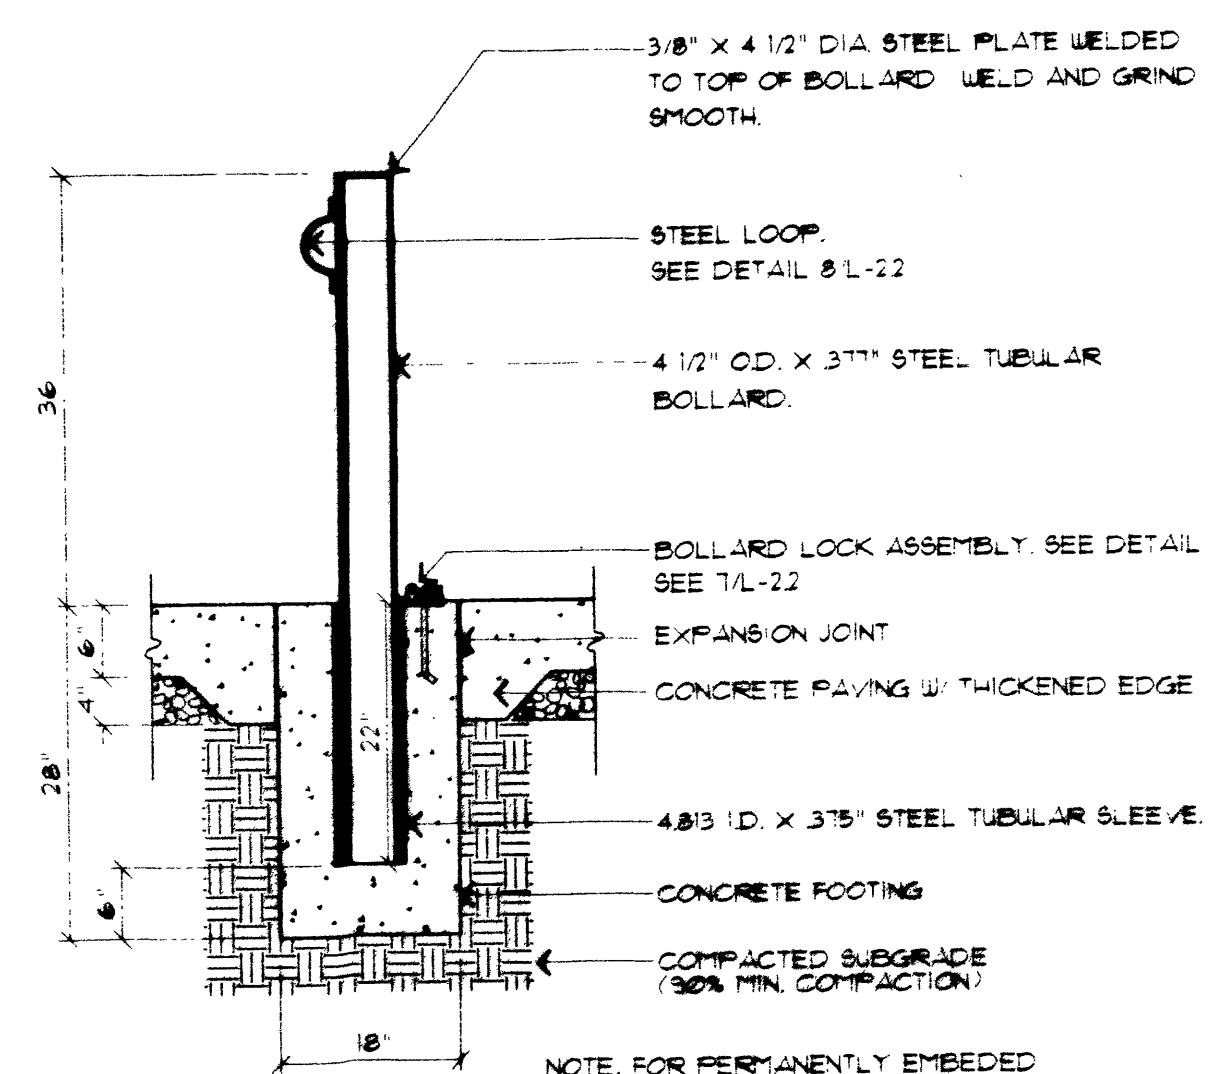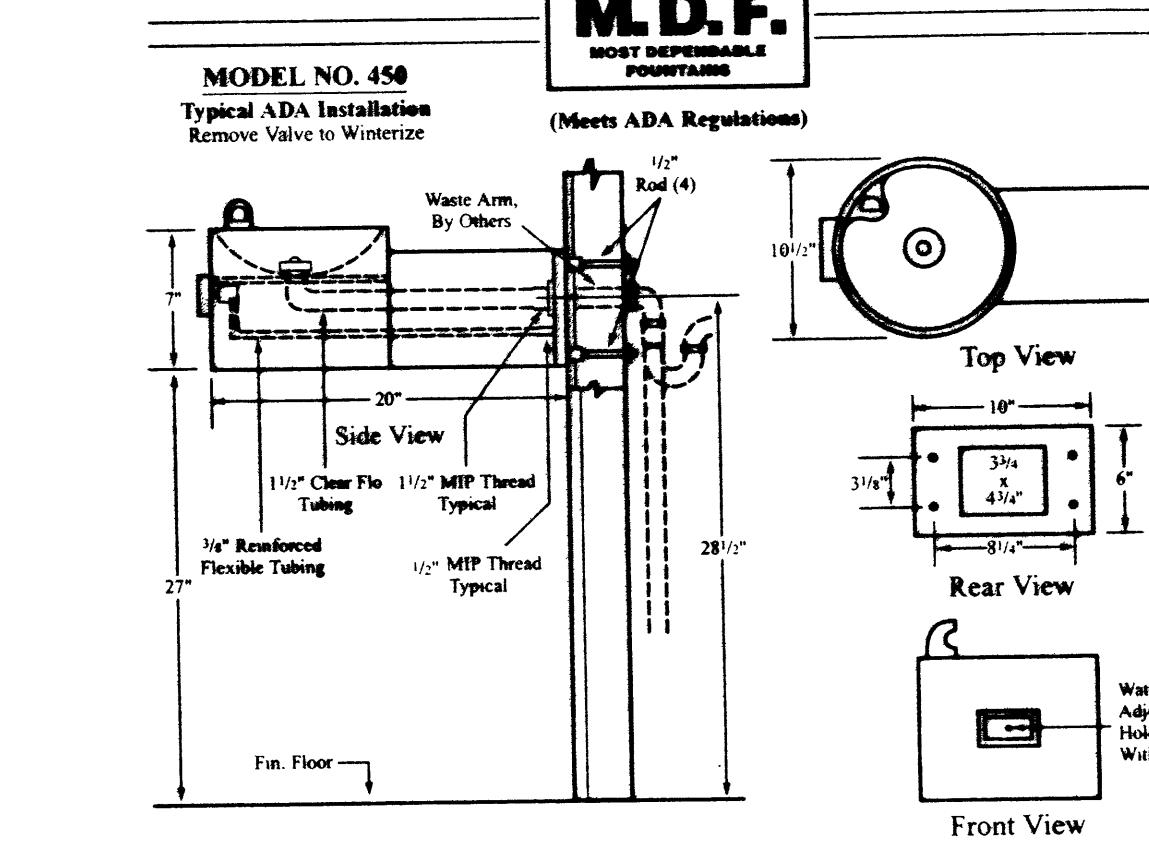

6 LOCKING BOLLARD
SCALE: 3/4"=1'-0"

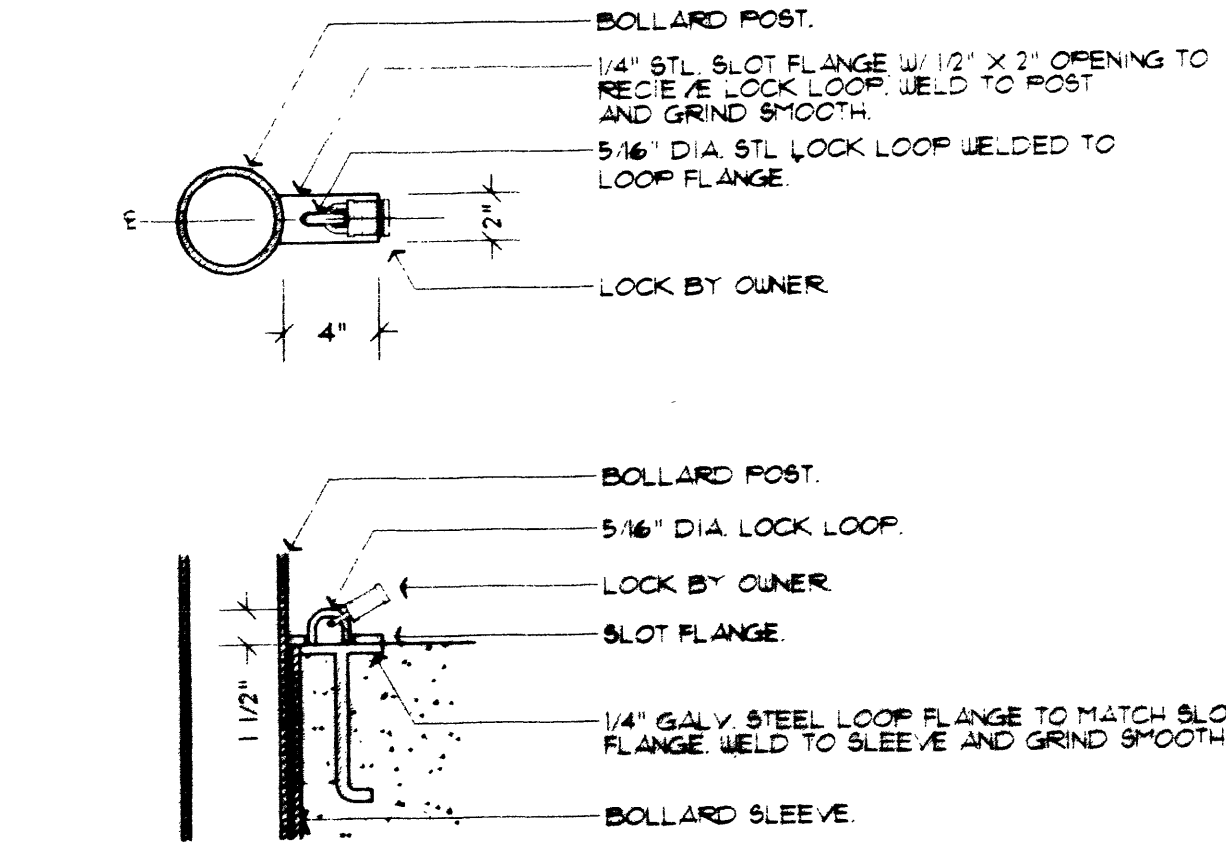


7 BOLLARD LOCK
SCALE: 1 1/2"=1'-0"


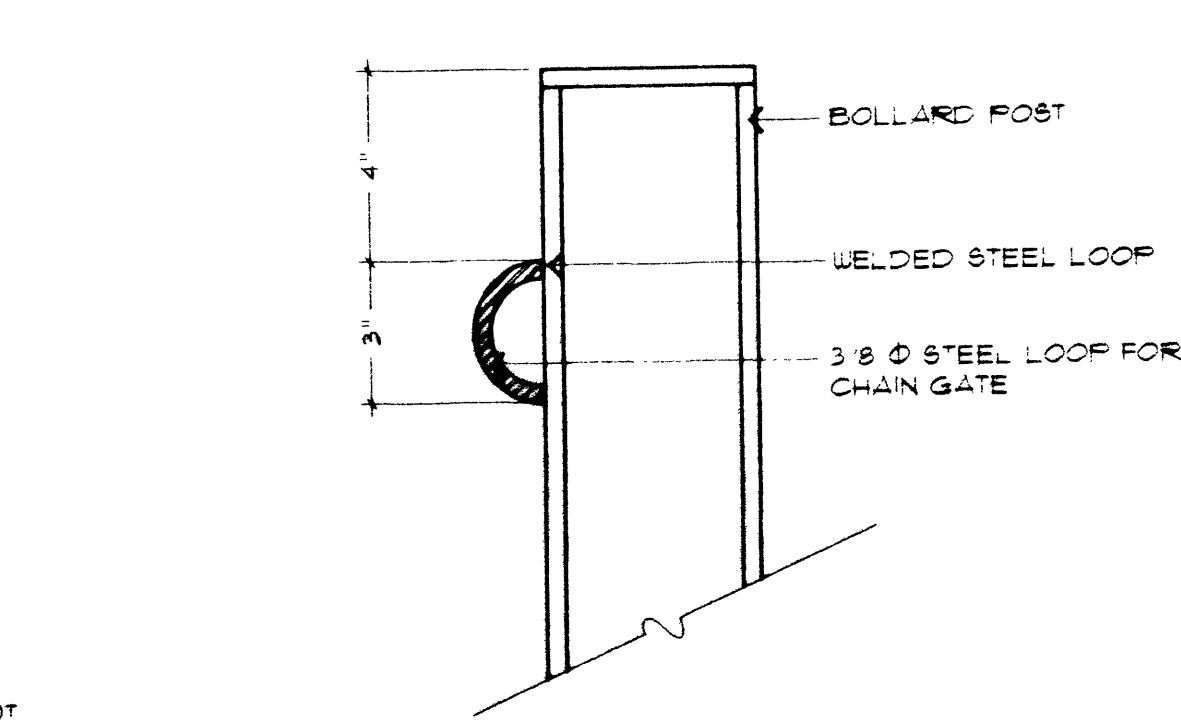


8 STEEL LOOP @ BOLLARD
SCALE: 3"=1'-0"

9 DRINKING FOUNTAIN-WALL MNT.
SCALE: NTS

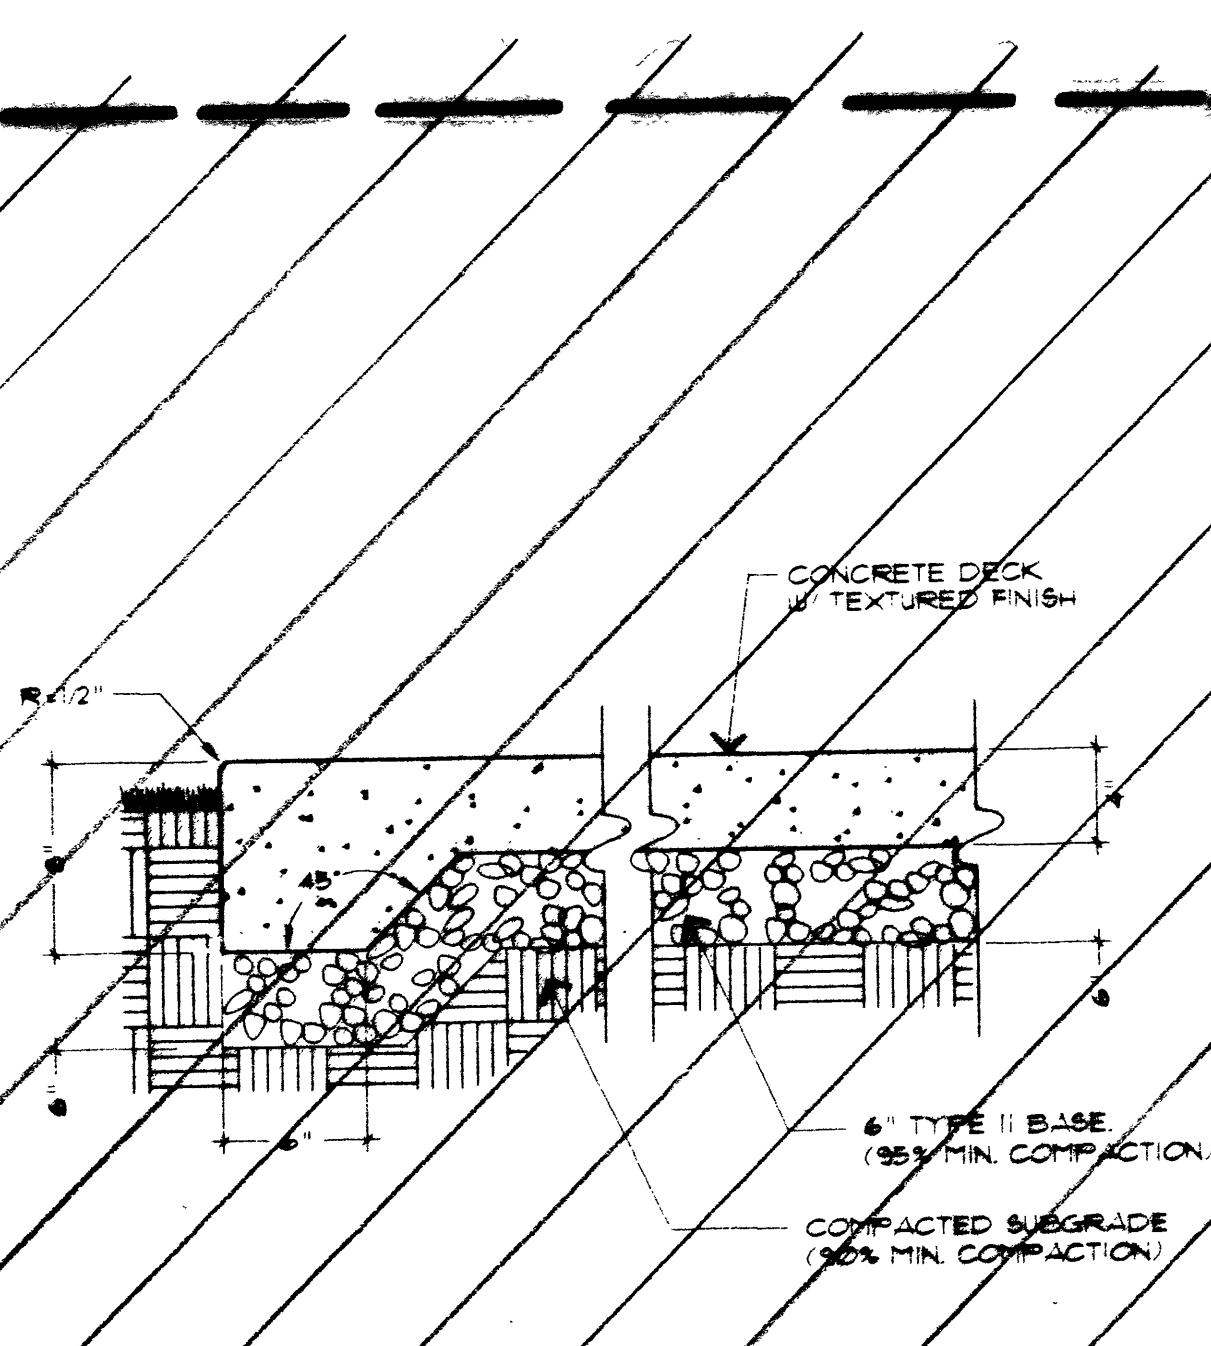

10 DRINKING FOUNTAIN-PEDESTAL
SCALE: NTS

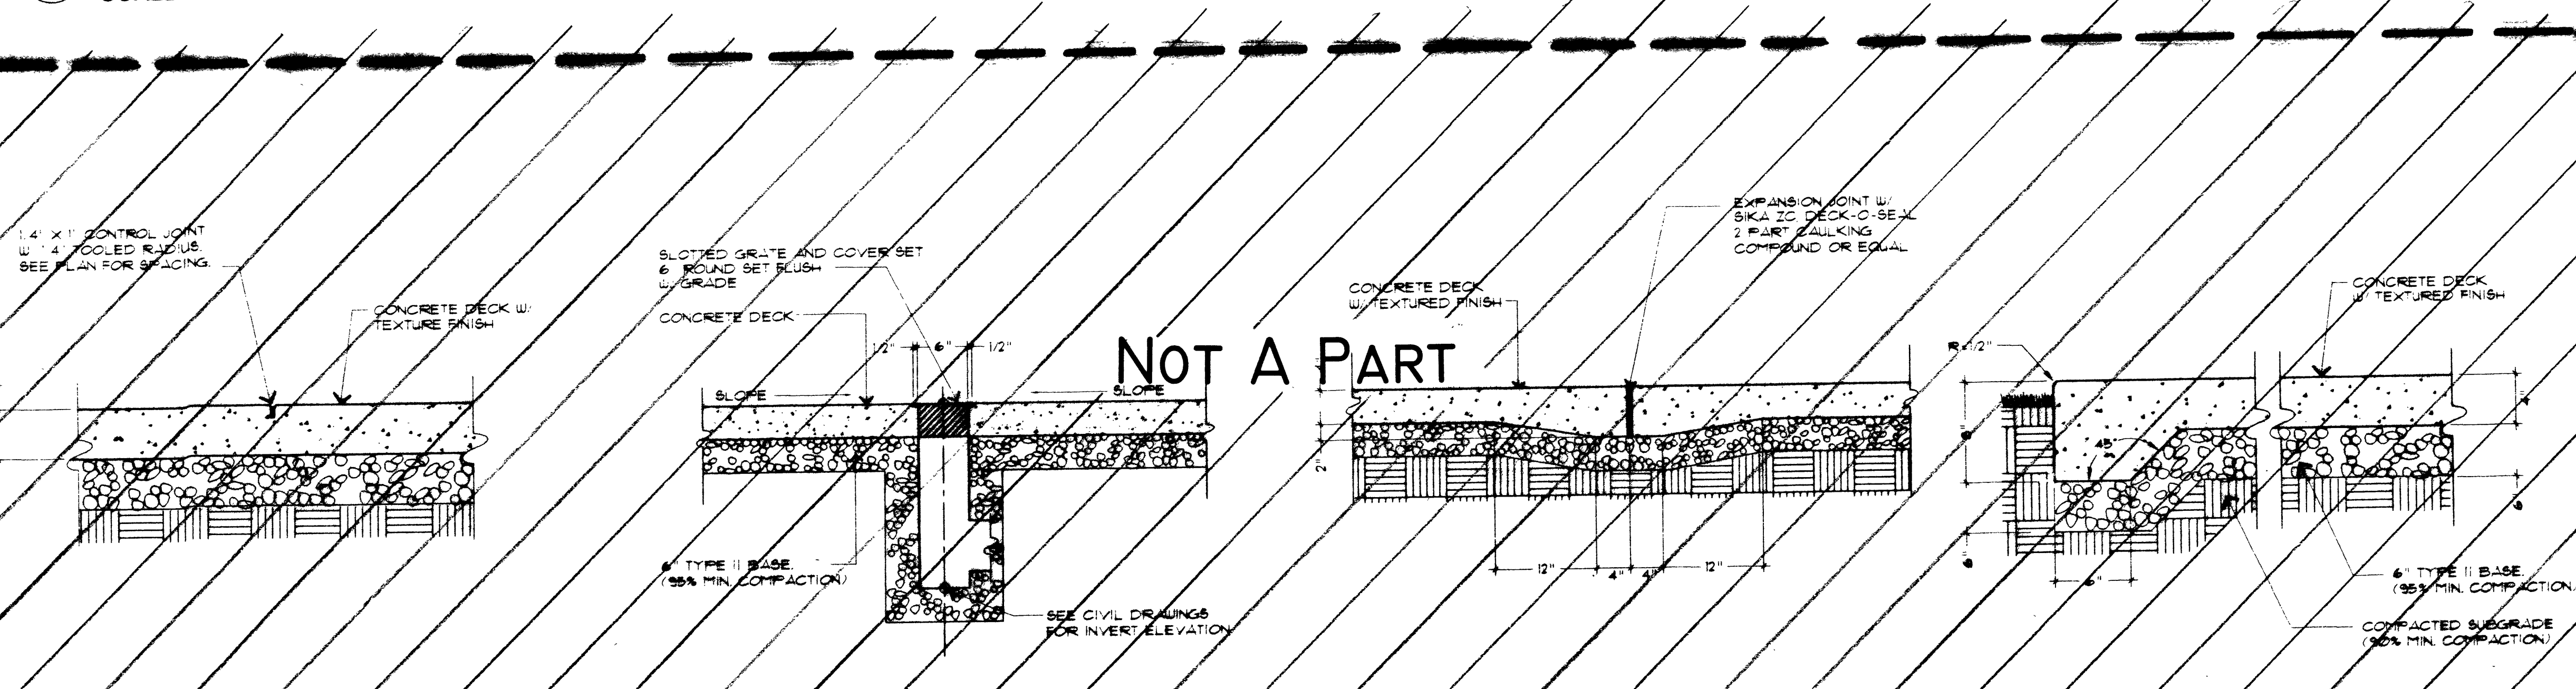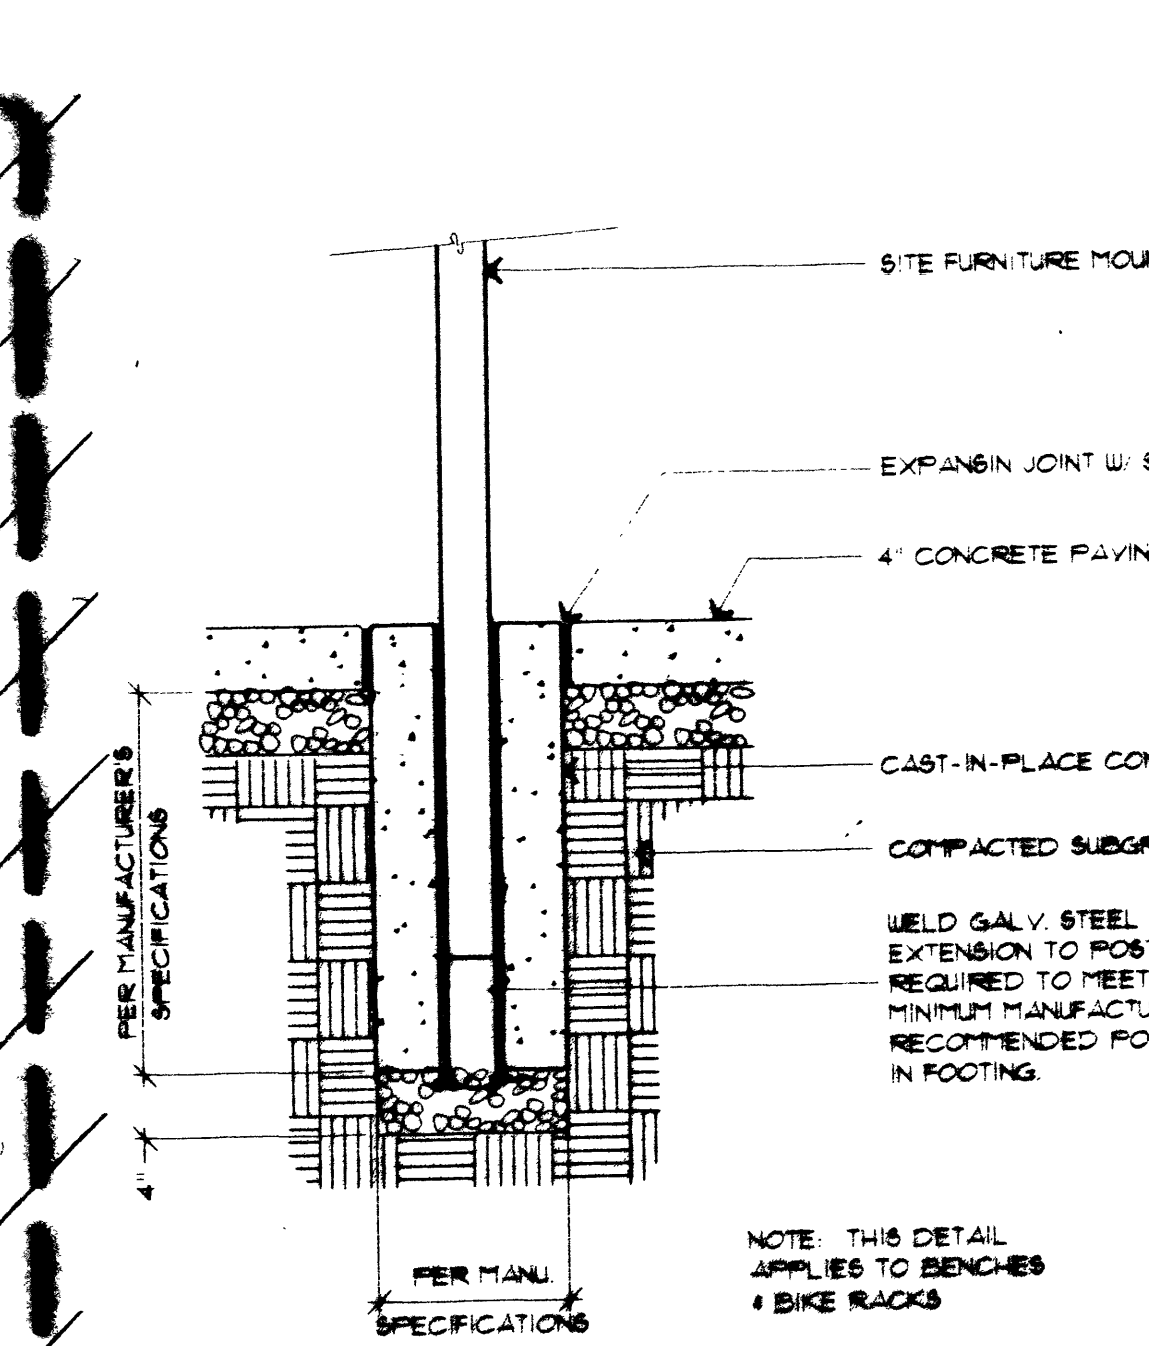

11 POOL DECK SCORE JOINT
SCALE: 1 1/2"=1'-0"

12 POOL DECK DRAIN
SCALE: 1"=1'-0"

13 POOL DECK EXP. JOINT
SCALE: 1"=1'-0"

14 POOL DECK AND TURNDOWN
SCALE: 1 1/2"=1'-0"

15 SITE FURNITURE MOUNT
SCALE: 1"=1'-0"

