


CONSTRUCTION NOTES

No.	DESCRIPTION
1	CURB & GUTTER "L" TYPE CC STD DWG 216
2	CROSS GUTTER CC STD DWG 228
3	ROLL CURB-24" CC STD DWG 217
4	"A" TYPE ISLAND CURB SECTION CC STD DWG 219
5	"L" CURB SECTION CC STD DWG 219
6	COMMERCIAL/ INDUSTRIAL DWY CC STD DWG 224
7	SIDEWALK RAMP CASE II CC STD DWG 235
8	SIDEWALK DRAIN-3 EACH CC STD DWG 236
9	SIDEWALK RAMP CASE I CC STD DWG 235
10	SIDEWALK CC STD DWG 234 WIDTH PER PLAN
11	BUS TURN OUT CC STD DWG 234.1
12	"L" CURB SECTION (HOLDING) GUTTER NO REQUIRED CC STD DWG 219



8 OF 118
650.59

 

This drawing is the property of HARDING LAWSON ASSOCIATES, including all patented and patentable features, and/or confidential information and its use is conditioned upon the user's agreement not to reproduce the drawing, in whole or part, nor the material described therein, nor the use of the drawing for any purpose other than specifically permitted in writing by HARDING LAWSON ASSOCIATES.

NO.	DATE	REVISIONS	BY	CHK
1	7-10-97		JHM	GAH

DRAWN:	RLR	PROJECT NO.:	41712	FILE NAME:	EDGRADE1.DWG
ENGINEER:	DAE	SCALE:	1"=30'		
CHECKED:	SWJ	APPROVED:	JHM		
DATE:	10-30-97	DATE:	7-17-98		

Harding Lawson Associates
Engineering and Environmental Services
5145 S. Arville St. Ste. A
Las Vegas, Nevada
(702) 251-5449

NORTHWEST FAMILY RECREATION CENTER
CITY OF LAS VEGAS
400 E. STEWART AVENUE
LAS VEGAS, NEVADA

GRADING PLAN	
DRAWING:	C7
SHEET:	6 OF 118
REVISION NUMBER:	
DATE:	