


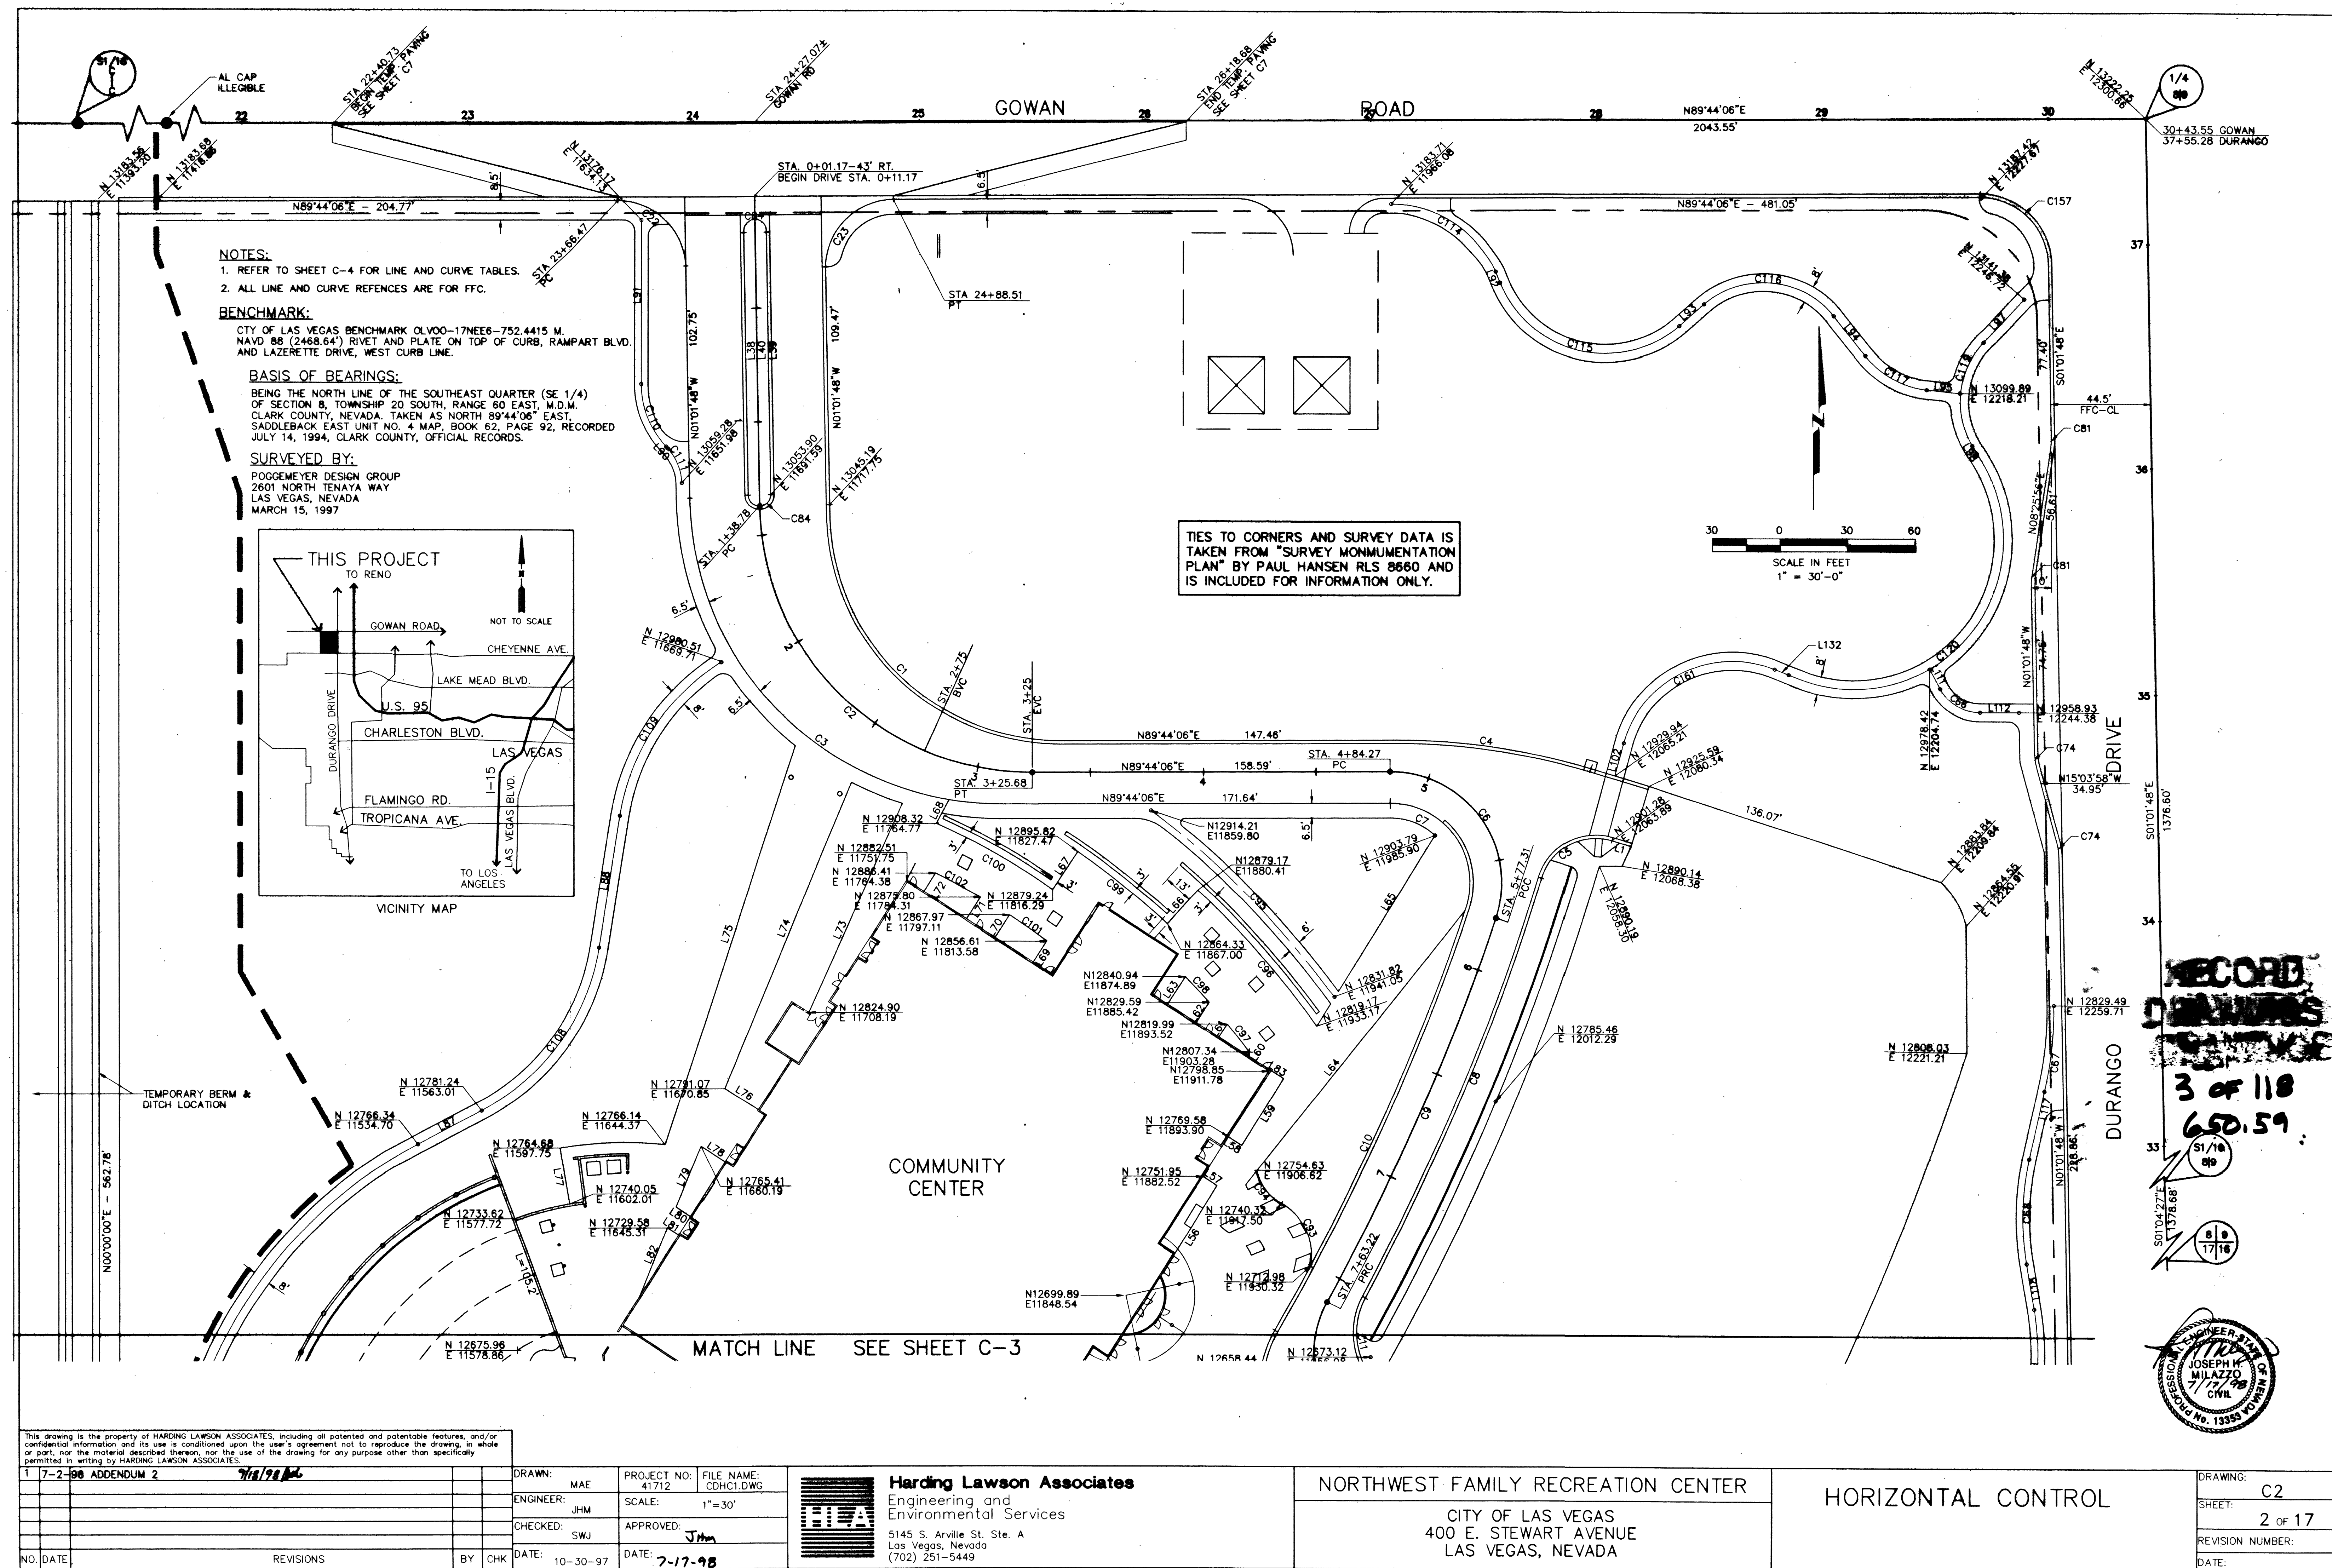

27015