

**NORTHWEST
 FAMILY
 RECREATIONAL
 COMPLEX**
 CITY OF
 LAS VEGAS, NEVADA



23 of 118
 650.59
**POOL
 ENLARGEMENT
 PLAN**


CONSTRUCTION DOCUMENTS

ISSUE DATE: 2/19/98
 DRAWN: JA REVIEWED: DD
 REVISIONS/DESCRIPTION:
 REV. FINAL SUBMITTAL: 1/12/98
 CHANGE ORDER PROPOSAL: 7/27/1998

SYMBOL LEGEND

- TW — TOP OF WALL
- TC — TOP OF CONCRETE
- TF — TOP OF FENCE
- FG — TOP OF FINISH GRADE
- RIM ELEV. — RIM ELEVATION
- UMBRELLA SLEEVE IN CONCRETE
- UMBRELLA SLEEVE IN LAWN
- UMBRELLA SLEEVE IN CONCRETE
- LIMIT OF POOL PAVING

PROJECT KEY MAP NT 3

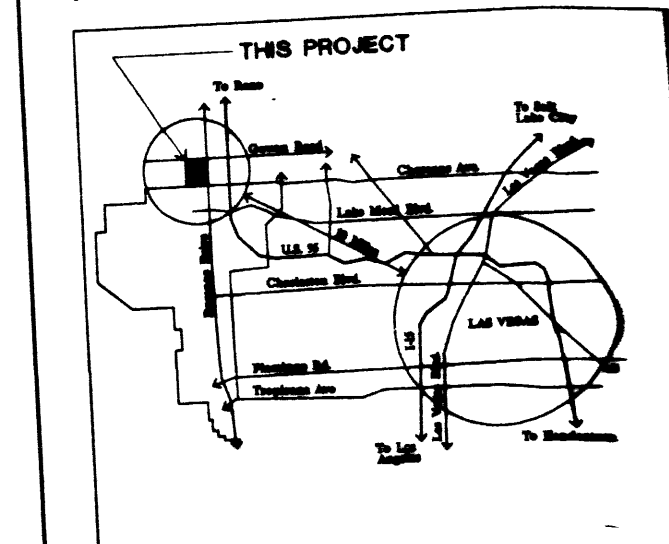


Scale: 1/16" = 1'-0" North

SHEET NUMBER
L-1.5

Design Workshop, Inc. ©

23 of 118
 650.59

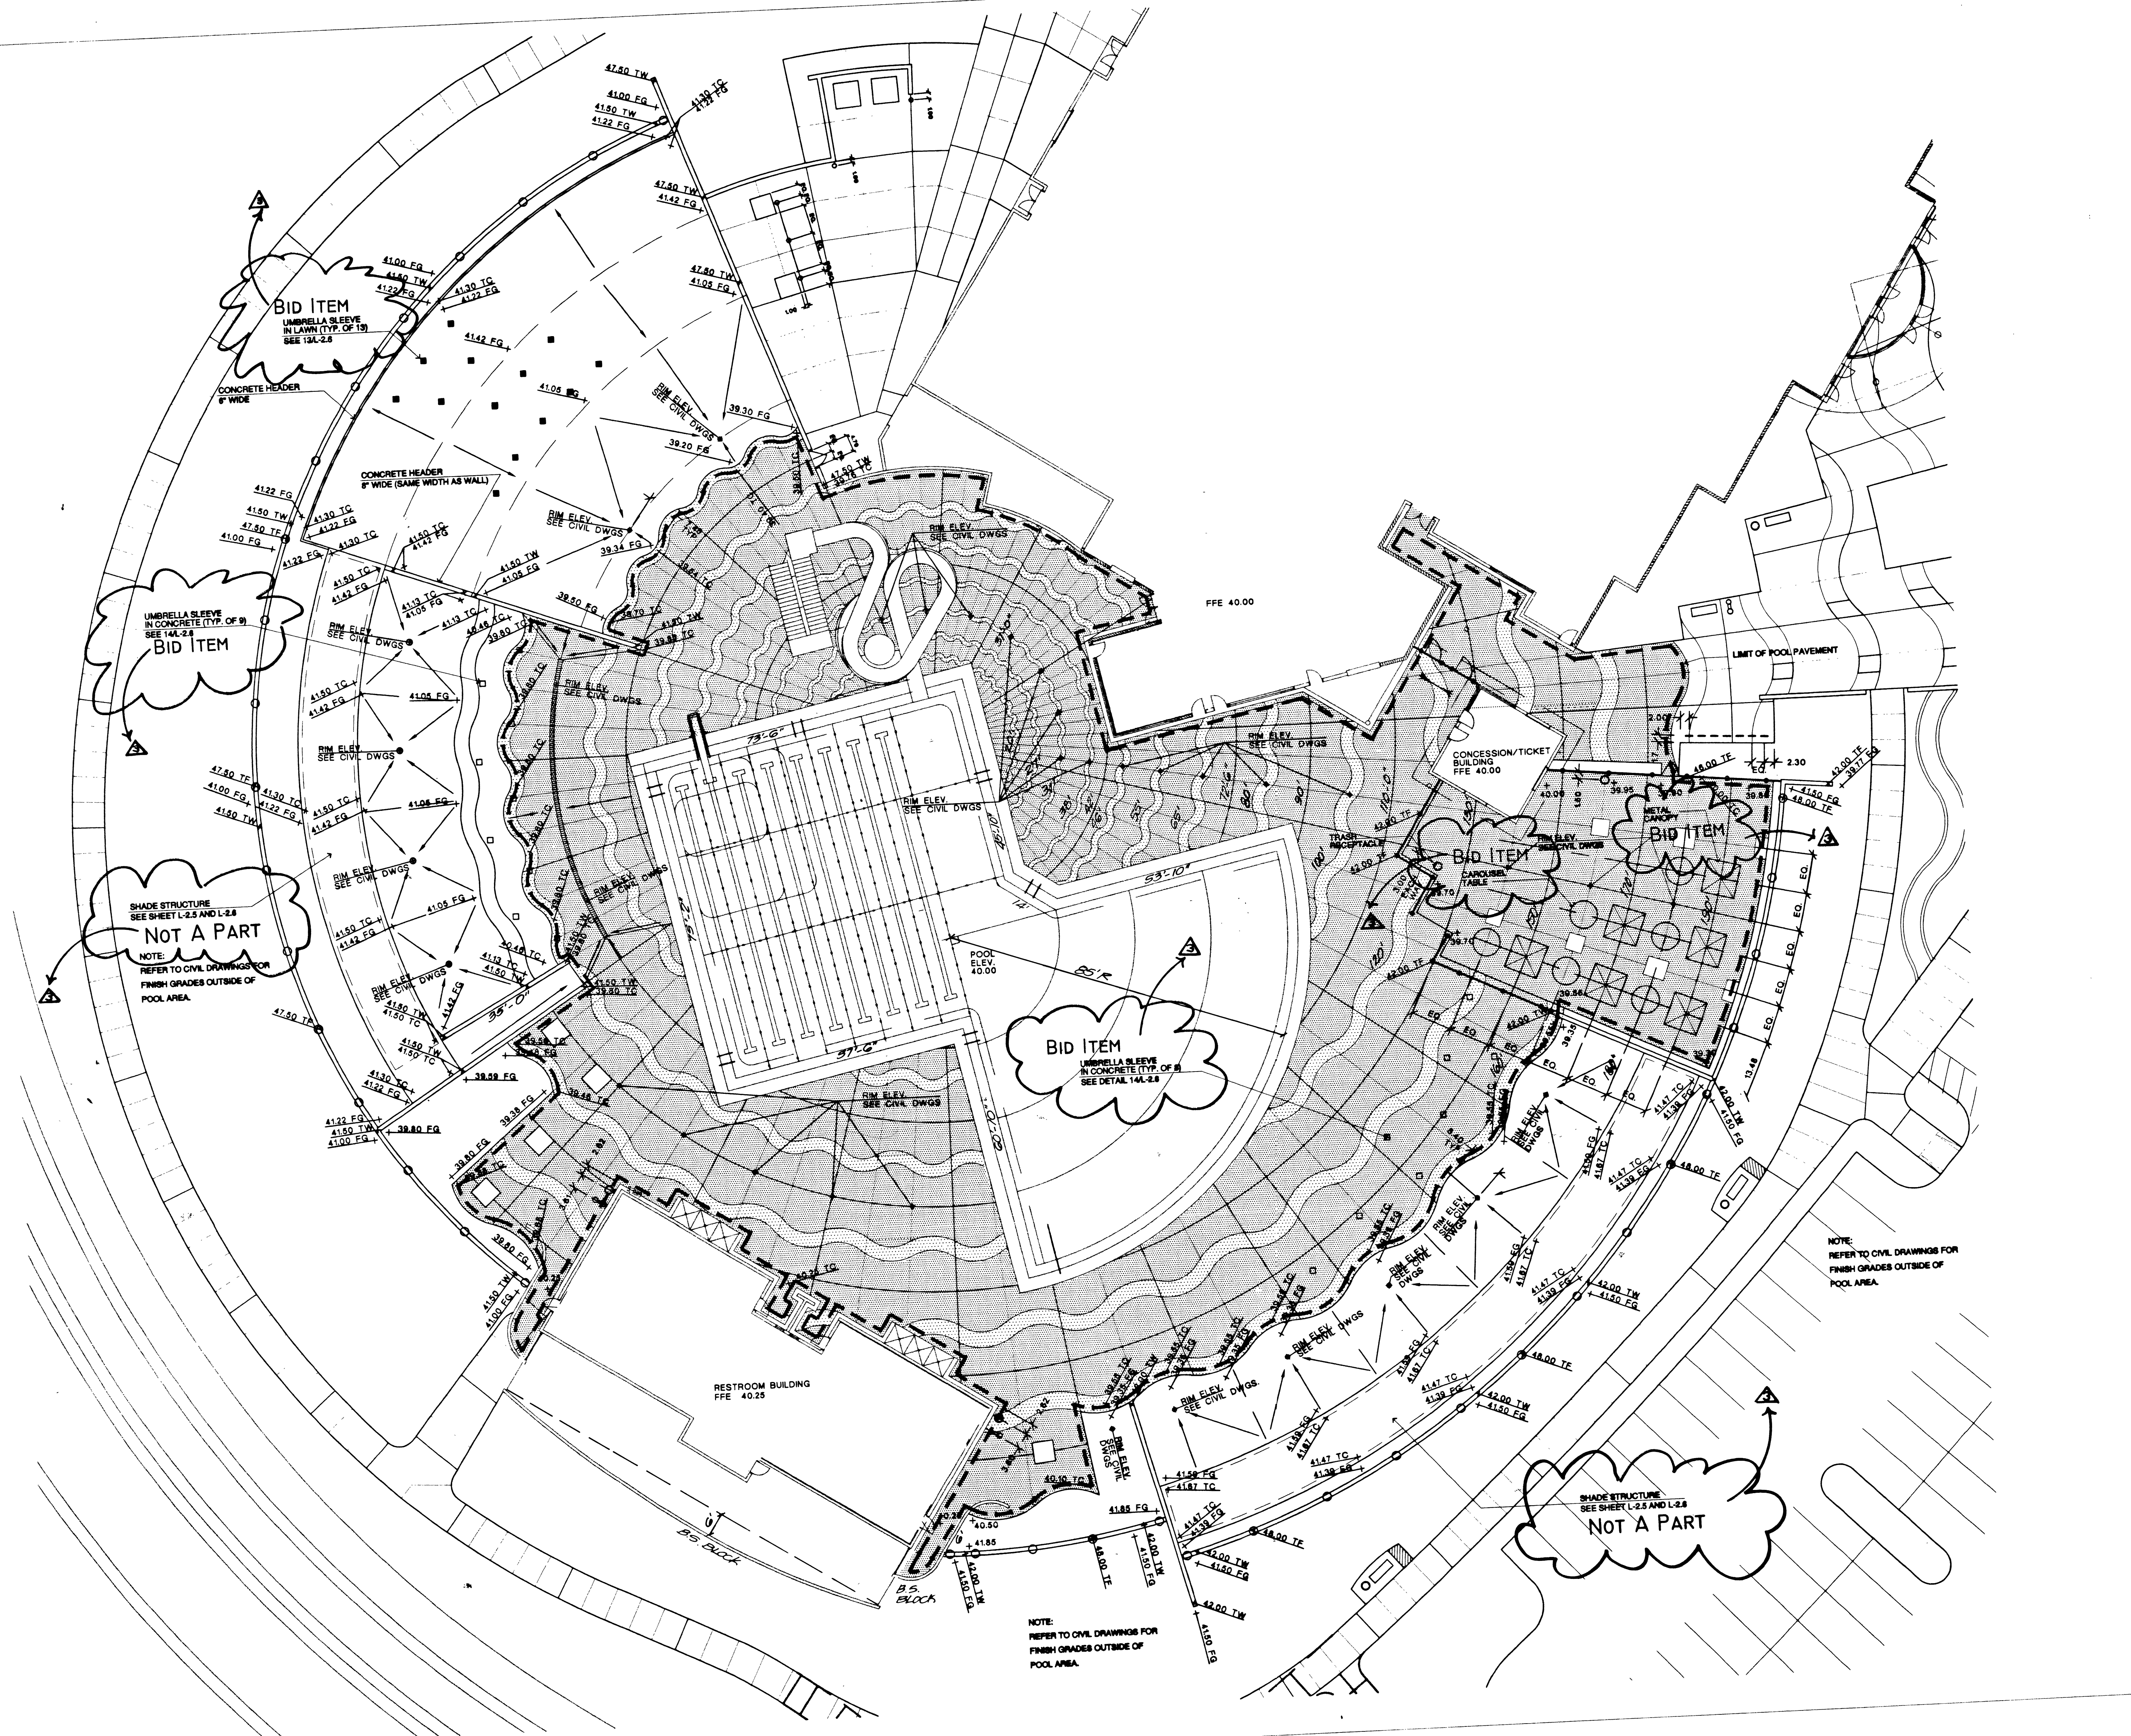

NOTE:
 REFER TO CIVIL DRAWINGS FOR
 FINISH GRADES OUTSIDE OF
 POOL AREA.

NOTE:
 REFER TO CIVIL DRAWINGS FOR
 FINISH GRADES OUTSIDE OF
 POOL AREA.

SHADE STRUCTURE
 SEE SHEET L-2.5 AND L-2.8
NOT A PART
 NOTE:
 REFER TO CIVIL DRAWINGS FOR
 FINISH GRADES OUTSIDE OF
 POOL AREA.

BID ITEM
 UMBRELLA SLEEVE
 IN CONCRETE (TYP. OF 6)
 SEE DETAIL 144-2.8

BID ITEM
 UMBRELLA SLEEVE
 IN LAWN (TYP. OF 19)
 SEE DETAIL 144-2.5

BID ITEM
 UMBRELLA SLEEVE
 IN CONCRETE (TYP. OF 9)
 SEE DETAIL 144-2.8

SHADE STRUCTURE
 SEE SHEET L-2.5 AND L-2.8
NOT A PART

DESIGN WORKSHOP, INC. RETAINS ALL PROPERTY RIGHTS TO ORIGINAL CONSTRUCTION PLANS AND WORK PREPARED BY DESIGN WORKSHOP, INC. NO PART OF THE DRAWINGS SHALL BE USED OR REPRODUCED WITHOUT WRITTEN CONSENT FROM DESIGN WORKSHOP, INC.