


CONSULTANT:

**NORTHWEST
 FAMILY
 RECREATIONAL
 COMPLEX**
 CITY OF
 LAS VEGAS, NEVADA

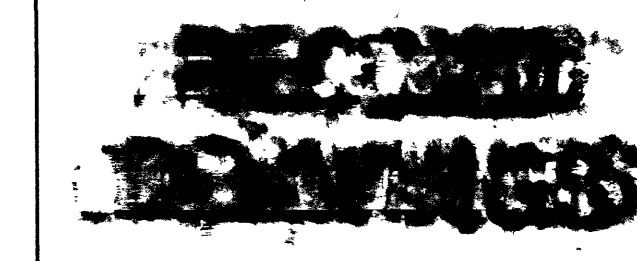

28 of 118

650.59


SITE DETAILS

CONSTRUCTION DOCUMENTS

ISSUE DATE: 2/18/98
 DRAWN: JA REVIEWED: DD

REVISIONS/DESCRIPTION
 CHANGE ORDER PROPOSAL 7/27/1998

PROJECT KEY MAP: NTS

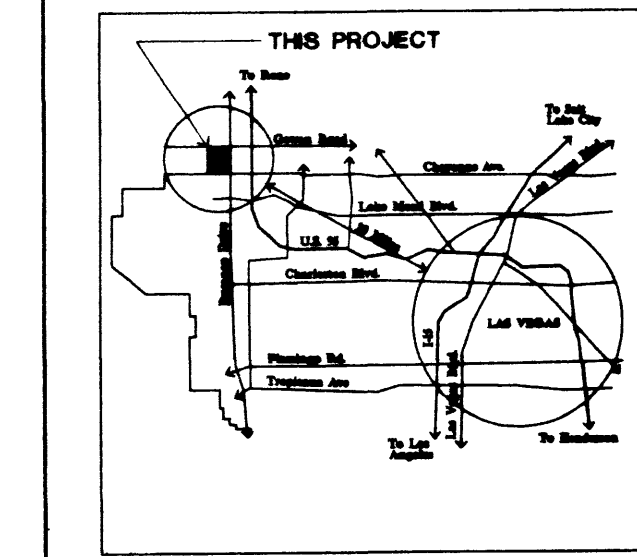


Scale: NTS North

SHEET NUMBER


L-2.5

Design Workshop, Inc. ©


28 of 118
 650.59

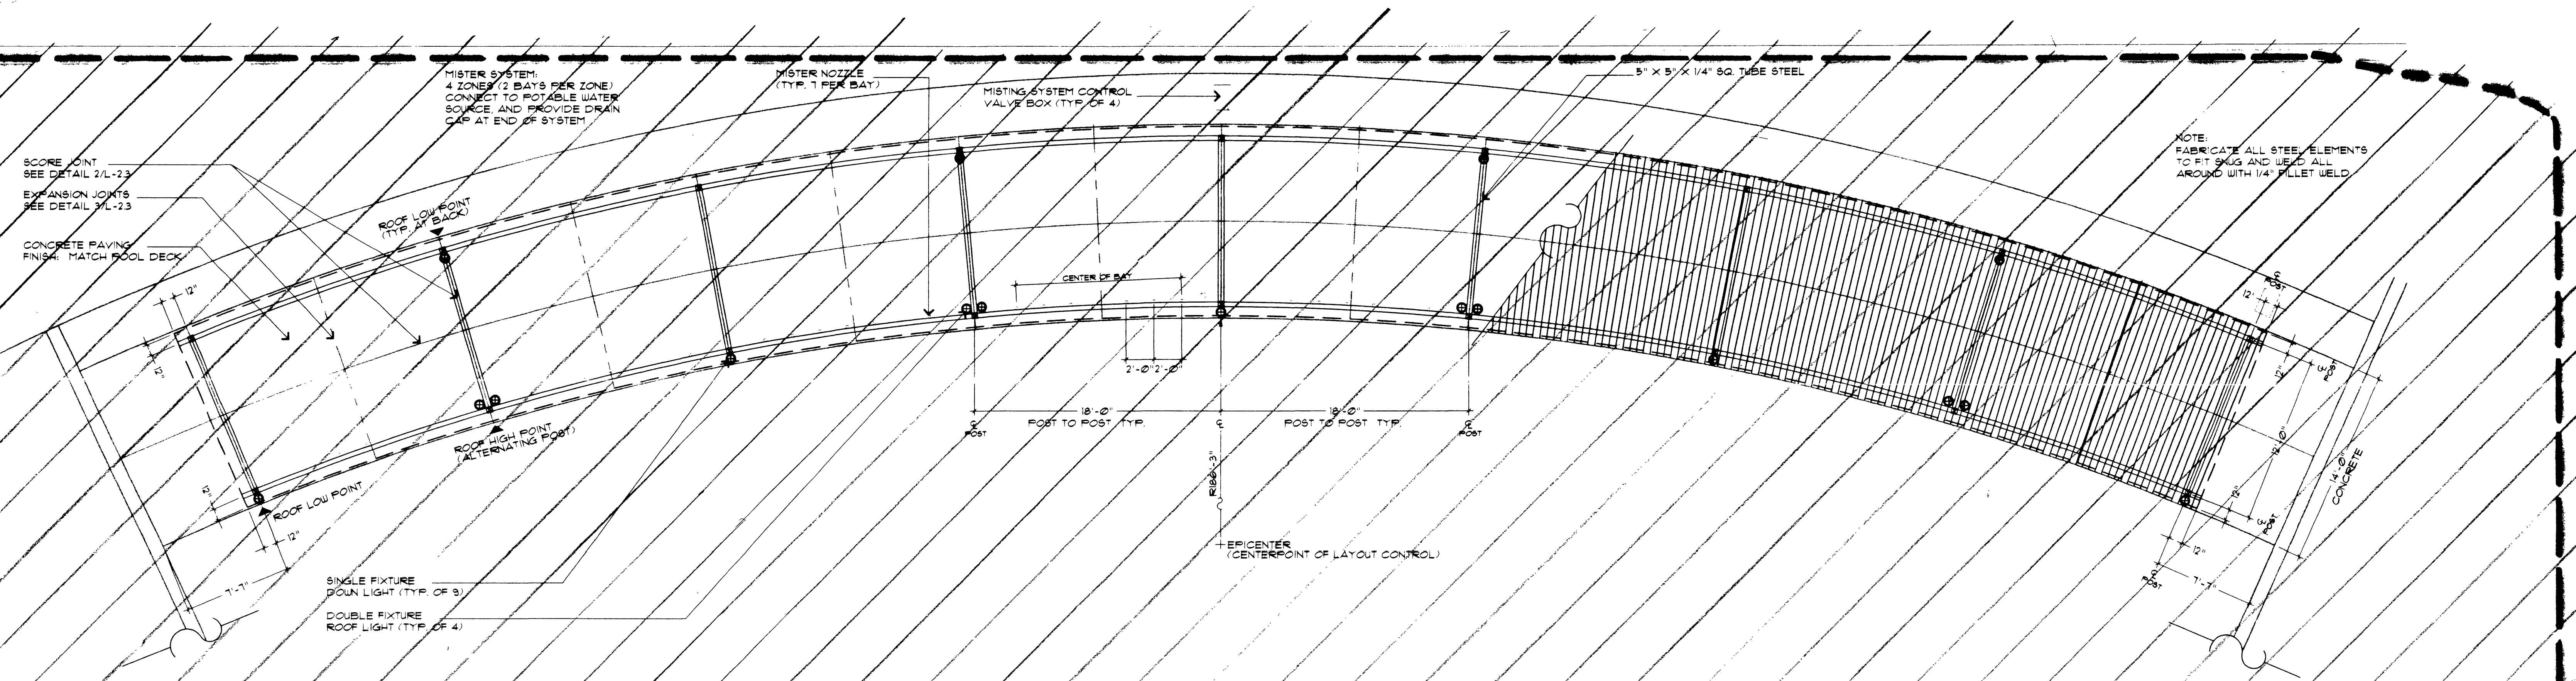

1 EAST SHADE STRUCTURE- PLAN VIEW
 SCALE: 3/16"=1'-0"

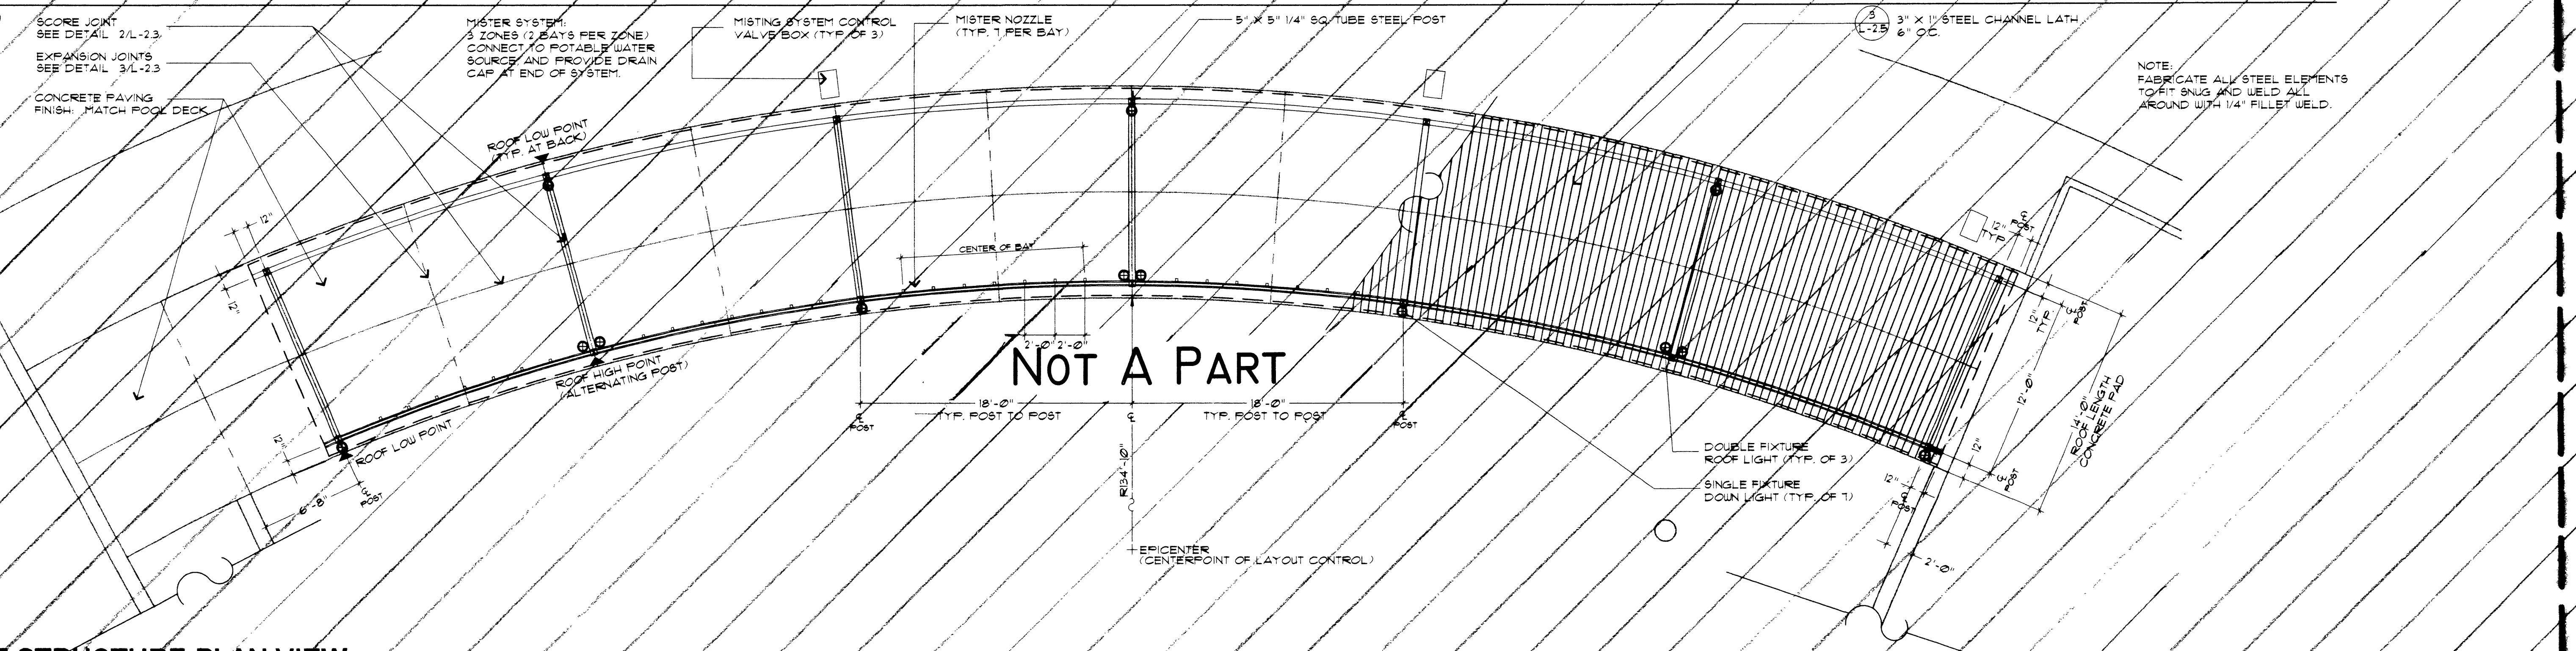

2 WEST SHADE STRUCTURE- PLAN VIEW
 SCALE: 3/16"=1'-0"

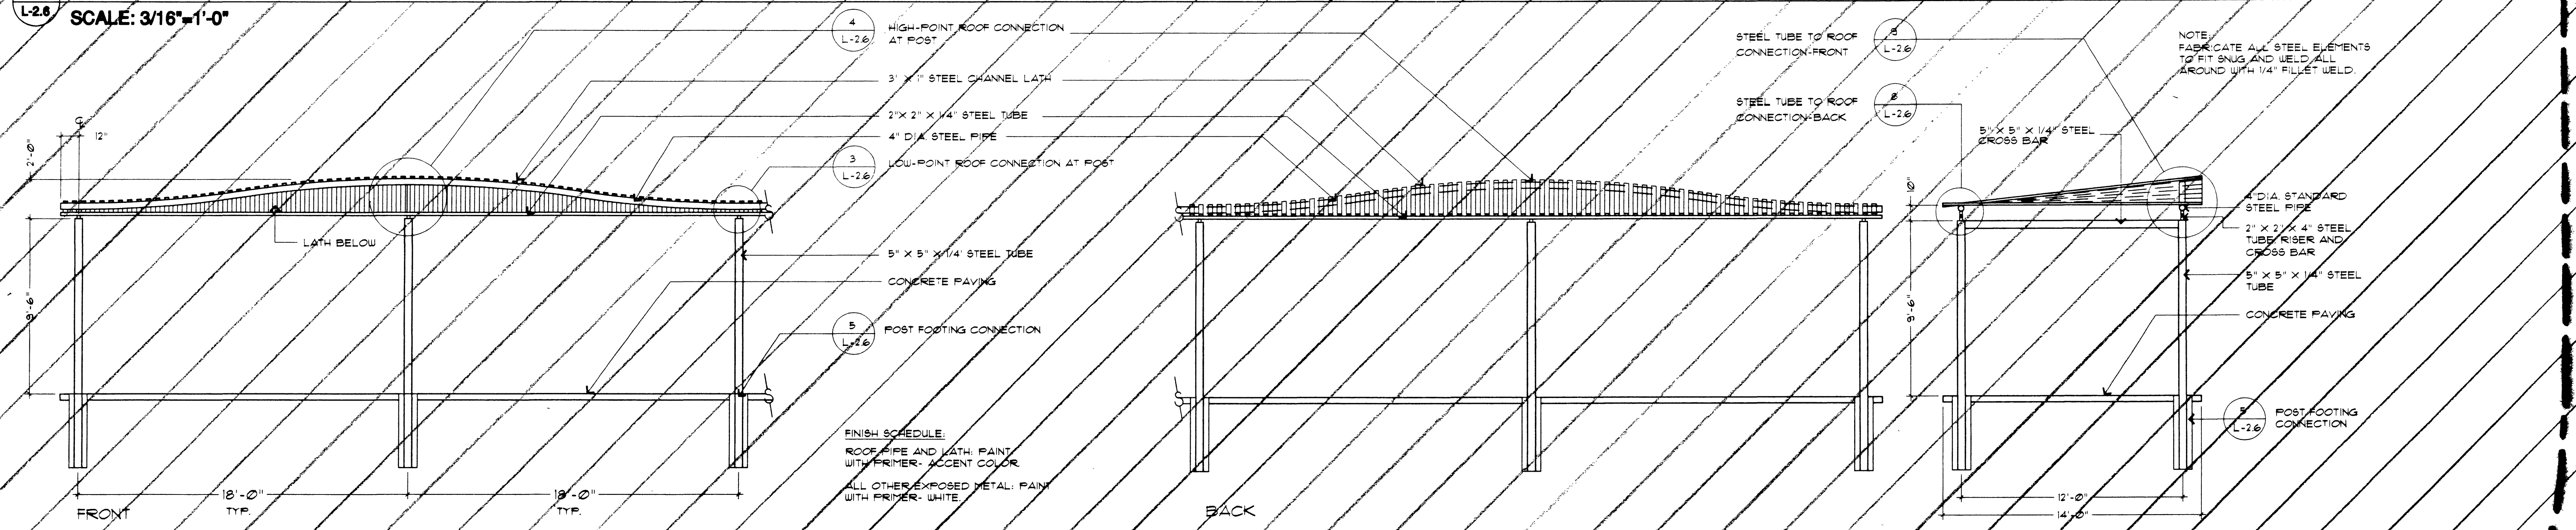

11 SHADE STRUCTURE-ELEVATION AND SECTION VIEWS
 SCALE: 1/4"=1'-0"

27040 S