

BID NO. 97-2610.05

THE NORTHWEST FAMILY LEISURE SERVICE CENTER



CITY OF LAS VEGAS DEPARTMENT OF PARKS
AND LEISURE ACTIVITIES

INDEX OF DRAWINGS

CIVIL
NOT A PART

LANDSCAPE
NOT A PART

ARCHITECTURAL

ERI	PLAN EXAMINER INFO.
A-1	KEY PLAN
A-2	FLOOR PLAN AREA A
A-3	FLOOR PLAN AREA B
A-4	BATH HOUSE ELEVATIONS AND SECTIONS
A-4.1	BATH HOUSE WALL SECTIONS
A-4.2	BATH HOUSE DETAILS
A-5	EXTERIOR ELEVATIONS
A-6	EXTERIOR ELEVATIONS
A-7	BUILDING SECTIONS
A-8	BUILDING SECTIONS
A-9	BATH HOUSE ROOF PLAN AND REFLECTED CEILING PLAN
A-10	ROOF PLAN AND REFLECTED CEILING PLAN - AREA A
A-11	ROOF PLAN - AREA B
A-12	REFLECTED CEILING PLAN - AREA B
A-13	BATH HOUSE ENLARGED PLAN
A-14	RESTROOMS ENLARGED PLAN
A-15	INTERIOR ELEVATIONS
A-16	INTERIOR ELEVATIONS
A-17	INTERIOR ELEVATIONS
A-17.1	INTERIOR ELEVATIONS
A-17.2	INTERIOR ELEVATIONS
A-18	INTERIOR ELEVATIONS
A-19	WALL SECTIONS
A-20	WALL SECTIONS
A-21	WALL SECTIONS
A-22	WALL SECTIONS
A-23	MISCELLANEOUS DETAILS
A-24	MISCELLANEOUS DETAILS
A-25	MISCELLANEOUS DETAILS
A-26	DOOR SCHEDULES, DOOR ELEVATIONS, FRAMES AND WINDOWS
A-27	DOOR AND WINDOW DETAILS
A-28	AREA A AND BATH HOUSE FINISH FLOOR PLANS
A-29	AREA B FINISH FLOOR PLAN
A-30	ROOM FINISH SCHEDULE & KEY
A-31	POOL SECTIONS AND DETAILS

STRUCTURAL

S-1	GENERAL STRUCTURAL NOTES AND SCHEDULES
S-2	FOUNDATION PLAN
S-2.1	FOUNDATION PLAN - AREA A & BATH HOUSE
S-3	ROOF FRAMING PLAN
S-3.1	ROOF FRAMING PLAN - AREA A & BATH HOUSE
S-4	FOUNDATION DETAILS
S-5	FRAMING DETAILS
S-6	FRAMING DETAILS
S-7	FRAMING DETAILS
S-8	FRAMING DETAILS
S-9	FRAMING DETAILS

MECHANICAL

M1.1	MECHANICAL LEGEND AND SCHEDULES
M1.2	MECHANICAL SCHEDULES
M2.1	HVAC PLAN - AREA B
M2.2	HVAC PIPING PLAN - AREA B
M2.3	HVAC PLAN - AREA A
M2.4	HVAC PIPING PLAN - AREA A
M3.1	ENLARGED MECHANICAL FLOOR PLAN
M4.1	MECHANICAL DETAILS
M4.2	MECHANICAL DETAILS
M4.3	MECHANICAL DETAILS
M5.1	MECHANICAL TEMPERATURE CONTROL DIAGRAMS
M5.2	MECHANICAL AND ELECTRICAL COORDINATION SHEET

PLUMBING

P1.1	PLUMBING LEGEND AND SCHEDULES
P2.1	PLUMBING FLOOR PLAN - AREA B
P2.2	PLUMBING FLOOR PLAN - AREA A
P3.1	PARTIAL PLUMBING FLOOR PLANS
P3.2	PARTIAL PLUMBING FLOOR PLANS
P4.1	PLUMBING DETAILS

ELECTRICAL


E1.0	ELECTRICAL SYMBOLS AND SCHEDULES
E1.1	ELECTRICAL SITE PLAN
E2.1	LIGHTING FLOOR PLAN - AREA B
E2.2	LIGHTING FLOOR PLAN - AREA A
E3.1	POWER FLOOR PLAN - AREA B
E3.2	POWER FLOOR PLAN - AREA A
E4.1	SIGNAL FLOOR PLAN - AREA B
E4.2	SIGNAL FLOOR PLAN - AREA A
E5.1	ELECTRICAL PART PLAN & ONE LINE DIAGRAM
E5.2	ELECTRICAL PANELS & SCHEDULES
E5.3	ELECTRICAL PANELS & SCHEDULES

CONSULTANTS

STRUCTURAL
DROTTAR - PRINISKI ASSOC.

MECHANICAL & ELECTRICAL
DUNHAM ASSOCIATES

VICINITY MAP

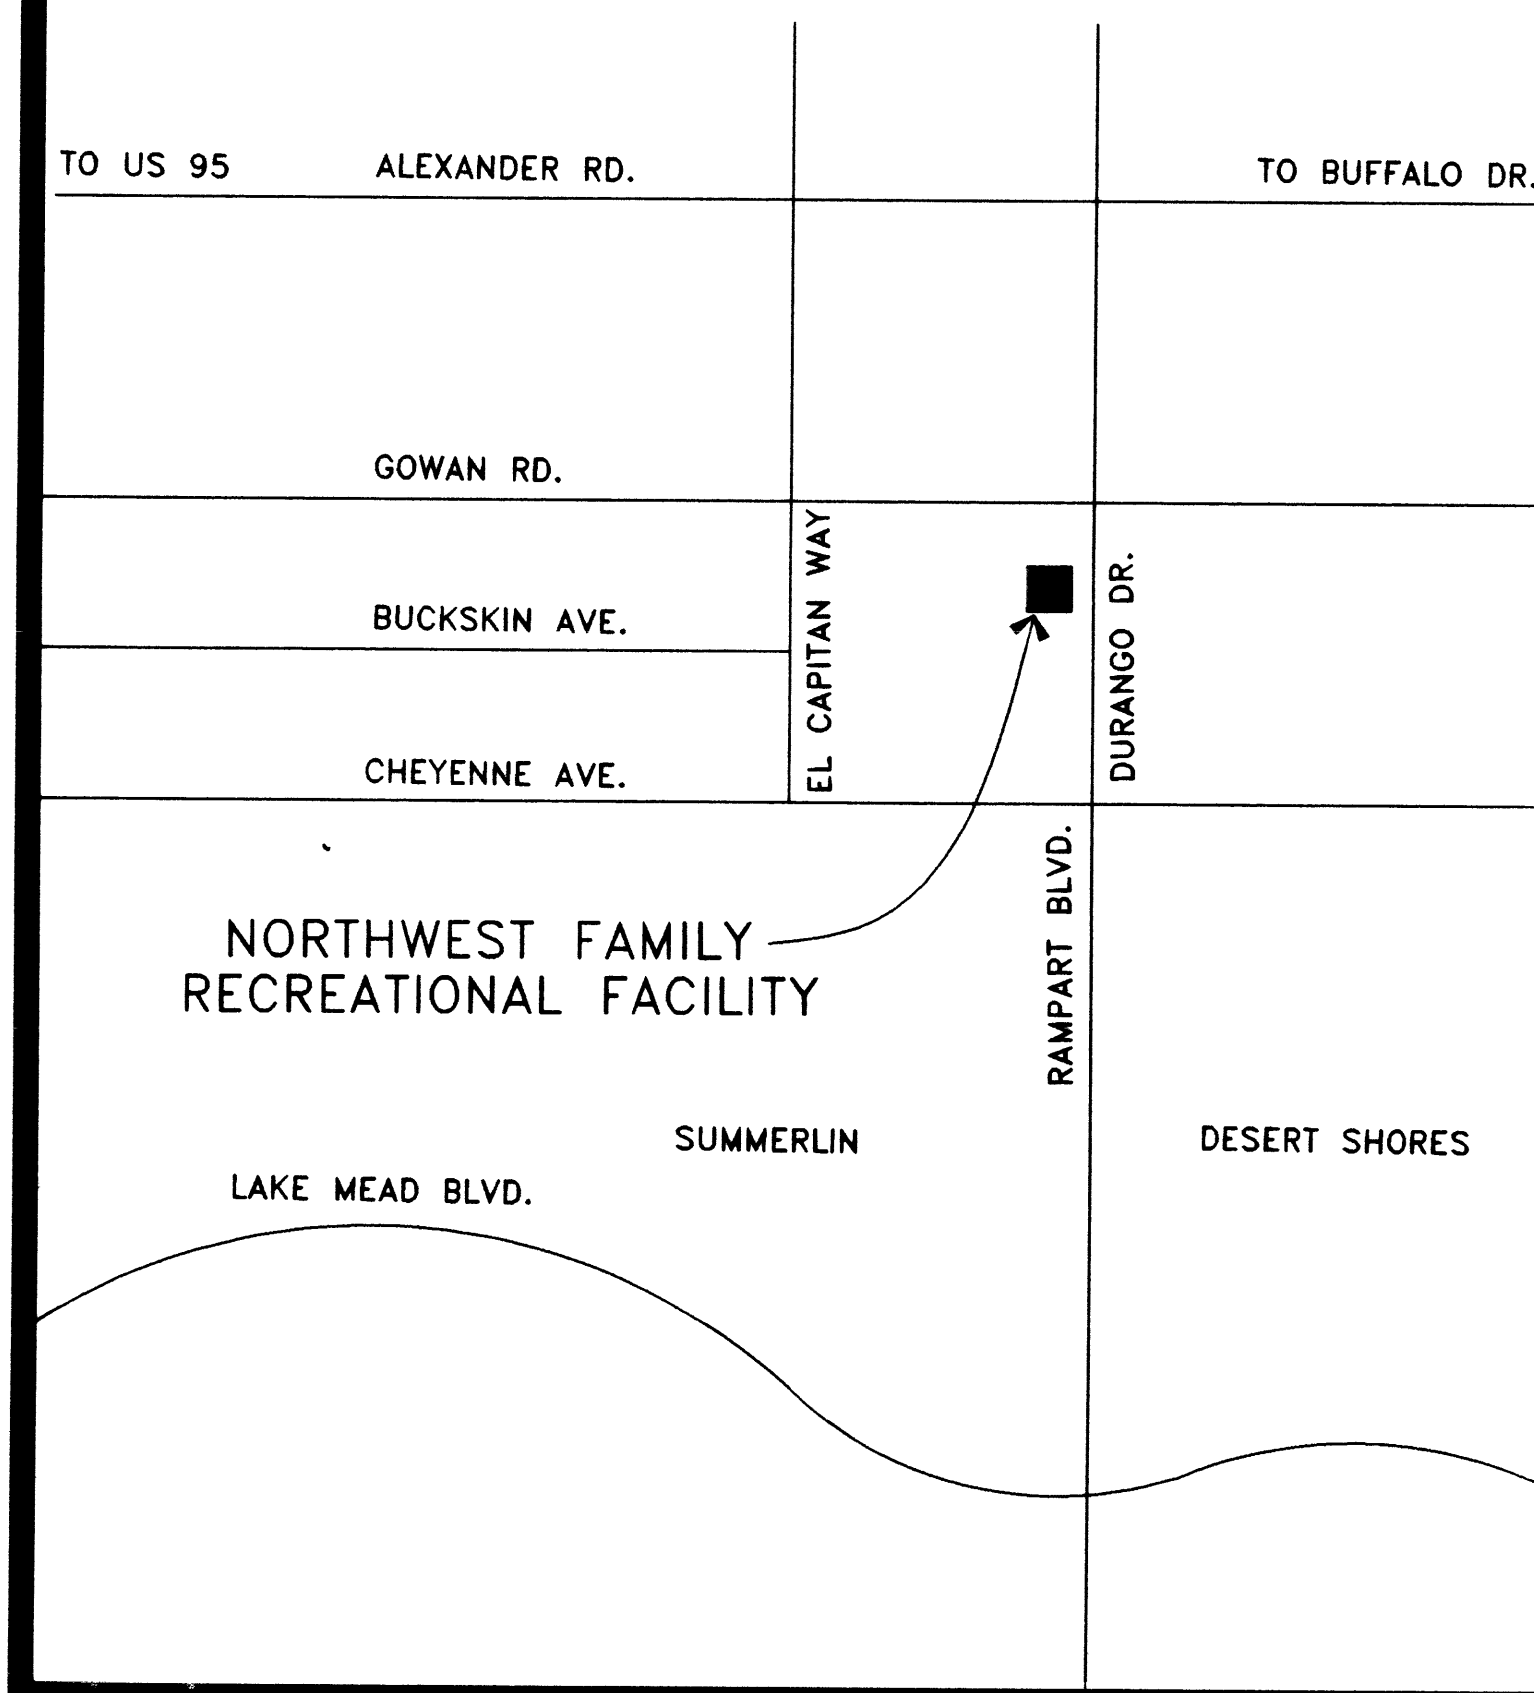

CODE INFORMATION

CODE USE:
U.B.C. 1994 EDITION/CITY OF LAS VEGAS SUPPLEMENT

OCCUPANCY:
A-2.1, B, A-3, M

GROSS AREAS: COMMUNITY BUILDING: 41,164
BATH HOUSE: 3,987
CONCESSION: 576
POOL MGR/POOL CONTROL/STORAGE: 4,218


OCCUPANCY LOAD: 49,945 G.R.S.F.

COMMUNITY BUILDING: 1,793
BATH HOUSE: 80
CONCESSION: 14

SINGLE STORY TOTAL: 1,887

15 EXITS PROVIDED AT COMMUNITY BUILDING
4 EXITS PROVIDED AT BATH HOUSE

CONSTRUCTION TYPE:
TYPE II 1-HOUR (FULLY SPRINKLERED)
(EXCEPT BATH HOUSE)
SPECIAL INSPECTIONS REQUIRED

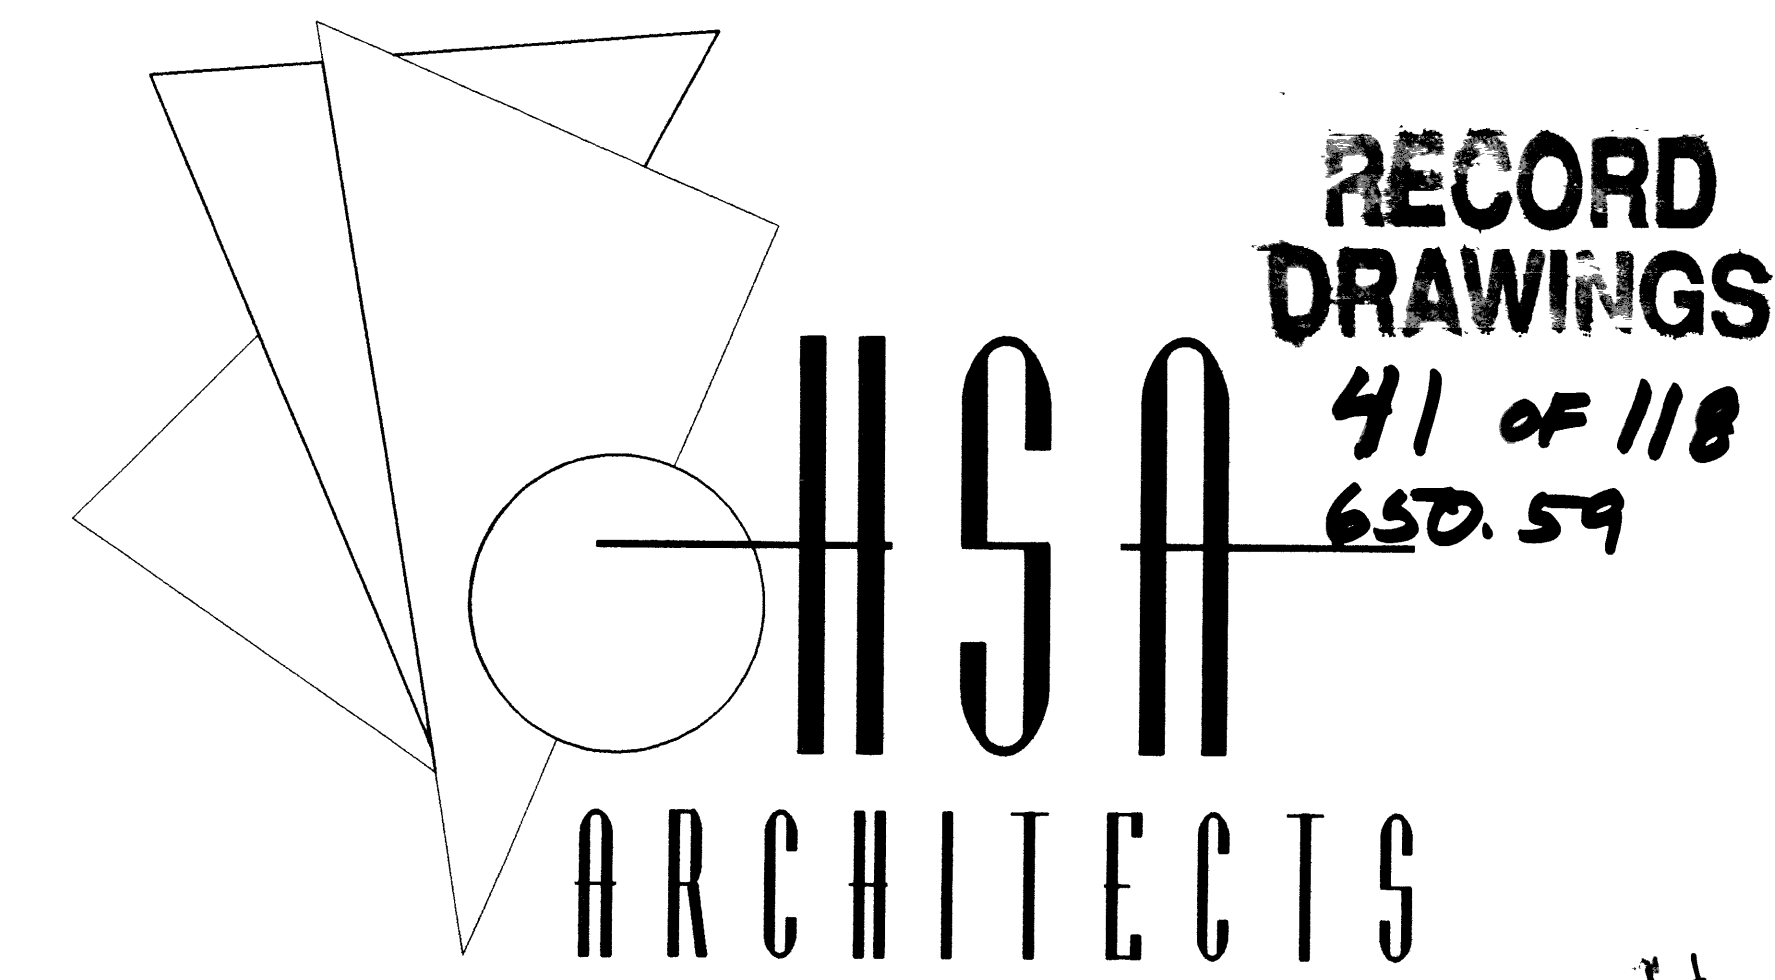

WAYNE P. SCHREINER, AIA THOMAS M. SILVA, AIA
1525 WEST OAKLEY BLVD • LAS VEGAS, NEVADA 89102 • (702) 383-0077 FAX 383-0057

21059