



REVISIONS

4-4-01 shelter / wall callouts

CONSULTANT

LUCCHESI GALATI ARCHITECTS

900 PILOT ROAD, SUITE A LAS VEGAS, NEVADA 89102 (702) 386-9771



MZUNINO & ASSOCIATES LANDSCAPE ARCHITECTURE LAND PLANNING


7771 South Jones Blvd. Las Vegas, Nevada 89146 Phone (702) 233-8300 Fax (702) 233-0716 Email mjz@mjz.com

DEPARTMENT OF PUBLIC WORKS ELKHORN SPRINGS NEIGHBORHOOD PARK BUFFALO DRIVE LANDSCAPE SITE PLAN

OWNER: CITY OF LAS VEGAS DEPARTMENT OF PUBLIC WORKS ARCHITECTURAL SERVICES

400 EAST STEWART AVENUE LAS VEGAS, NEVADA 89101 PHONE: (702) 229-6939 FAX: (702) 382-3232 (702) 386-9108 TDD:

DRAWN: HK5 FILE: 20445-SITE PLAN DATE: 3-9-01 SCALE: 1" = 30'-0" REC NO: 01-15304.16 CIV DWG NO: 650.64 ZZ of 90 SHE NO:

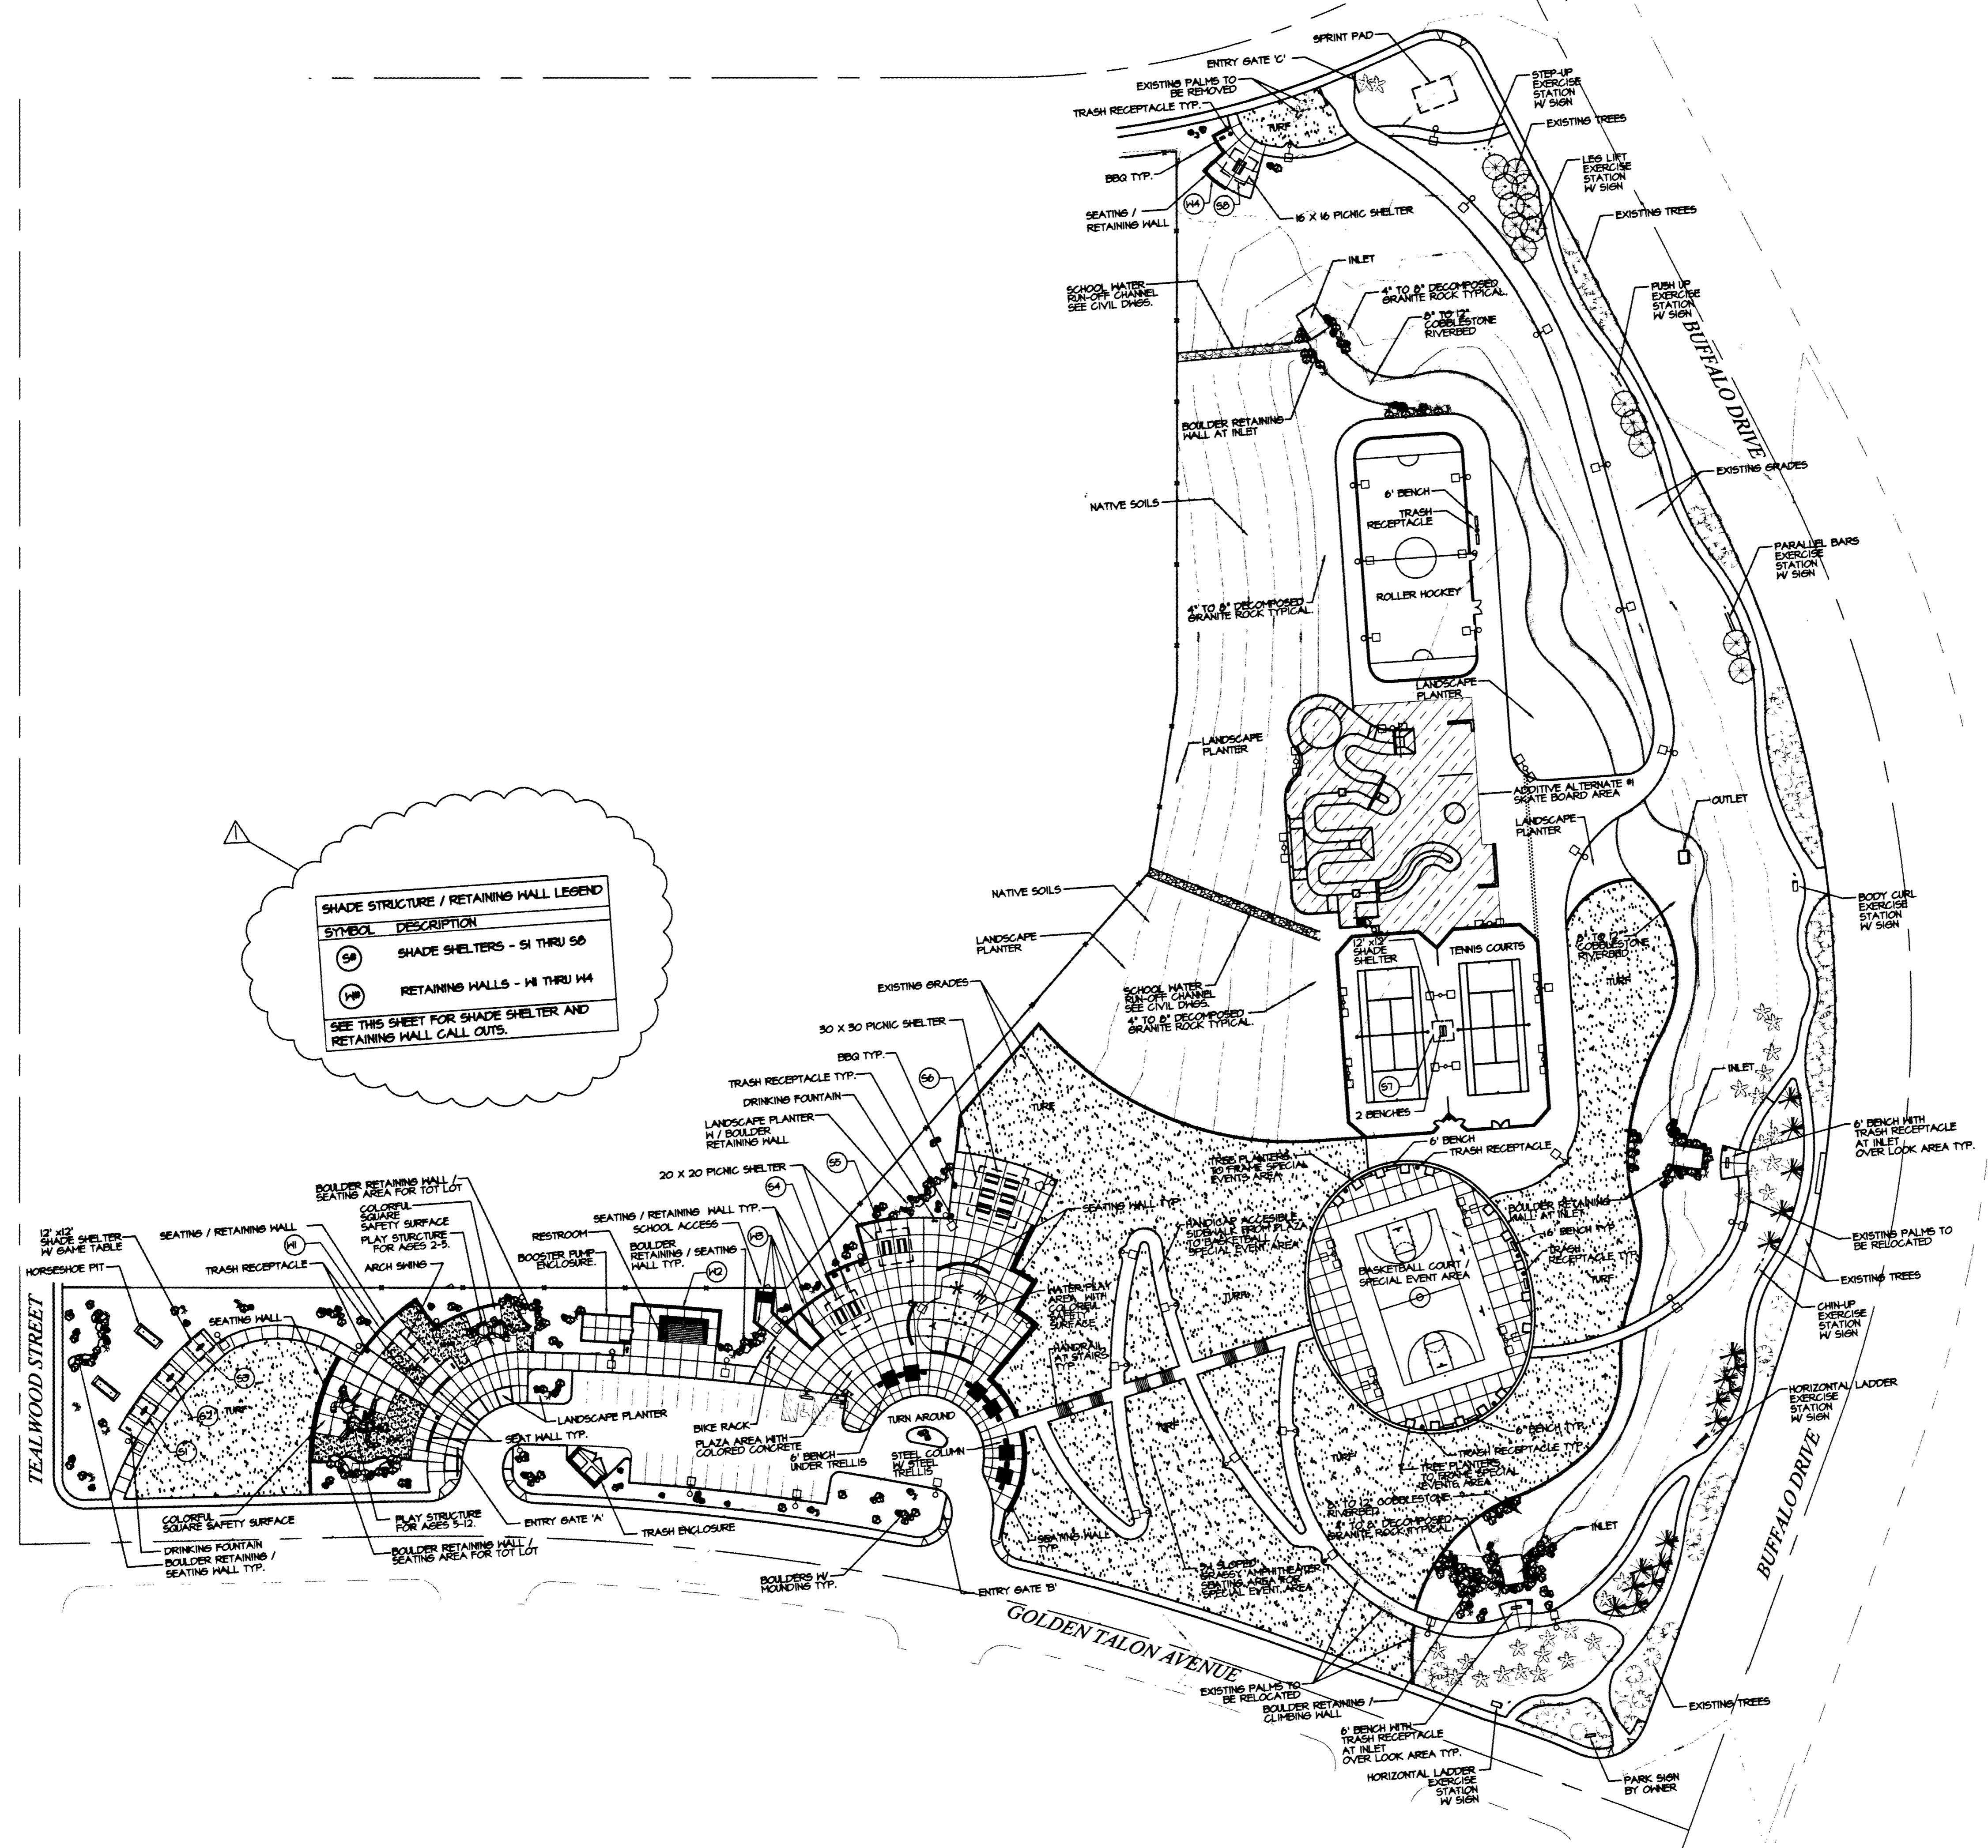

SHADE STRUCTURE / RETAINING WALL LEGEND

SYMBOL	DESCRIPTION
(SH)	SHADE SHELTERS - SH THRU S6
(RH)	RETAINING WALLS - RH THRU RH4

SEE THIS SHEET FOR SHADE SHELTER AND RETAINING WALL CALL OUTS.